

WYE BRANCH
SEWER DISTRIBUTION SYSTEM
FOR



SCALE 1"=50'

COUNTY

DON C. MOEHM

CONSULTING CIVIL ENGINEER
WICHITA, KANSAS

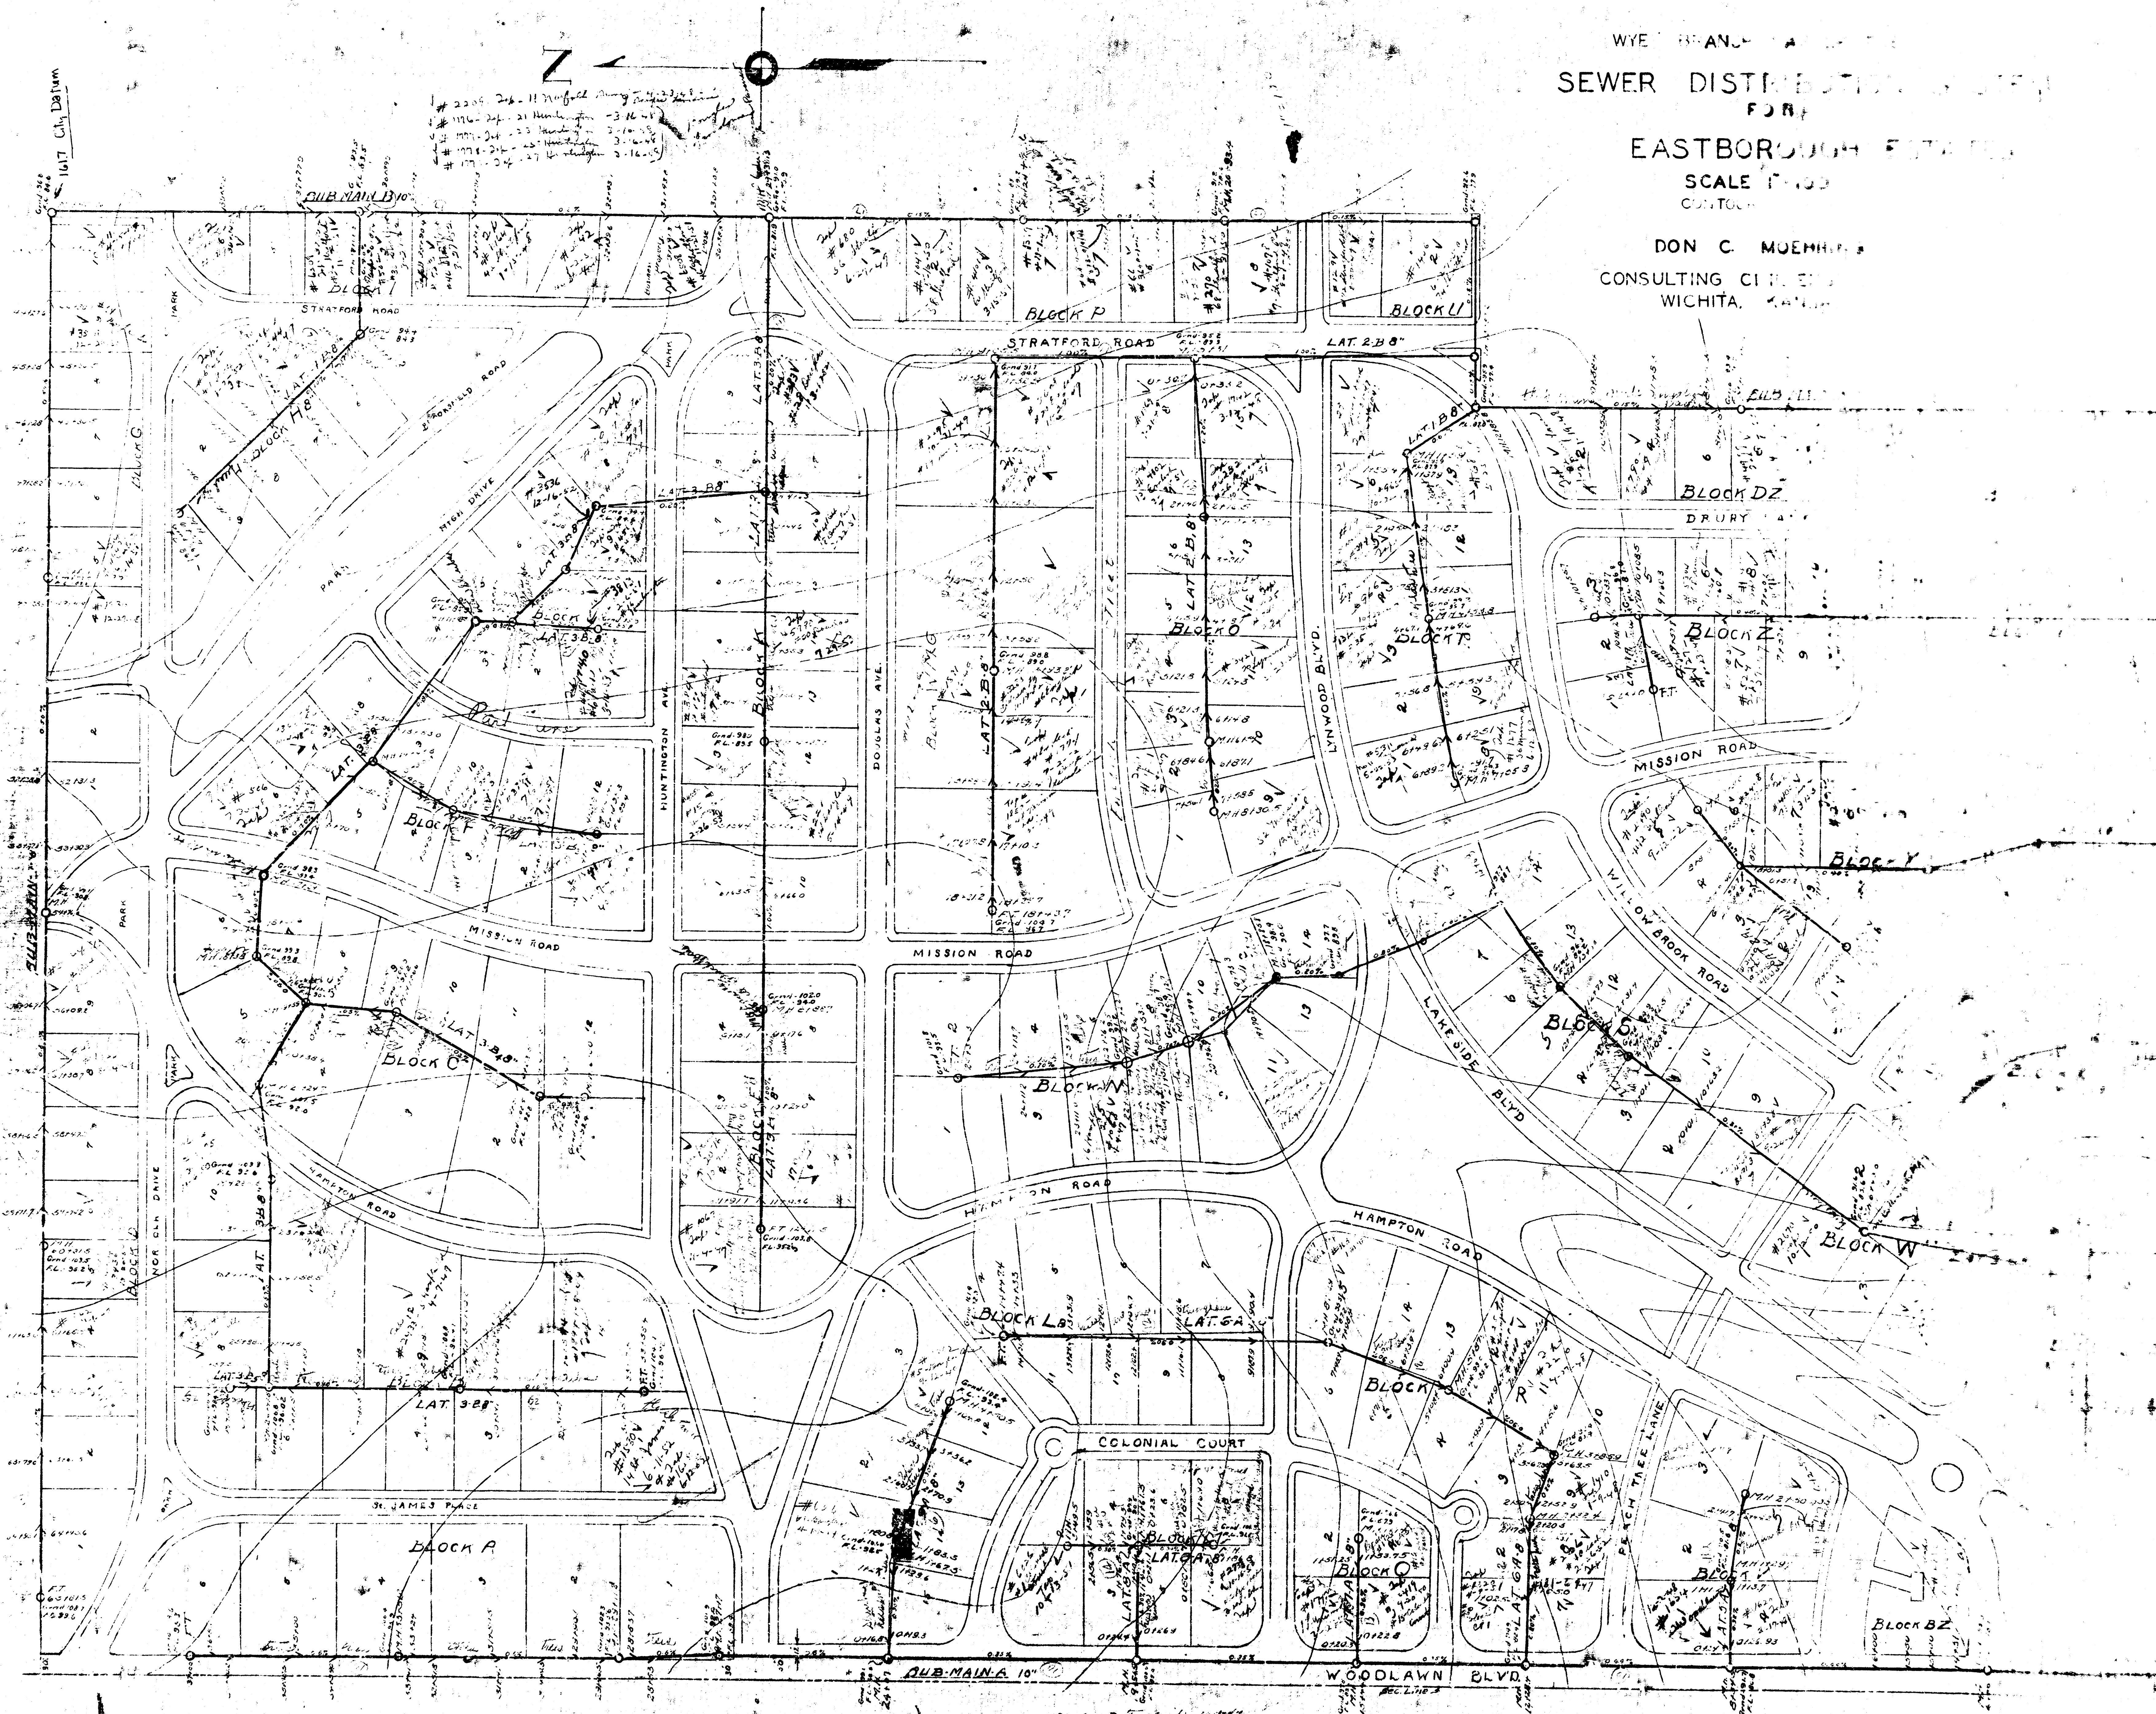

