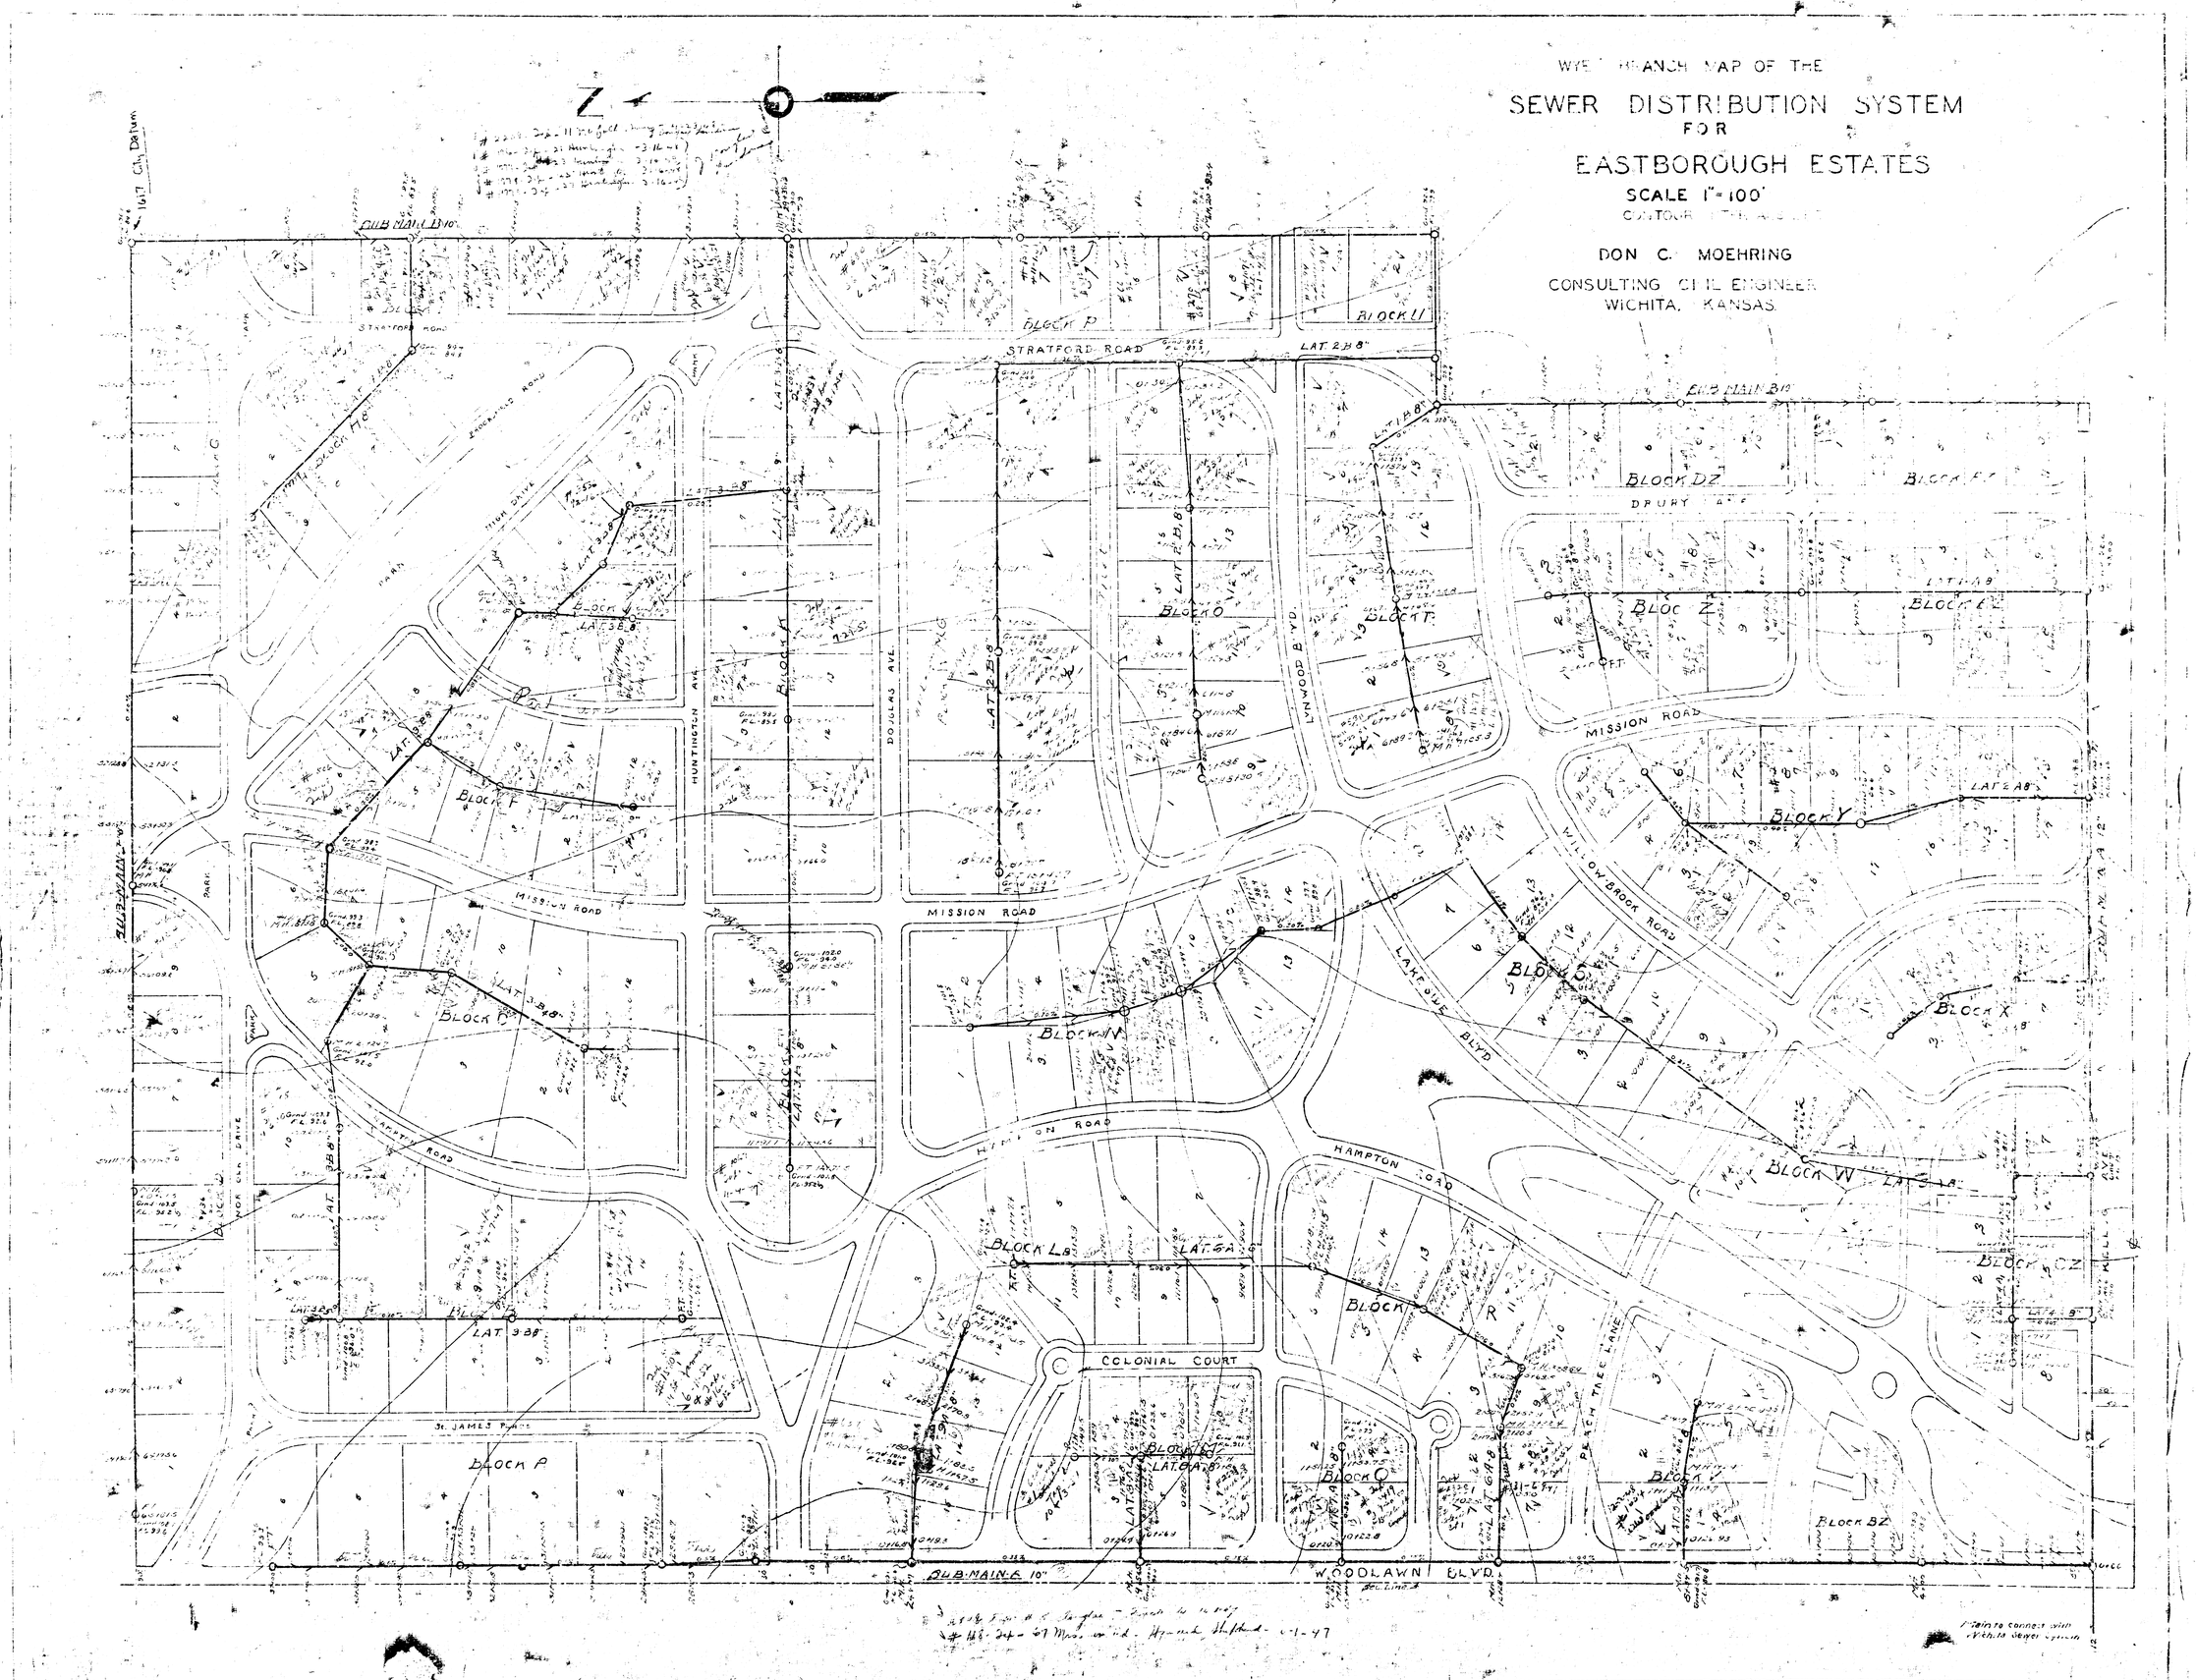
WYE BRANCH MAP OF THE
SEWER DISTRIBUTION SYSTEM
FOR
EASTBOROUGH ESTATES
SCALE 1" = 100'
DON C. MOEHRING
CONSULTING CIVIL ENGINEER
WICHITA, KANSAS
STRATFORD ROAD
MISSION ROAD
HAMPTON ROAD
COLONIAL COURT
WOODLAWN BLVD.
DOUGLAS AVE.
HUNTINGTON AVE.
LYNWOOD BLVD.
LAKESIDE BLVD.
WILLOWBROOK ROAD
PEACH TREE LANE
DRURY ATE
ST. JAMES PLACE
BLOCK P
BLOCK Q
BLOCK R
BLOCK S
BLOCK T
BLOCK U
BLOCK V
BLOCK W
BLOCK X
BLOCK Y
BLOCK Z
BLOCK AZ
BLOCK BZ
BLOCK CZ
BLOCK DZ
BLOCK EZ
BLOCK FZ
BLOCK LB
BUB MAIN B 10"
BUB MAIN A 10"
Plan to connect with Wichita Sewer system