

APPROVED AS NOTED

By CITY ENGINEER

Sanitary Sewers


Storm Sewers

Driveway Approaches

NOTE TO CONTRACTOR

This project will be constructed under the supervision of the CITY ENGINEER and conforming to the SPECIFICATIONS of the CITY OF WICHITA. The CONTRACTOR will reimburse the City of Wichita for all cost of Engineering, Plans, and Inspection.

East High

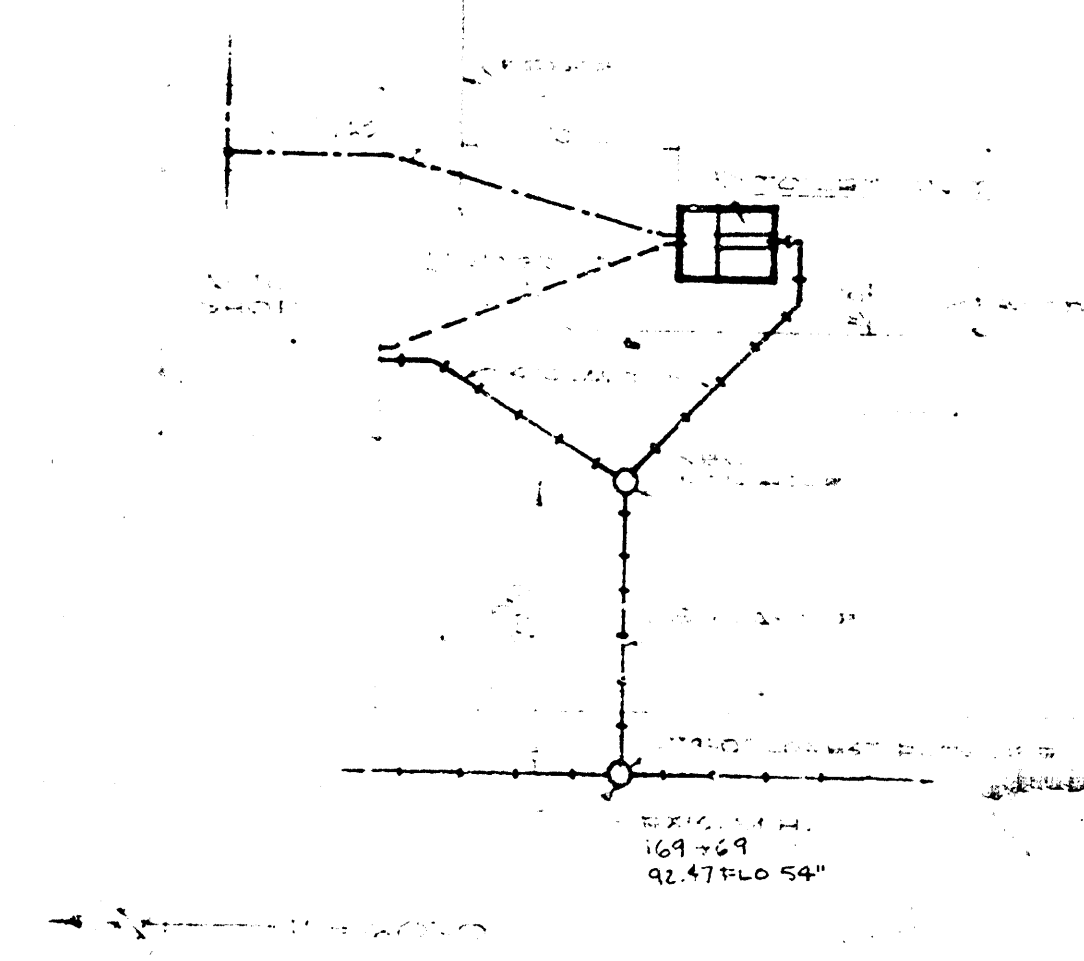

JOB NO. DATE BOARD OF EXAMINERS TOILET UNIT DE... CC. SHEET

6011 JUNE 9-60

WICHITA

EAST HIGH SCHOOL (R)

OF 1

8 4 12