



PLAN SCALE 1"=40'  
 PROFILE SCALE 1"=40' HOR, 1"=4' VERT

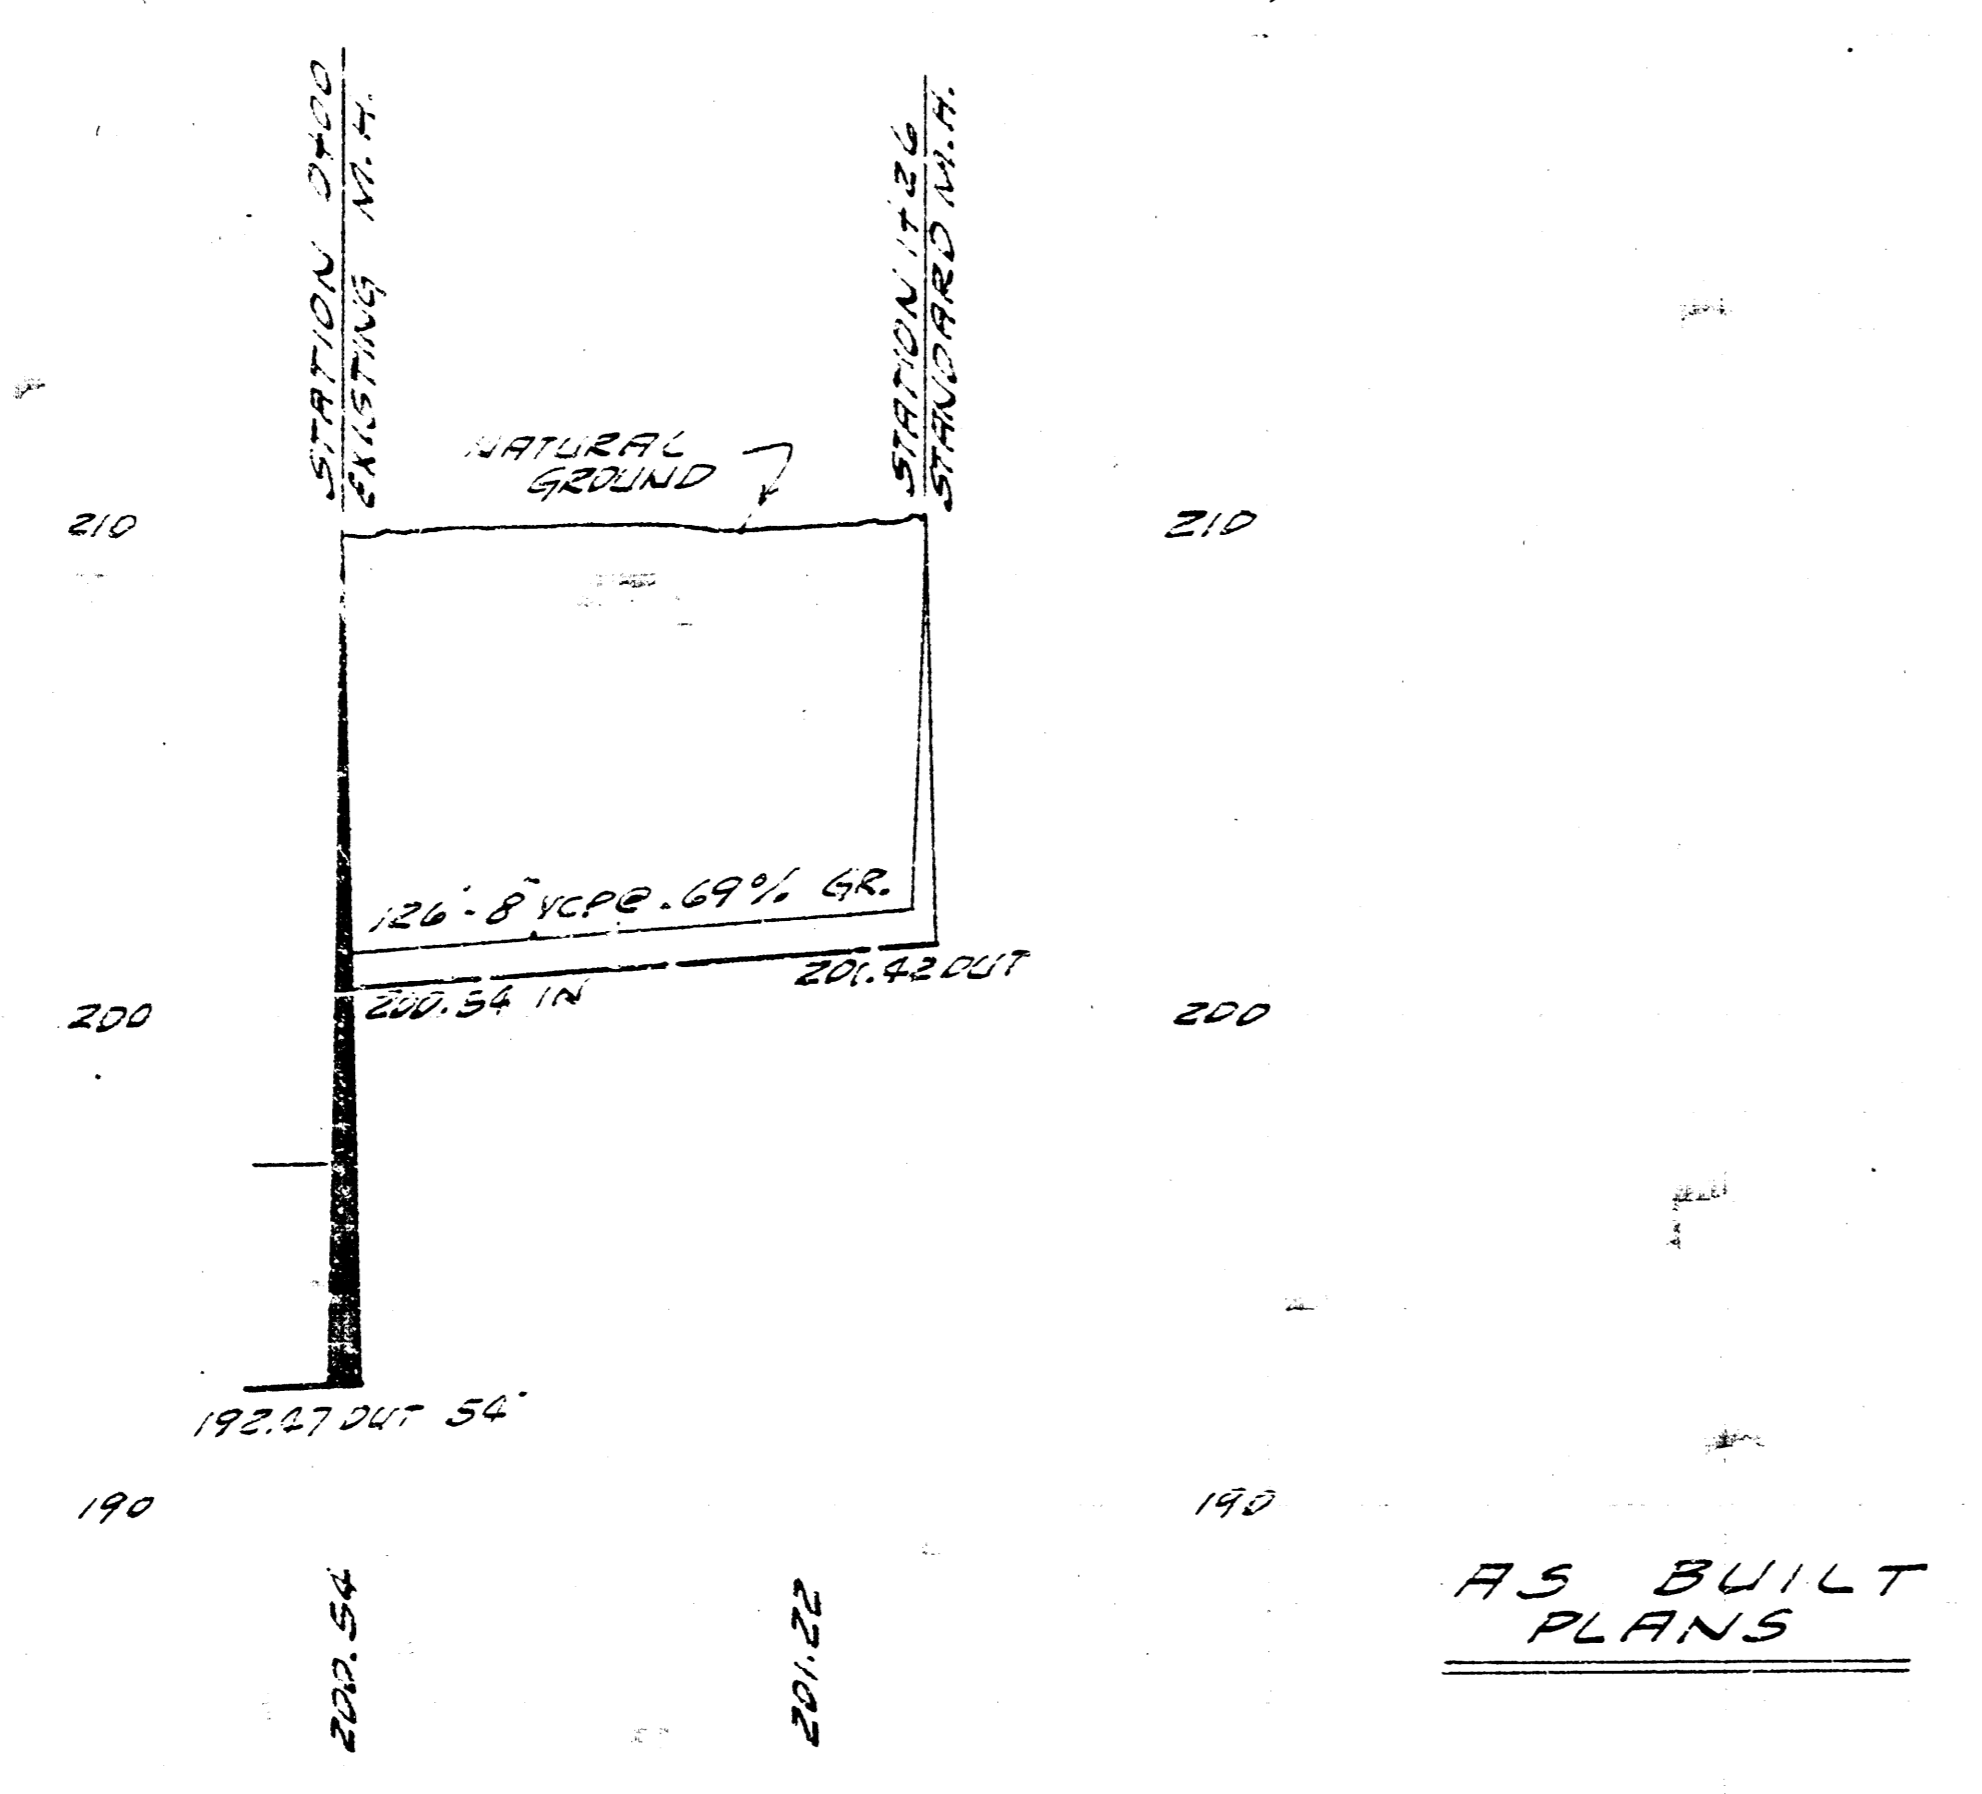

PRIVATE SAN. SEWER FOR  
 EAST HIGH SCHOOL  
 CITY OF WICHITA, KANSAS  
 B.E. SMITH CITY ENGINEER  
 PRIVATE JOB. NOV. 1960



PLAN SCALE 1"=40'  
 PROFILE SCALE 1"=40' HOR, 1"=4' VERT

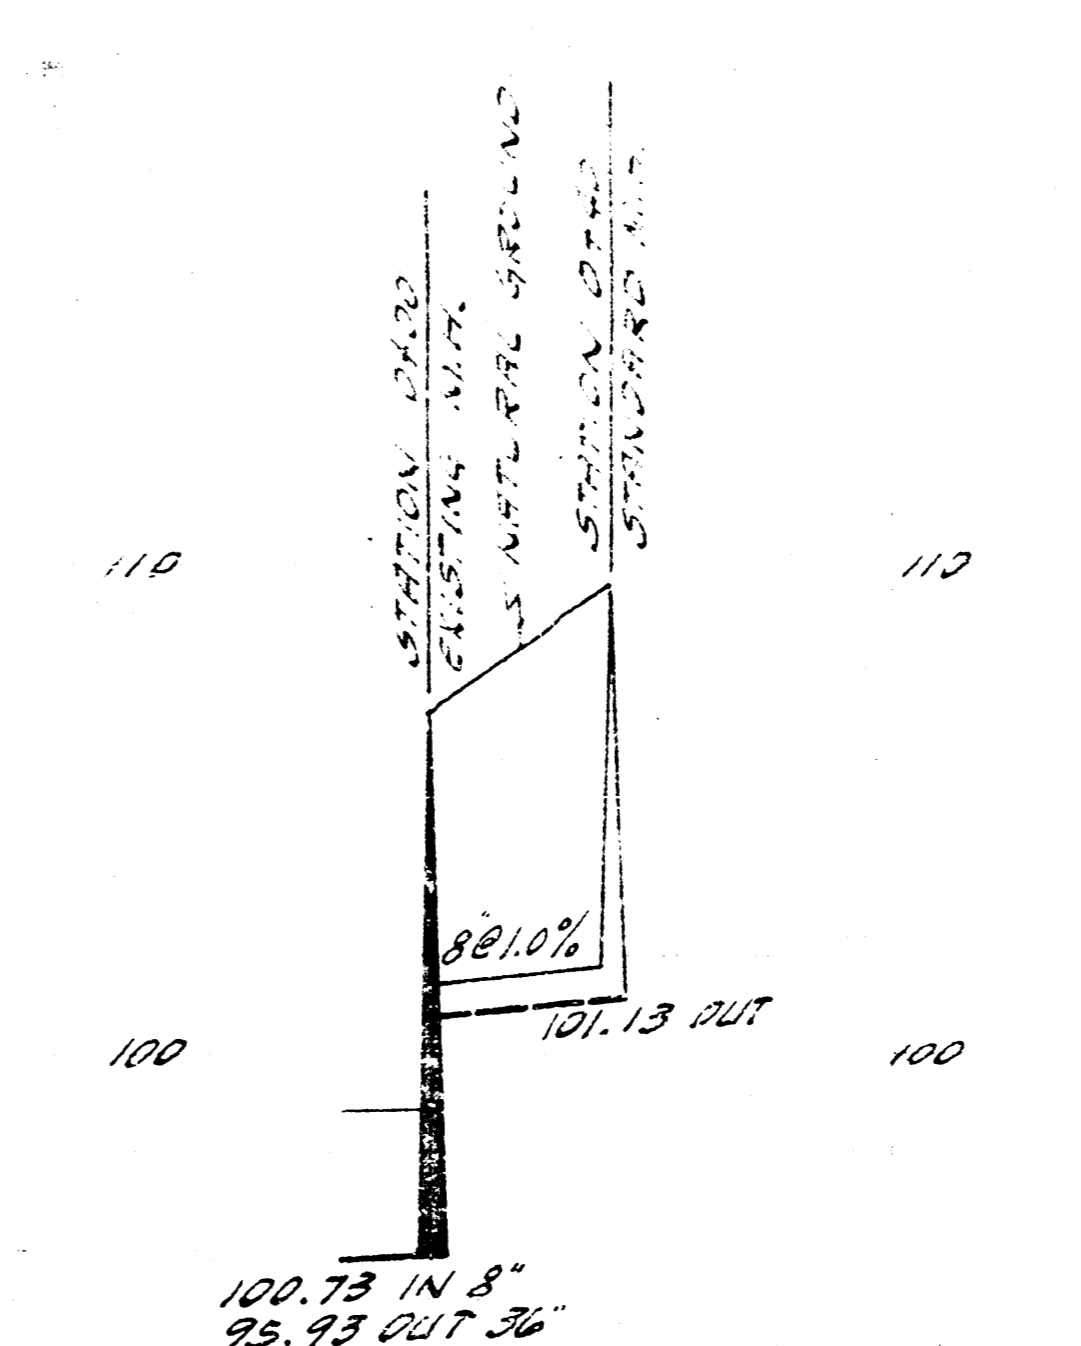

PRIVATE SAN. SEWER AT  
 SW. COR. K-42 & SHERIDAN  
 CITY OF WICHITA, KANSAS  
 B.E. SMITH CITY ENGINEER  
 PRIVATE JOB NOV. 1960.