

PLANS

SANITARY SEWER SYSTEM

CRESTVIEW COUNTRY CLUB ESTATES

EAST MEADOWS ADDITION

NORTH
POINT

ADD.

EAST

MEADOWS

ADD.

LEGEND


1" = 100' (Horizontal Scale)

1" = 10' (Vertical Scale)

AS RECONSTRUCTED

SANITARY SEWER LINES

CRESTVIEW IMPROVEMENT DISTRICT

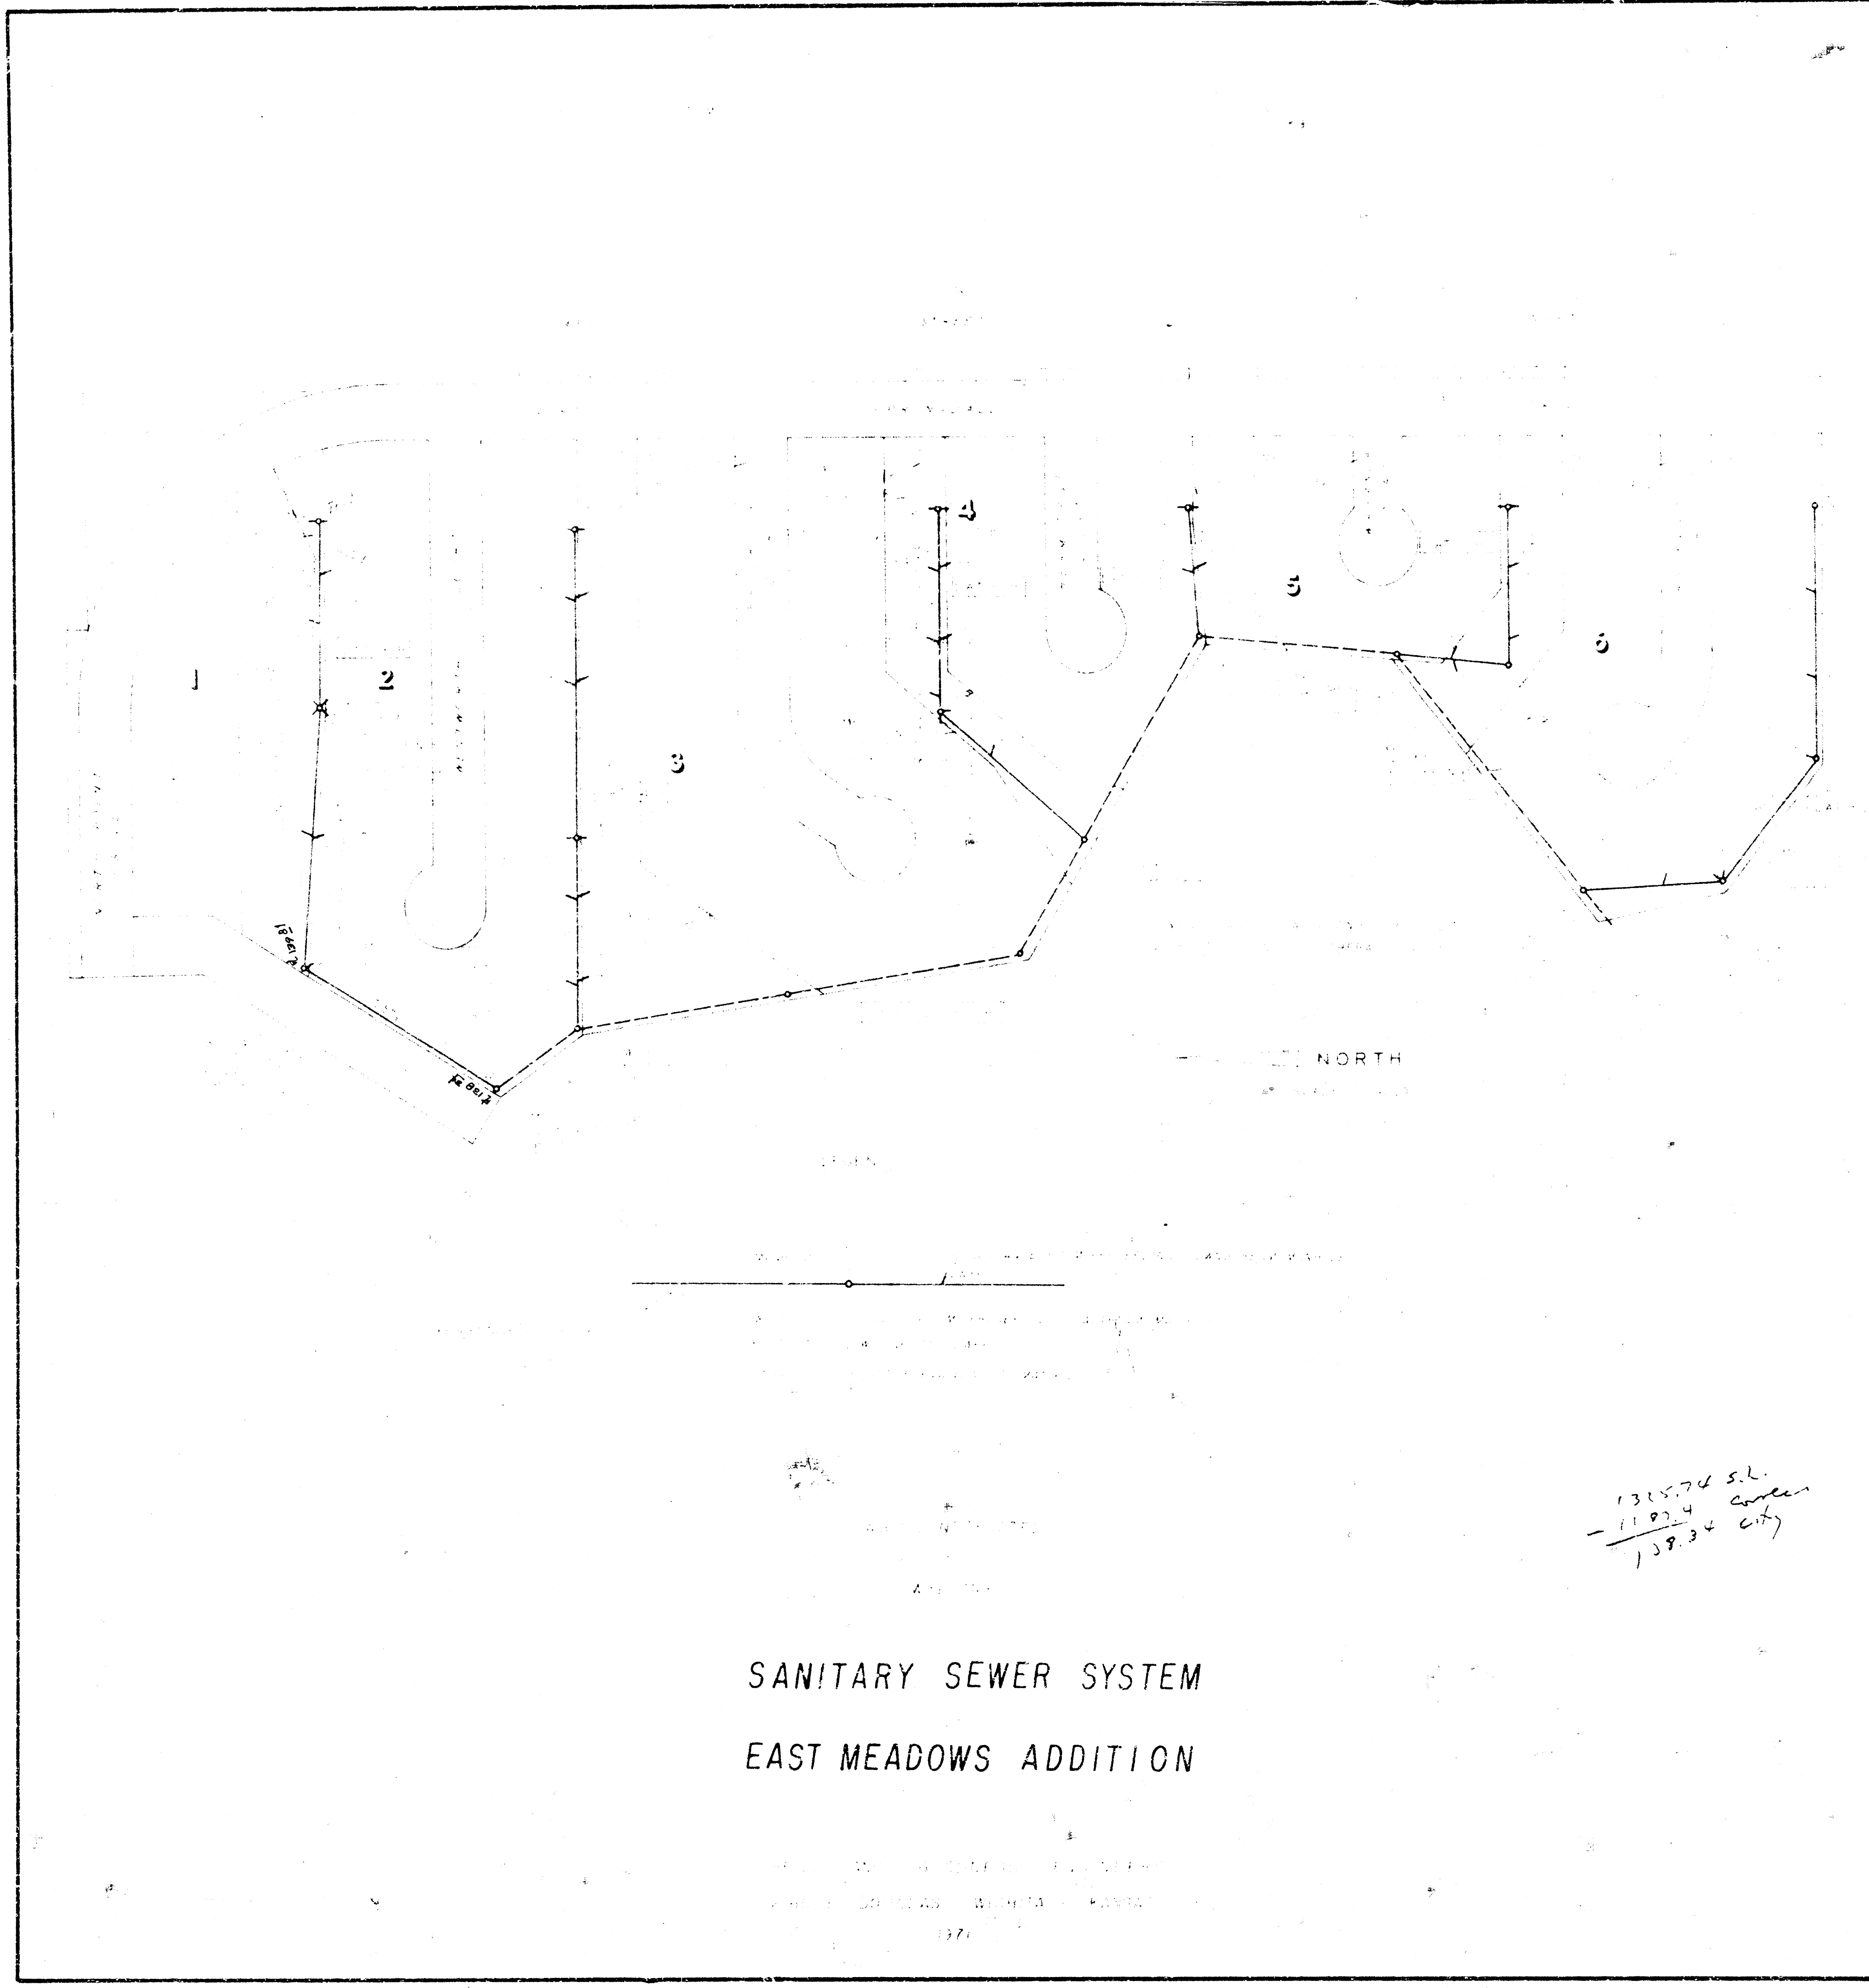

SANITARY SEWER SYSTEM
EAST MEADOWS ADDITION

1971





