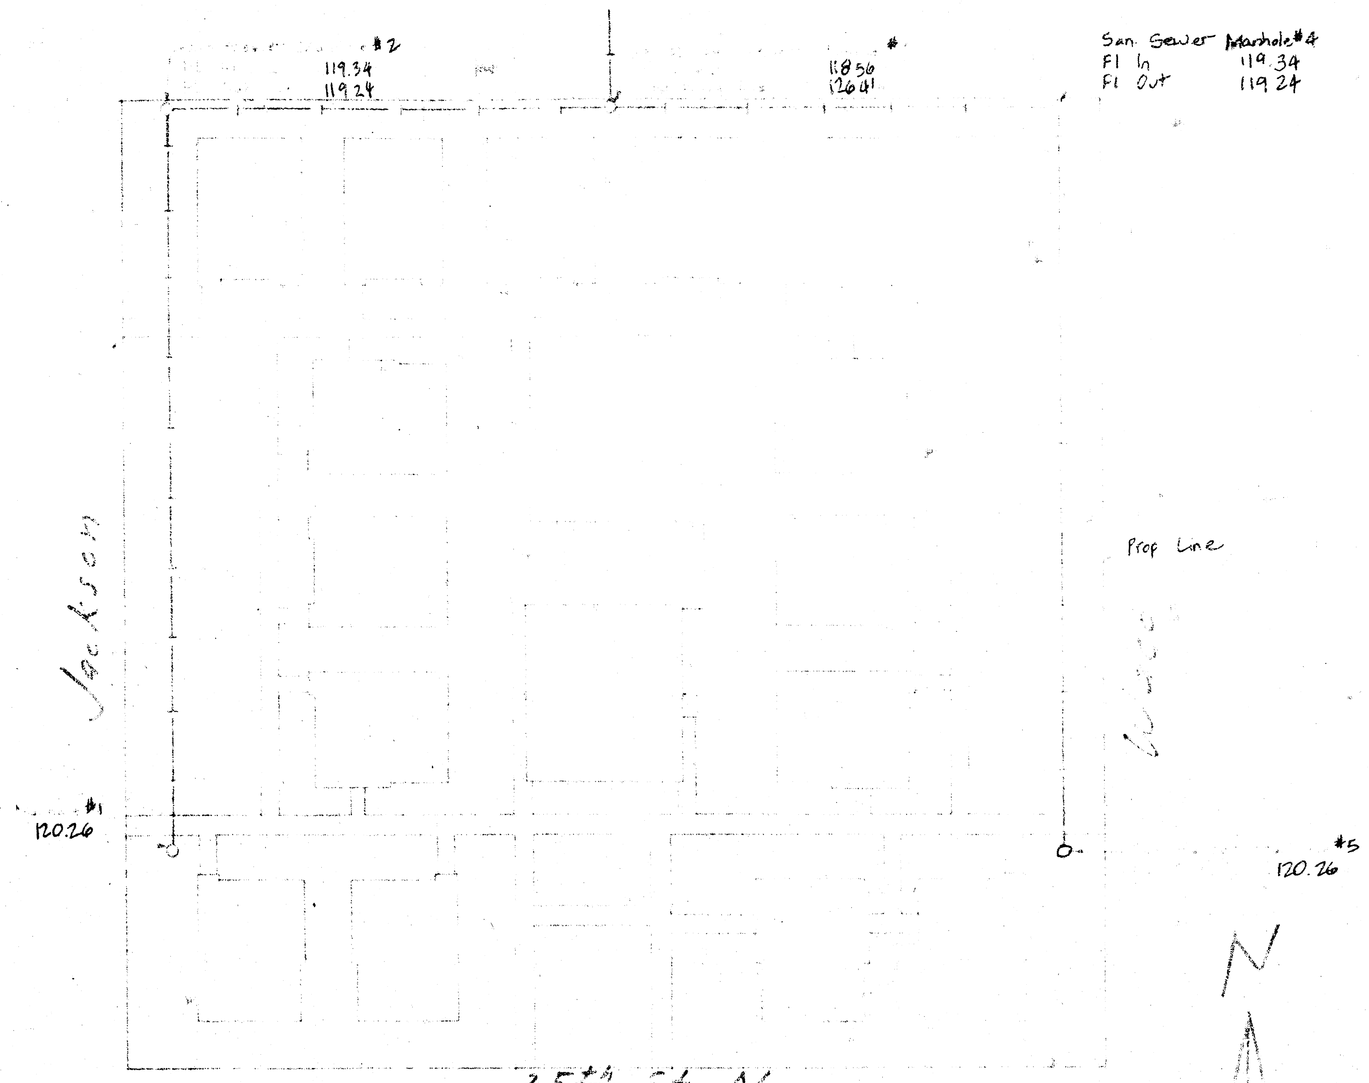

SANITARY SEWER PLAN

1"=30'-0"

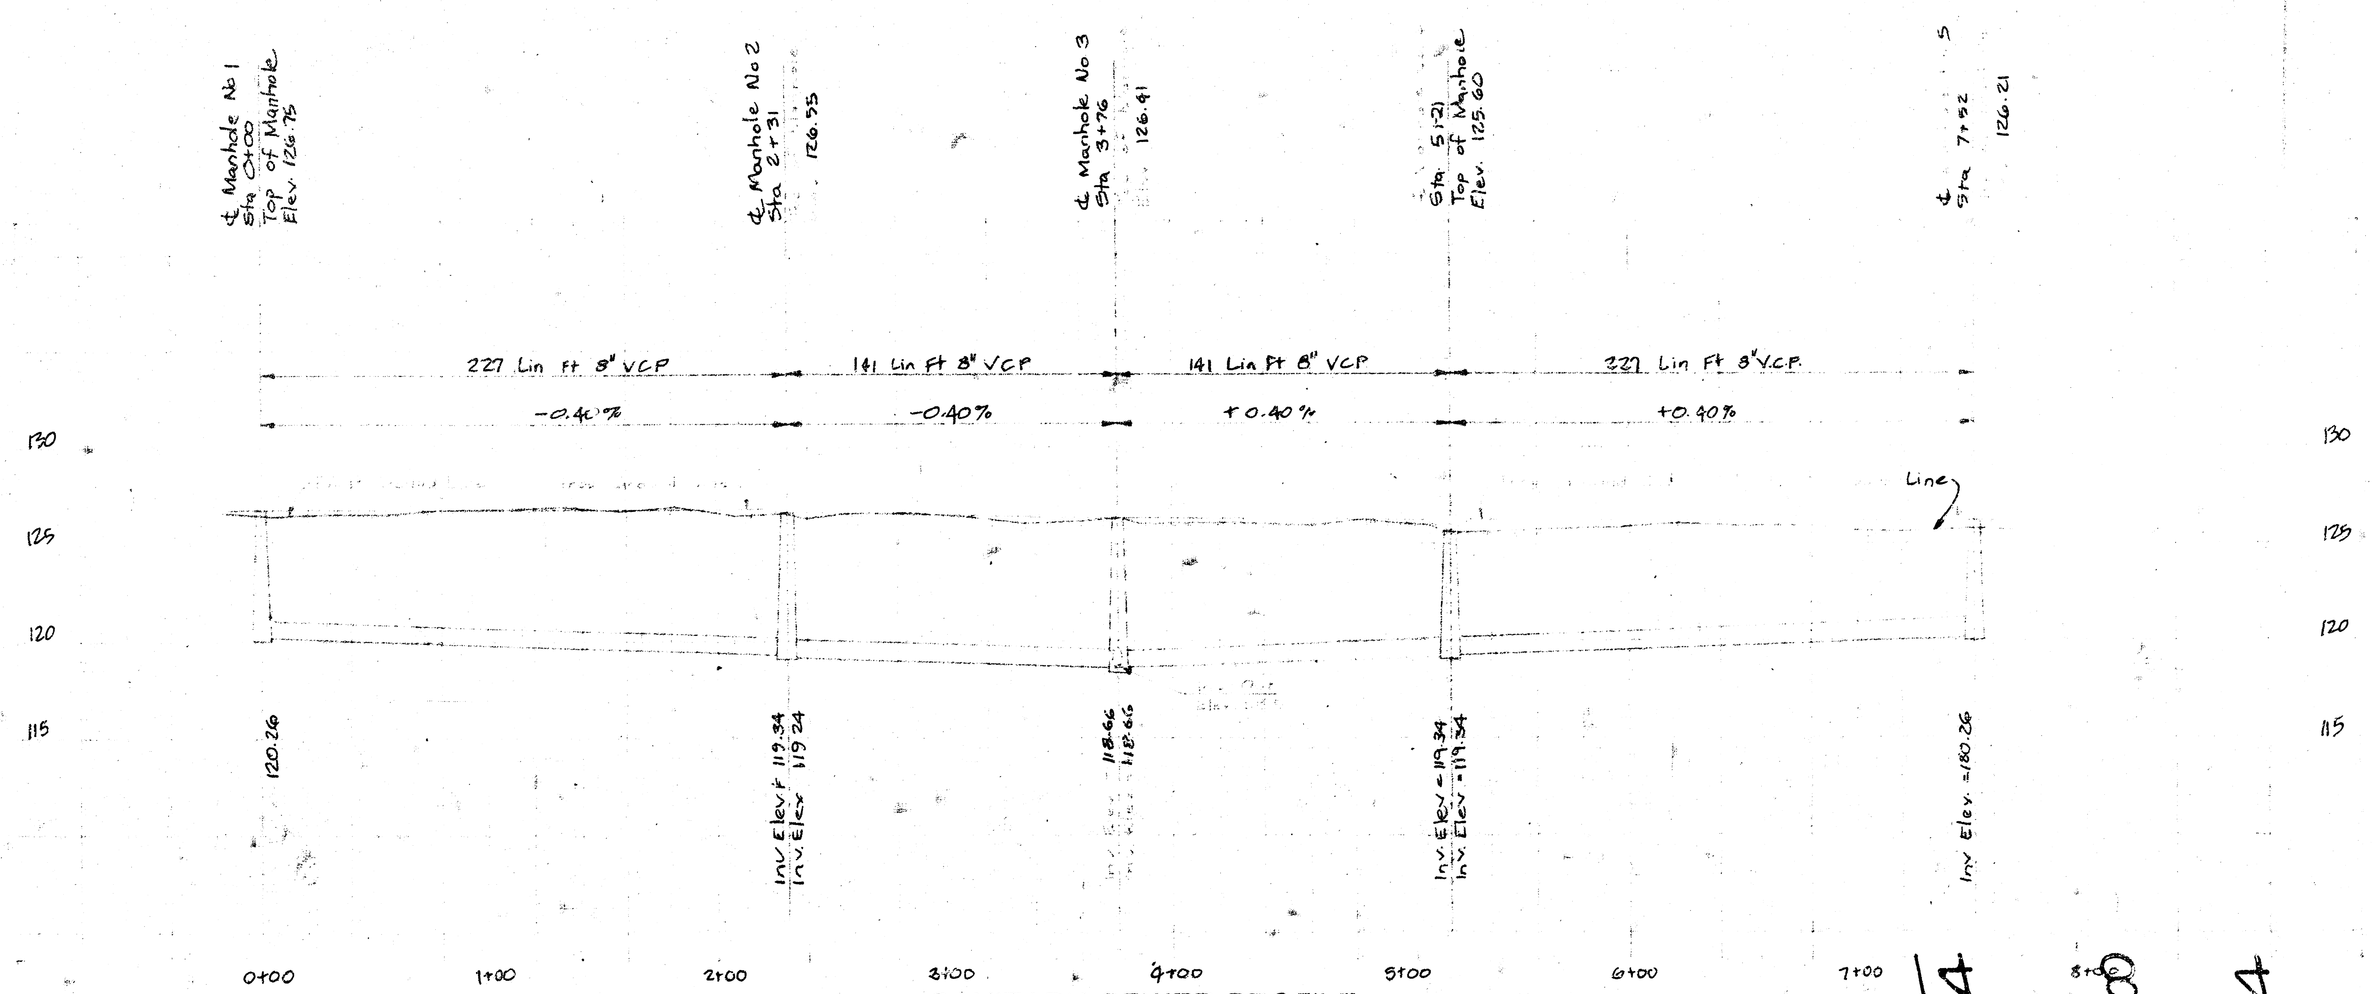

SANITARY SEWER PROFILE

14 8 4 13

A THIRTY-TWO UNIT ELDERLY HOUSING DEVELOPMENT
FOR THE HOUSING AUTHORITY OF THE CITY OF WICHITA, KANSAS

sheet X of