
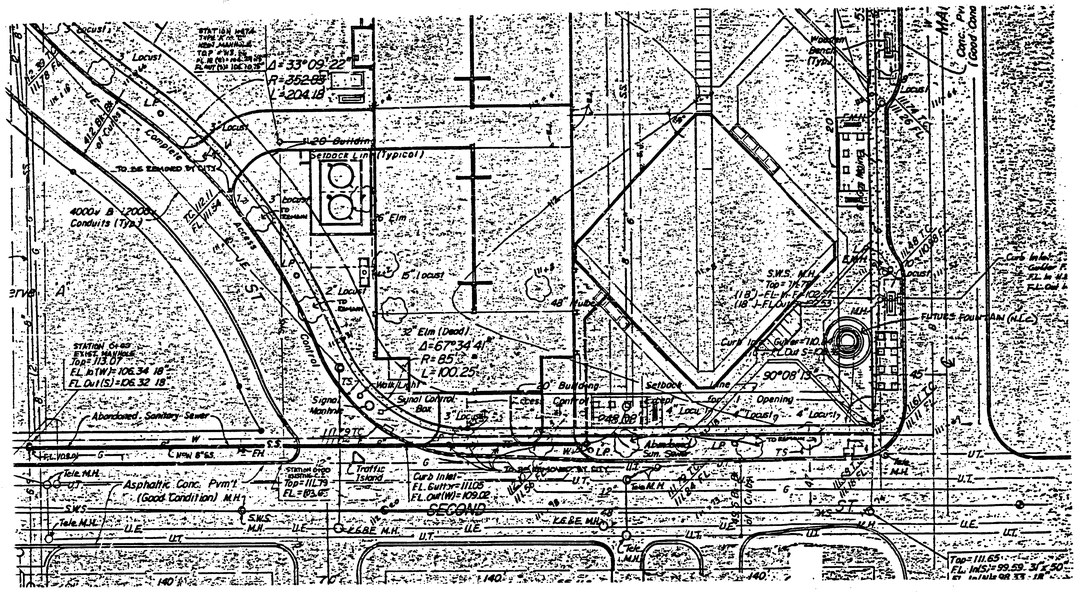


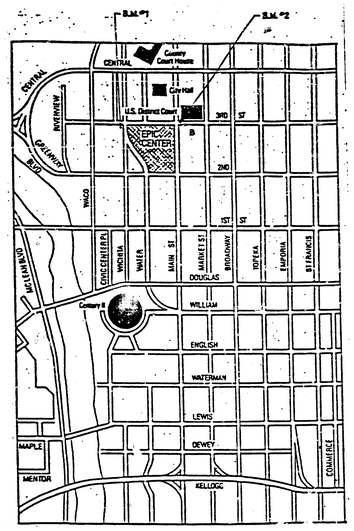


LOCATION PLAN

MECHANICAL SITE PLAN

1" = 40'-0"

BENCH MARK:
1. N.E. Cor. Conc. Base, Railroad Control Box, S.W. Cor., Wichita ST. & 3rd ST. Elev. 114.07 City Datum.
2. "o" on Back of Walk on N. Line 3rd St. 5' E. of E. Line Main ST. Elev. 112.71 City Datum.

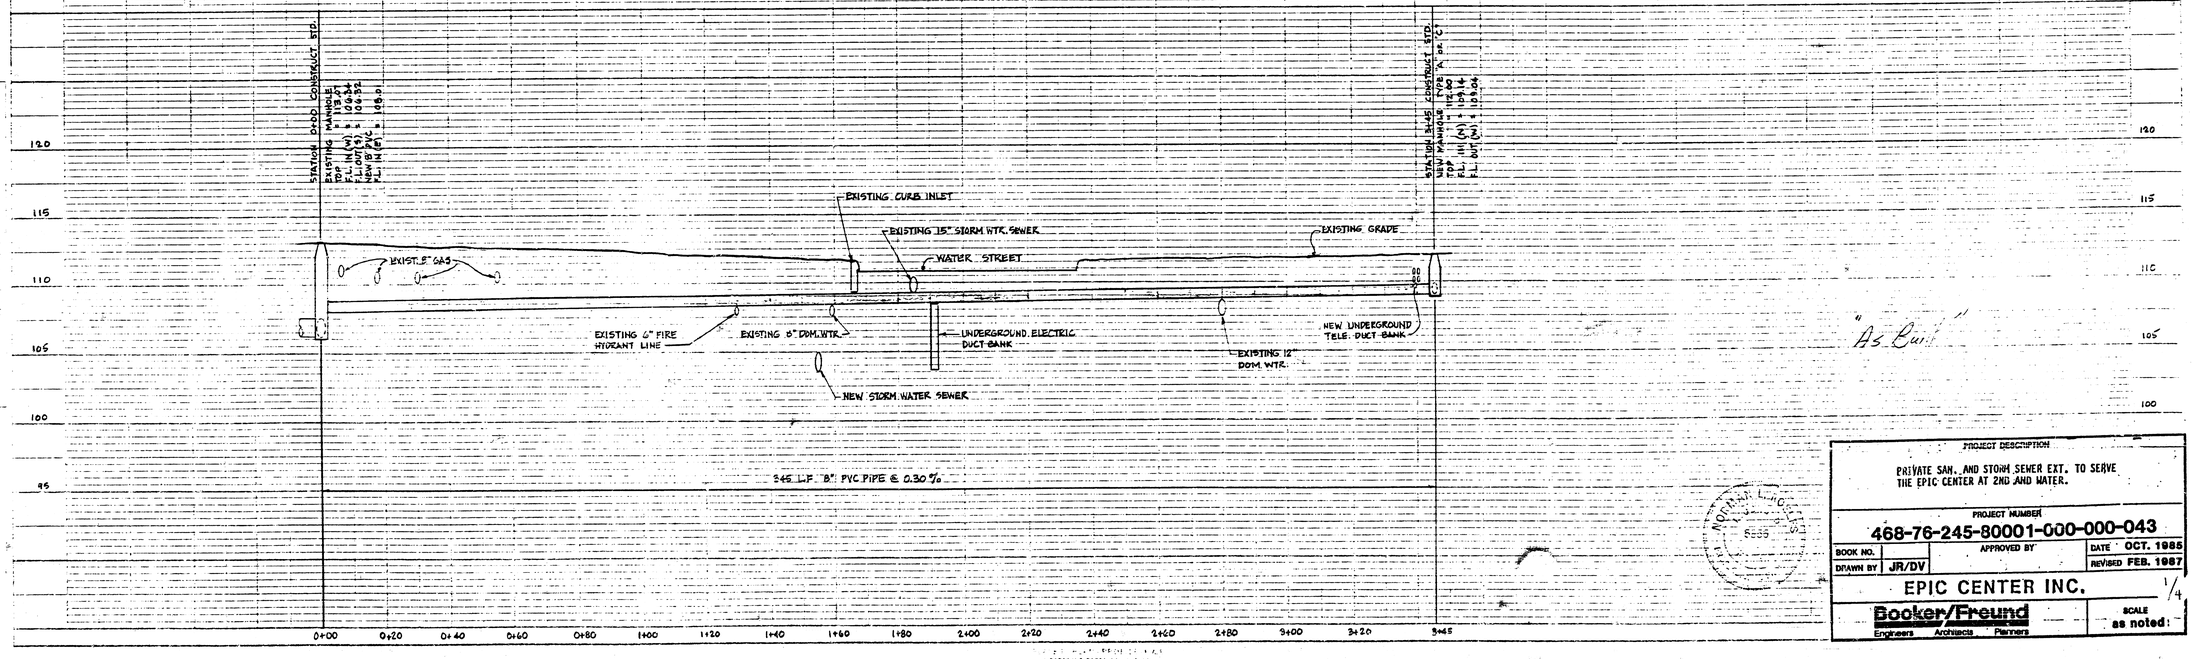

"As Built"

PROJECT DESCRIPTION
PRIVATE SAN. AND STORM SEWER EXT. TO SERVE THE EPIC CENTER AT 2ND AND WATER.

PROJECT NUMBER
468-76-245-80001-000-000-043


BOOK NO.	APPROVED BY	DATE OCT. 1985
DRAWN BY JR/DV		REVISED FEB. 1987

EPIC CENTER INC. 1/4

Booker/Freund Engineers Architects Planners

SCALE as noted:

FILMED FROM THE BEST AVAILABLE COPY

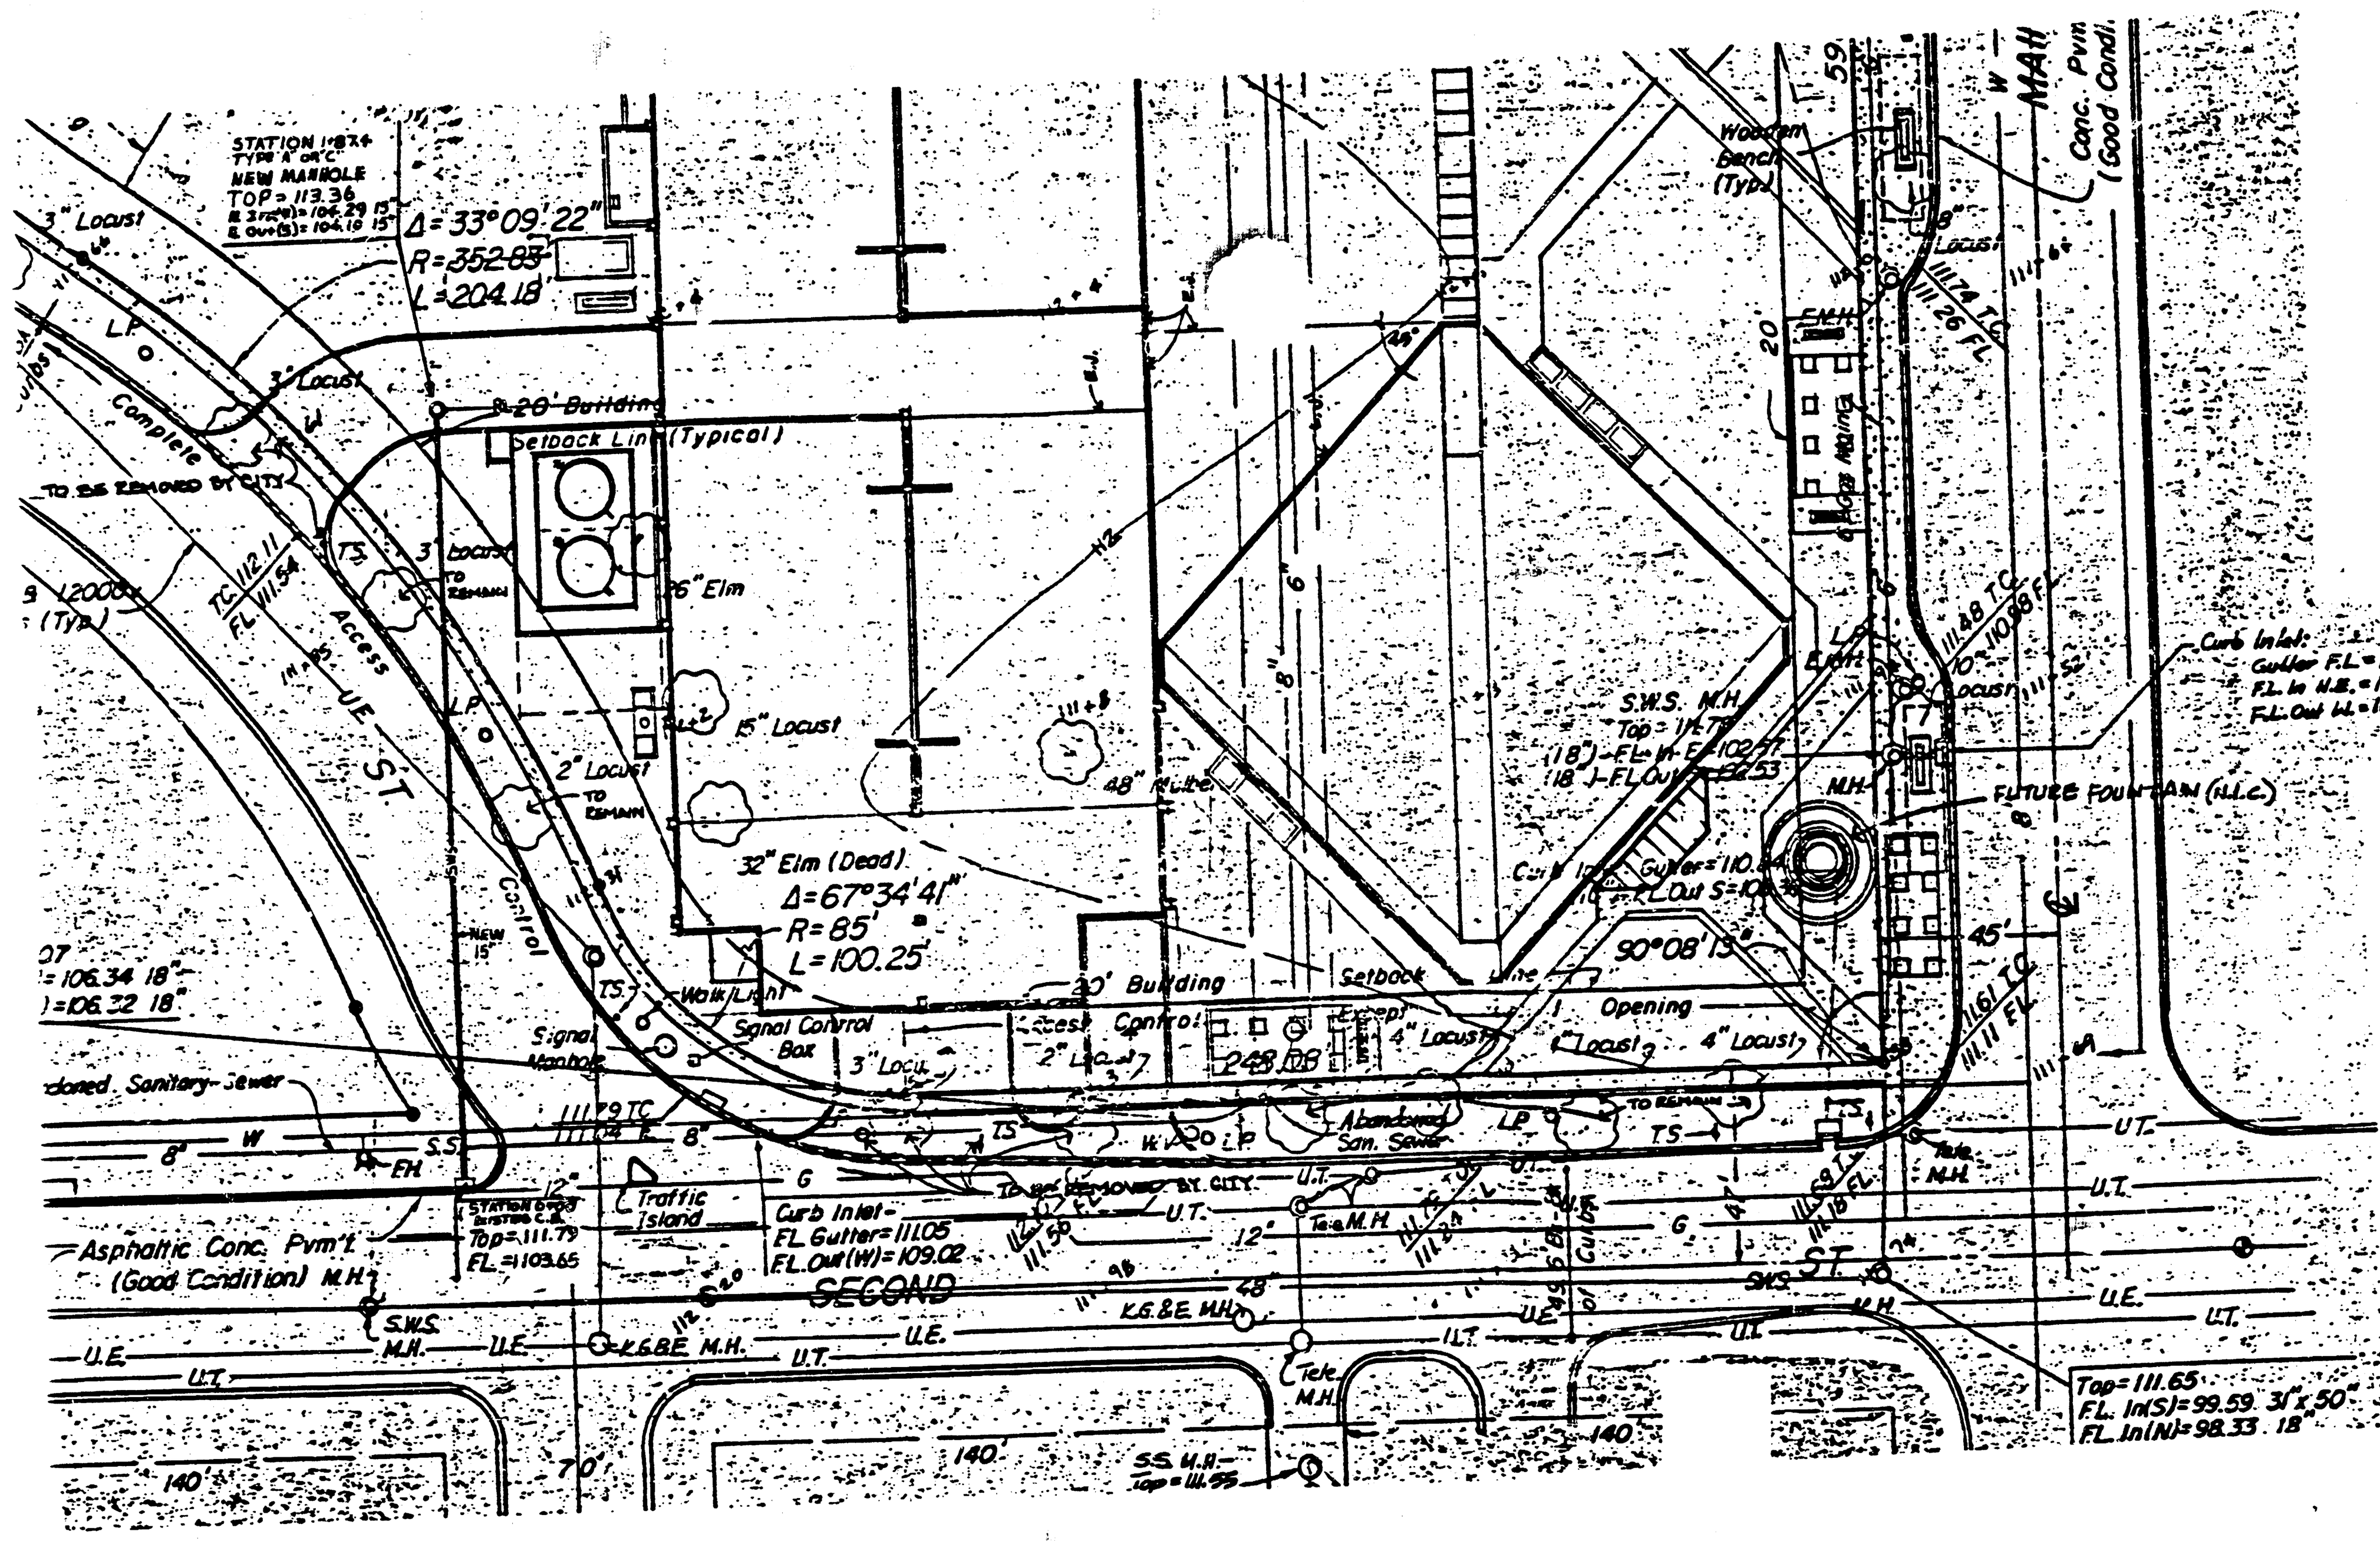


MECHANICAL SITE PLAN


1" = 40'-0"

BENCH MARK: 1. N.E. Cor. Conc. Base, Railroad Control Box, S.W. Cor., Wichita ST. & 3rd ST. Elev. 114.07 City Datum.

2. "□" on Back of Walk on N. Line 3rd St. 5' E. of E. Line Main ST. Elev. 112.71 City Datum.

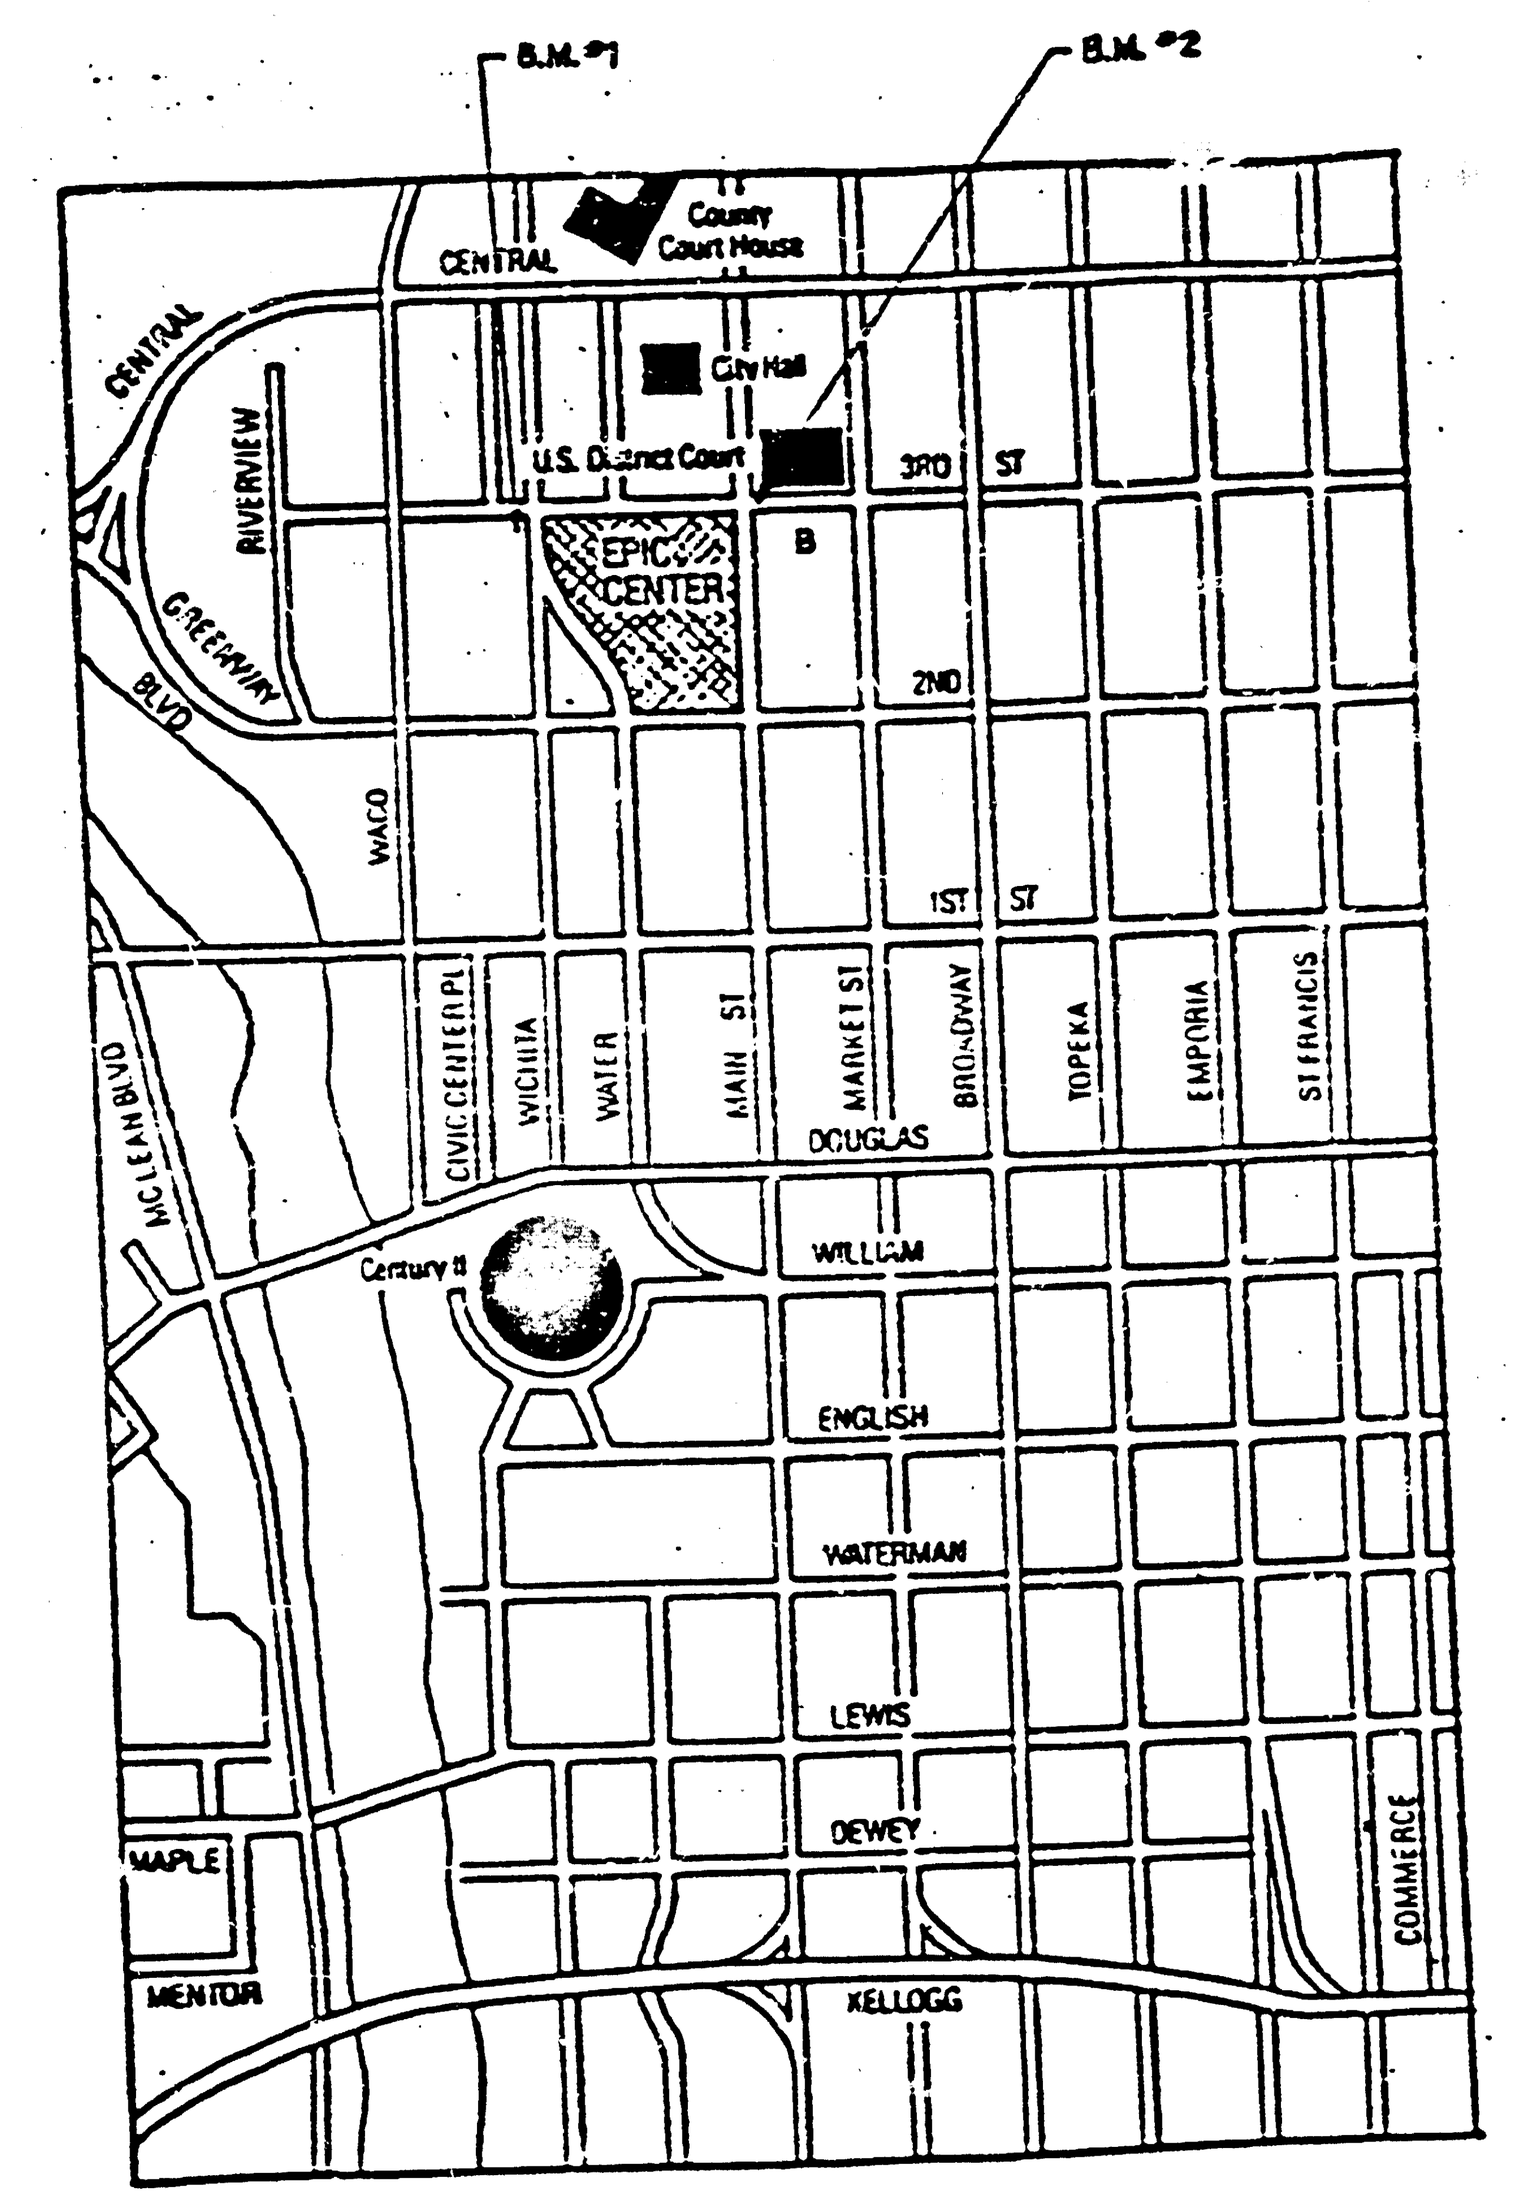

LOCATION PLAN

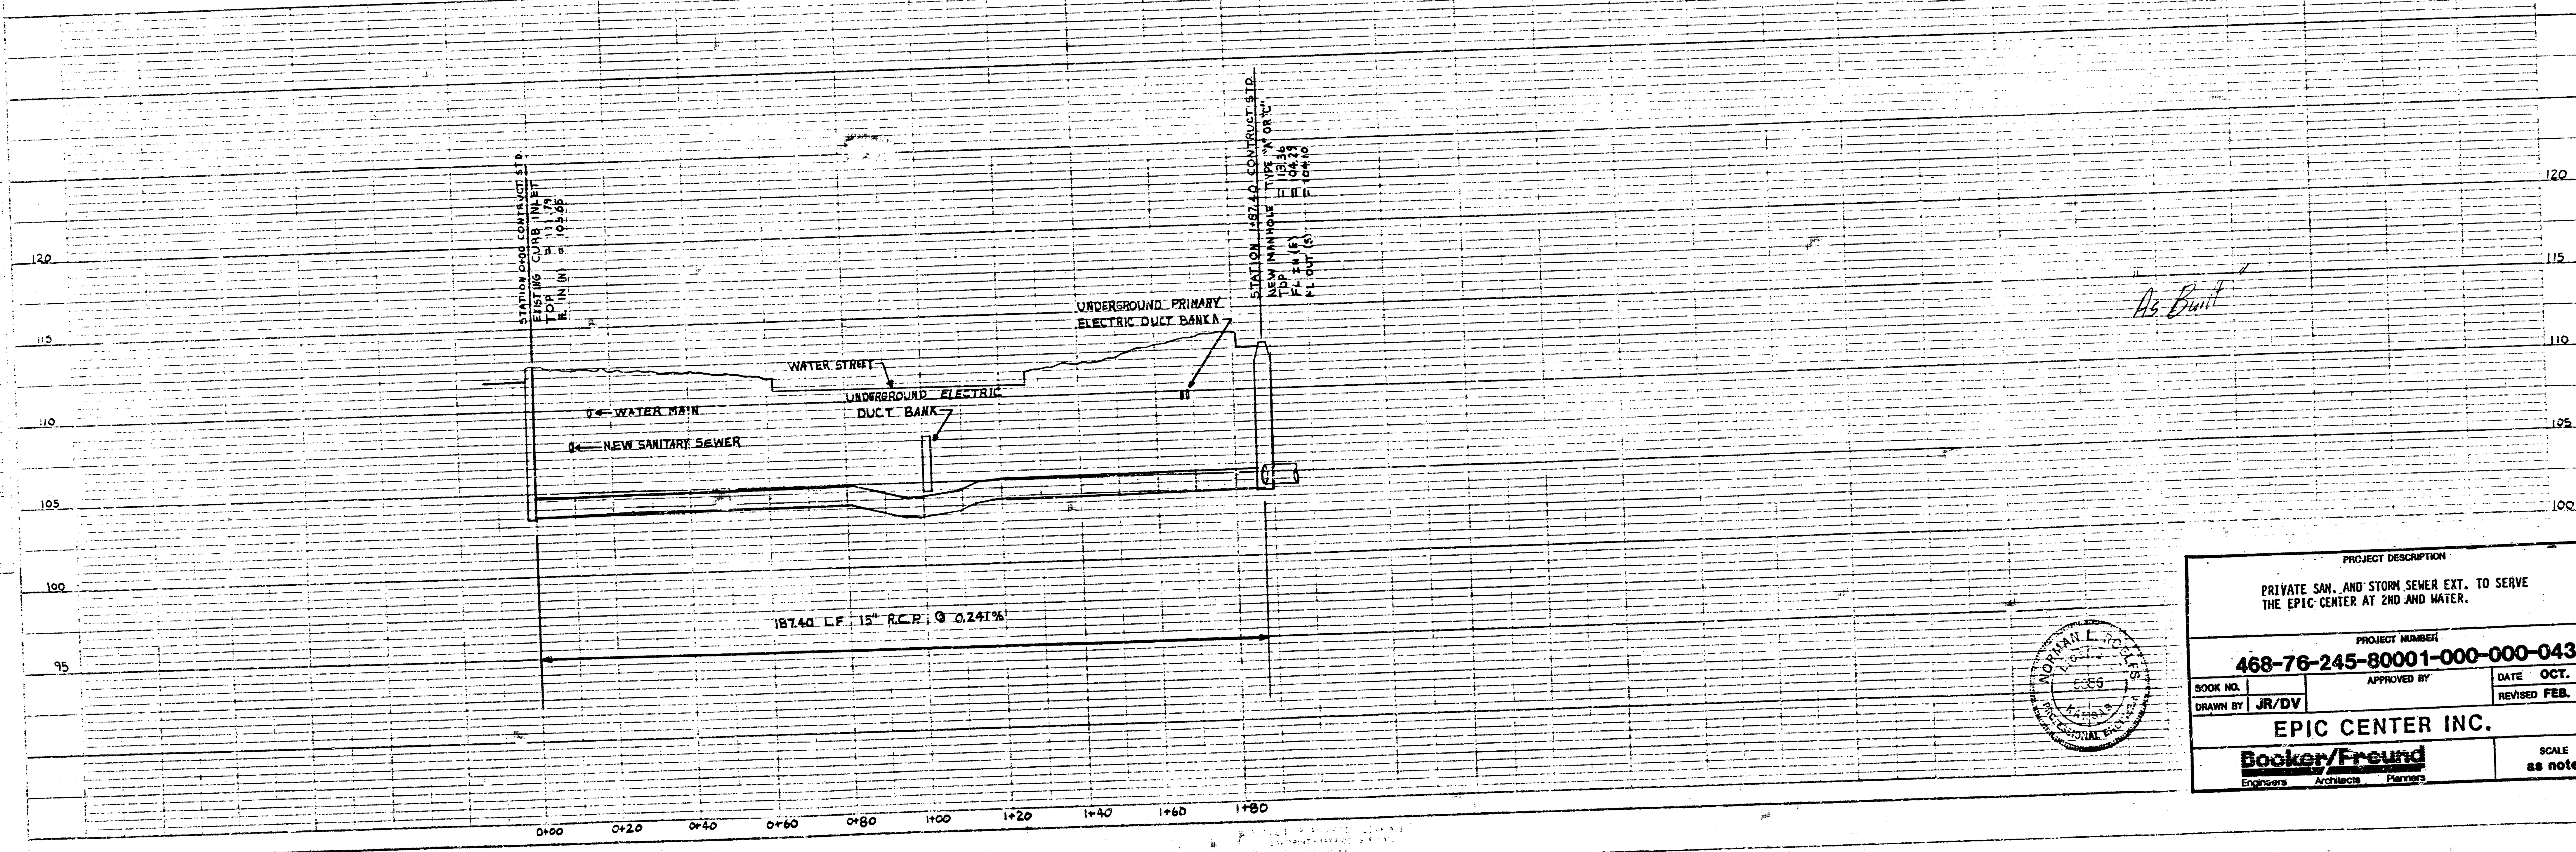

PROJECT DESCRIPTION

PRIVATE SAN. AND STORM SEWER EXT. TO SERVE THE EPIC CENTER AT 2ND AND WATER.

PROJECT NUMBER

468-76-245-80001-000-000-043

BOOK NO.		APPROVED BY	DATE OCT. 1985
DRAWN BY	JR/DV		REVISED FEB. 1987

EPIC CENTER INC.

Booker/Freund Engineers Architects Planners

SCALE as noted


2/4


NORMAN L. ROELFS 5365 KANSAS PROFESSIONAL ENGINEER

FILMED FROM THE BEST AVAILABLE COPY

MECHANICAL SITE PLAN

1" = 40'-0"

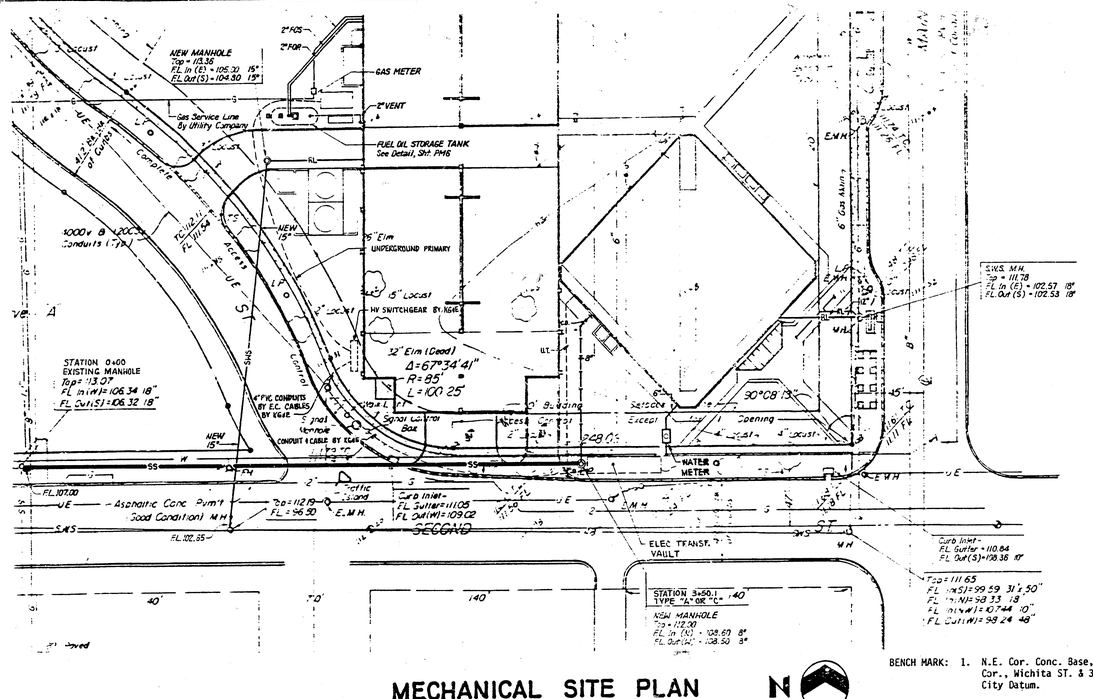

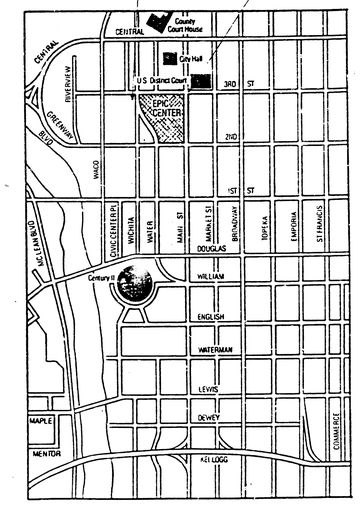

LOCATION PLAN

BENCH MARK: 1. N.E. Cor. Conc. Base, Railroad Control Box, S.W. Cor., Wichita ST. & 3rd ST. Elev. 114.07 City Datum.


2. "a" on Back of Walk on N. Line 3rd St. 5' E. of E. Line Main ST. Elev. 112.71 City Datum.

APPROVED AS NOTED
By CITY ENGINEER, WICHITA
Sanitary Sewer: 10/24/85
Storm Sewer: 10/24/85
Driveway:
Water:
Paving:

NOTE TO CONTRACTOR

This project will be constructed under the supervision of the CITY ENGINEER and conforming to the SPECIFICATIONS of the CITY OF WICHITA. The CONTRACTOR will pay the City of Wichita for all costs of plan review, inspection and booking per contract.

NOTE: VERIFY DEPTH OF ALL UTILITIES BEFORE EXCAVATION

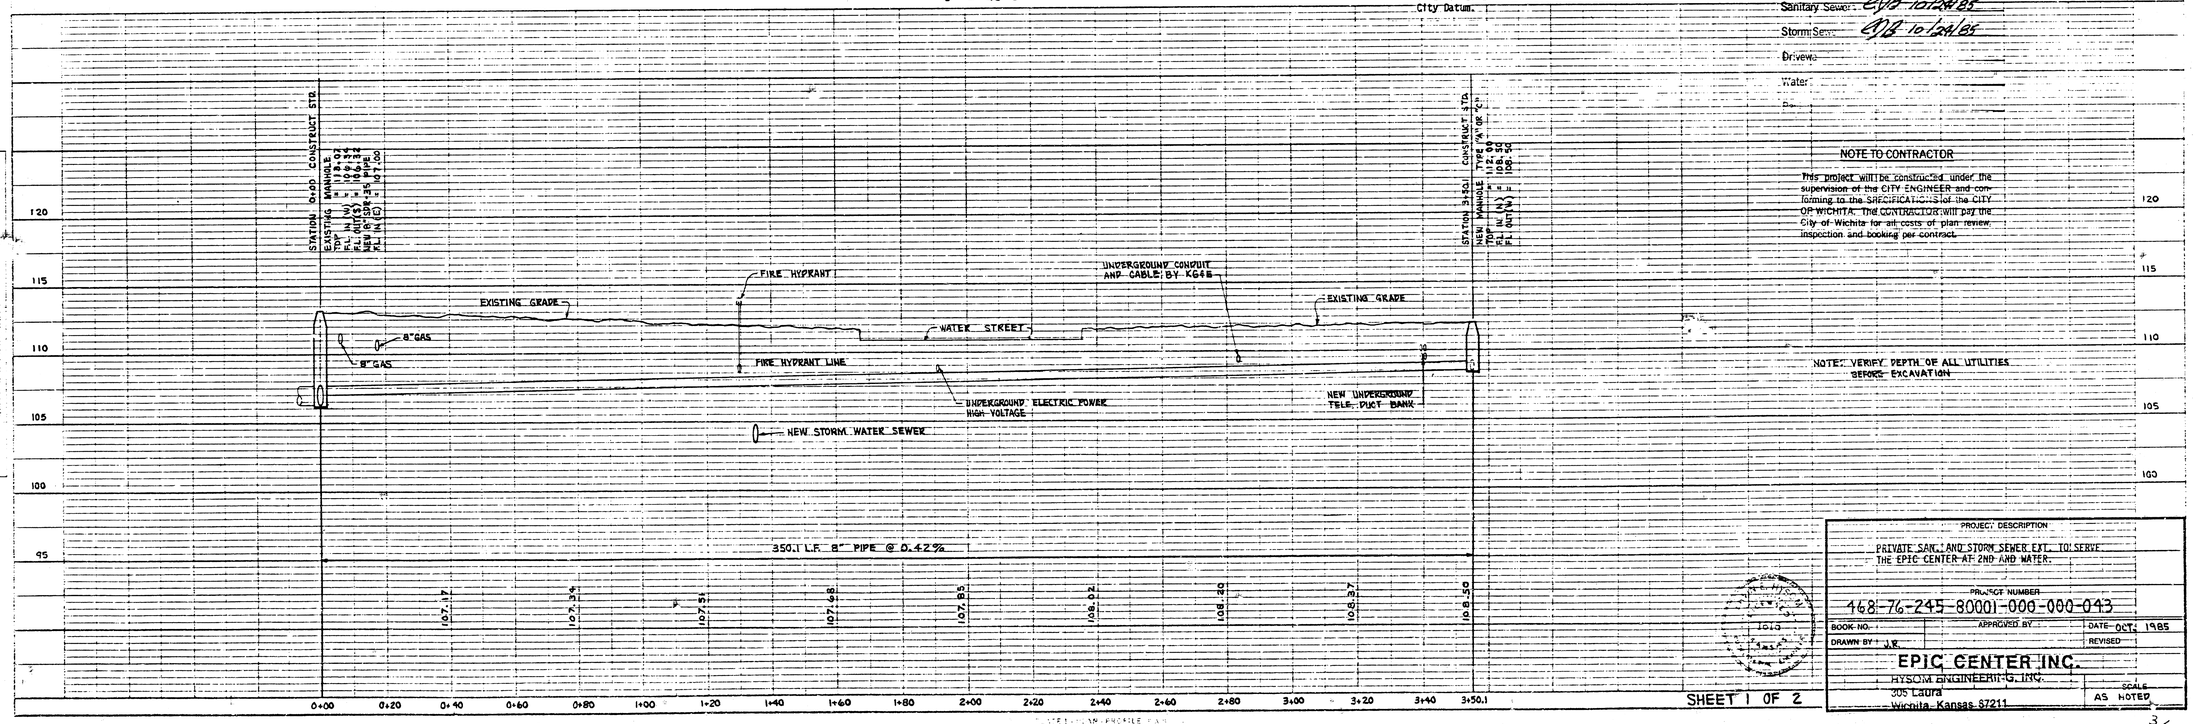

PROJECT DESCRIPTION	PRIVATE SAN. AND STORM SEWER EXT. TO SERVE THE EPIC CENTER AT 2ND AND WATER.
PROJECT NUMBER	468-76-245-80001-000-000-043
BOOK NO.	APPROVED BY
DATE	OCT. 1985
DRAWN BY	J.R.
REVISED	
	EPIC CENTER INC.
	HYSOM ENGINEERING INC. 305 Laura Wichita, Kansas 67211
SCALE	AS NOTED


SHEET 1 OF 2

3/4

FILMED FROM THE BEST


PLAN

PROFILE

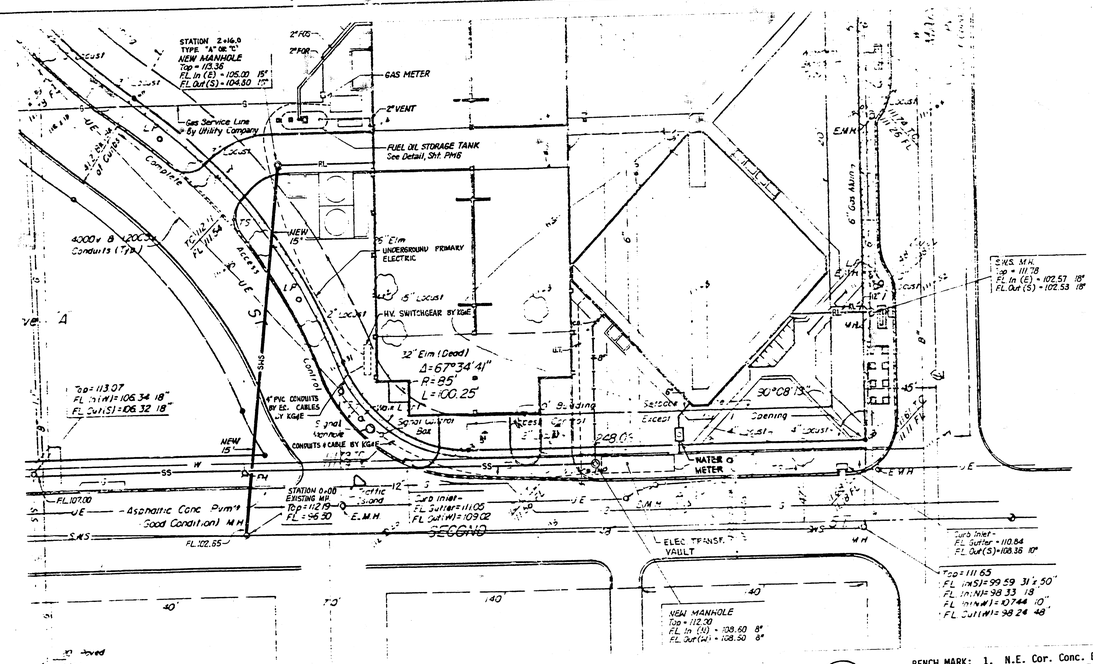


MECHANICAL SITE PLAN

1" = 40'-0"

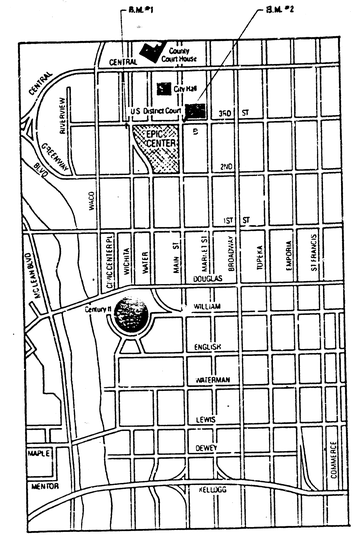

LOCATION PLAN

BENCH MARK:
1. N.E. Cor. Conc. Base, Railroad Control Box, S.W. Cor., Wichita ST. & 3rd ST. Elev. 114.07 City Datum.
2. "□" on Back of Walk on N. Line 3rd St. 5' E. of E. Line Main ST. Elev. 112.71 City Datum.

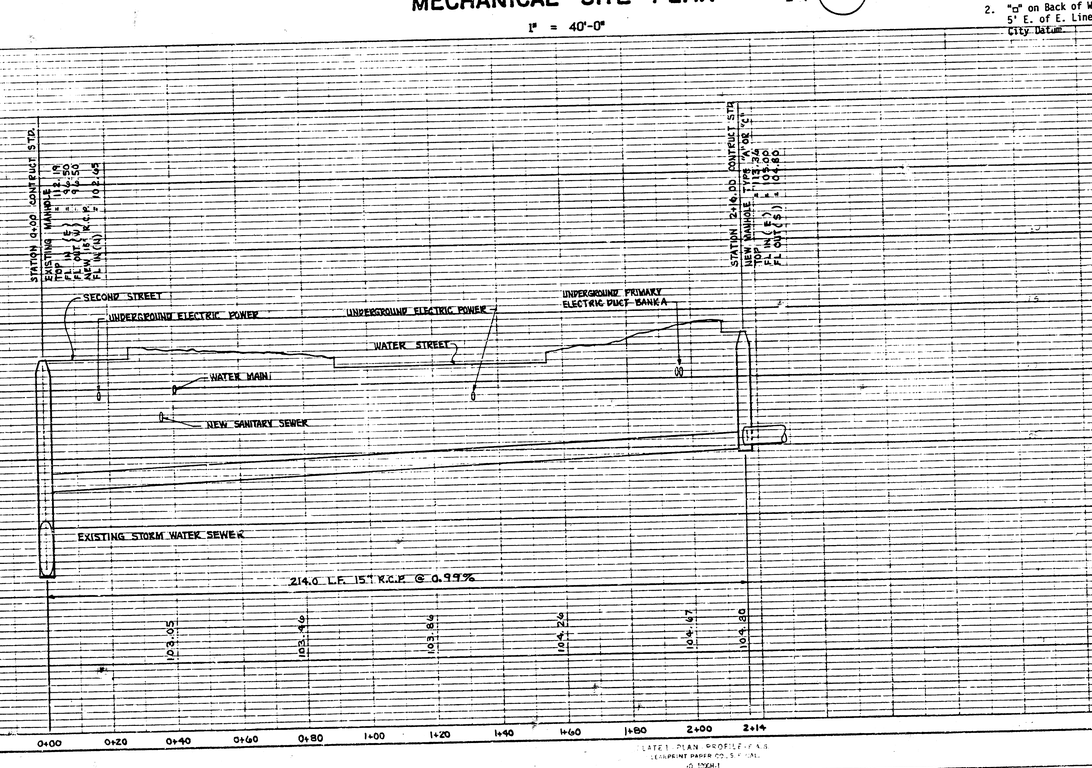

NOTE: VERIFY DEPTH OF ALL UTILITIES BEFORE EXCAVATION

SHEET 2 OF 2

PROJECT DESCRIPTION	PRIVATE SAN. AND STORM SEWER EXT. TO SERVE THE EPIC CENTER AT 2ND AND WATER.
PROJECT NUMBER	468-76-245-80001-000-000-043
BOOK NO.	APPROVED BY
DATE	OCT. 1985
DRAWN BY	JK
REVISED	
	EPIC CENTER INC.
	HYSOM ENGINEERING, INC. 305 Laura Wichita, Kansas 67211
SCALE	AS NOTED

4/4

FILMED FROM THE BEST AVAILABLE COPY