
GAS SERVICE CO. REPORT NO LINES IN THIS AREA

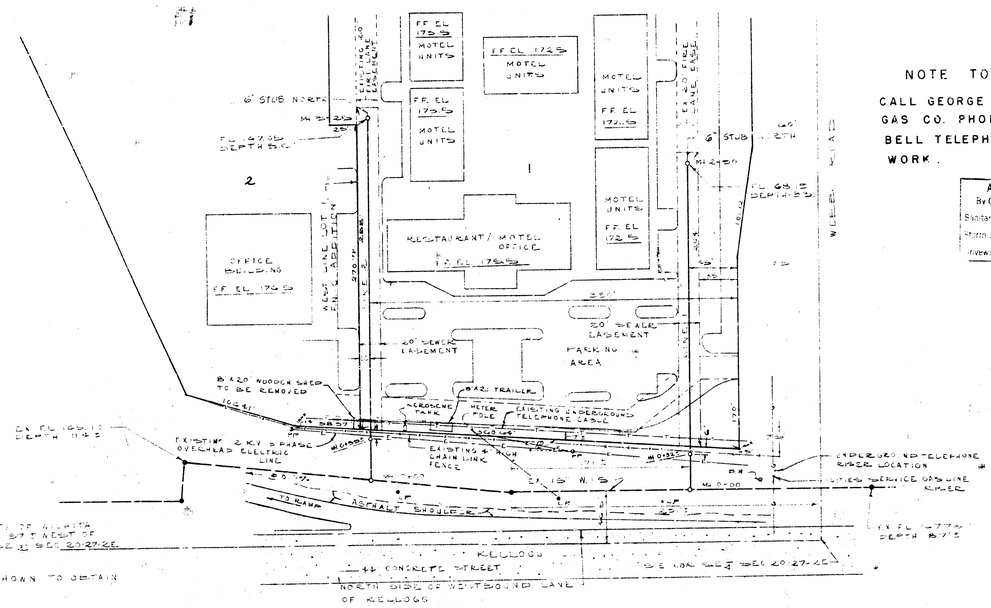

B.M. ELEVATIONS - WEST RIM OF F.I. TOP OF HYDRANT 44' SOUTH & 57' WEST OF THE S.E. COR. SEC. 8 SEC. 20-27-2E

NOTE: ADD 0.48' TO ELEVATIONS SHOWN TO OBTAIN CITY OF WICHITA DATUM

NOTE TO CONTRACTOR:

CALL GEORGE HOFSESS - CITIES SERVICE GAS CO. PHONE 524-0491 AND SOUTHWESTERN BELL TELEPHONE CO. BEFORE COMMENCING WORK.

7-24-74

APPROVED AS NOTED
By CITY ENGINEER OF WICHITA
Sanitary sewers 8'-0.E.)
Storm sewers
Driveway Approaches

NOTE TO CONTRACTOR

SEWER EXTENSION FOR ADDITION

Rev. 7-23-74

Note: Building Layout furnished by others
Manholes- Poured concrete to City of Wichita Specs.

PROJECT: DBKW 703072

