GAS SERVICE CO. REPORT NO LINES IN THIS AREA

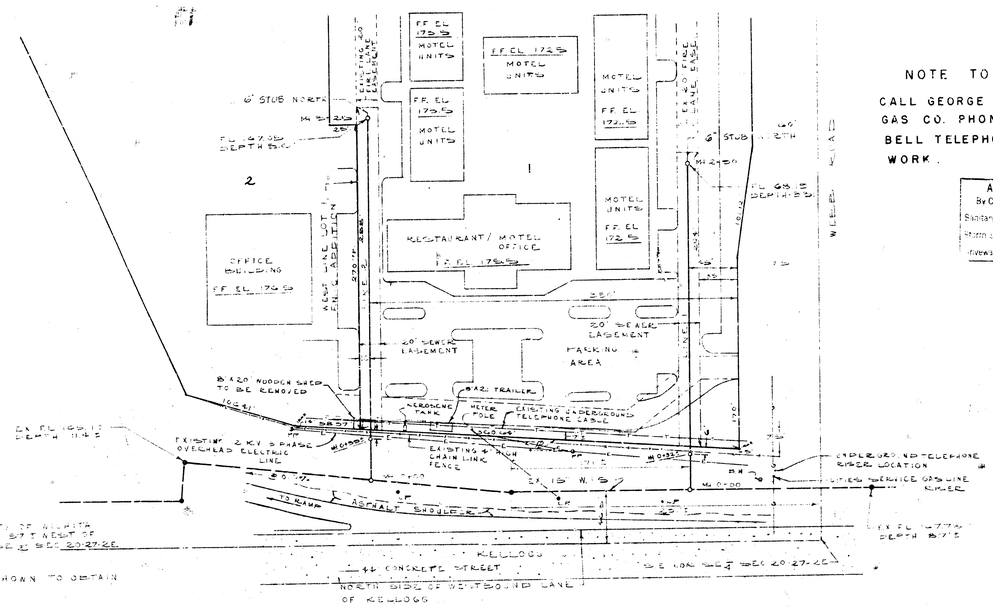

NOTE TO CONTRACTOR:

CALL GEORGE HOFSESS - CITIES SERVICE GAS CO. PHONE 524-0491 AND SOUTHWESTERN BELL TELEPHONE CO. BEFORE COMMENCING WORK.

7-24-74

APPROVED AS NOTED
By CITY ENGINEER OF WICHITA
Sanitary Sewers 8"-O.E.J.
Storm Sewers
Driveway Approaches

NOTE TO CONTRACTOR
This project will be [illegible] under the supervision of the City Engineer and operation of the specifications of the City of Wichita. [illegible] TRACTOR [illegible] Violation of [illegible] inspection.

Note: Building Layout furnished by others
Manholes - Poured concrete to City of Wichita Specs.
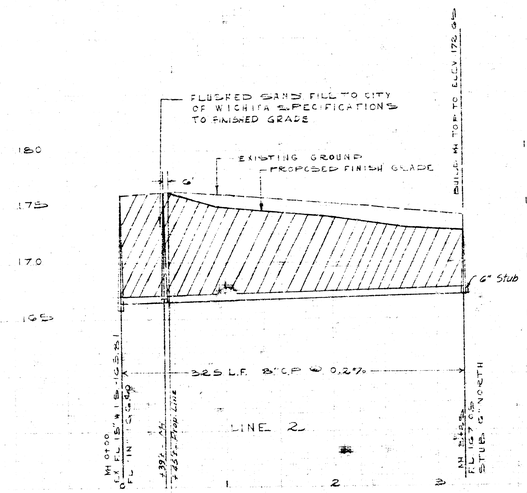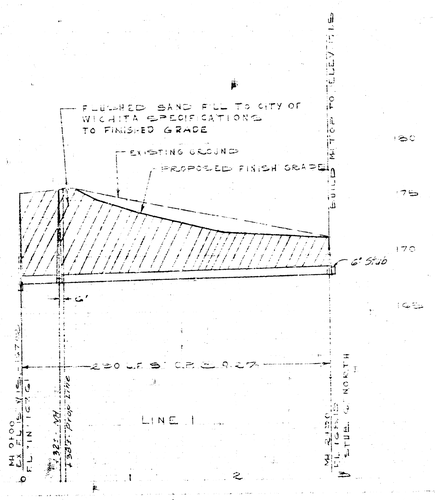
PROJECT: DBKW 703072