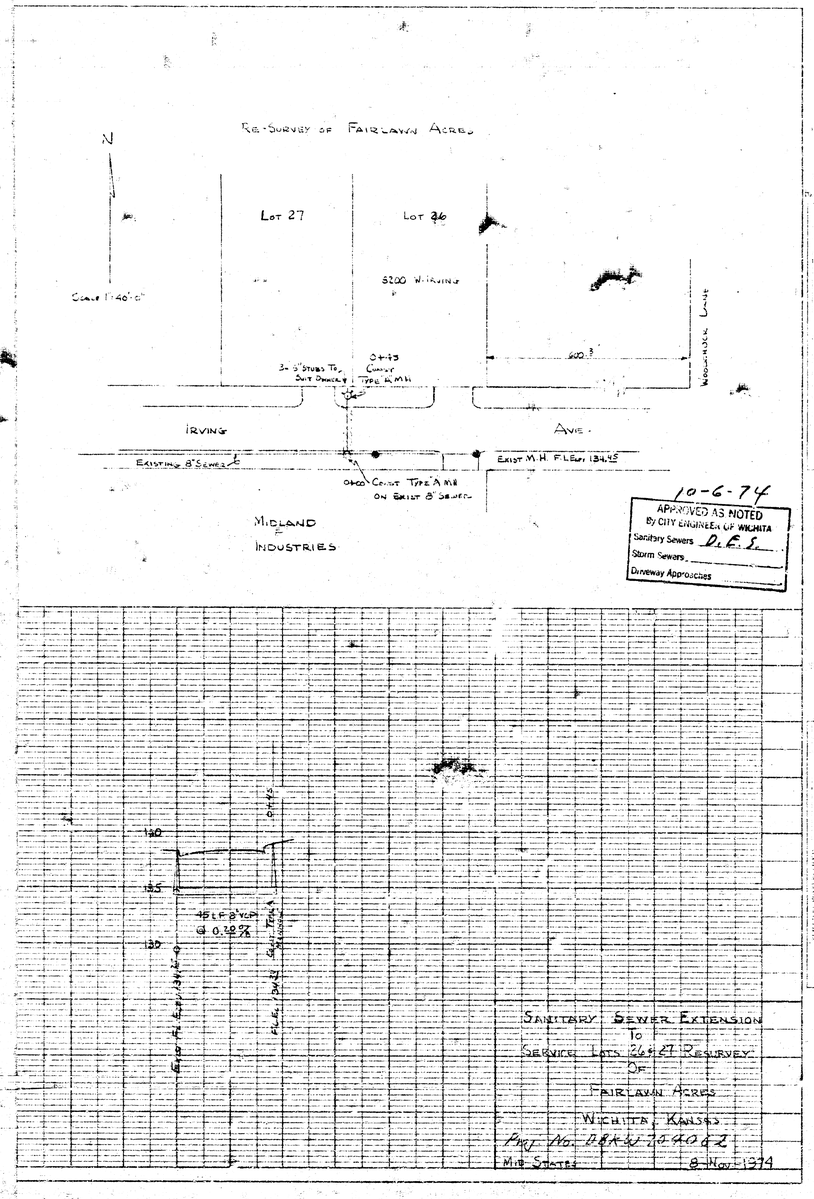

RE-SURVEY OF FAIRLAWN ACRES
N
LOT 27
LOT 26
5200 W. IRVING
SCALE 1"=40'-0"
600.3'
3-3" STUBS TO SUIT OWNER
CONN. TYPE A M.H.
IRVING
AVE.
EXISTING 8" SEWER
EXIST M.H. F.L.El. 1345
CONN. TYPE A MH ON EXIST 8" SEWER
MIDLAND INDUSTRIES
10-6-74
APPROVED AS NOTED
By CITY ENGINEER OF WICHITA
Sanitary Sewers D.E.S.
Storm Sewers
Driveway Approaches
130
135
140
45 LF 8" VCP @ 0.20%
EXIST. F.L. EL. 1340.0
SANITARY SEWER EXTENSION
TO
SERVICE LOTS 26 & 27 RESURVEY
OF
FAIRLAWN ACRES
WICHITA, KANSAS
PROJ. NO. 088-W-74062
MID STATES
8 NOV. 1974
