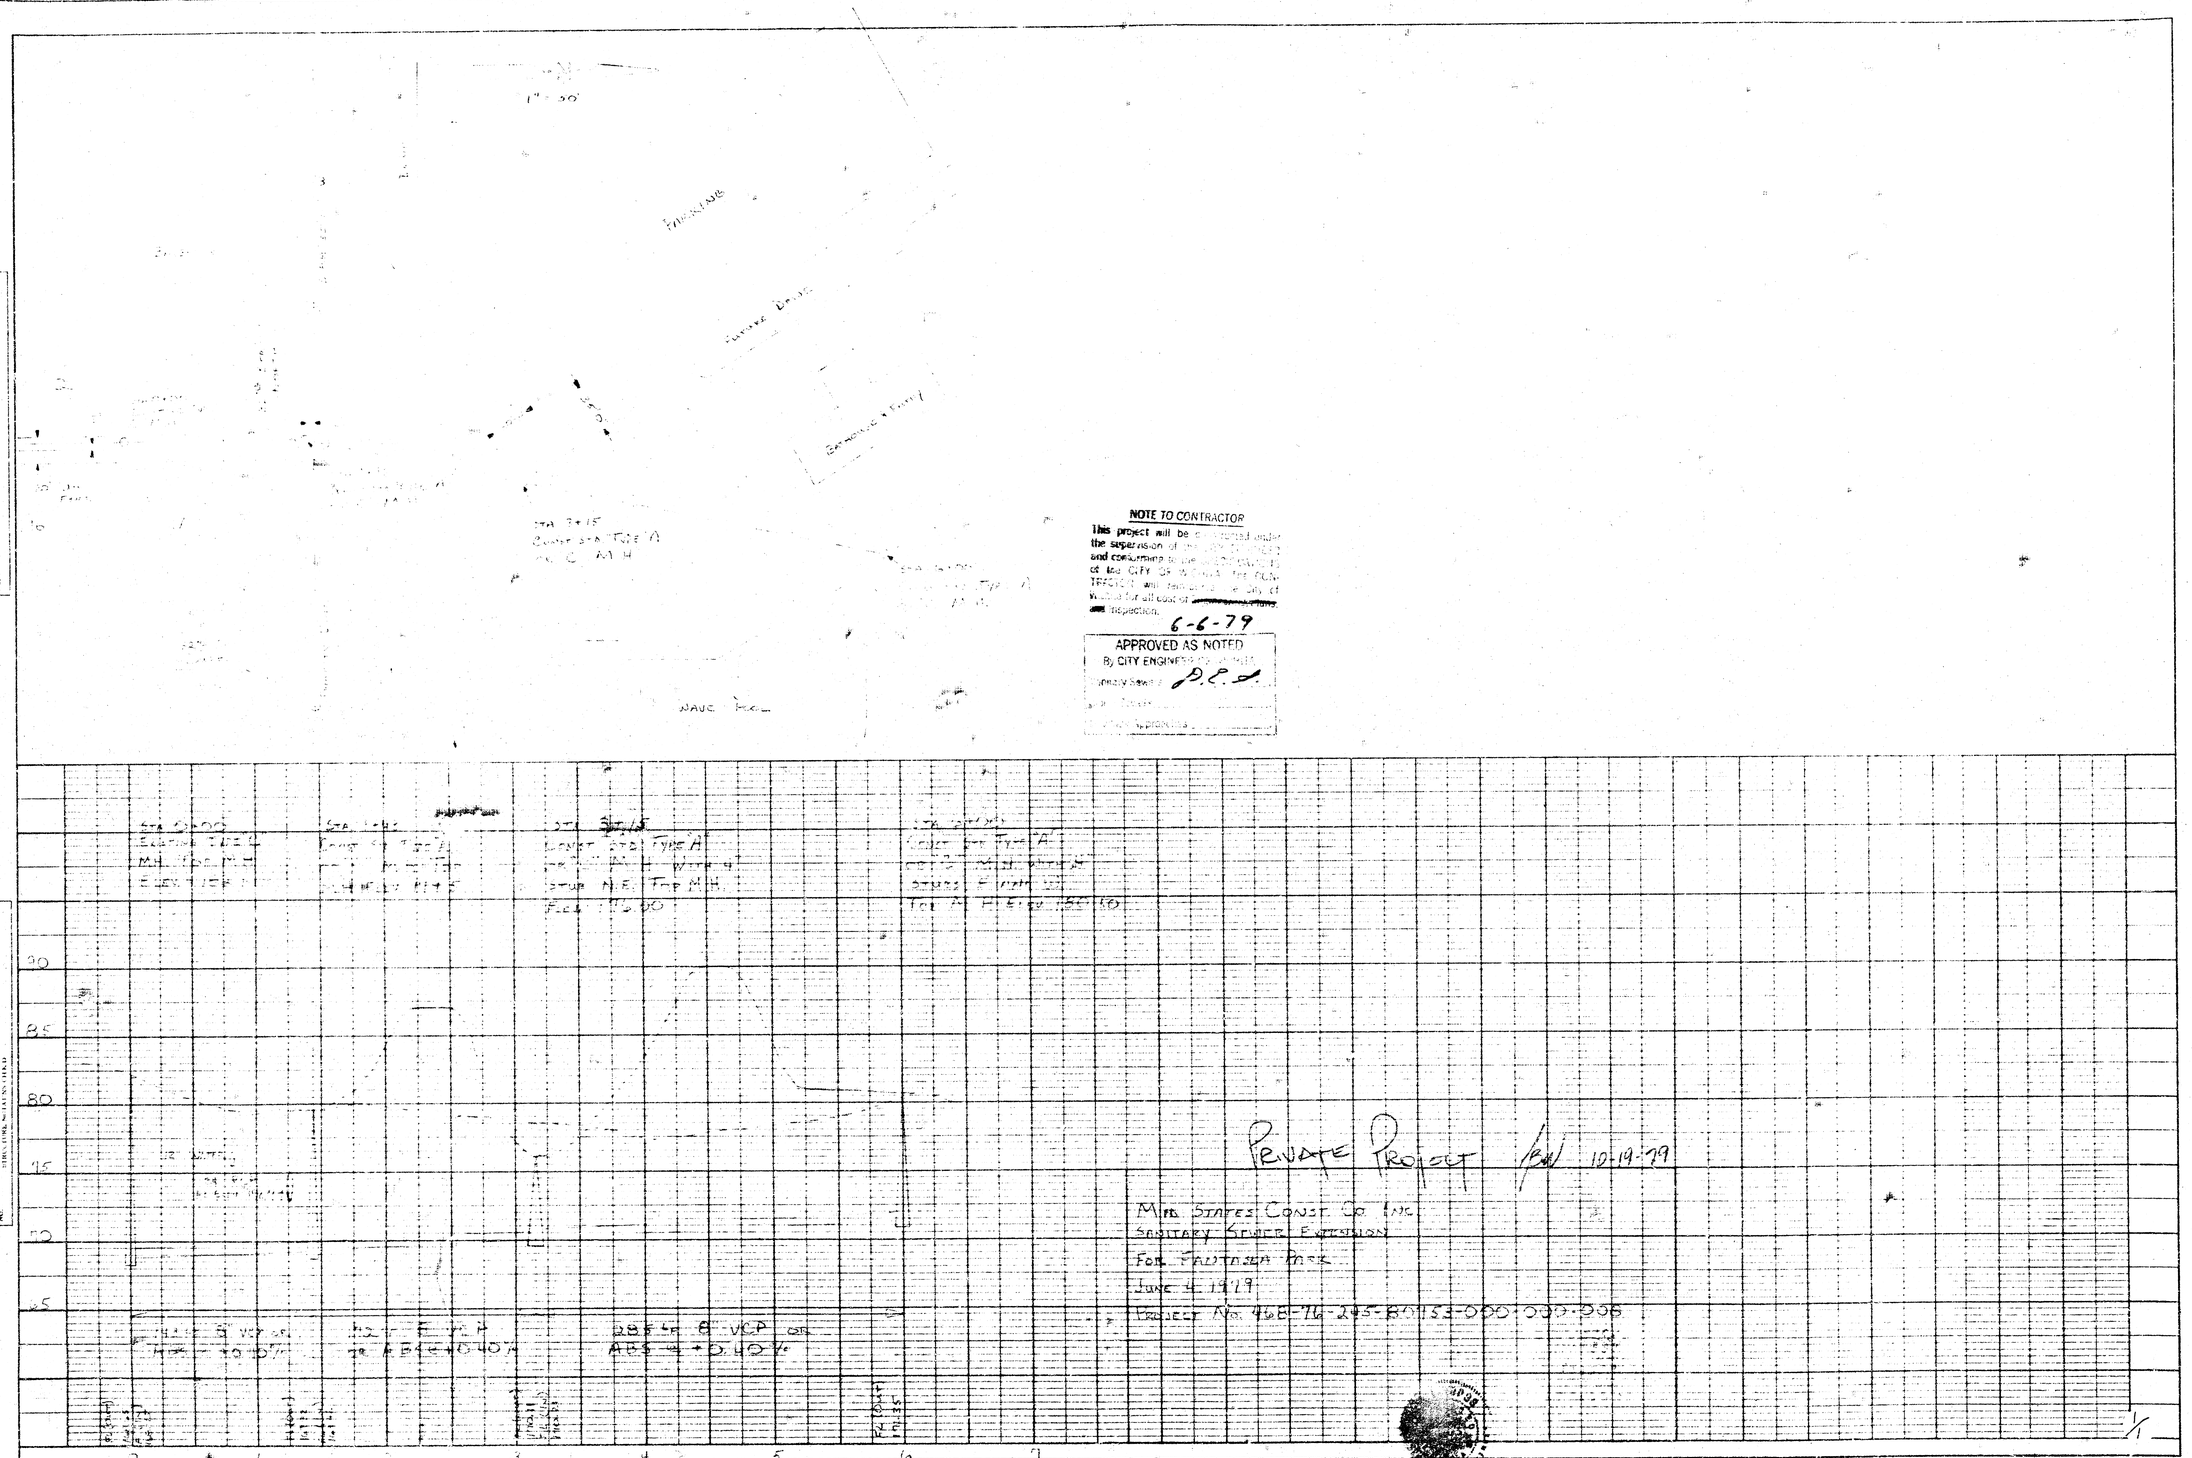

PLATE 1 - PLAN - PROFILE - F.A.S.
CLEARPRINT PAPER CO., S.F. CAL.
NO. 1000H 1

STA 0+00 = STA 1+00 LINE 5A LAT 13 MAIN 7, S.S. No. 23

14 2 5 10