GAS SERVICE CO. REPORT NO LINES IN THIS AREA.

NOTE TO CONTRACTOR:

CALL GEORGE HOFSESS - CITIES SERVICE GAS CO. PHONE 524-0491 AND SOUTHWESTERN BELL TELEPHONE CO. BEFORE COMMENCING WORK.

7-24-74

APPROVED AS NOTED
By CITY ENGINEER OF WICHITA
Sanitary Sewers 8" P.E.S.
Storm Sewers
Driveway Approaches

NOTE TO CONTRACTOR

This project will be constructed under the supervision of the CITY ENGINEER and conforming to the SPECIFICATIONS of the CITY OF WICHITA. The CONTRACTOR will reimburse the City of Wichita for all cost of [redacted] inspection.

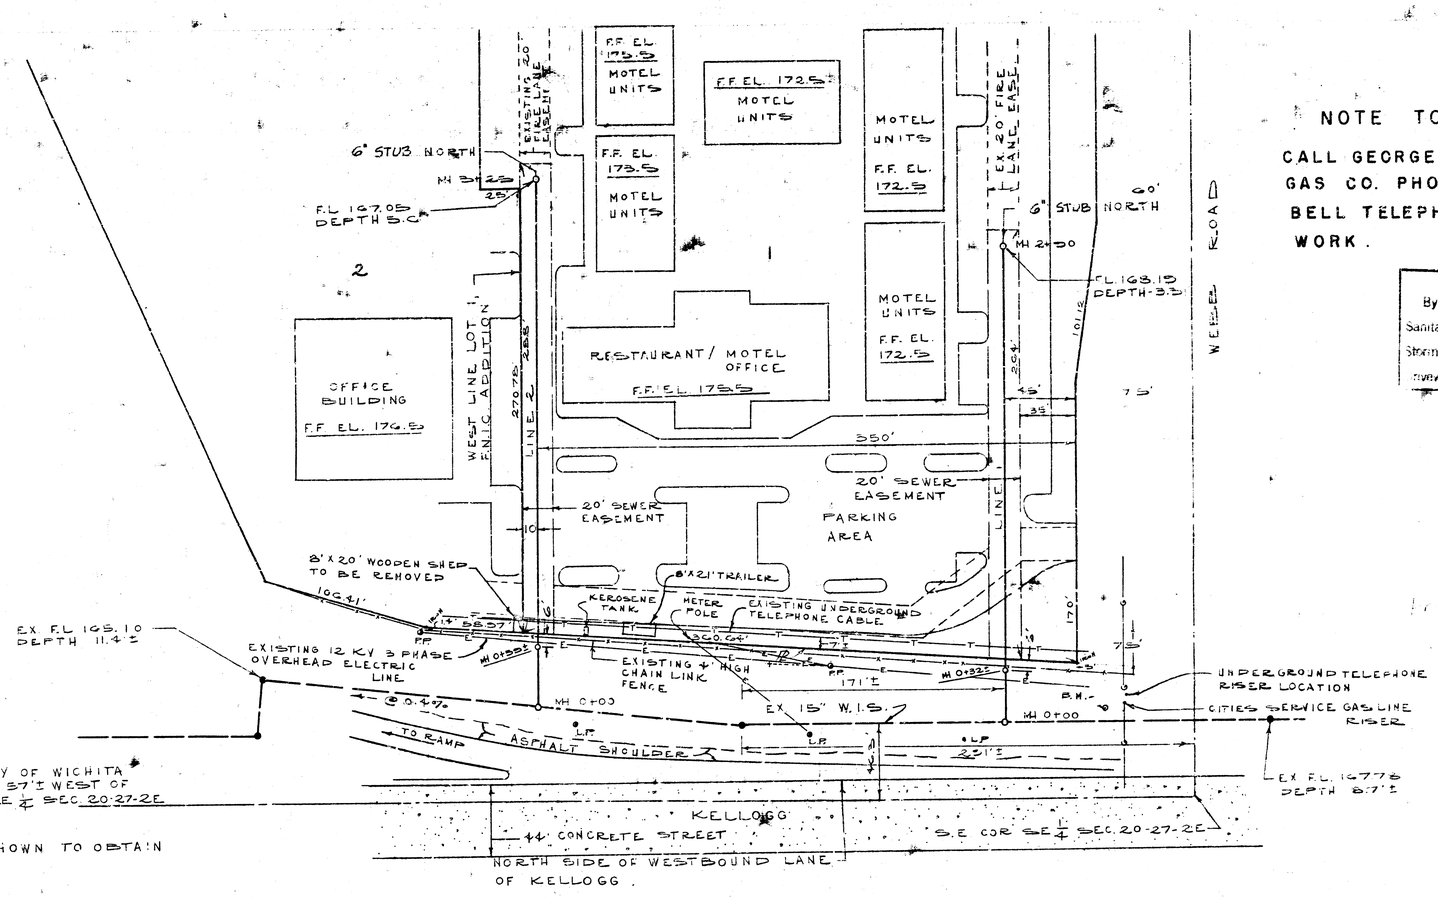

B.M.: ELEV. 176.52 - WEST RIM OF CITY OF WICHITA MH 54'± NORTH & 57'± WEST OF THE S.E. COR. SE¼ SEC. 20-27-2E

NOTE: ADD 0.35 TO ELEVATIONS SHOWN TO OBTAIN CITY OF WICHITA DATUM

Note: Building Layout furnished by others.
Manholes - Poured concrete to City of Wichita Specs.

Trunk Sanitary
SEWER EXTENSION
FNIC ADDITION

K.O. TAYLOR, P.E.
DEC. 19, 1973
REVISED JAN. 22, 1974
Rev. 7-23-74
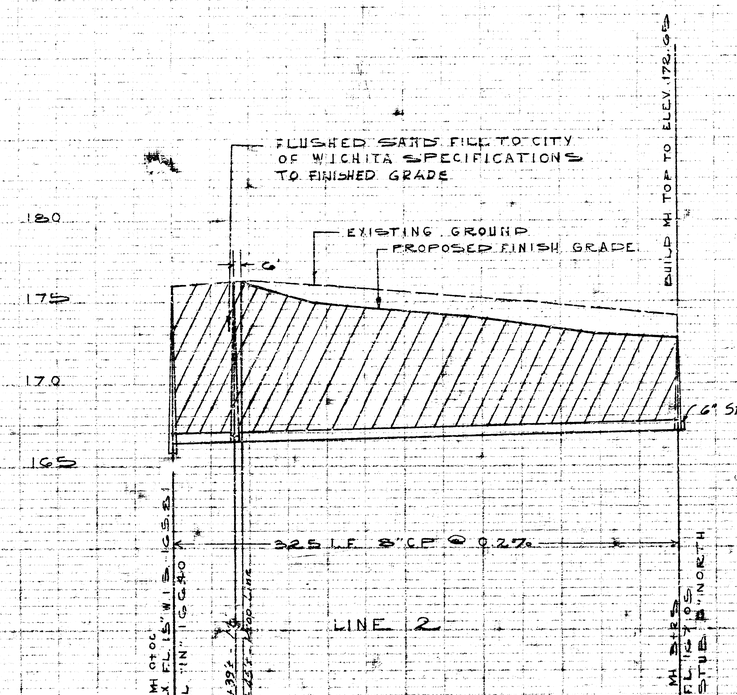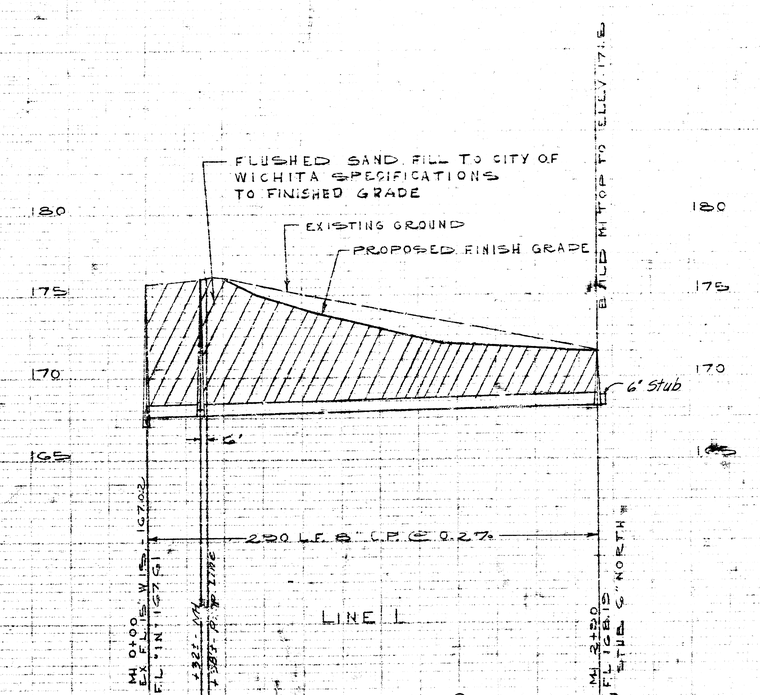
PROJECT: DBKW 703072