
GAS SERVICE CO. REPORT NO LINES IN THIS AREA.

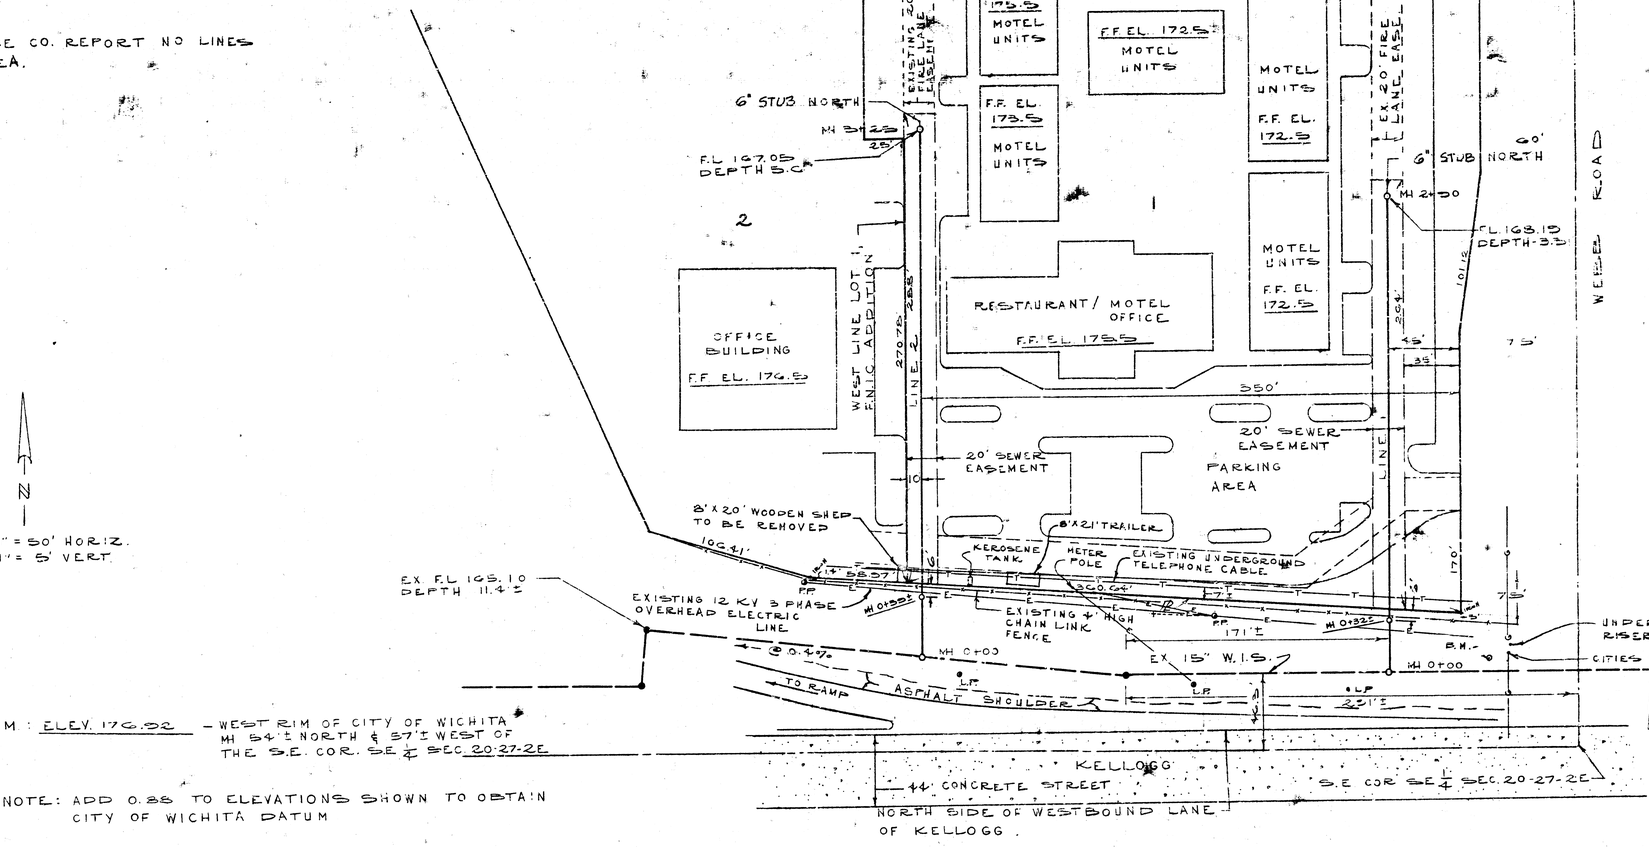

N

1" = 50' HORIZ.
1" = 5' VERT.

B.M.: ELEV. 176.92 – WEST RIM OF CITY OF WICHITA MH 54'± NORTH & 57'± WEST OF THE S.E. COR. SE¼ SEC. 20-27-2E

NOTE: ADD 0.85 TO ELEVATIONS SHOWN TO OBTAIN CITY OF WICHITA DATUM

NOTE TO CONTRACTOR:

CALL GEORGE HOFSESS - CITIES SERVICE GAS CO. PHONE 524-0491 AND SOUTHWESTERN BELL TELEPHONE CO. BEFORE COMMENCING WORK.

7-24-74

APPROVED AS NOTED
By CITY ENGINEER OF WICHITA
Sanitary Sewers 8" P.V.C.
Storm Sewers

NOTE TO CONTRACTOR

This project will be constructed under the supervision of the CITY ENGINEER and conforming to the SPECIFICATIONS of the CITY OF WICHITA. The CONTRACTOR will reimburse the City of Wichita for all cost of [redacted] and inspection.

Public Sanitary
SEWER EXTENSION
FNIC ADDITION

K.O. TAYLOR, P.E.
DEC. 19, 1973
REVISED JAN. 22, 1974
Rev. 7-23-74

Note: 'Building Layout furnished by others.
Manholes- Poured concrete to City of Wichita Specs.

PROJECT: DBKW 703072