


449 561
 1.30
 0.431
 1.731
 474
 474
 474

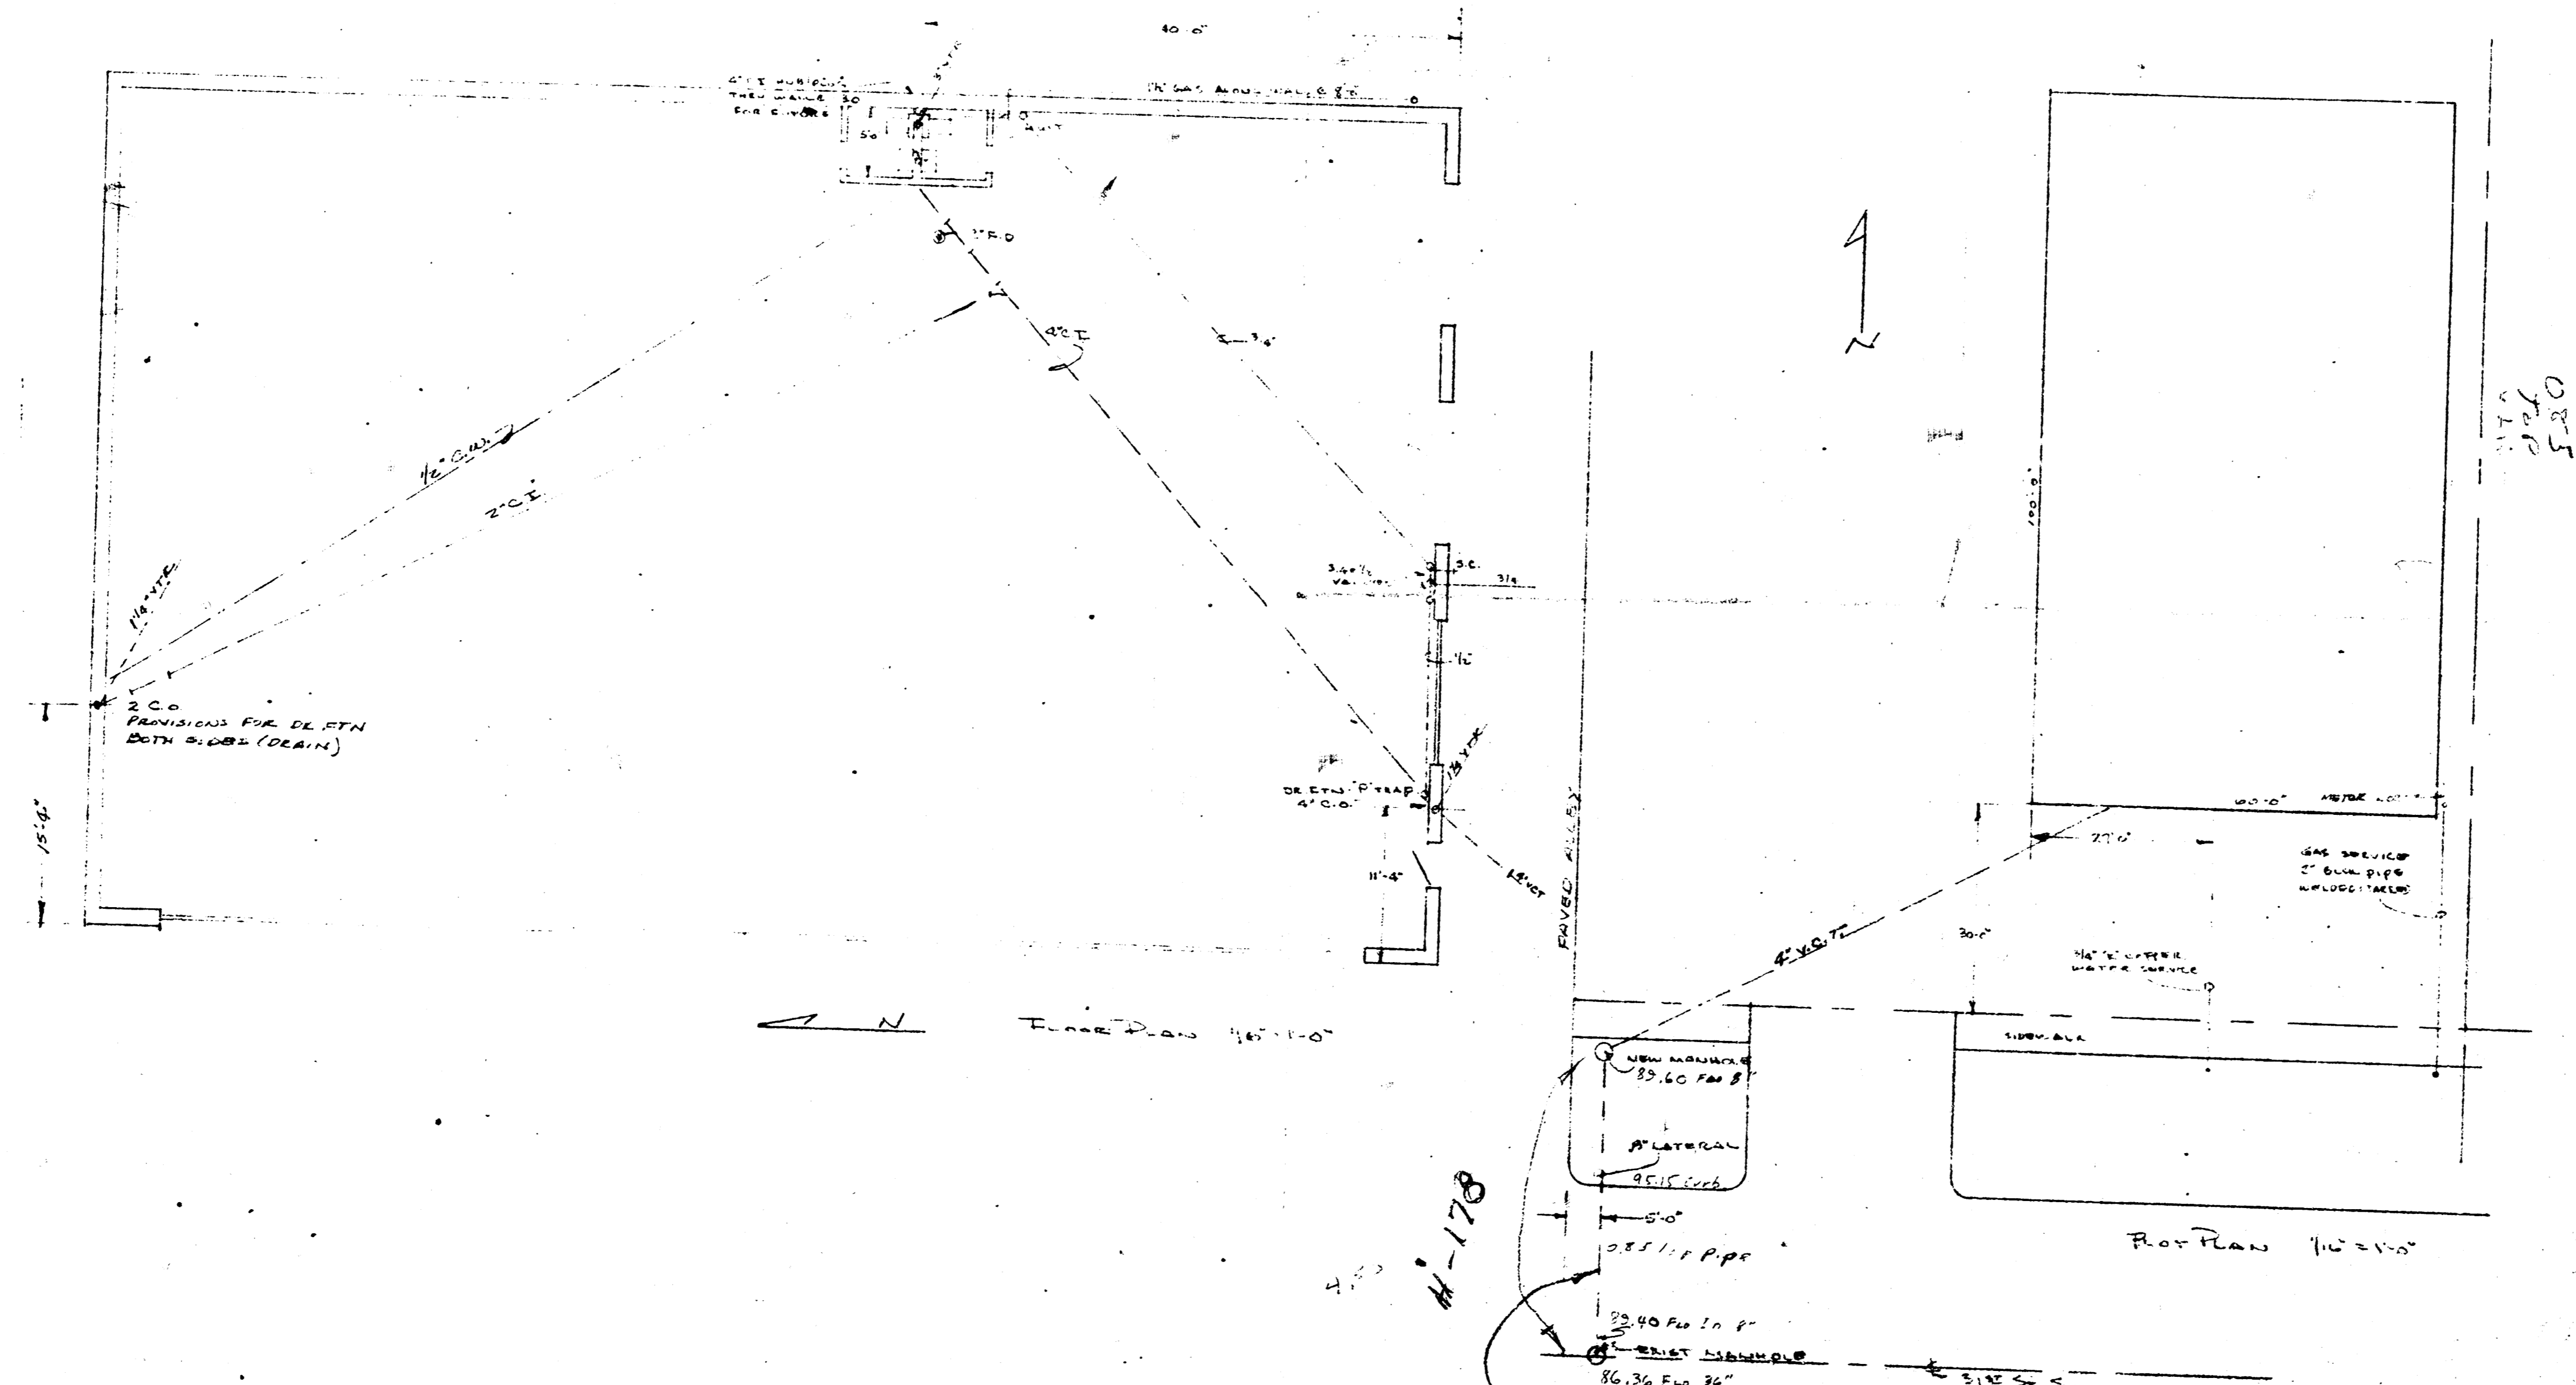

4-178
 Detail
 4/14

MECHANICAL LAYOUT
 GARRETT BLDG Co 1000 West 31st St
 H.D. QUINN COURT Co - KENNEDY AVE. 100
 # 3457
 REV 10/20