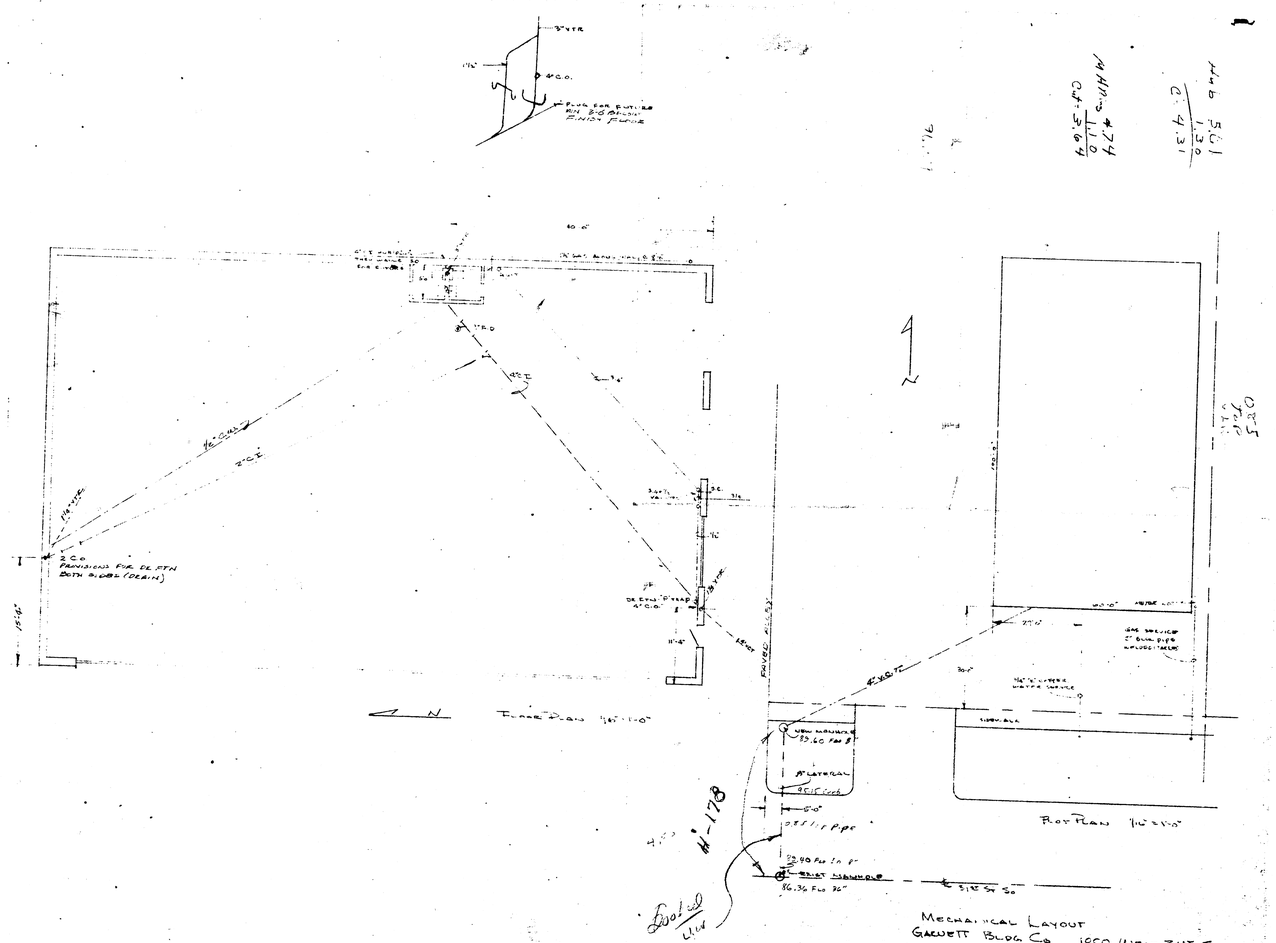


MECHANICAL LAYOUT
GARNETT BLDG CO 1000 WEST 31ST SO
U.D QUEENS COURT CO ~ KOONTZ AIR, INC
#3457
REV 10/20