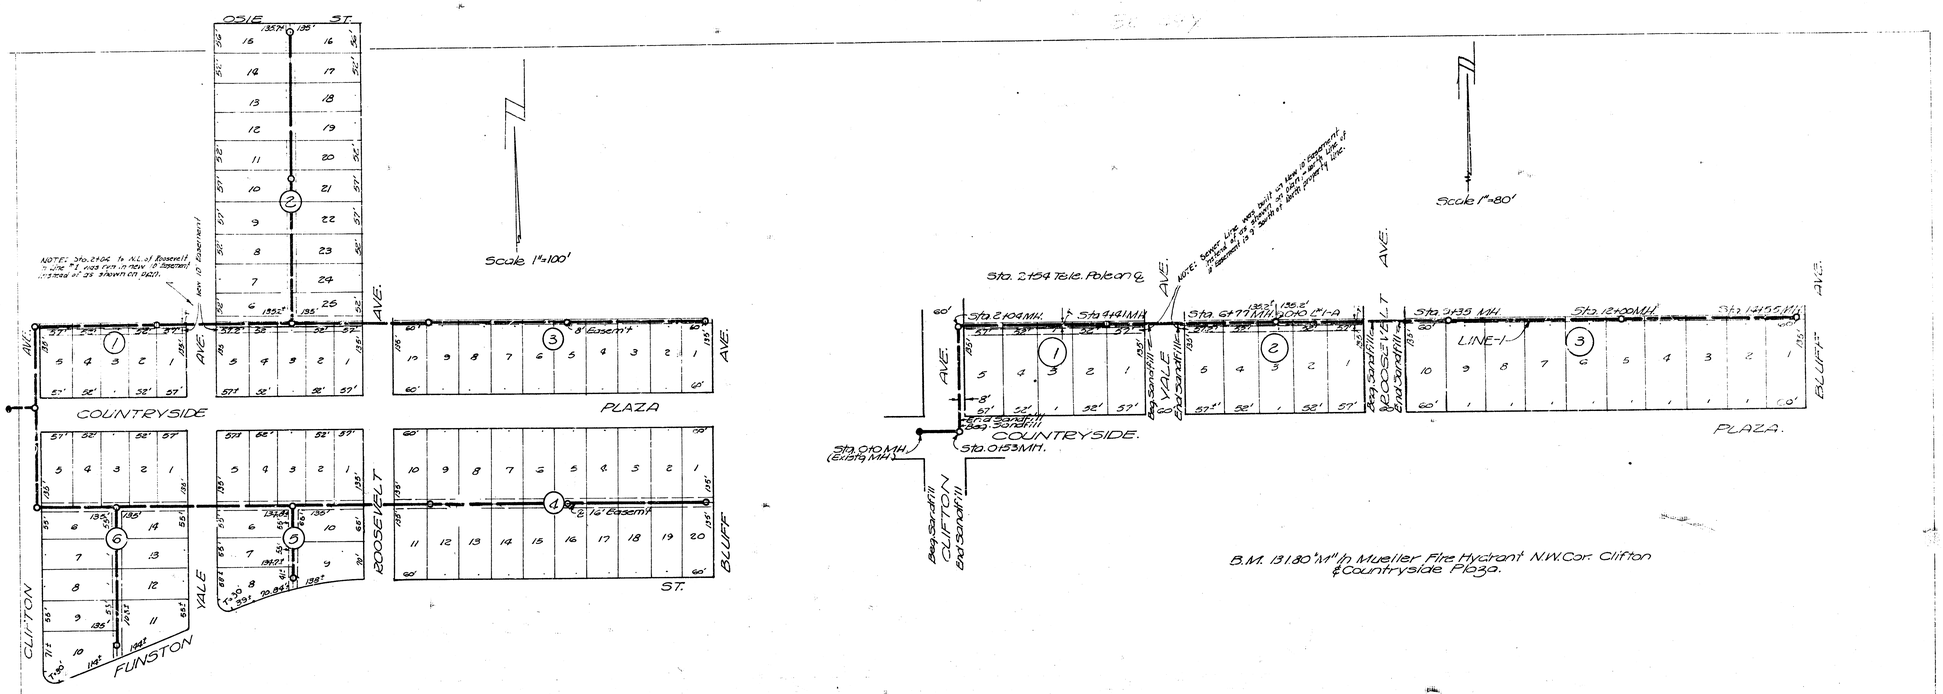

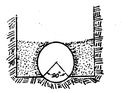

Detail of tamped Backfill

Pipe Size	24" TRENCH		27" TRENCH		30" TRENCH	
8"	13'	NONE	10'	11'	9'	10'
10"	13'	NONE	11'	14'	9'	10'
	Wet clay	Dry clay	Wet clay	Dry clay	Wet clay	Dry clay

NOTE:

If tamped backfill is not considered practical do to condition of ditch, sandfill to the top of pipe by the order of the City Engineer.

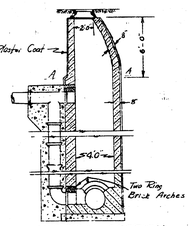

VERTICAL SECTION

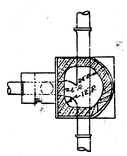

HORIZONTAL SECTION

DETAIL OF SPECIAL MANHOLE Sta. 4+41

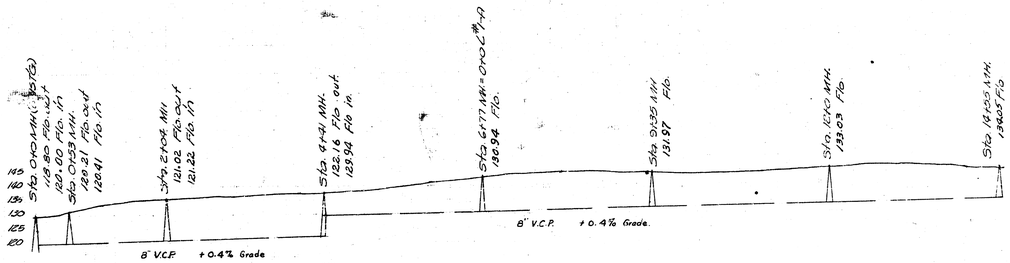

Sanitary Sewer Grandview Heights Addn.
City of Wichita, Kansas
Private Job

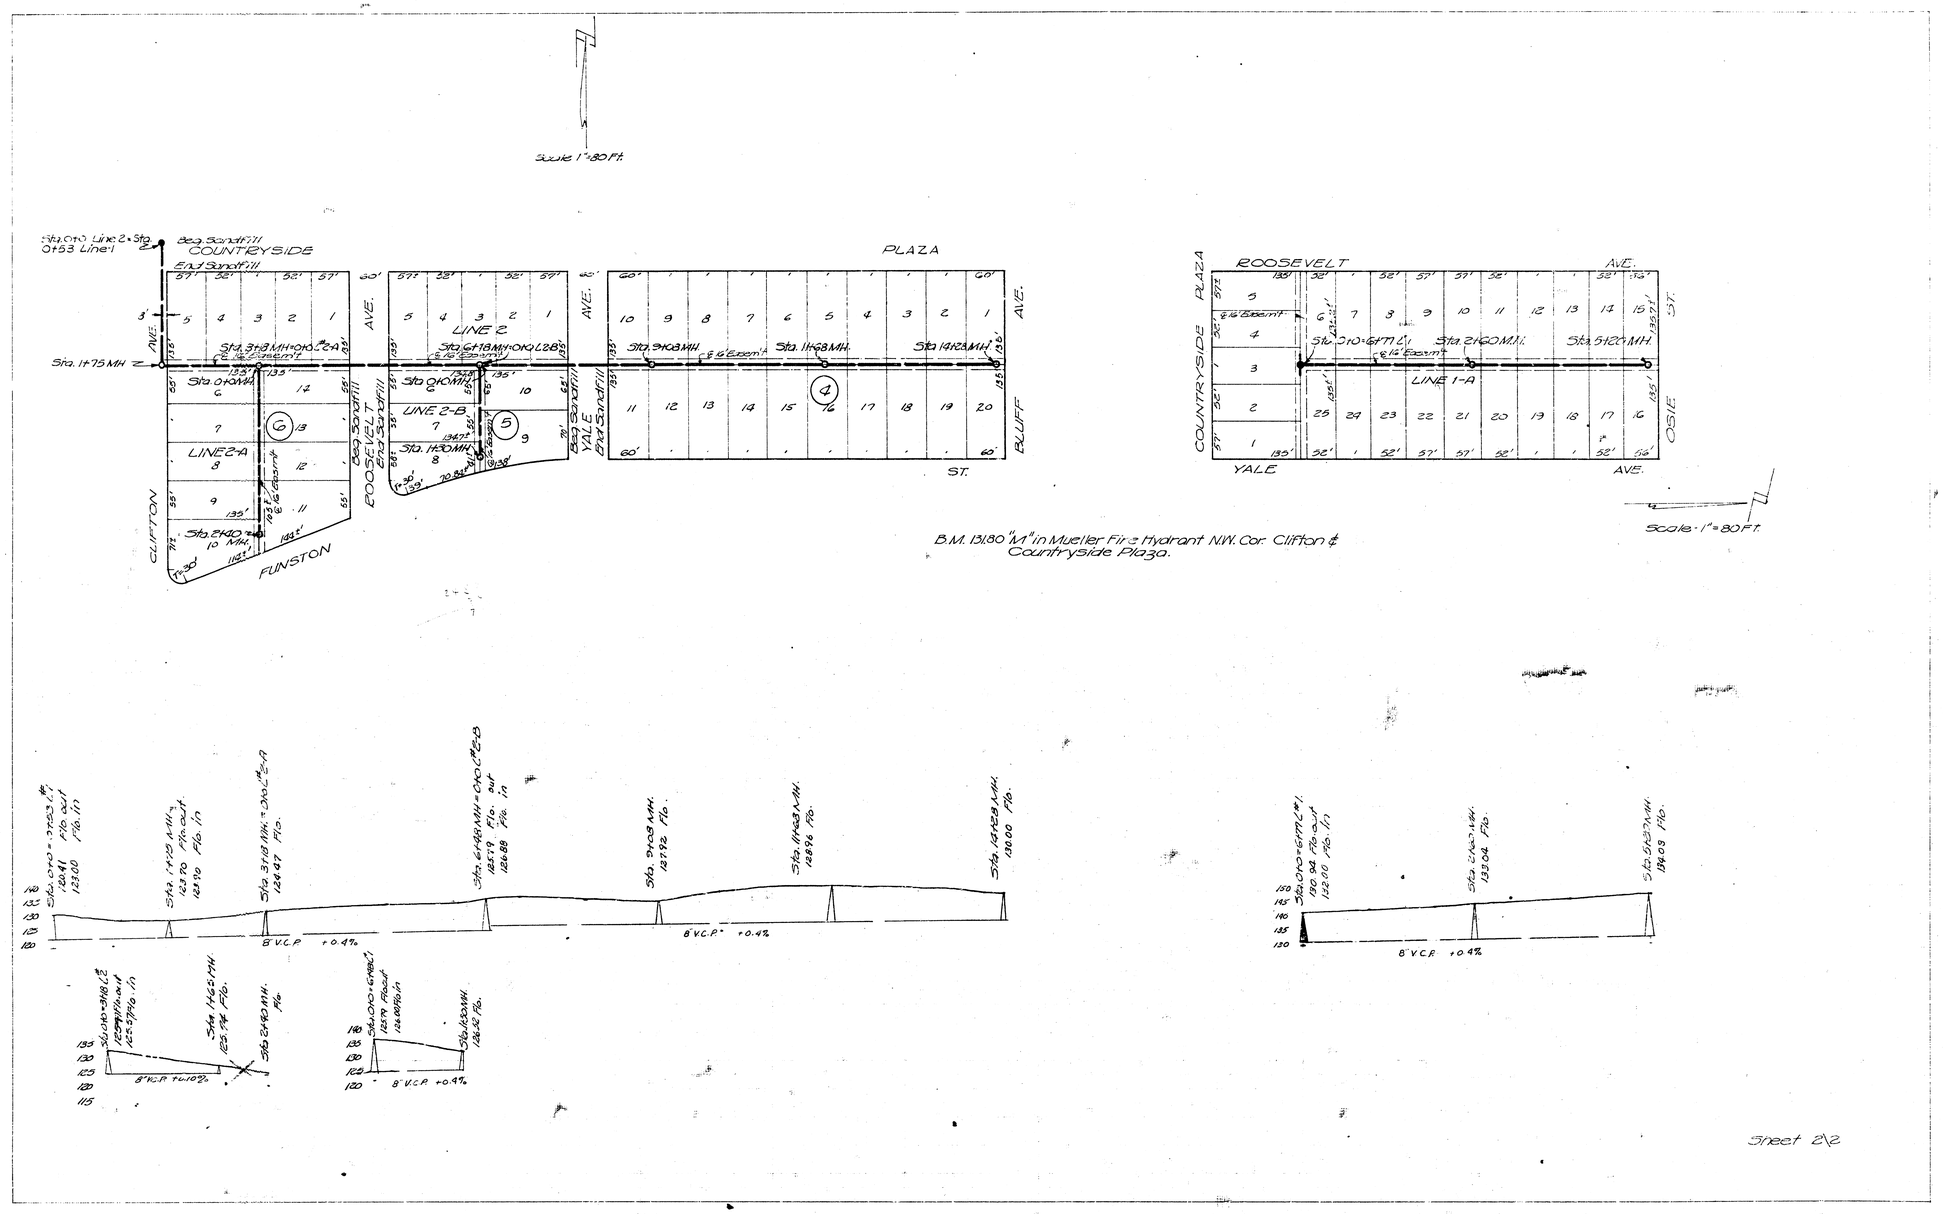
Scale 1" = 80 Ft.
COUNTRYSIDE
PLAZA
ROOSEVELT
YALE
BLUFF
CLIFTON
FUNSTON
LINE 2
LINE 2-A
LINE 2-B
LINE 1-A
B.M. 13.80 "M" in Mueller Fire Hydrant N.W. Cor. Clifton & Countryside Plaza.
8" V.C.P. +0.4%
Sheet 2\2