
 


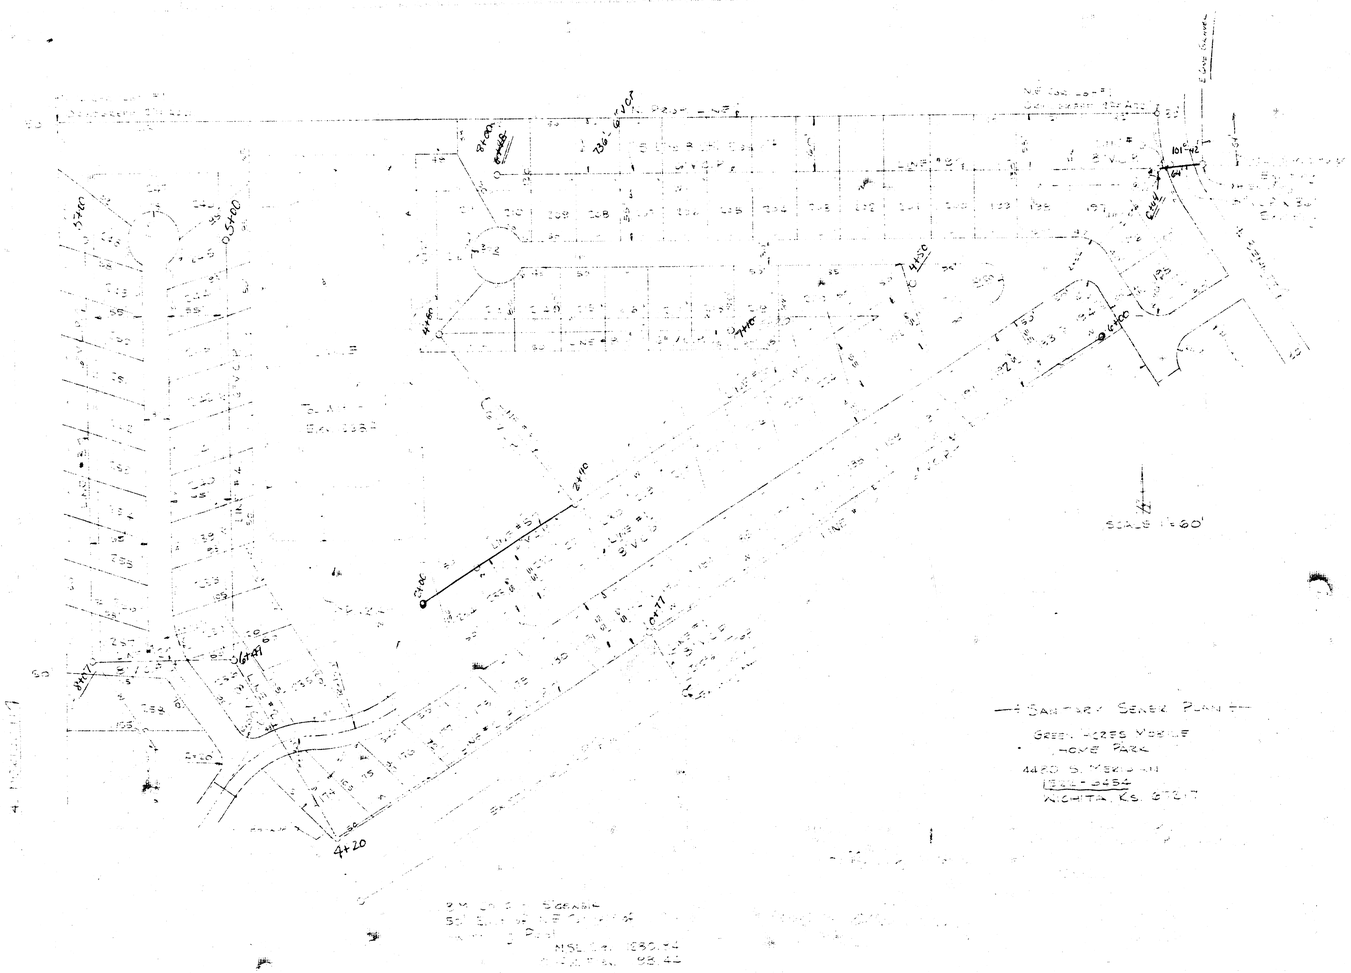

As Built Plans
Green Acres Mobile Homes
H.C. Lobb


SEWER GRADES
— NORTH SECTION —
4-50 D MERIDIAN
LINE #1
LINE #2
LINE #3
LINE #4
LINE #5
LINE #6
LINE #7
Existing Driveway

14 2 1 18