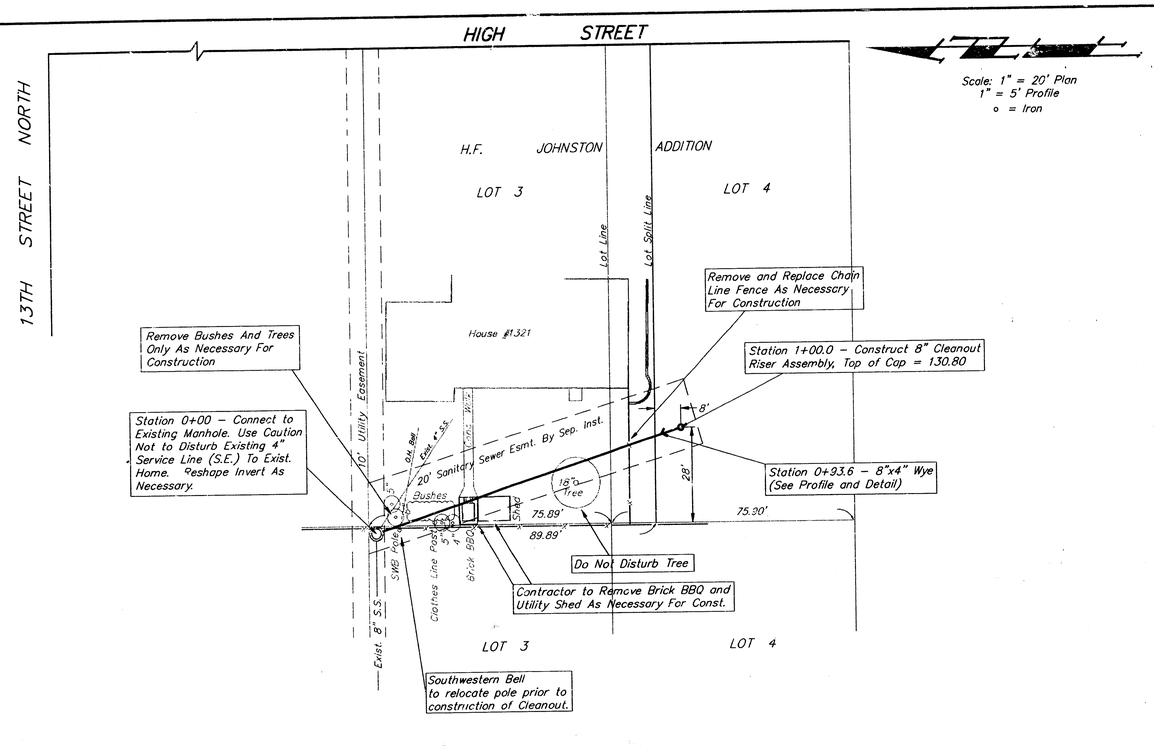

Scale: 1" = 20' Plan
1" = 5' Profile
o = Iron

8" CLEANOUT RISER ASSEMBLY DETAIL

Note: All Fittings on 8" Cleanout Riser Assembly to be Solvent Welded Per City Specifications.

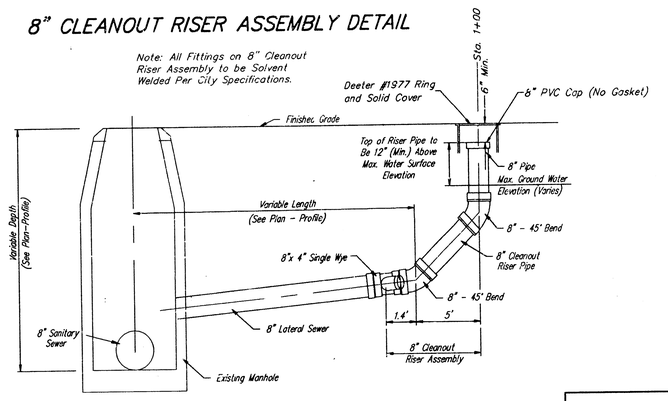

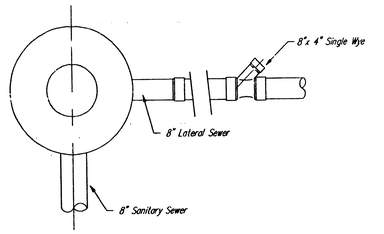

Bench Mark: City Disc, 29.5' E and 35.9' N of the Centerlines of 13th Street North and Sheridan, Elevation = 125.72

Bench Mark: Square Cut in Top of Curb, South Side of 13th Street North, 10' West of the N.W. Corner of Lot 2, H.F. Johnston Addition, Elevation = 127.85

APPROVED AS NOTED
BY CITY ENGINEER OF WICHITA

Sanitary Sewers VRH 3/10/93

Storm Sewers _____

Driveway Approaches _____

Water Mains _____

Paving _____

NOTE TO CONTRACTORS

Inspection and testing for this project is to be provided by a Licensed Consulting Engineering Firm under contract with the Owner/Developer. Said inspection to be in accordance with the City of Wichita standard construction engineering practices and certified by a Licensed Professional Engineer. No work shall be performed in dedicated easements or public right-of-way by the Contractor without such inspection nor shall any work be commenced without written authorization by the City Engineer.

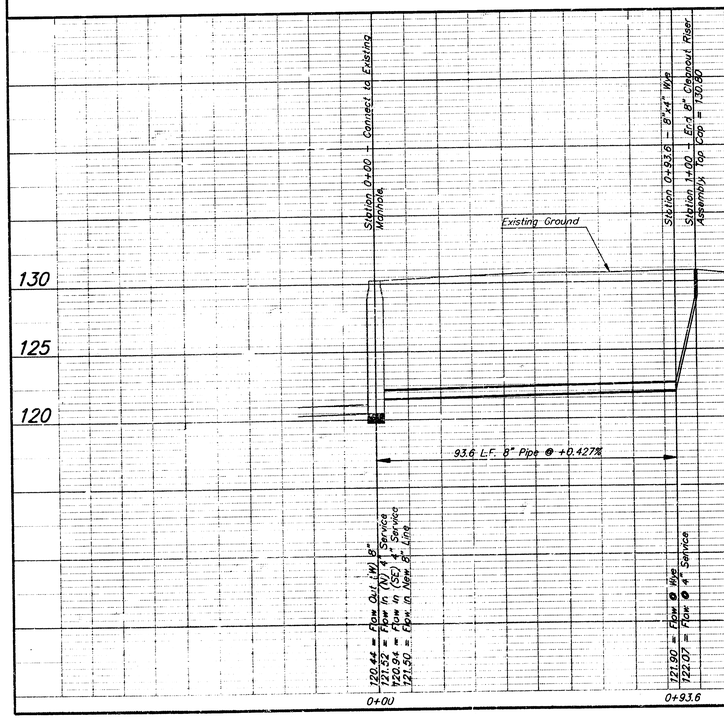

Backed 6-22-93
JKB
FROM AS BUILTS



PRIVATE SANITARY SEWER EXTENSION TO SERVE
PART OF LOT 4, H.F. JOHNSTON ADDITION

BAUGHMAN COMPANY P. A.
ENGINEERING & SURVEYING
316/262-7271 • 315 ELLIS • WICHITA, KANSAS 67211

PROJECT NUMBER 367 PPS (607861)

SHEET 1 OF 1

DESIGN	DRAWN	UTIL. CHECK'D	DATE	SCALE
C. Bohm	C. Bohm		11-18-92	Noted

18-11-1-B

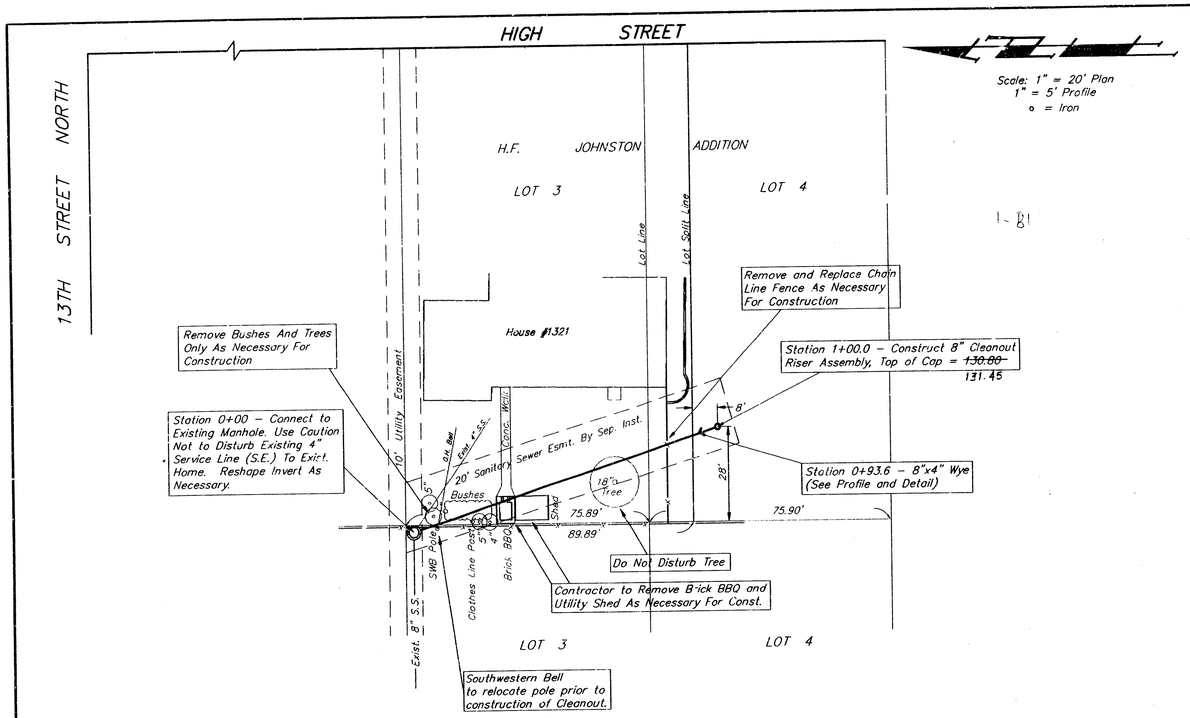

Scale: 1" = 20' Plan
1" = 5' Profile
o = Iron

8" CLEANOUT RISER ASSEMBLY DETAIL

Note: All Fittings on 8" Cleanout Riser Assembly to be Solvent Welded Per City Specifications.

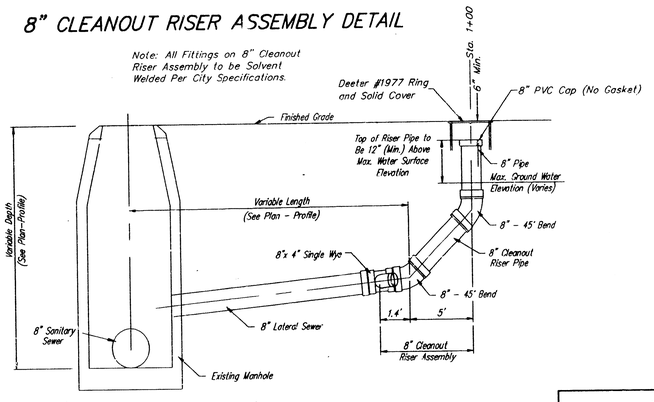

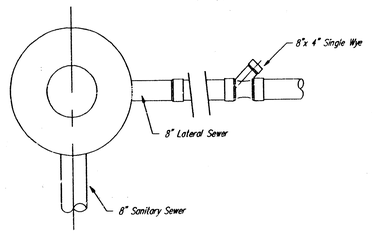

Bench Mark: City Disc. 29.5' E and 35.9' N. of the Centerlines of 13th Street North and Sheridan, Elevation = 125.72

Bench Mark: Square Cut in Top of Curb, South Side of 13th Street North, 10' West of the N.W. Corne. of Lot 2, H.F. Johnston Addition, Elevation = 127.85

APPROVED AS NOTED
BY CITY ENGINEER OF WICHITA

Sanitary Sewers VRH 3/10/93
Storm Sewers
Driveway Approaches
Water Mains
Paving

NOTE TO CONTRACTORS

Inspection and testing for this project is to be provided by a Licensed Consulting Engineering Firm under contract with the Owner/Developer. Said inspection to be in accordance with the City of Wichita standard construction engineering practices and certified by a Licensed Professional Engineer. No work shall be performed in dedicated easements or public right-of-way by the Contractor without such inspection nor shall any work be commenced without written authorization by the City Engineer.

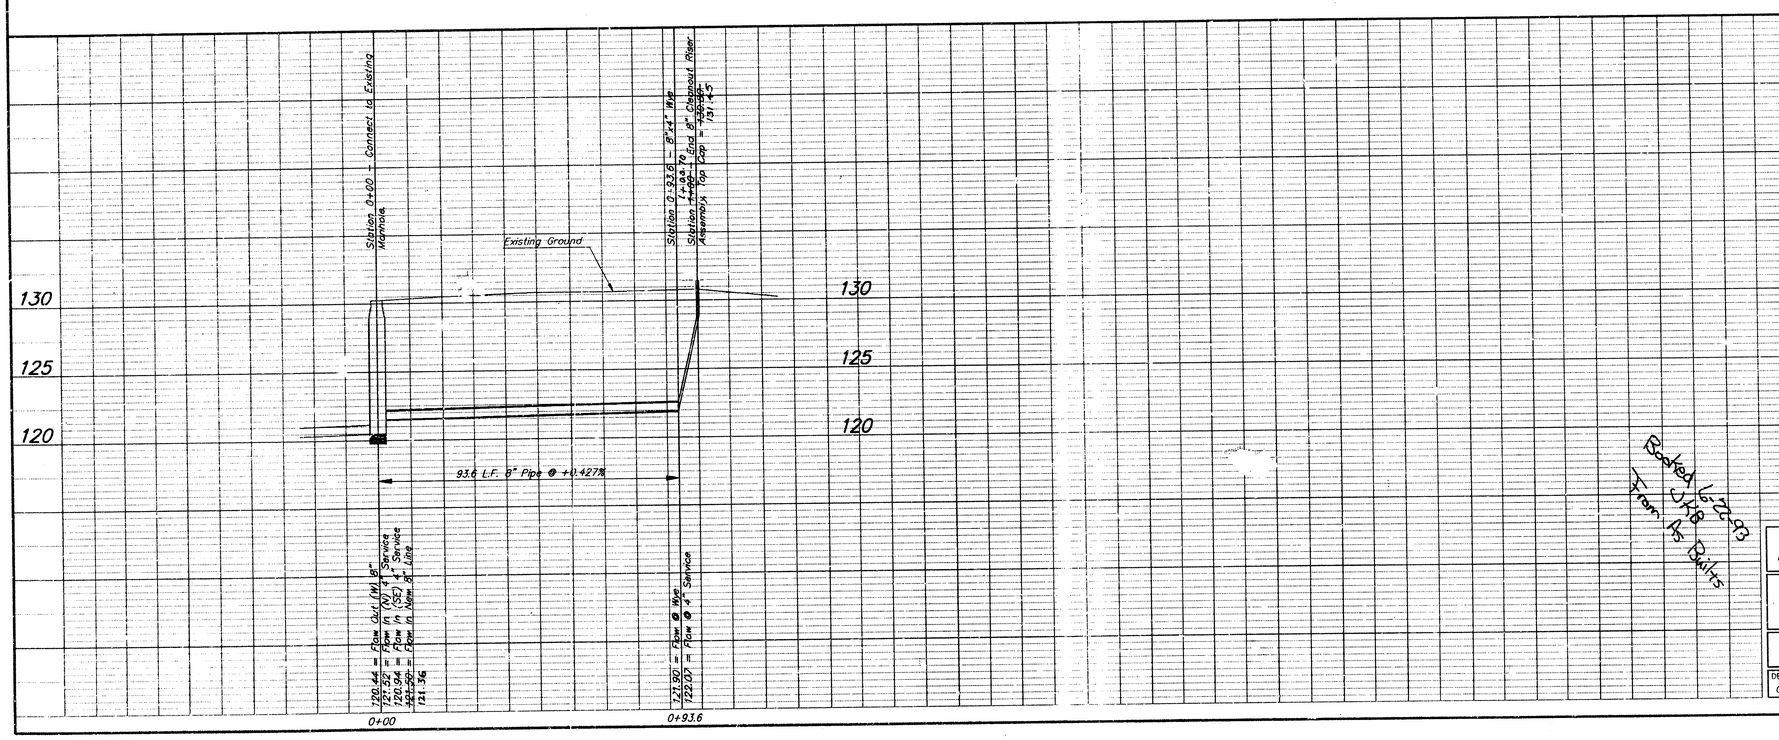

Booked 6-22-93
From As Builts

KERMIT D. BOTEN
LICENSED
8476
KANSAS
PROFESSIONAL ENGINEER

A.Z.

AS BUILT 6-3-93

PRIVATE SANITARY SEWER EXTENSION TO SERVE
PART OF LOT 4, H.F. JOHNSTON ADDITION

BAUGHMAN COMPANY P. A.
ENGINEERING & SURVEYING
316/262-7271 • 315 ELLIS • WICHITA, KANSAS 67211

PROJECT NUMBER 367 PPS (607861)

DESIGN	DRAWN	UTIL. CHECK'D	DATE	SCALE
C. Bohm	C. Bohm		11-18-92	Noted

SHEET 1 OF 1