
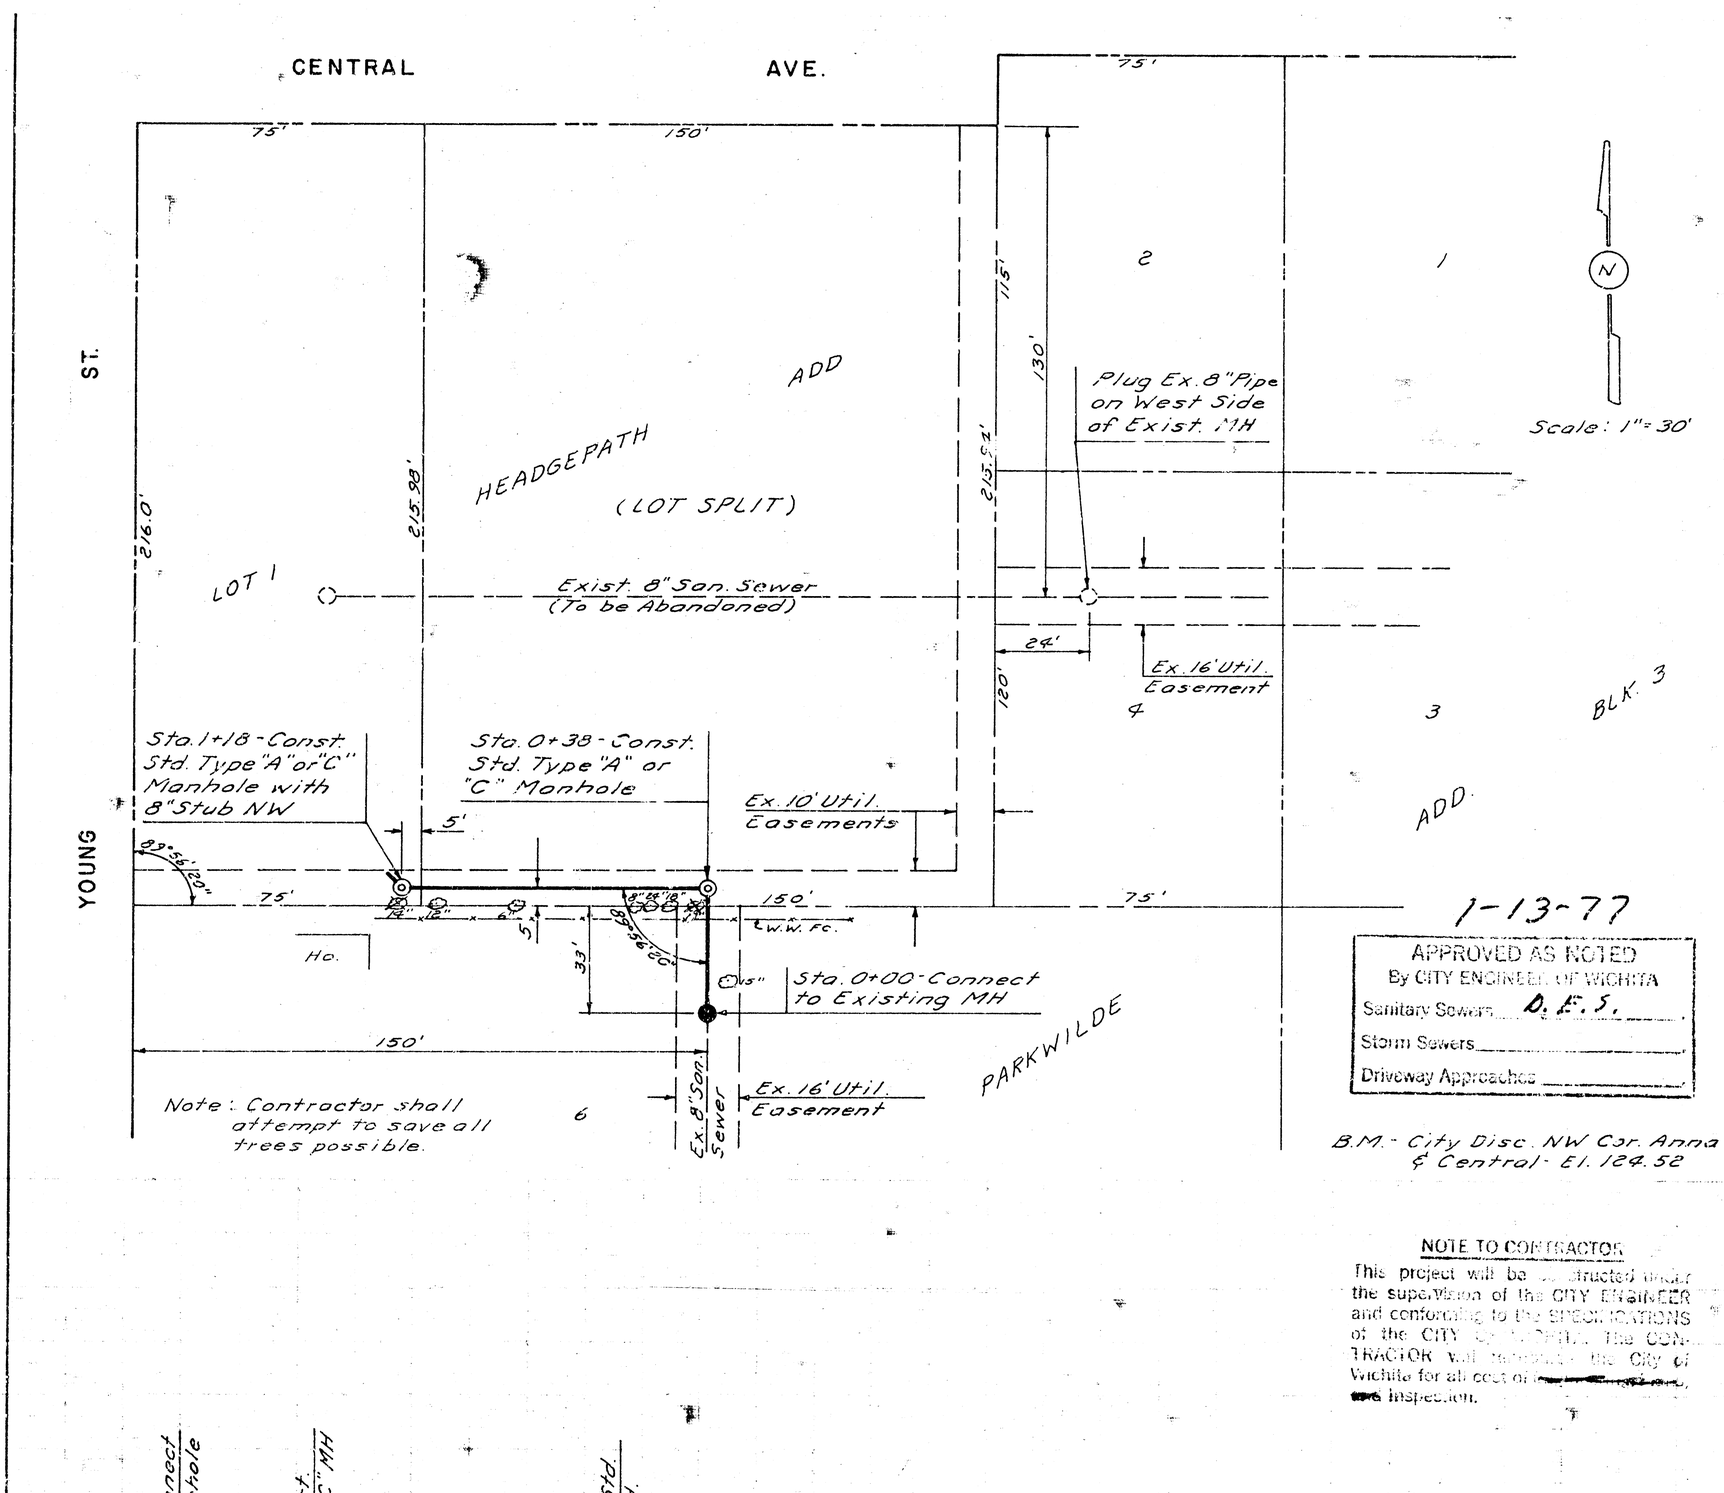


NOTE TO CONTRACTOR

This project will be constructed under the supervision of the CITY ENGINEER and conforming to the SPECIFICATIONS of the CITY OF WICHITA. The CONTRACTOR will reimburse the City of Wichita for all cost of [illegible] inspection.

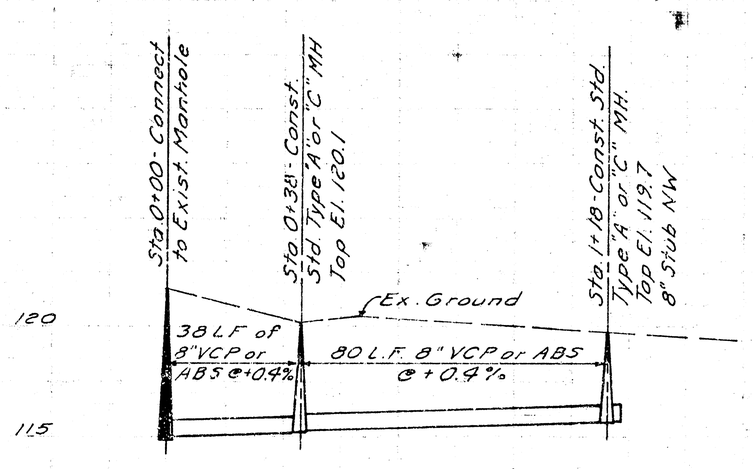

CITY PROJ. NO. DBKW 707004
SANITARY SEWER TO SERVE
HEADGEPATH ADDITION