

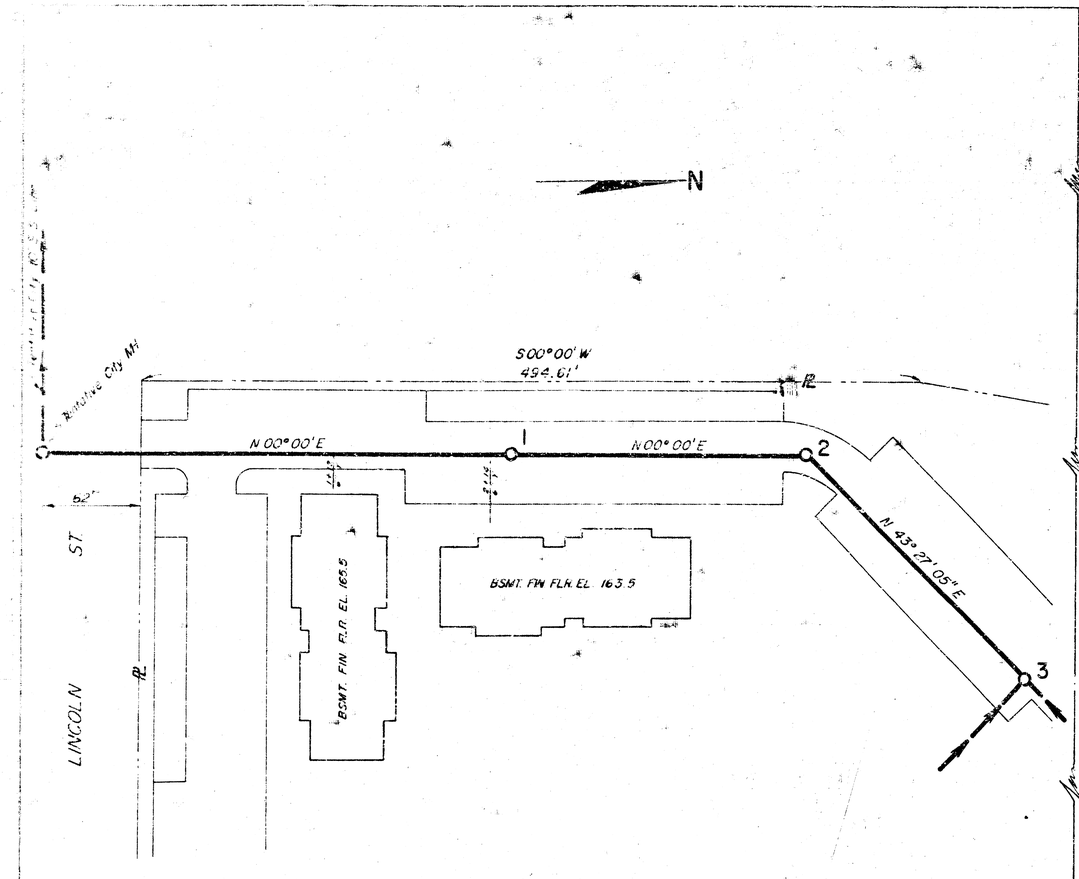


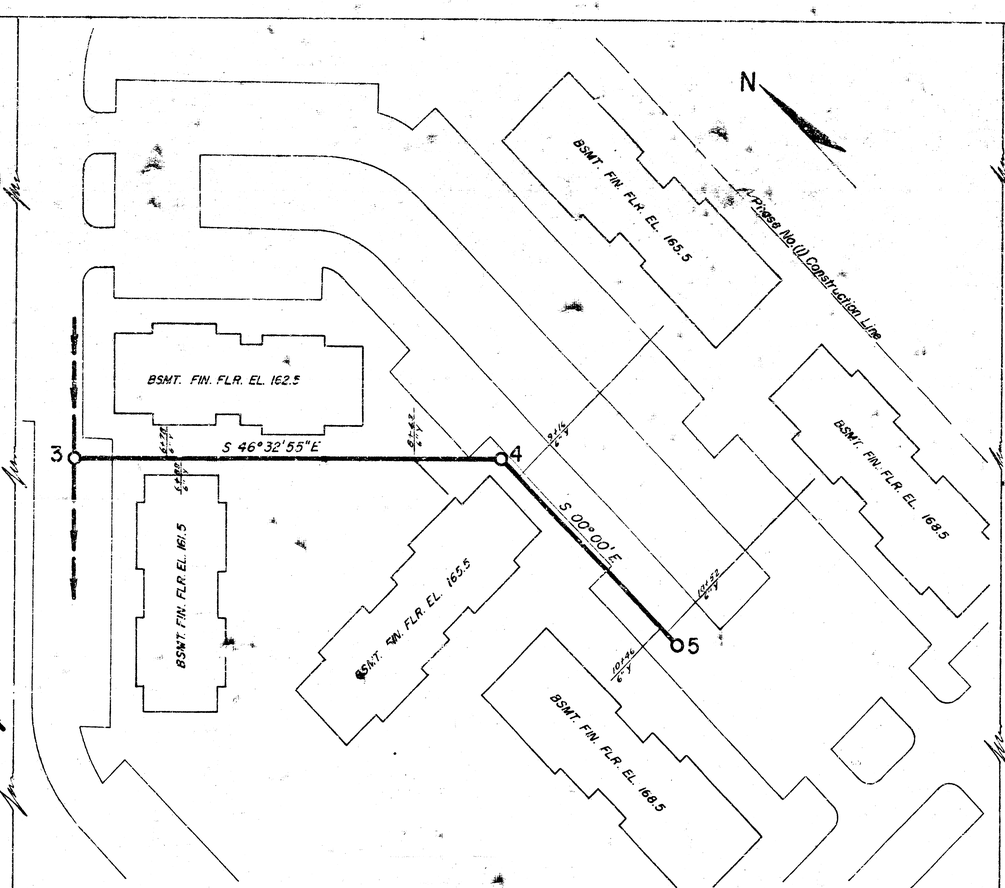

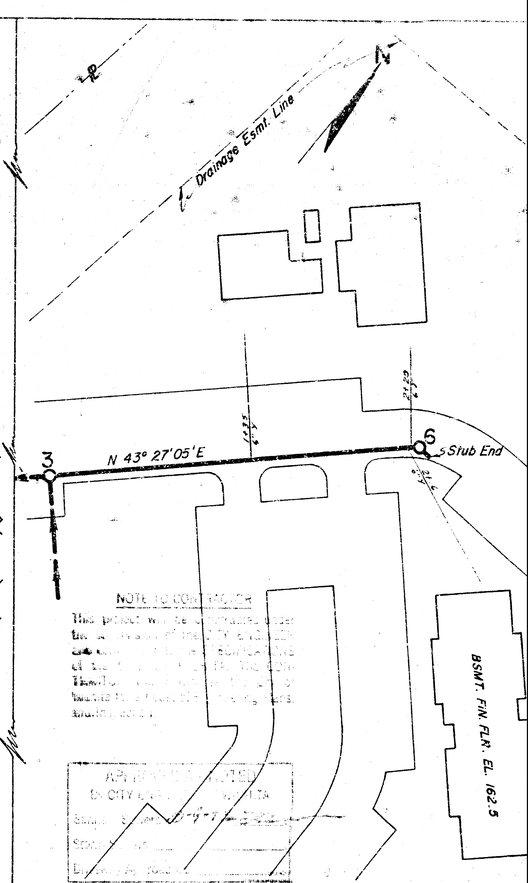

NOTE: All Lines To Be Sand Blackfilled And Flushed

HIGH POINT EAST
WICHITA, KANSAS

ONSITE SANITARY SEWER
PLAN & PROFILE

SCALE
PLAN: 1" = 50'
PROFILE: Ver. 1" = 5'
Hor. 1" = 50'

MOEHRING & ASSOCIATES CONSULTING ENGINE

9-2

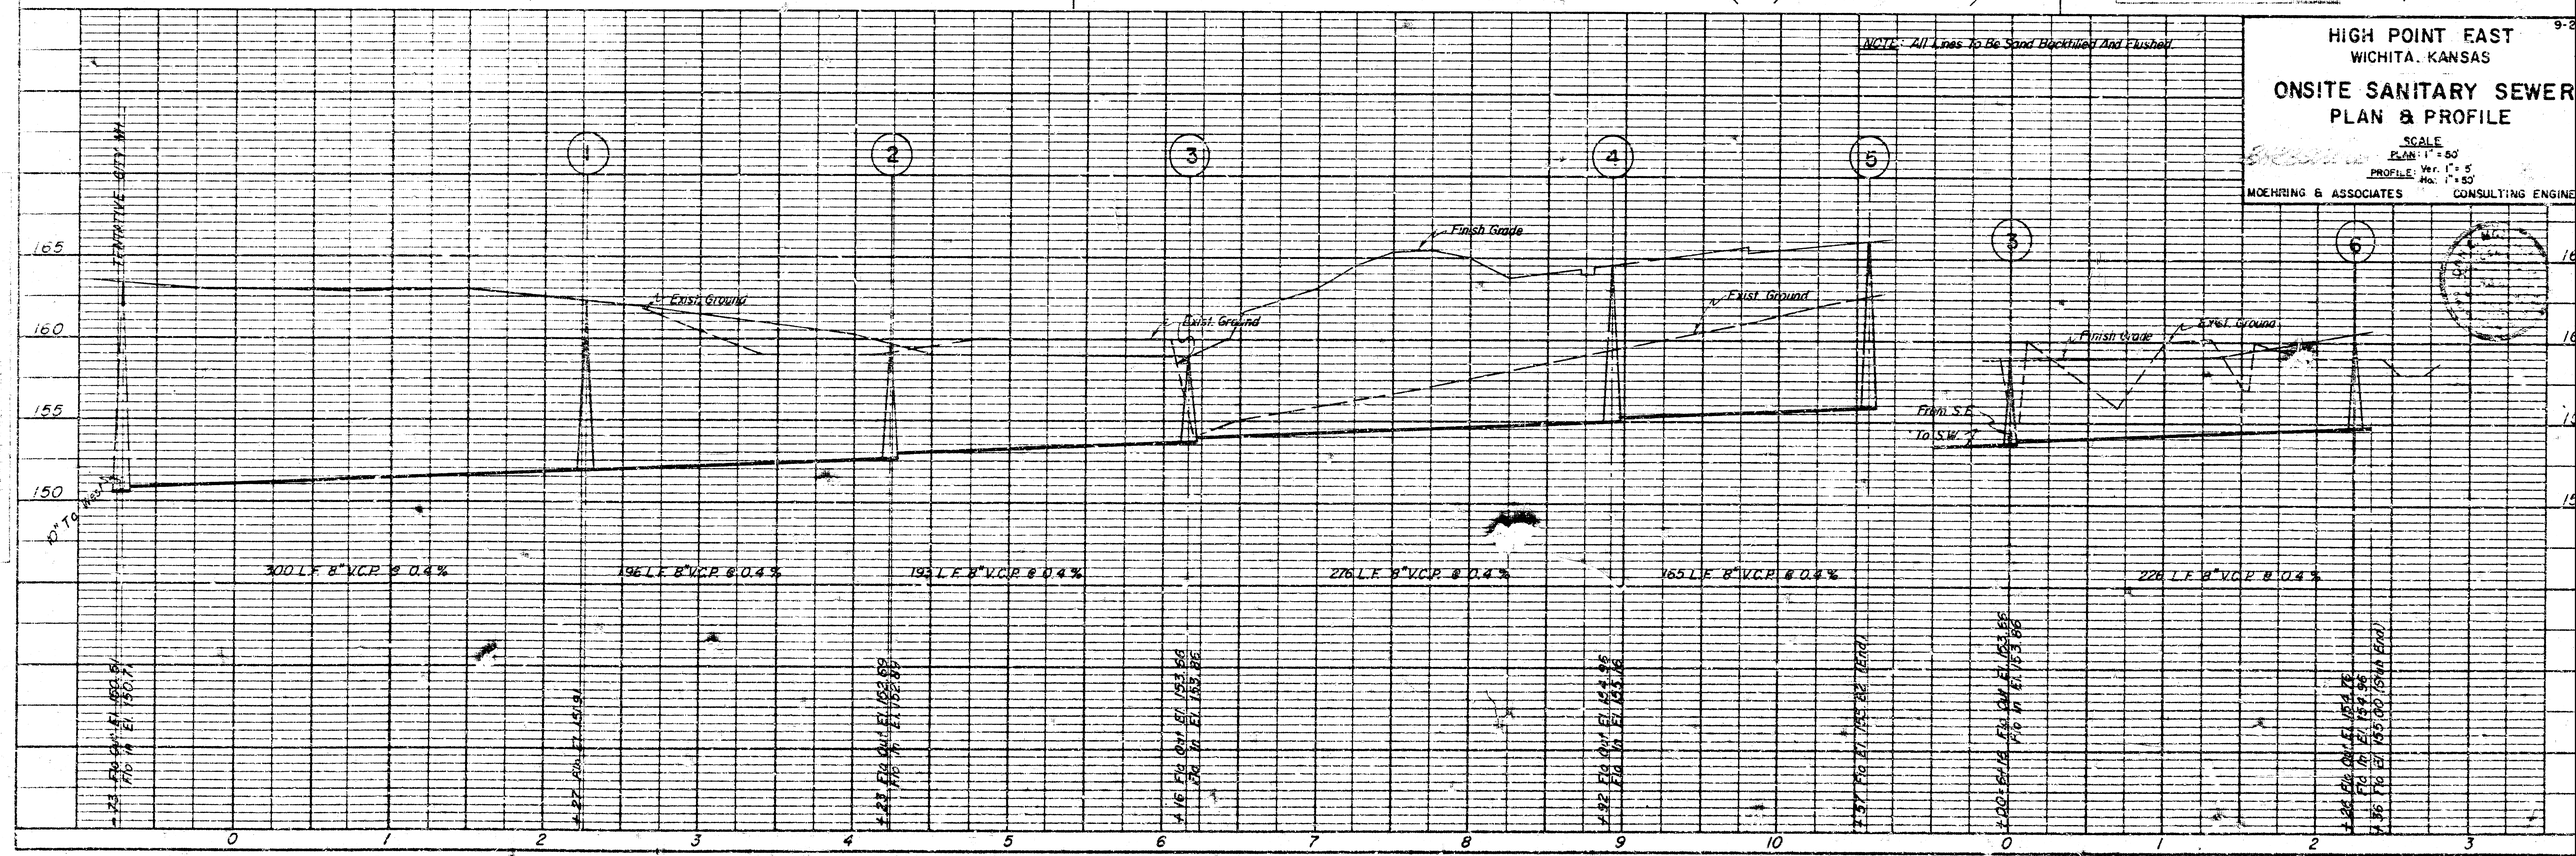


PLATE 1 - PLAN - PROFILE - F.A.B.
CLEARPRINT PAPER CO., S. F., CAL.

N

S 00°00'
494.61'

Existing Manhole

N 00°00'E

N 00°00'E

N 43° 27' 05" E

S 00°00'E

S 46°32'55"E

N 43° 27' 05" E

S Stub End

℄ Drainage Esmt. Line

℄ 1st Phase Ngbd. Construction Line

42'

72'

ST

LINCOLN

BSMT. FIN. FLR. EL. 165.5

ESMT. FIN. FLR. EL. 163.5

BSMT. FIN. FLR. EL. 162.5

BSMT. FIN. FLR. EL. 161.5

BSMT. FIN. FLR. EL. 166.5

1 2 3 4 5 6

NOTE: All Lines To Be Sand Backfilled And Finished

HIGH POINT EAST
WICHITA, KANSAS

ONSITE SANITARY SEWER
PLAN & PROFILE

SCALE
PLAN: 1" = 50'
PROFILE: Ver. 1" = 5'
Hor. 1" = 50'

MOEHRING & ASSOCIATES CONSULTING ENGINEE

9-24
Rev. as b
11-8-












Finish Grade

Exist. Ground

Top 155.5'

From S.E. to S.W. 2'







165
160
155
150

0 1 2 3 4 5 6 7 8 9 10 11 0 1 2 3

PLATE 1 - PLAN - PROFILE - F. A. S.
CLEARPRINT PAPER CO., S. F. CAL.