3. M. #2 171.26 "□" cut S.W. cor. 4'x4' S.W.S. M.H. 24' N. of N. cb Hiway 54 & 46' E. of W. L. K. T. A. R/W.

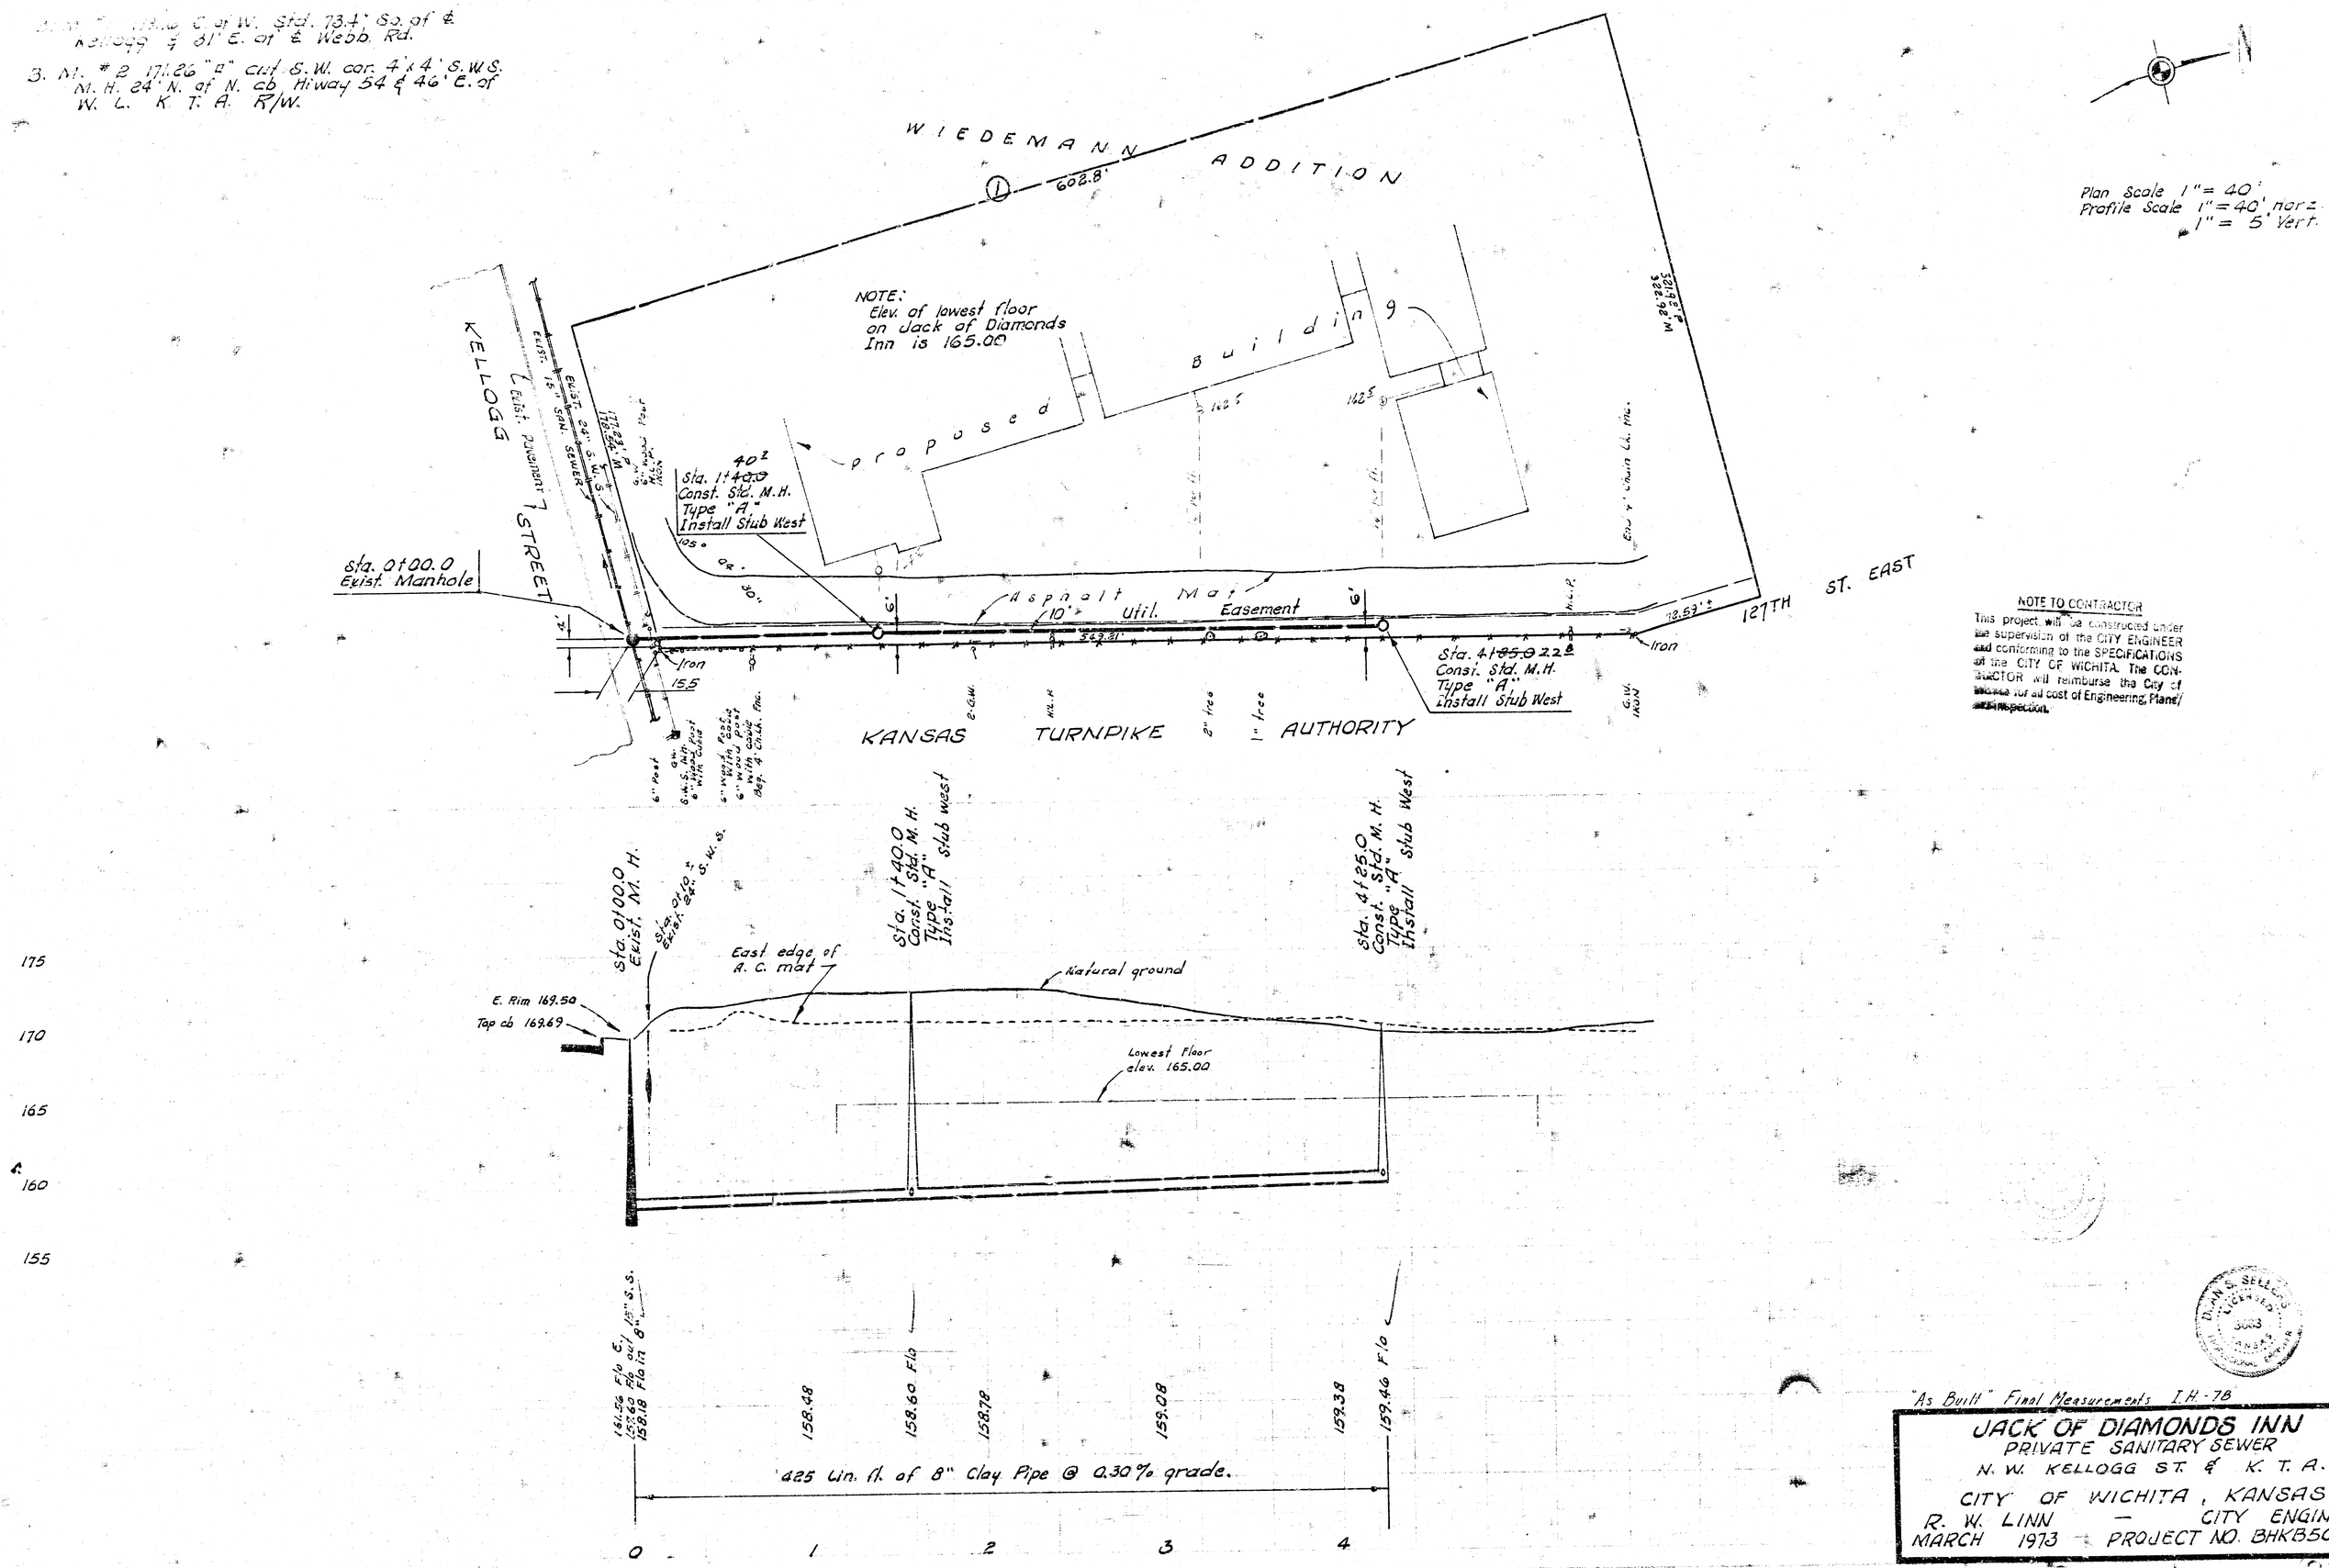

Plan Scale 1" = 40'
Profile Scale 1" = 40' horz.
1" = 5' Vert.

NOTE TO CONTRACTOR

This project will be constructed under the supervision of the CITY ENGINEER and conforming to the SPECIFICATIONS of the CITY OF WICHITA. The CONTRACTOR will reimburse the City of Wichita for all cost of Engineering, Plans/Inspection.

"As Built" Final Measurements I.H.-78

JACK OF DIAMONDS INN
PRIVATE SANITARY SEWER
N. W. KELLOGG ST. & K. T. A.
CITY OF WICHITA, KANSAS
R. W. LINN — CITY ENGINEER
MARCH 1973 — PROJECT NO. BHKB5030