



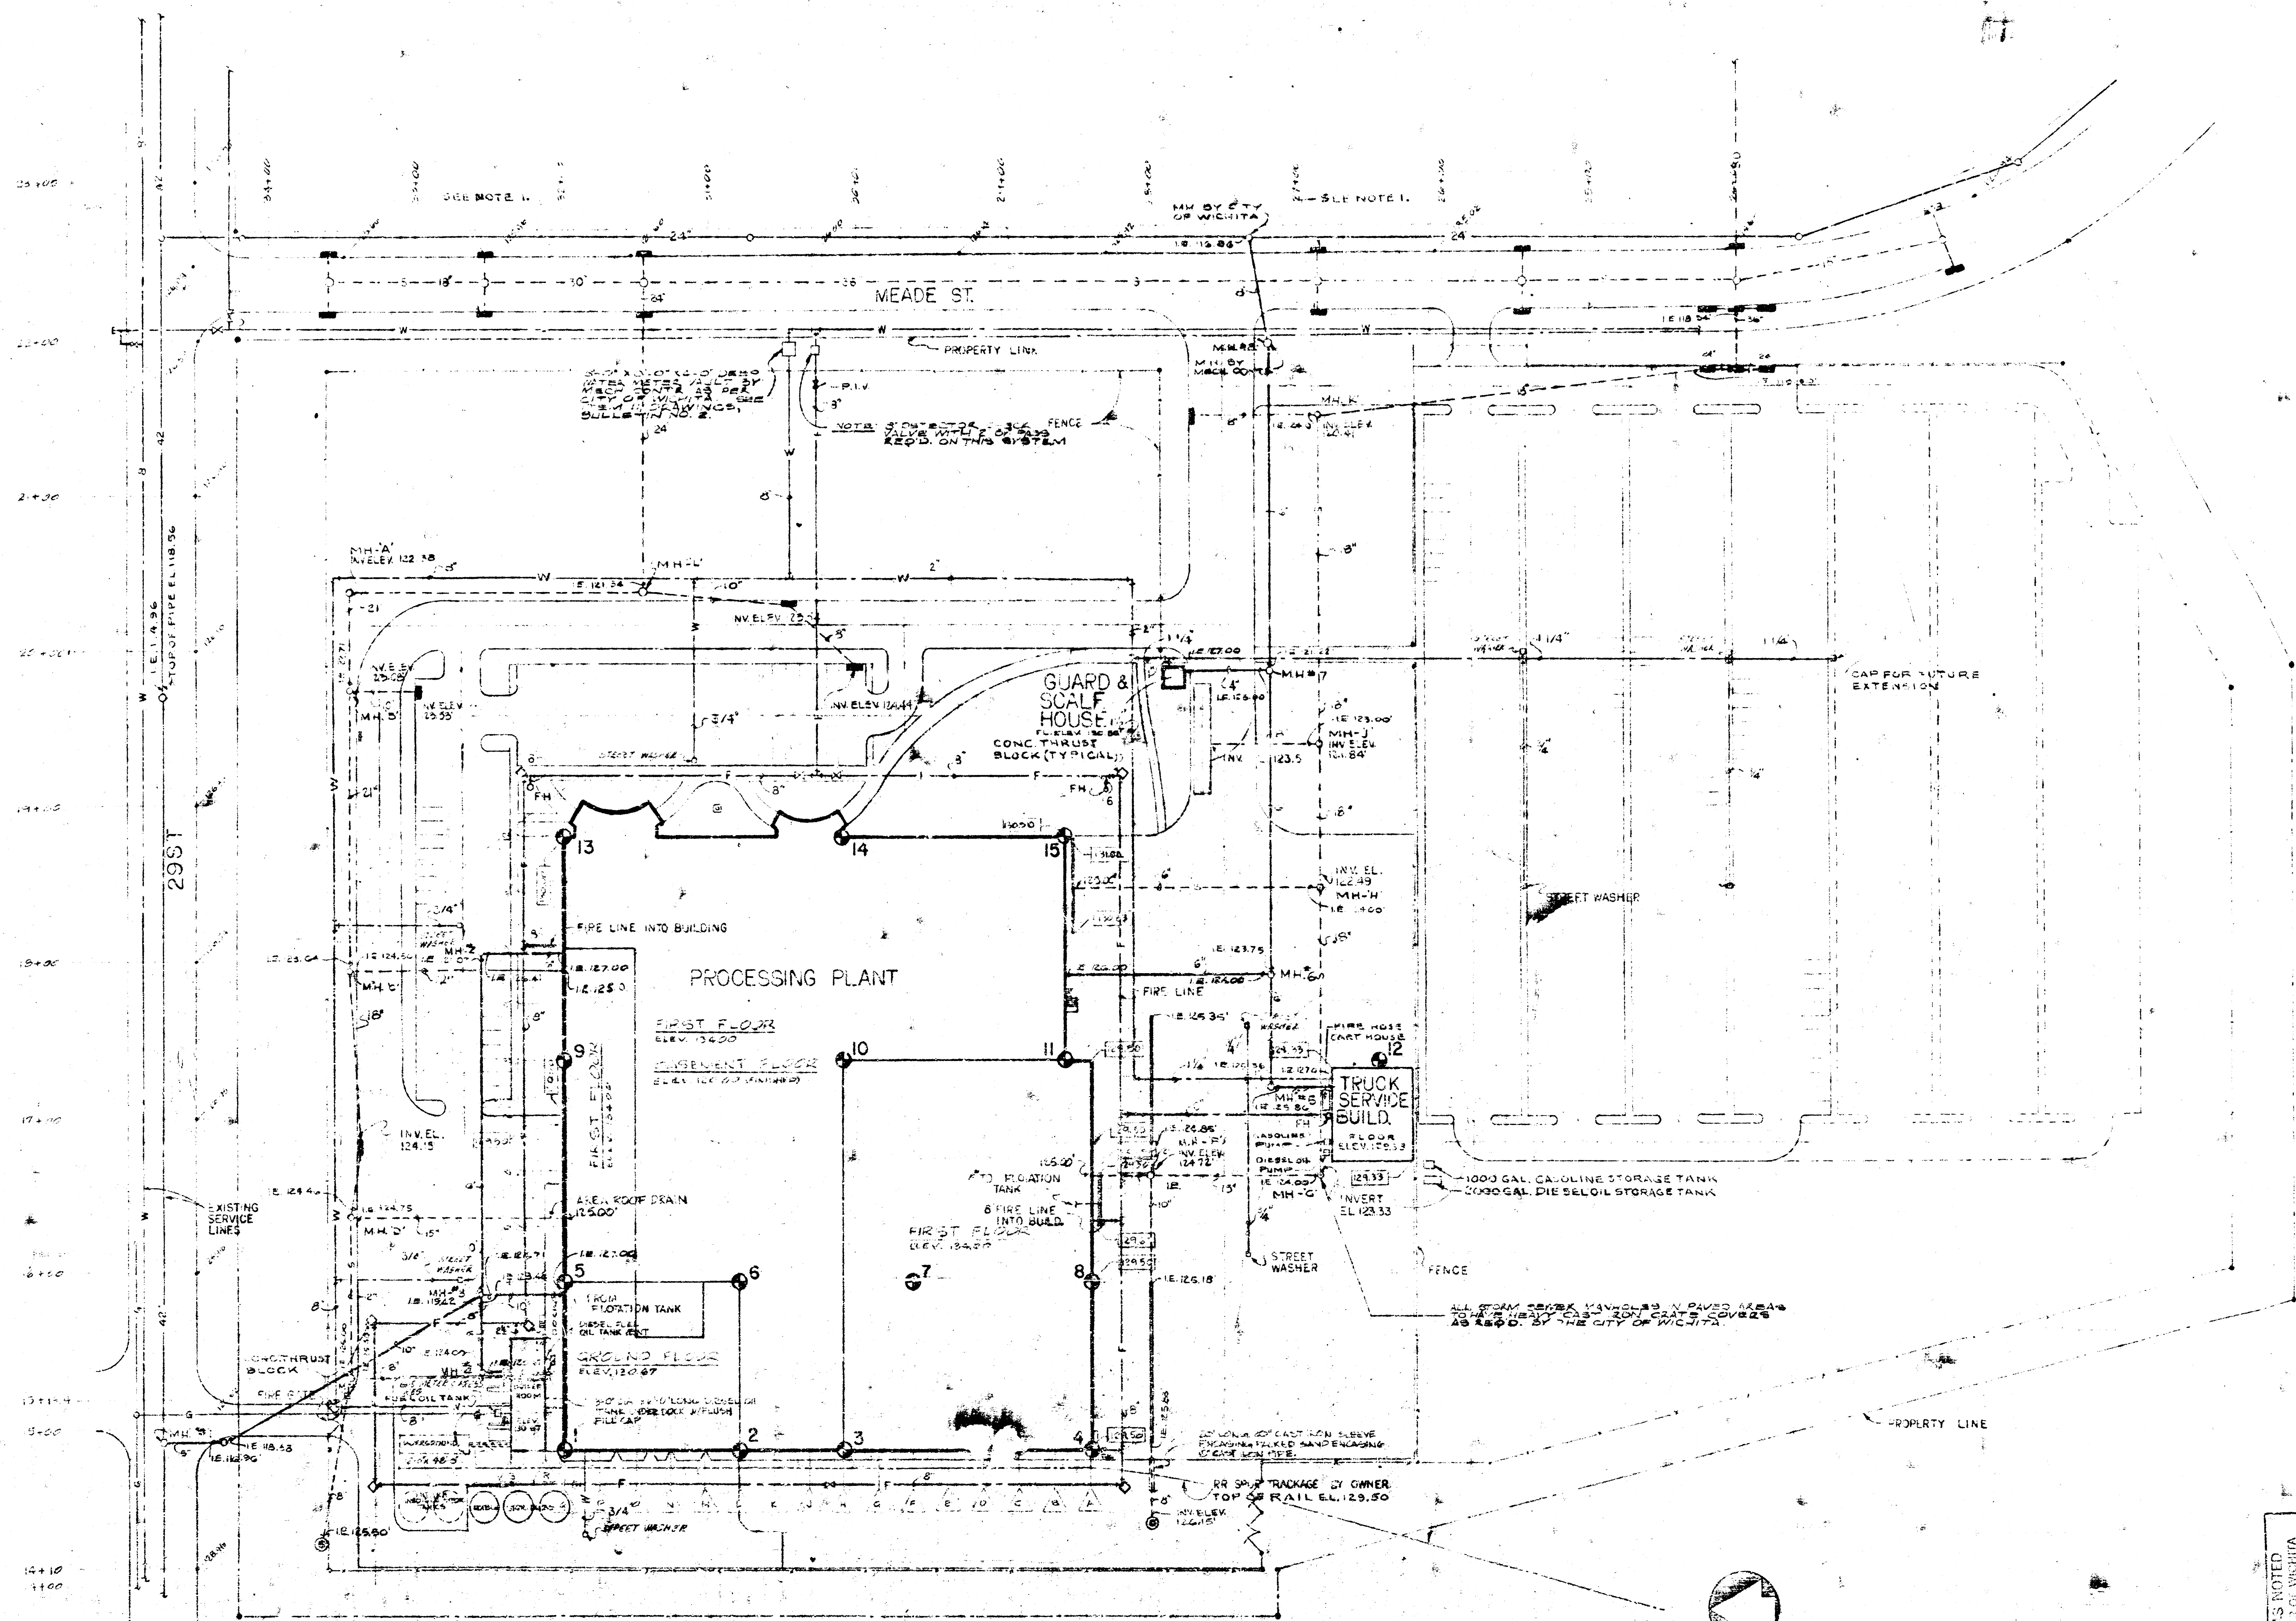

NOTES:
 1. ALL CURB INLETS SHOW OUTSIDE OF
 PROPERTY LINES WILL BE BY OTHERS.
 2. ALL STORM AND SANITARY DRAINAGE UNDER
 PAVED AREAS TO BE EXTRA HEAVY CAST
 IRON SOIL PIPE. ALL OTHER EXTERIOR
 TYPED DRAINAGE TO BE REINFORCED
 CONCRETE PIPE. ALL OTHER EXTERIOR
 SANITARY DRAINAGE TO BE VITRIFIED
 CLAY PIPE. REFER TO SPECIFICATIONS FOR
 PUMPED DRAINAGE SYSTEMS.
 3. MANHOLE COVER ELEVATIONS SHALL BE PLUSH
 WITH CONCRETE OR GRADE.

SITE PLAN
 SCALE 1"=50'

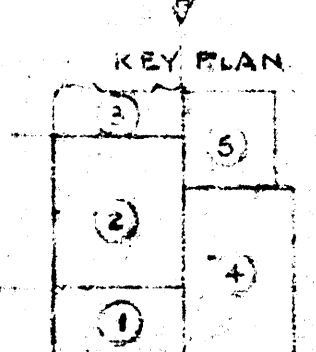

APPROVED IS NOTED
 BY CITY ENGINEER OF WICHITA
 [Signature]
 [Signature]
 [Signature]

WILLIS REGIER, A.I.A.
 REGISTERED PROFESSIONAL ARCHITECT
 WICHITA, KANSAS

KANSAS BEEF INDUSTRIES INC.
 TWENTY NINTH STREET AT 29TH AVENUE
 WICHITA, KANSAS

DATE: 2-26-1952
 SHEET: 1 OF 1

PROJECT: MECHANICAL
 SITE PLAN