
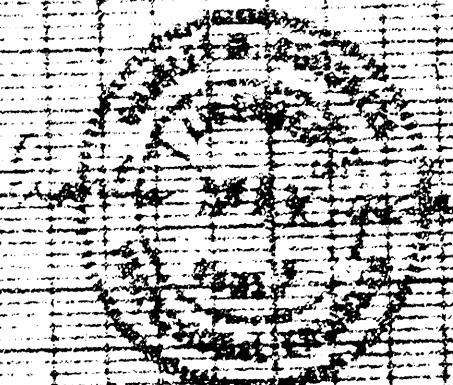


APPROVED AS NOTED
By **CITY ENGINEER OF WICHITA**
Sanitary Sewers _____
Storm Sewers _____
Driveway Approaches _____

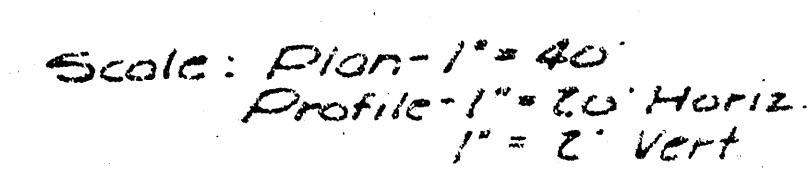

REISS & GOODNESS ENGINEERS
2100 WEST 21ST STREET
WICHITA, KANSAS 67204
(316) 272-0723