SRB

Scale: 1" = 40' Plan
1" = 5' Profile (Vert.)
o = Iron

BENCH MARK: RAILROAD SPIKE IN EAST FACE OF POWER POLE LOCATED NEAR THE SOUTHEAST CORNER OF CARSON'S BODY SHOP. ELEVATION = 104.25 MSL

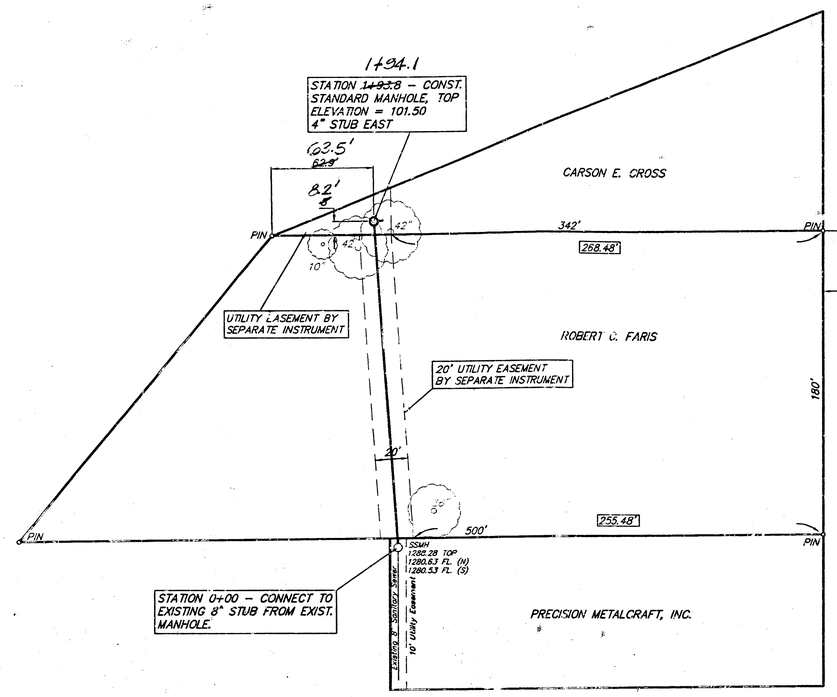

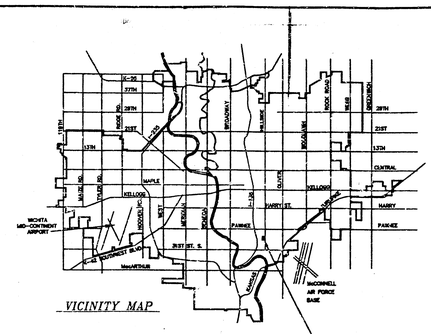

VICINITY MAP

PROJECT LOCATION

GENERAL NOTES

1. Underground utility service lines and overhead utility pole lines are to be adjusted as necessary by others prior to construction unless the plans specifically call for their adjustment be the Contractor or unless the plans specifically identify a utility to be adjusted by its owner during construction. Existing utilities and their location, as shown on the plans, represent the best information obtainable for design. Location information has been obtained from the various utility companies and is either from company record drawings or company provided field locations. The Contractor will be required to work around existing utilities within the right-of-way which do not conflict with proposed construction.
2. The Contractor shall be responsible for preserving property irons. The Contractor will be required to re-establish any property irons which are damaged or destroyed by his construction operations. Such irons shall be re-established by a licensed land surveyor or a licensed professional engineer in accordance with state laws.
3. The Contractor shall contact Kansas One Call at 687-2470 to have underground utilities located prior to construction of this project.
4. The Contractor shall seed, fertilize and mulch all disturbed areas.

INSPECTION AND TESTING FOR THIS PROJECT TO BE PROVIDED BY A LICENSED CONSULTING ENGINEERING FIRM UNDER CONTRACT WITH THE OWNER/DEVELOPER. SAID INSPECTION TO BE IN ACCORDANCE WITH THE CITY OF WICHITA STANDARD CONSTRUCTION ENGINEERING PRACTICES AND CERTIFIED BY A LICENSED PROFESSIONAL ENGINEER. NO WORK SHALL BE PERFORMED IN DEDICATED EASEMENTS OR PUBLIC RIGHT-OF-WAY BY THE CONTRACTOR WITHOUT SUCH INSPECTIONS. NOR SHALL ANY WORK BE COMMENCED IN DEDICATED EASEMENTS OR PUBLIC RIGHT-OF-WAY WITHOUT WRITTEN AUTHORIZATION BY THE CITY ENGINEER.

APPROVED AS NOTED
By CITY ENGINEER OF WICHITA

Sanitary Sewers VRH 8/23/94
Storm Sewers
Driveway Approaches
Water Mains
Paving

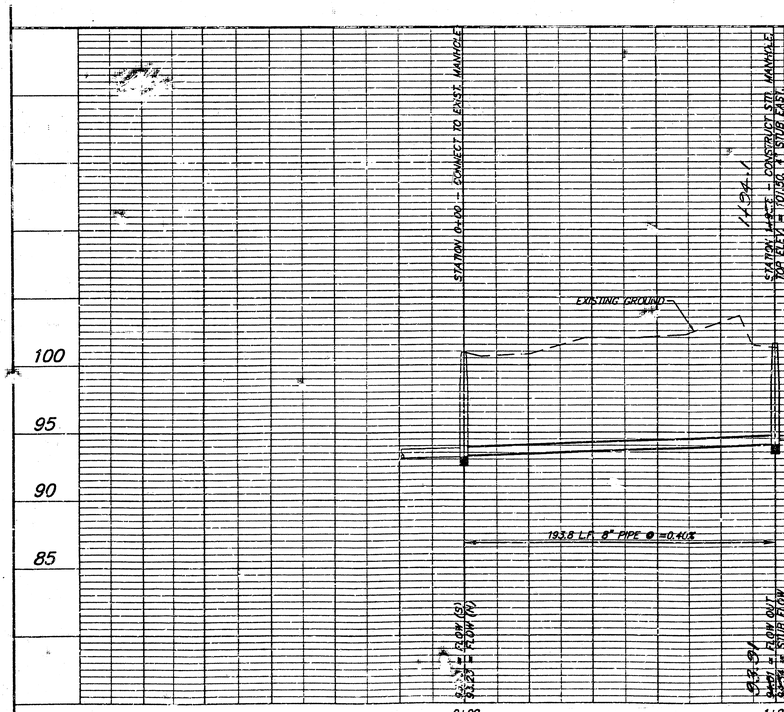

Booked 8-30-95
From As Builts

REVISED AS BUILT
4-25-95

CHRISTOPHER MICHAEL BOHM
LICENSED
31631
8-19-94
KANSAS
PROFESSIONAL ENGINEER

PRIVATE SANITARY SEWER EXTENSION
SERVING LIVING WORD OUTREACH, INC.
WICHITA, KANSAS

SRB 924 NORTH MAIN WICHITA, KANSAS 67211 316-264-8008 FAX 264-4621
SAVOY, RUGGLES & BOHM, P.A.
ENGINEERING & SURVEYING

PROJECT NUMBER 476PPS (607861)

DRAWN	DESIGN	REVIEW	DATE	UTILITY	SHEET NO.	SHEET TOTAL
C. Bohm	C. Bohm		7-15-1994		166E	1

SHB JOB 166E

REVISED

18-13-5-5