



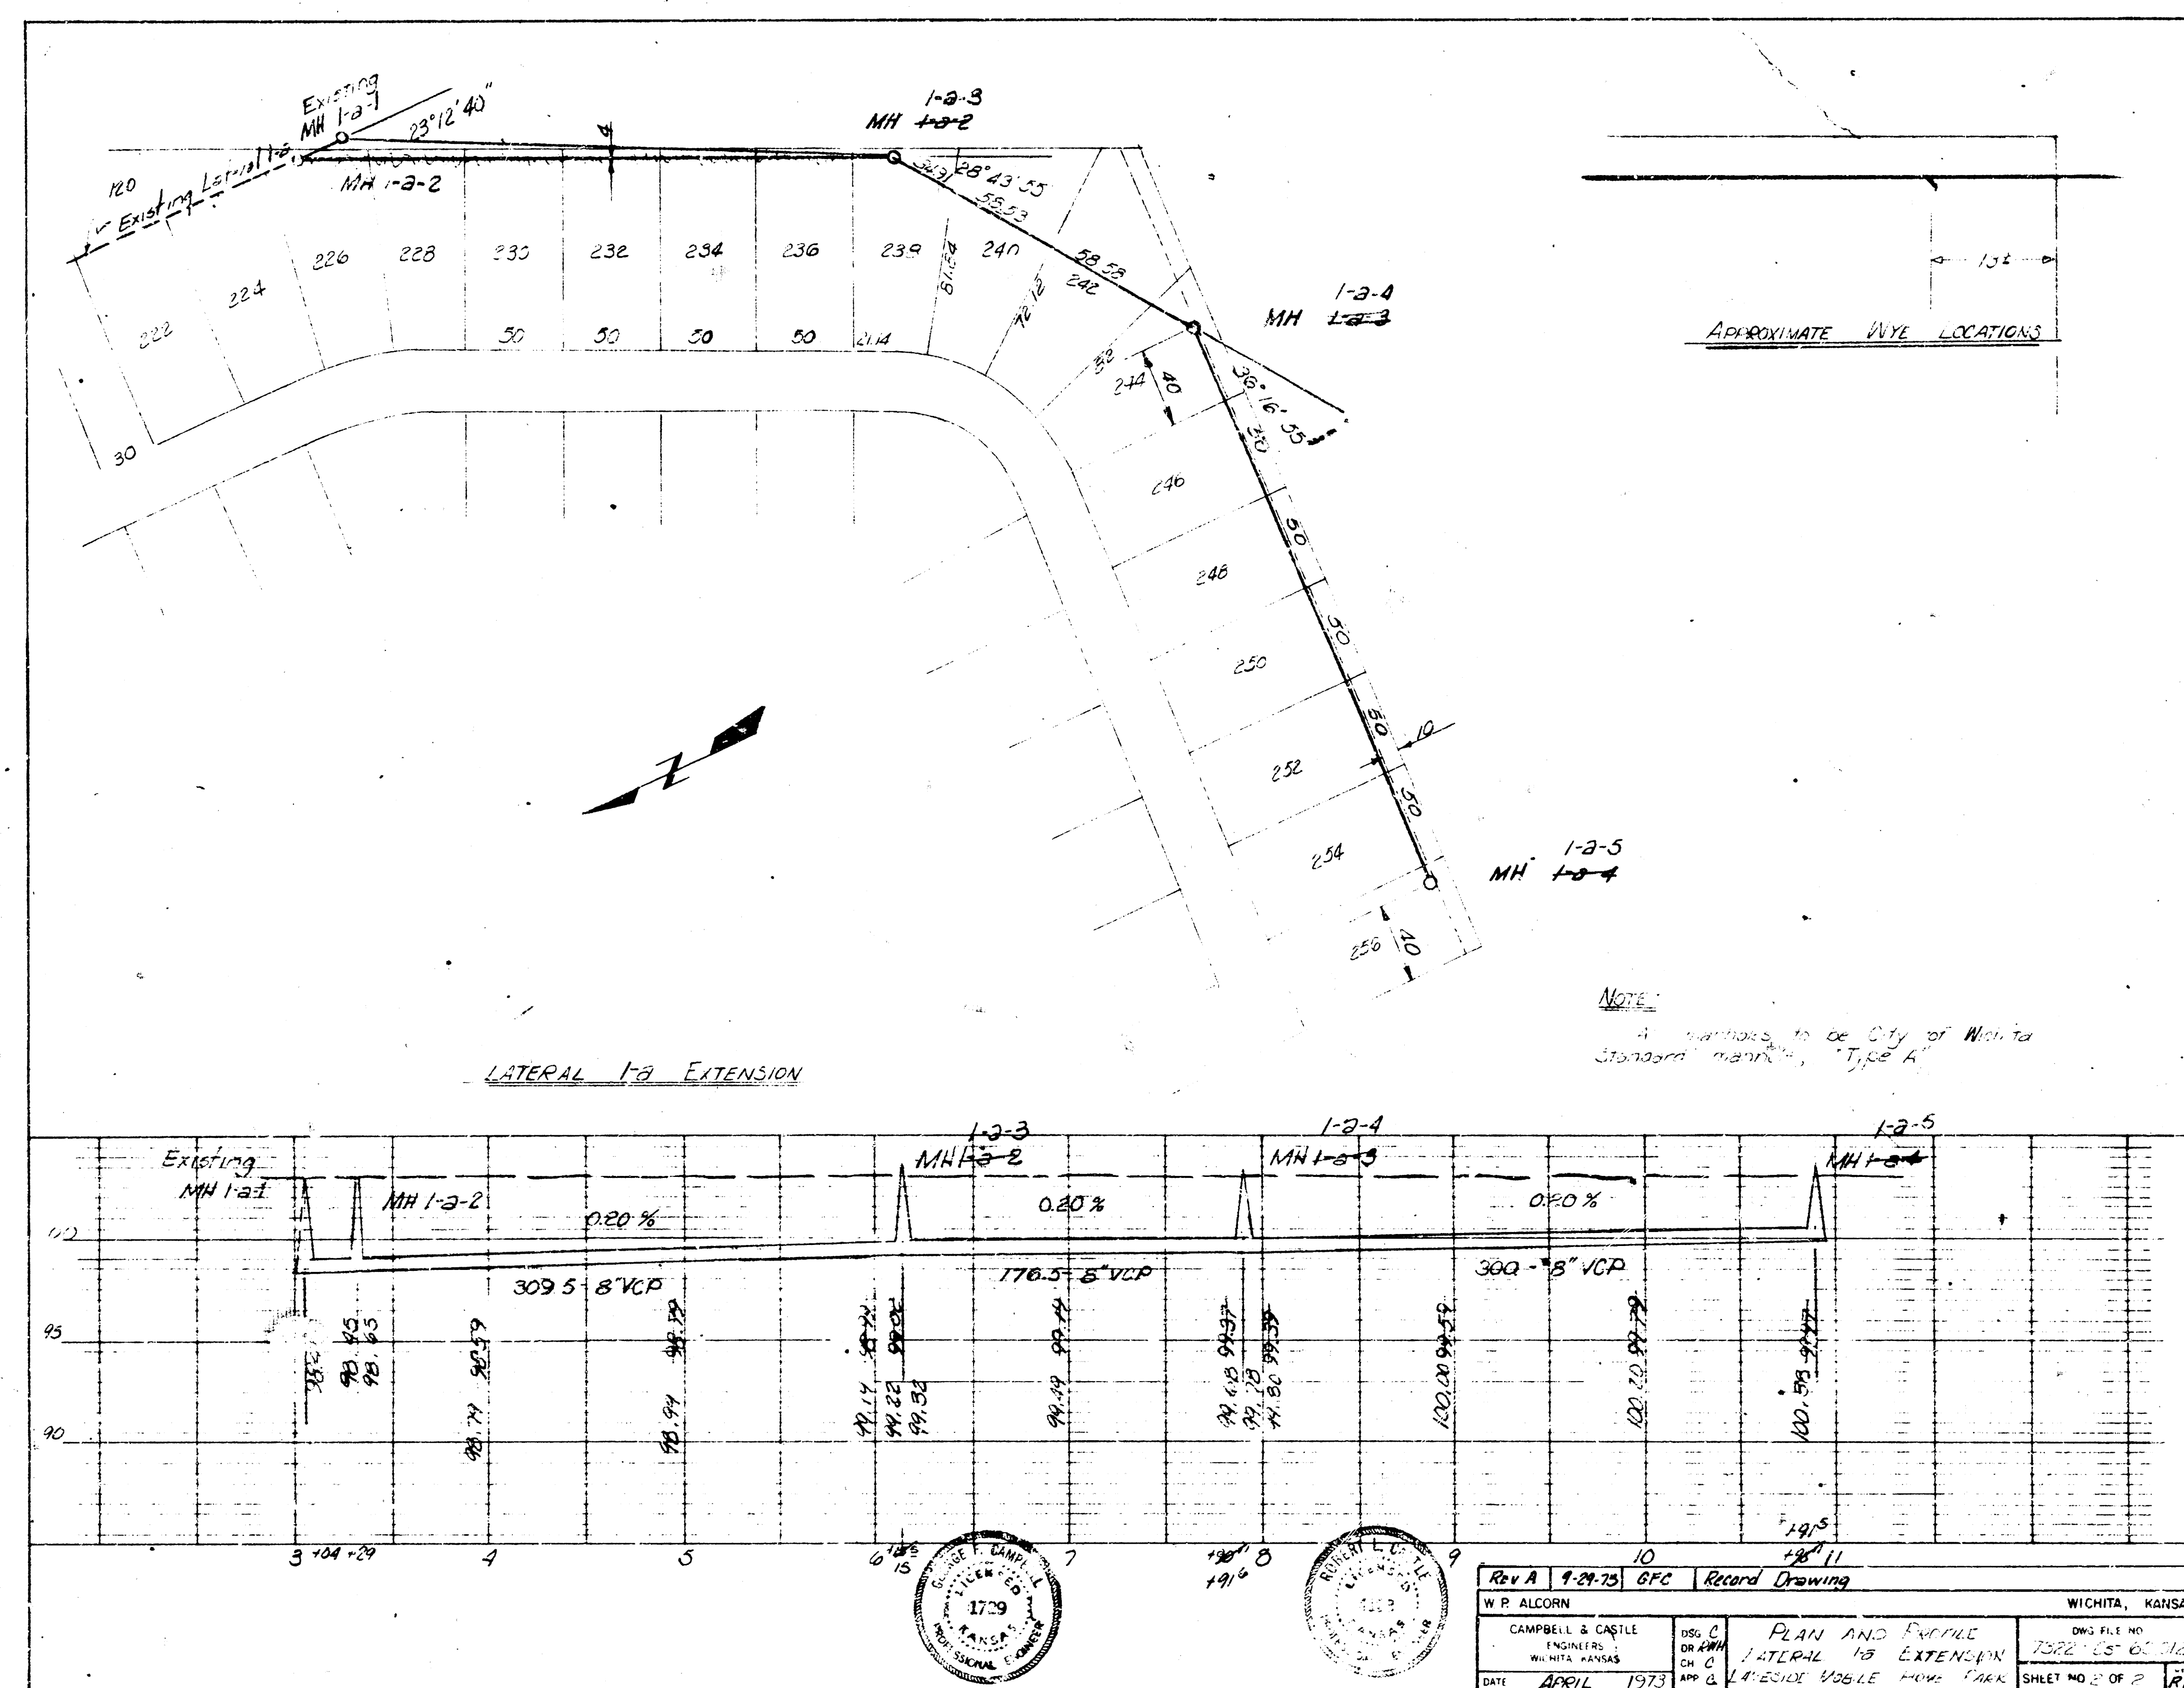


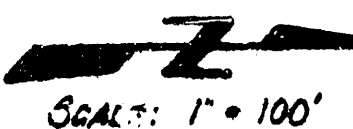


REV A 9-20-73 GFC Added Lateral 1-b Extension			
SOUTHWEST SAND, INC.			
WICHITA, KANSAS			
WYE MAP			
LAKESIDE MOBILE HOME PARK			
2625 SOUTH WEST STREET		WICHITA, KANSAS	
CAMP 1 & CASTLE		DSB	DWG FILE NO
ENGINEERS		ON CLM	6546-D60,009
WICHITA, KANSAS		CH APP.	
DATE	MAY 1966	SHEET NO	1 OF 1
		REV	A




SOUTHWEST SAND, INC.			
WICHITA. KANSAS			
WYE MAP			
LAKESIDE MOBILE HOME PARK			
2625 SOUTH WEST STREET		WICHITA, KANSAS	
CAMPBELL & CASTLE ENGINEERS WICHITA, KANSAS		DSG DC CLIM CH APP	DWG FILE NO 6546-D60,009
DATE	MAY 1968	SHEET NO 1 OF 1	REV.

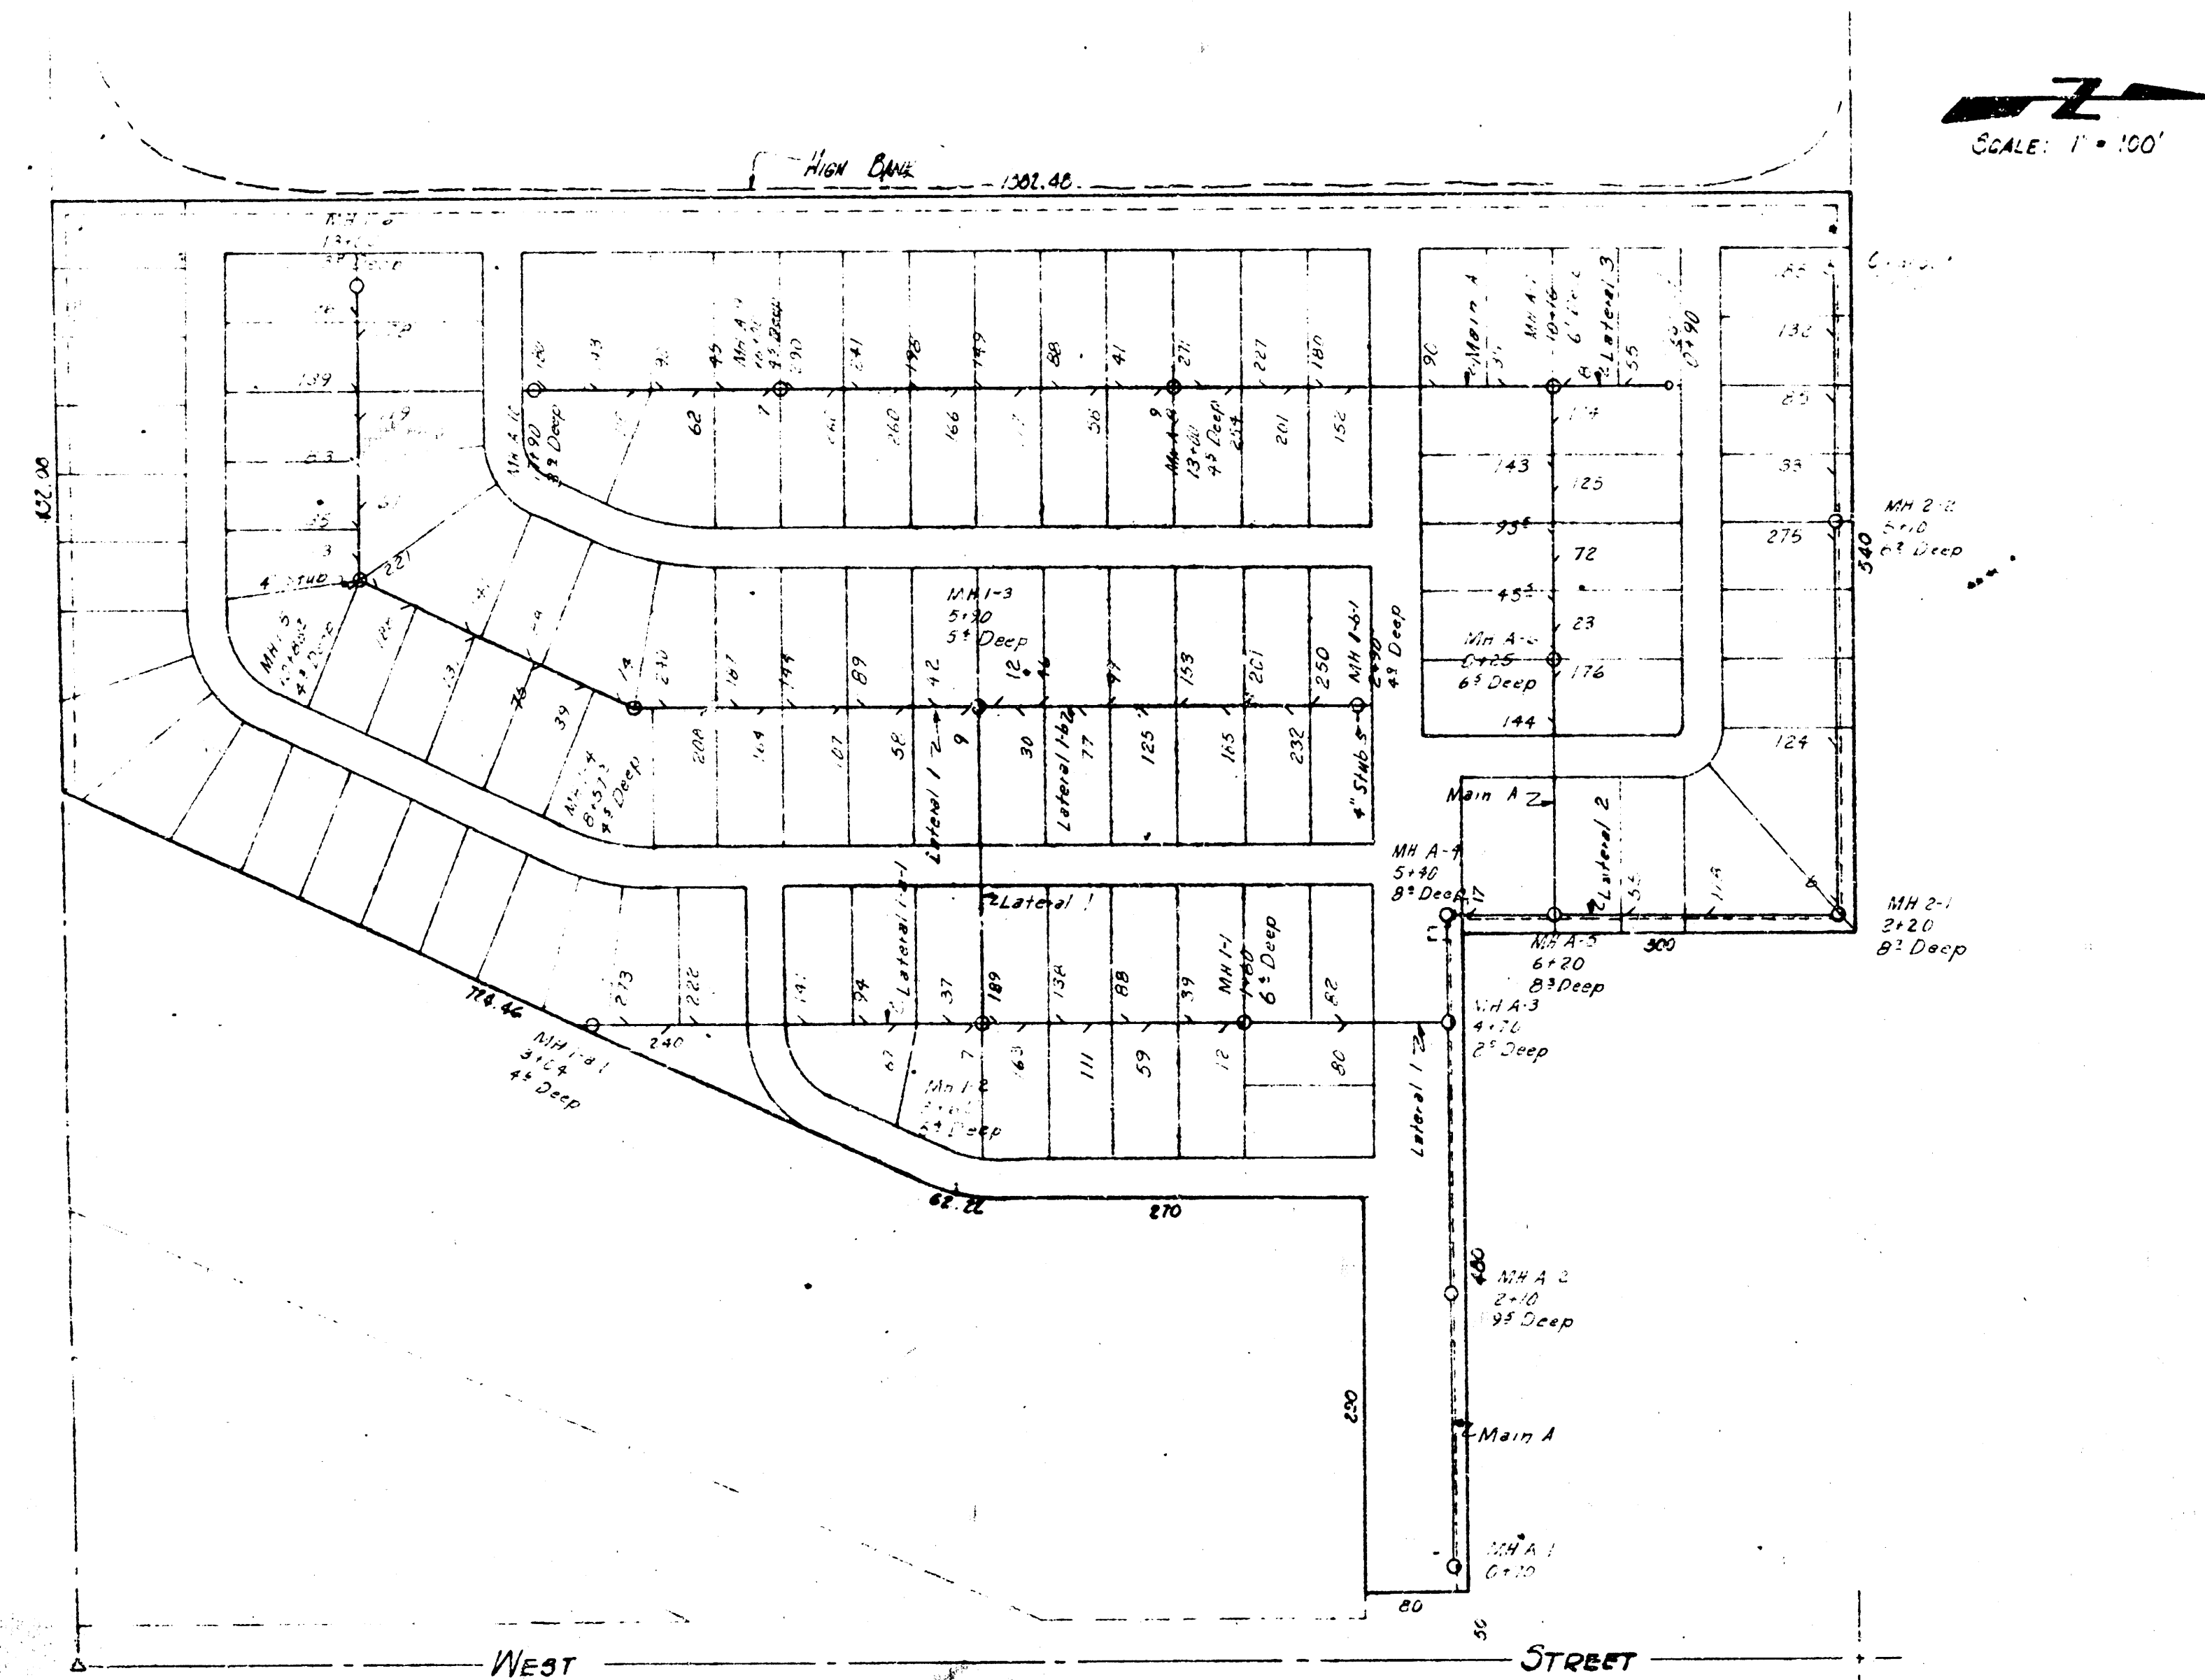

SOUTHWEST SAND, INC. WICHITA, KANSAS			
WYE MAP LAKESIDE MOBILE HOME PARK 2625 SOUTH WEST STREET WICHITA, KANSAS			
CAMPBELL & CASTLE ENGINEERS WICHITA, KANSAS	DSG DR CLM CH APP	DWG. FILE NO. 6546-D60,009	REV.
DATE MAY 1968		SHEET NO 1 OF 1	

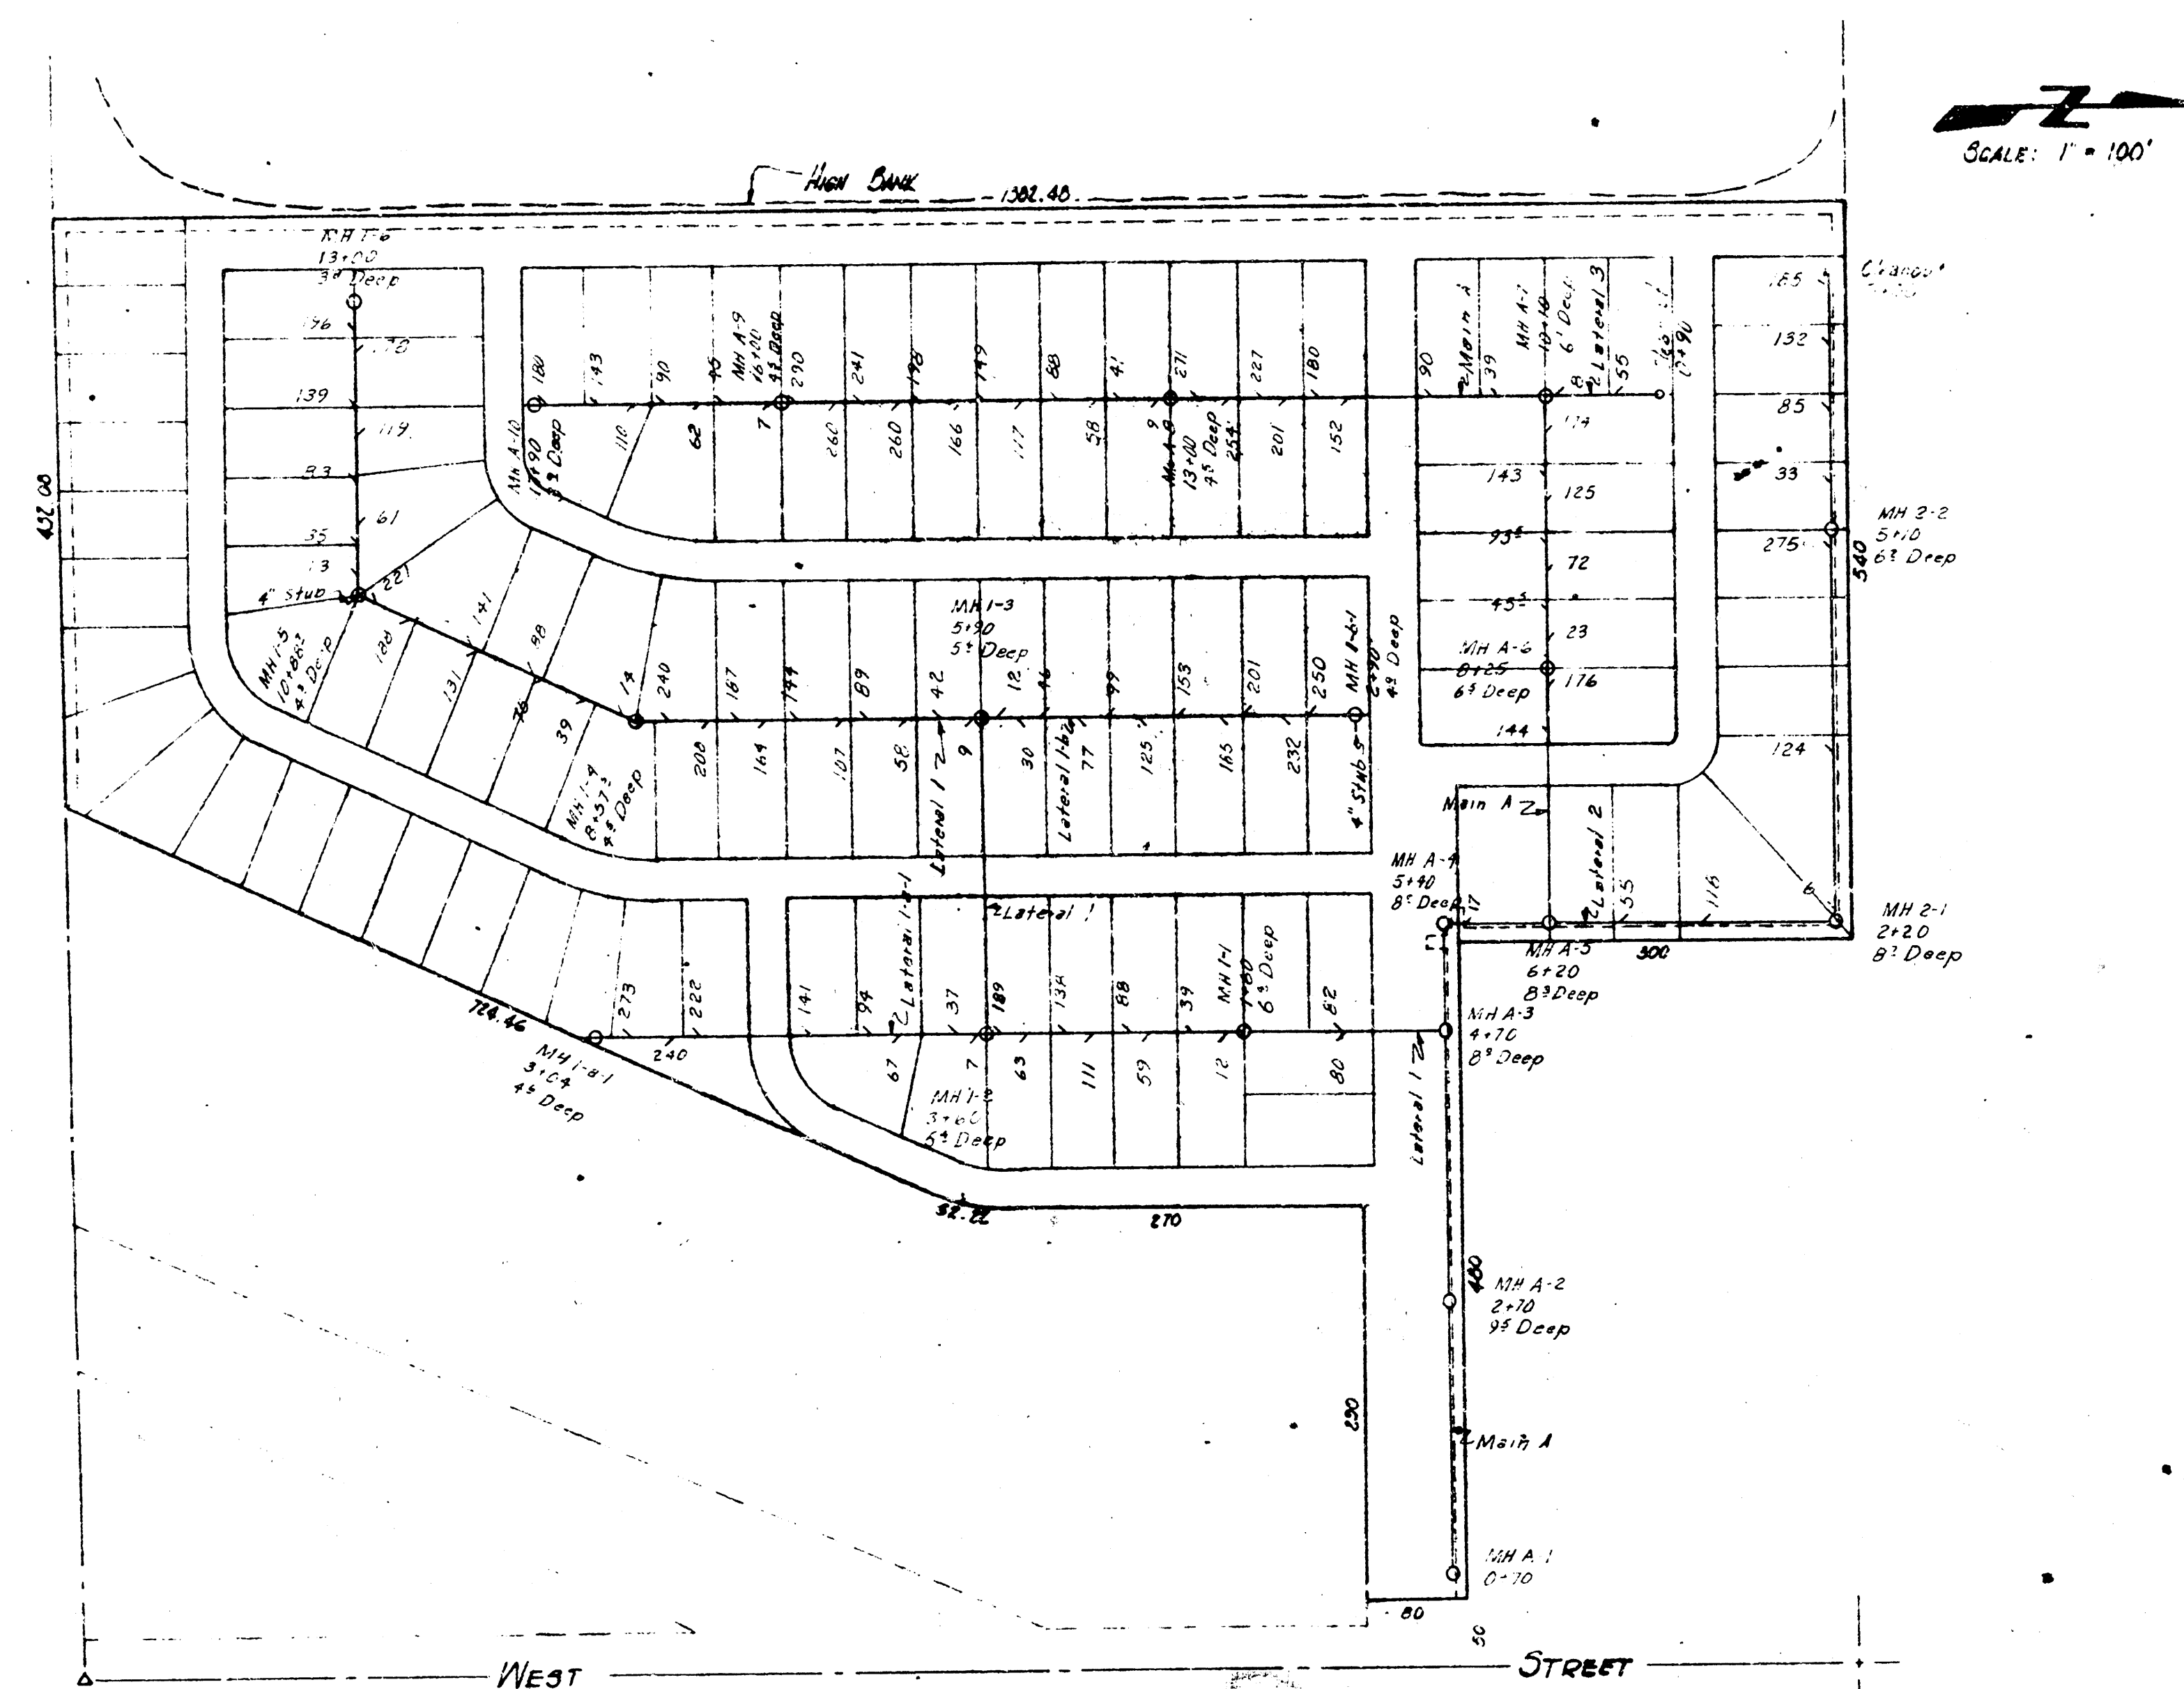

SOUTHWEST SAND, INC.			
WICHITA, KANSAS			
WYE MAP			
LAKESIDE MOBILE HOME PARK			
2025 SOUTH WEST STREET WICHITA, KANSAS			
CAMPBELL & CASTLE	DSG	DWG FILE NO.	
ENGINEERS	DR 214	6546-D60,009	
WICHITA, KANSAS	CH		
DATE MAY 1966	APP	SHEET NO 1 OF 1	REV

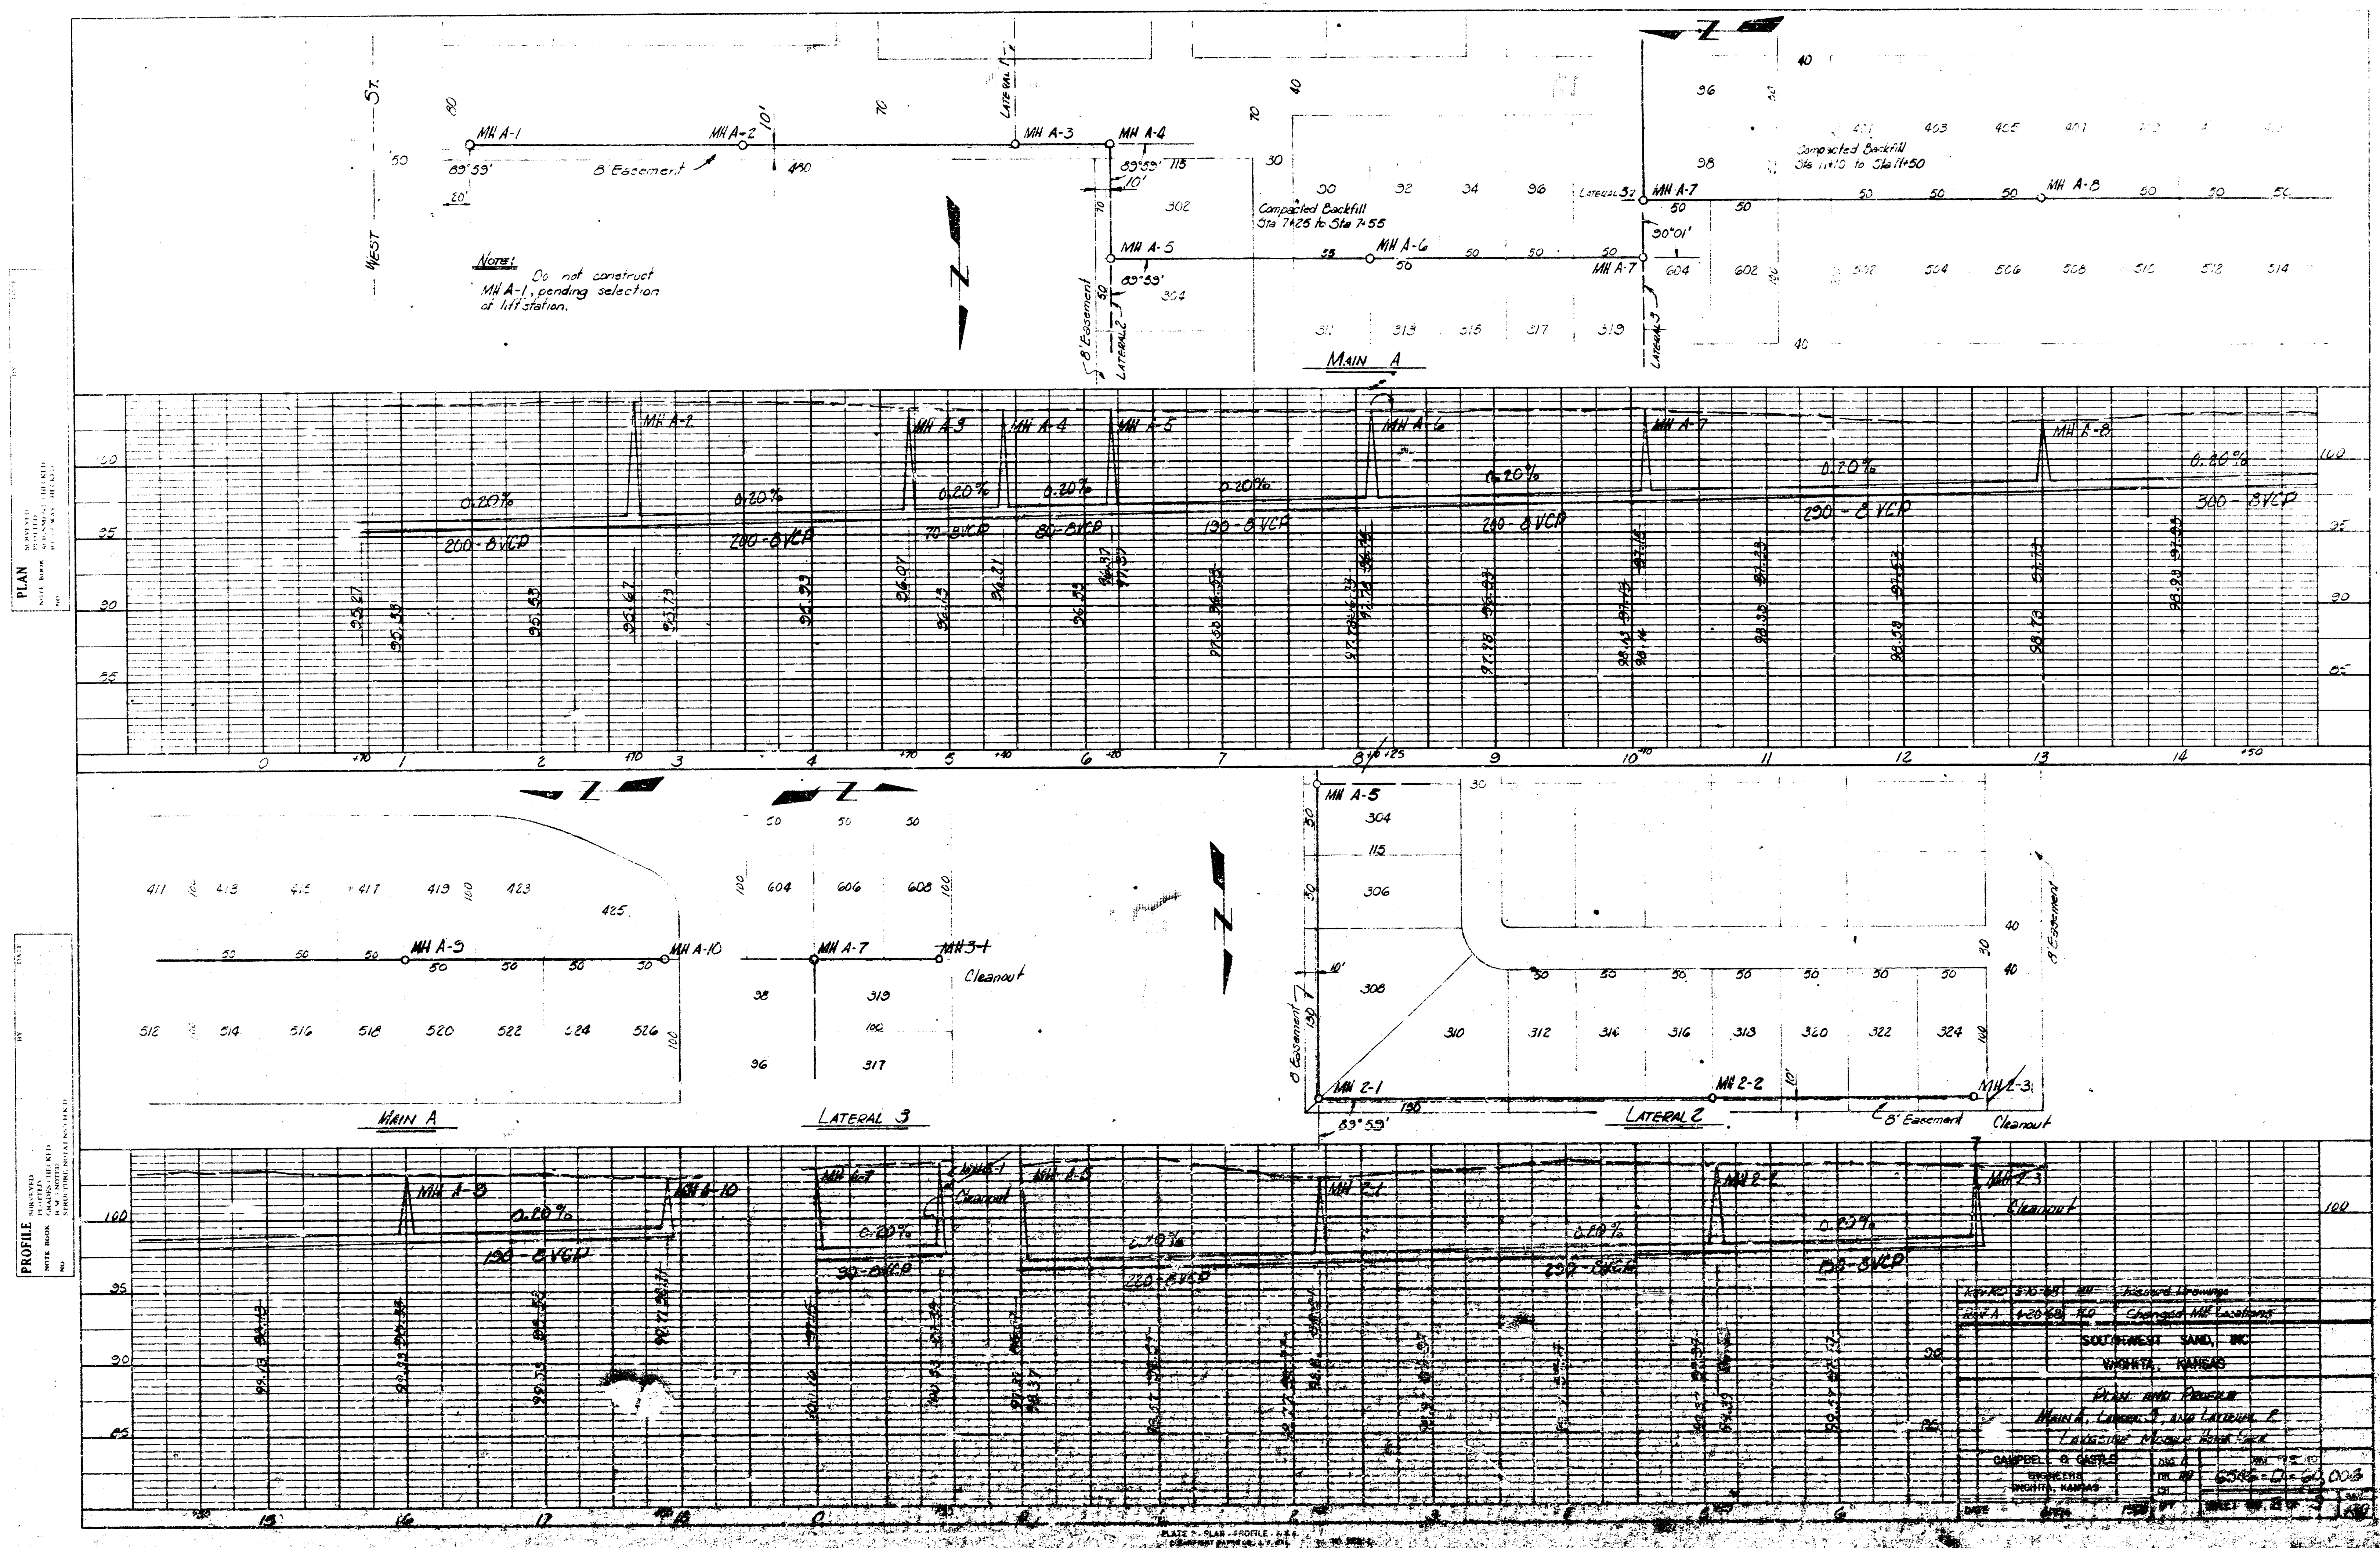

PLAN
 1" = 100'
 NORTH ARROW
 1" = 100'

PROFILE
 1" = 10'
 1" = 100'


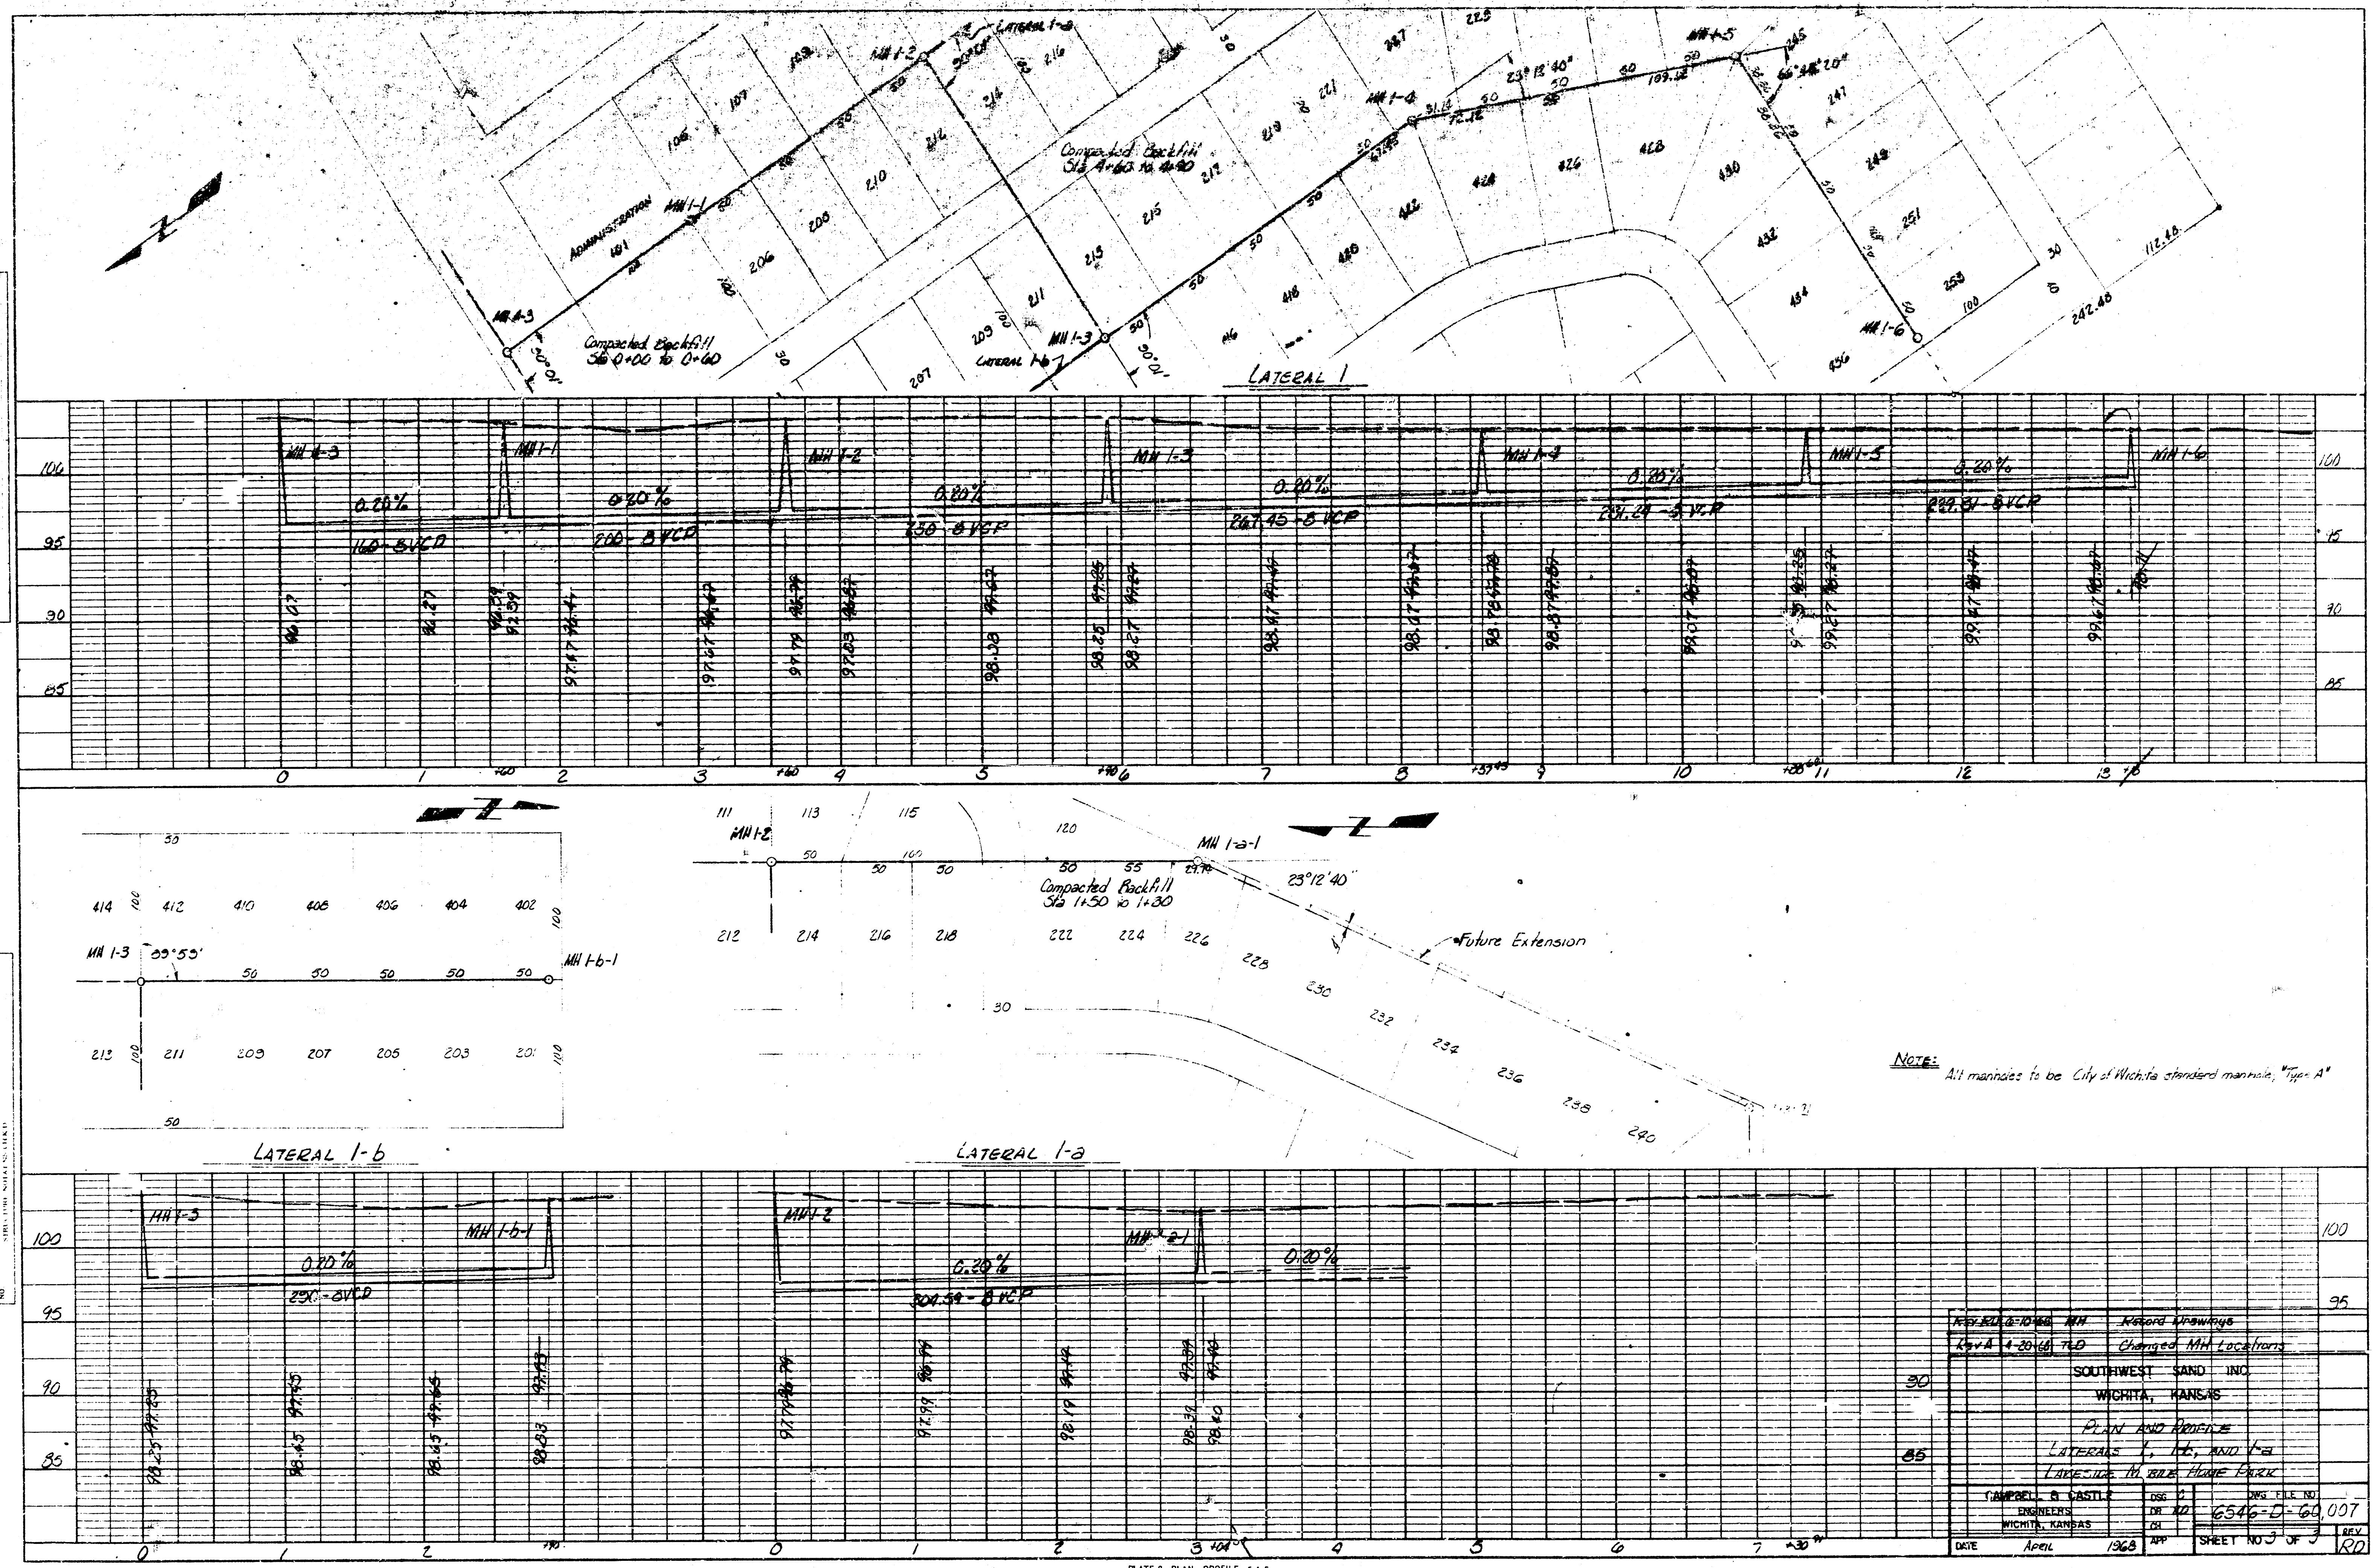


PLATE 2 - PLAN - PROFILE - F.A.S.
 CLEARPOINT PAPER CO. S. P. CAL.
 NO. 1000-2


PLAN	DATE	7-26-68
	BY	R. S. SELLERS
NOTE BOOK	NO.	
	DATE	


PROFILE	DATE	7-26-68
	BY	R. S. SELLERS
NOTE BOOK	NO.	
	DATE	

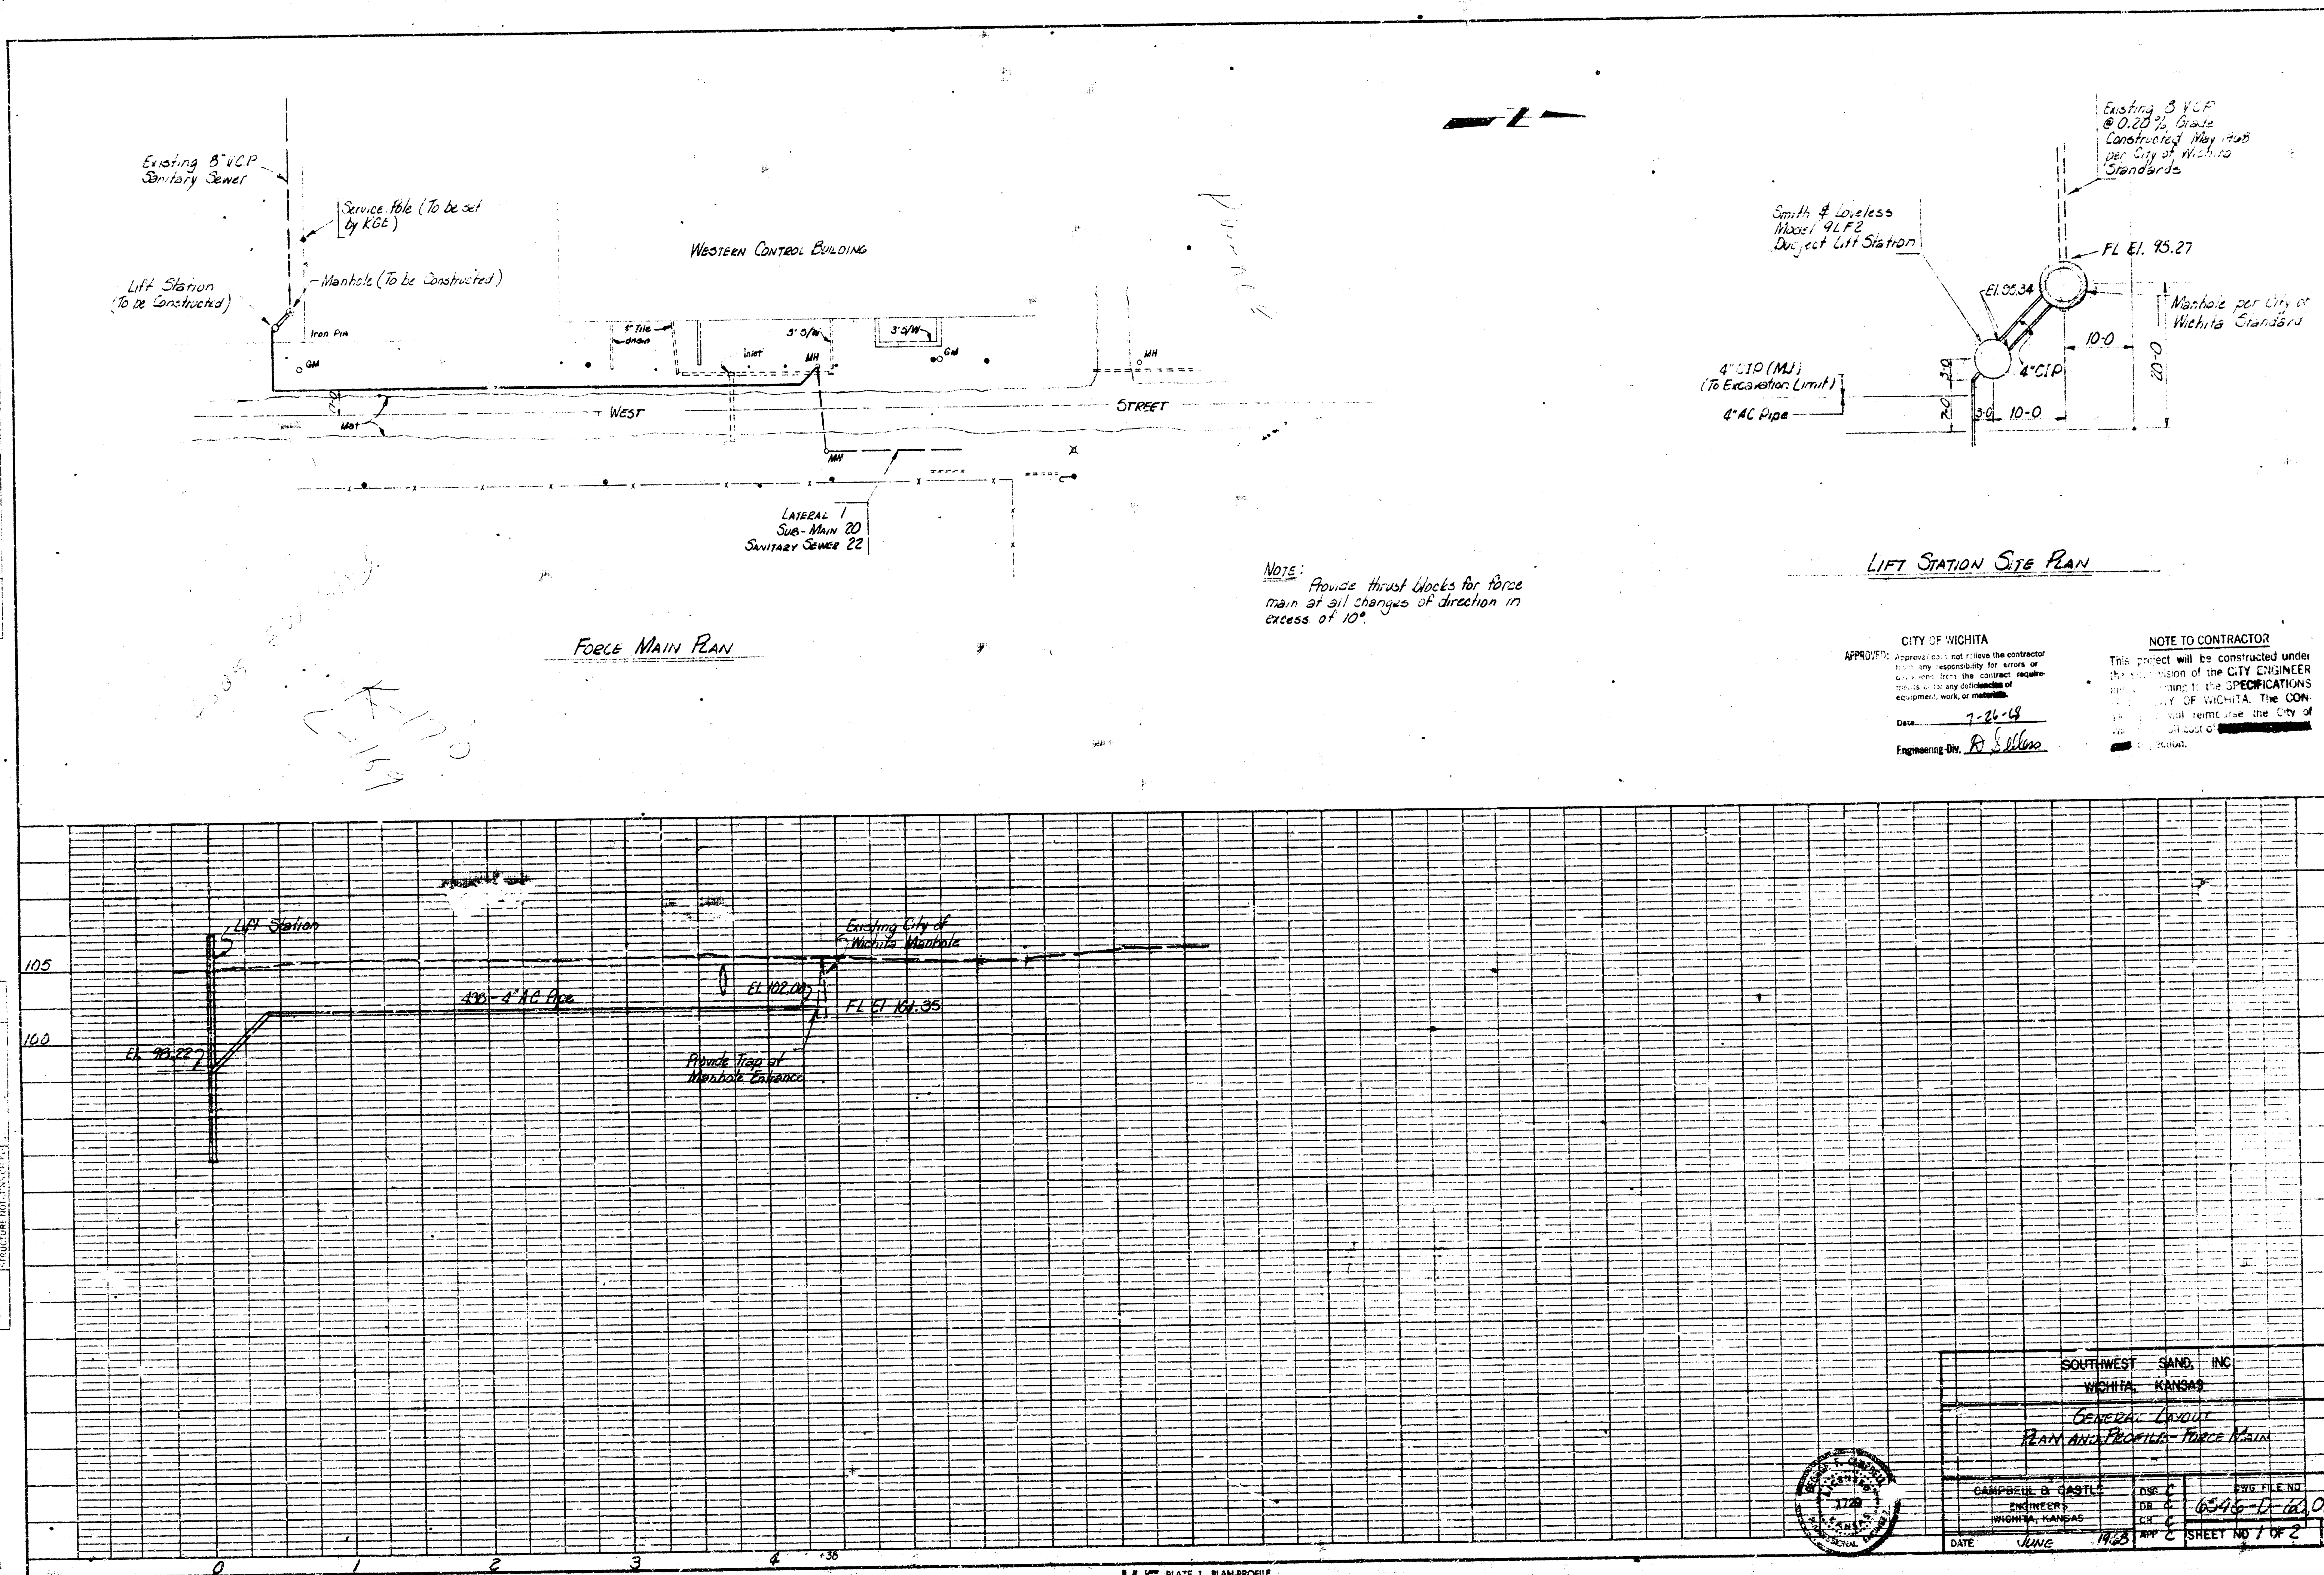



K-E PLATE 1, PLAN/PROFILE
KAPPA & BROS. CO.



SOUTHWEST SAND, INC.	
WICHITA, KANSAS	
GENERAL DRAIN	
PLAN AND PROFILE - FORCE MAIN	
CAMPBELL & CASTLE	ENGINEER
WICHITA, KANSAS	
DATE	JUNE 1968
BY	RAY
SHEET NO.	1 OF 2

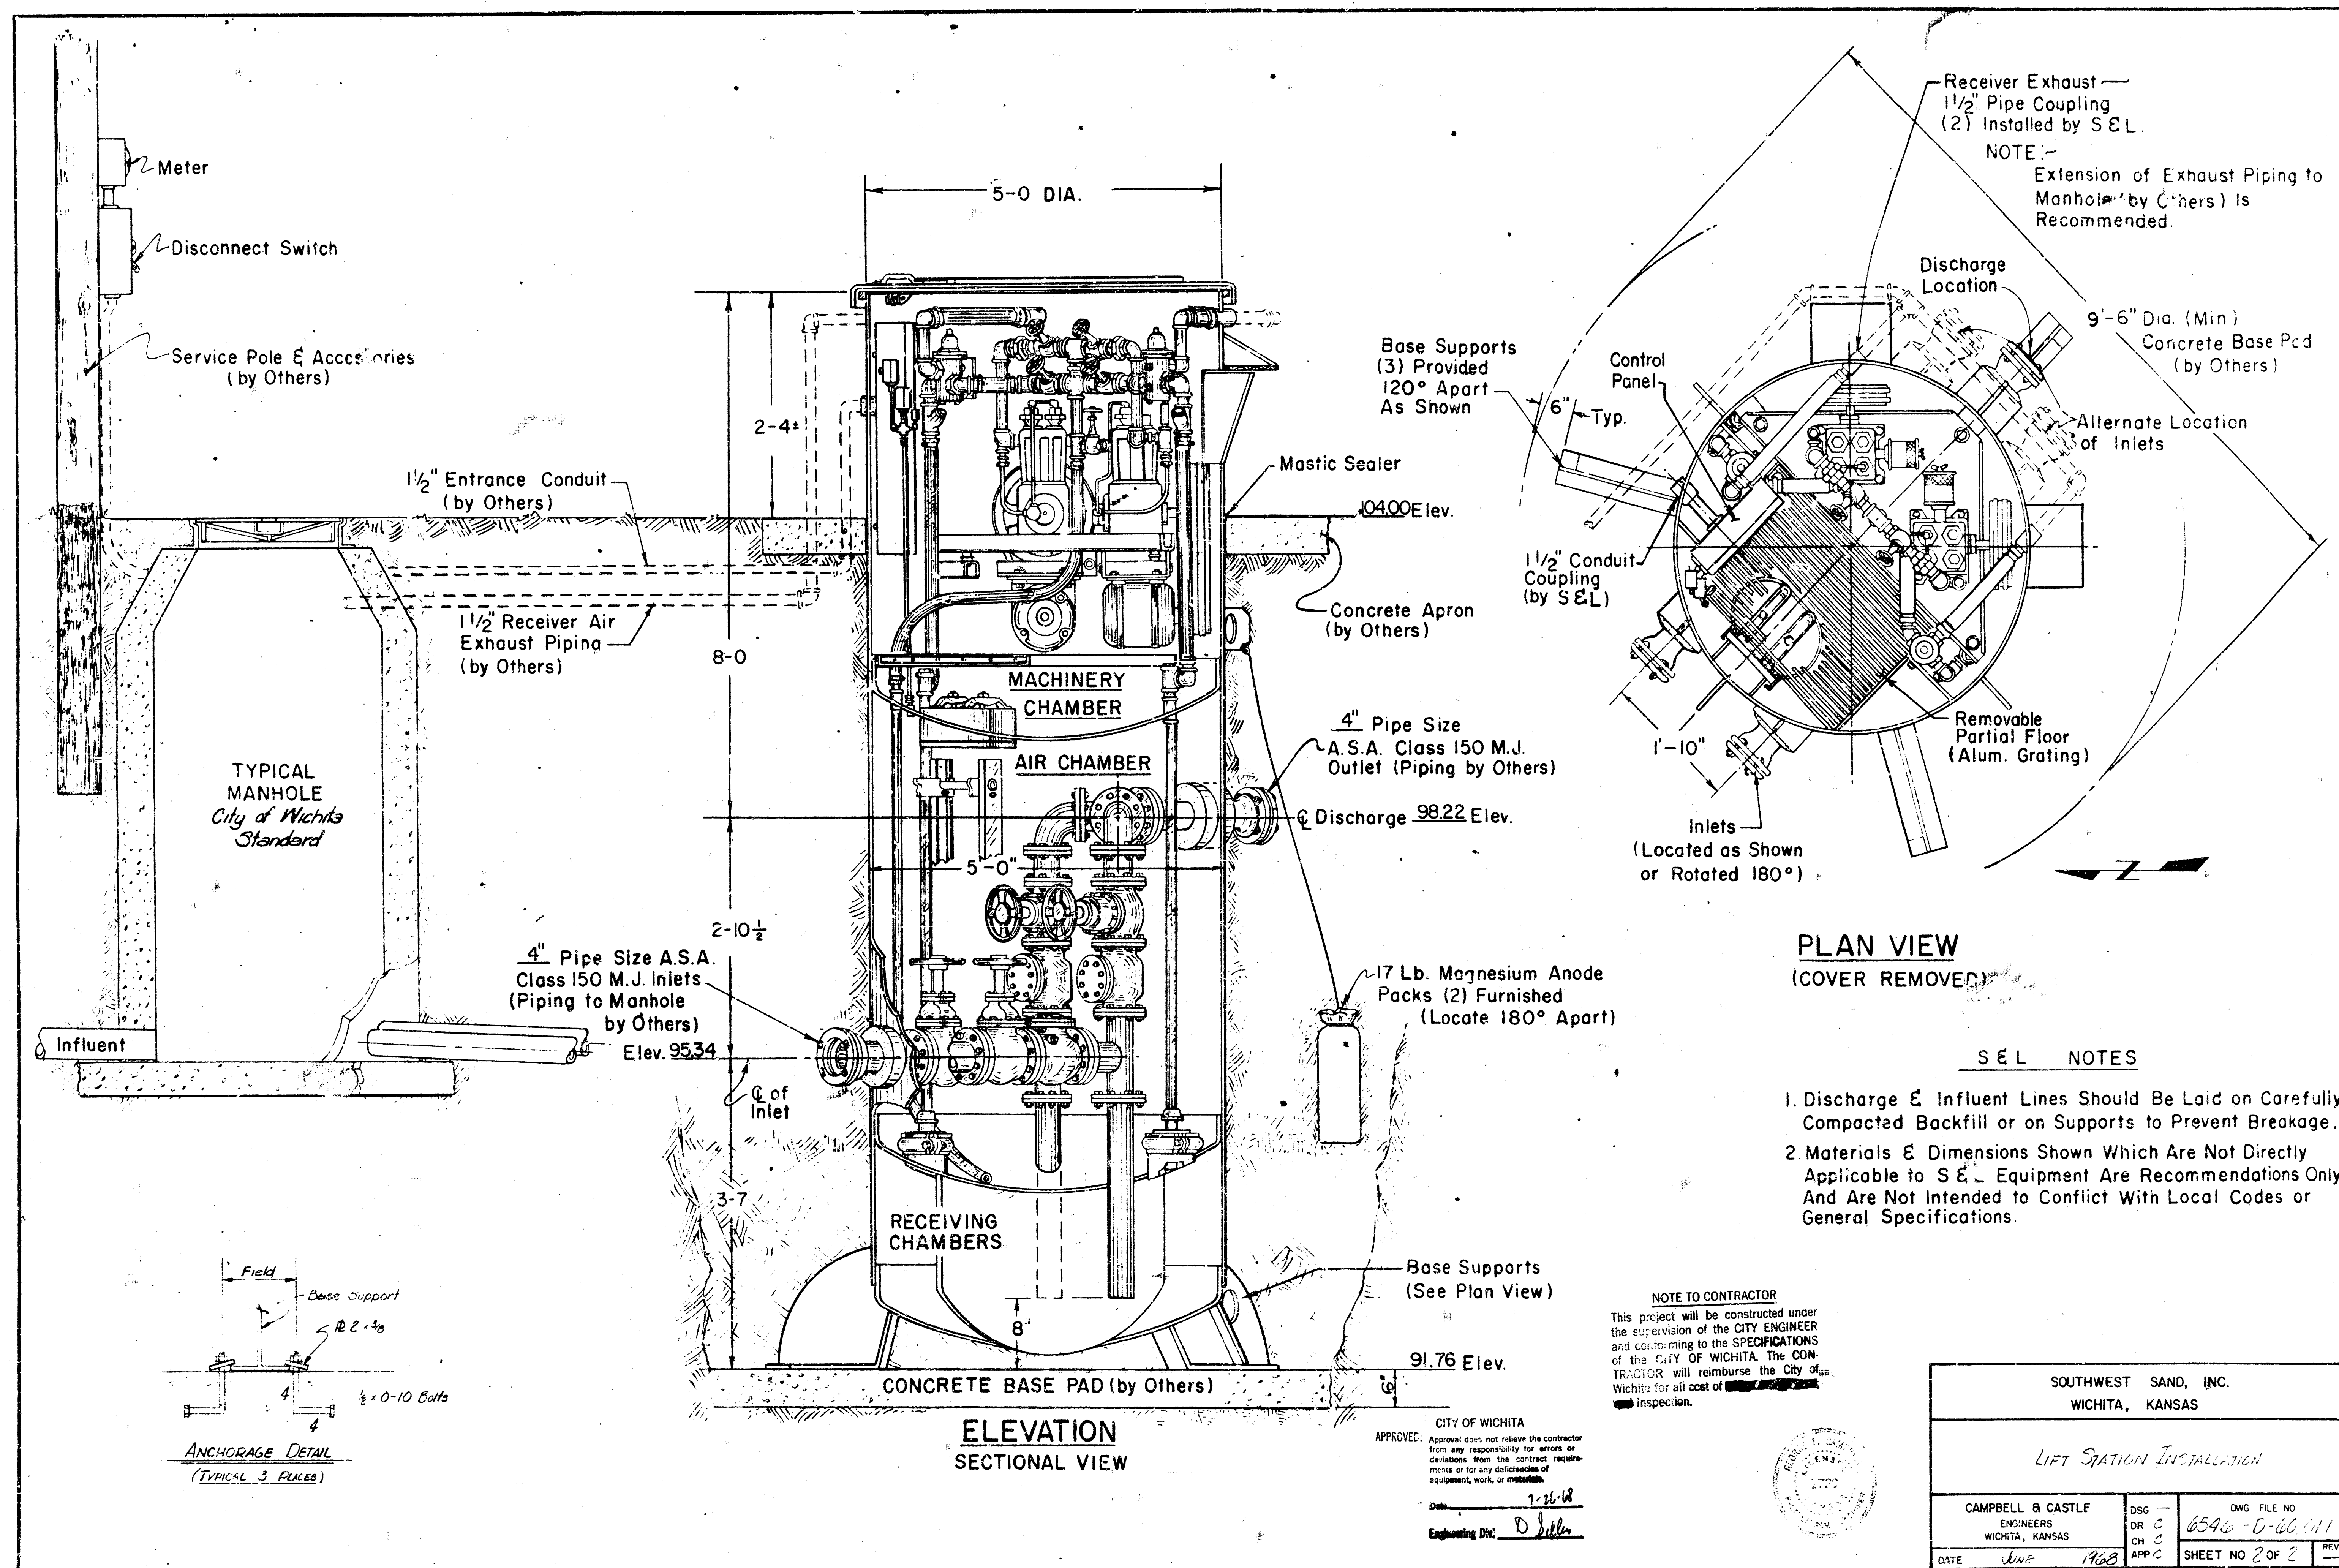

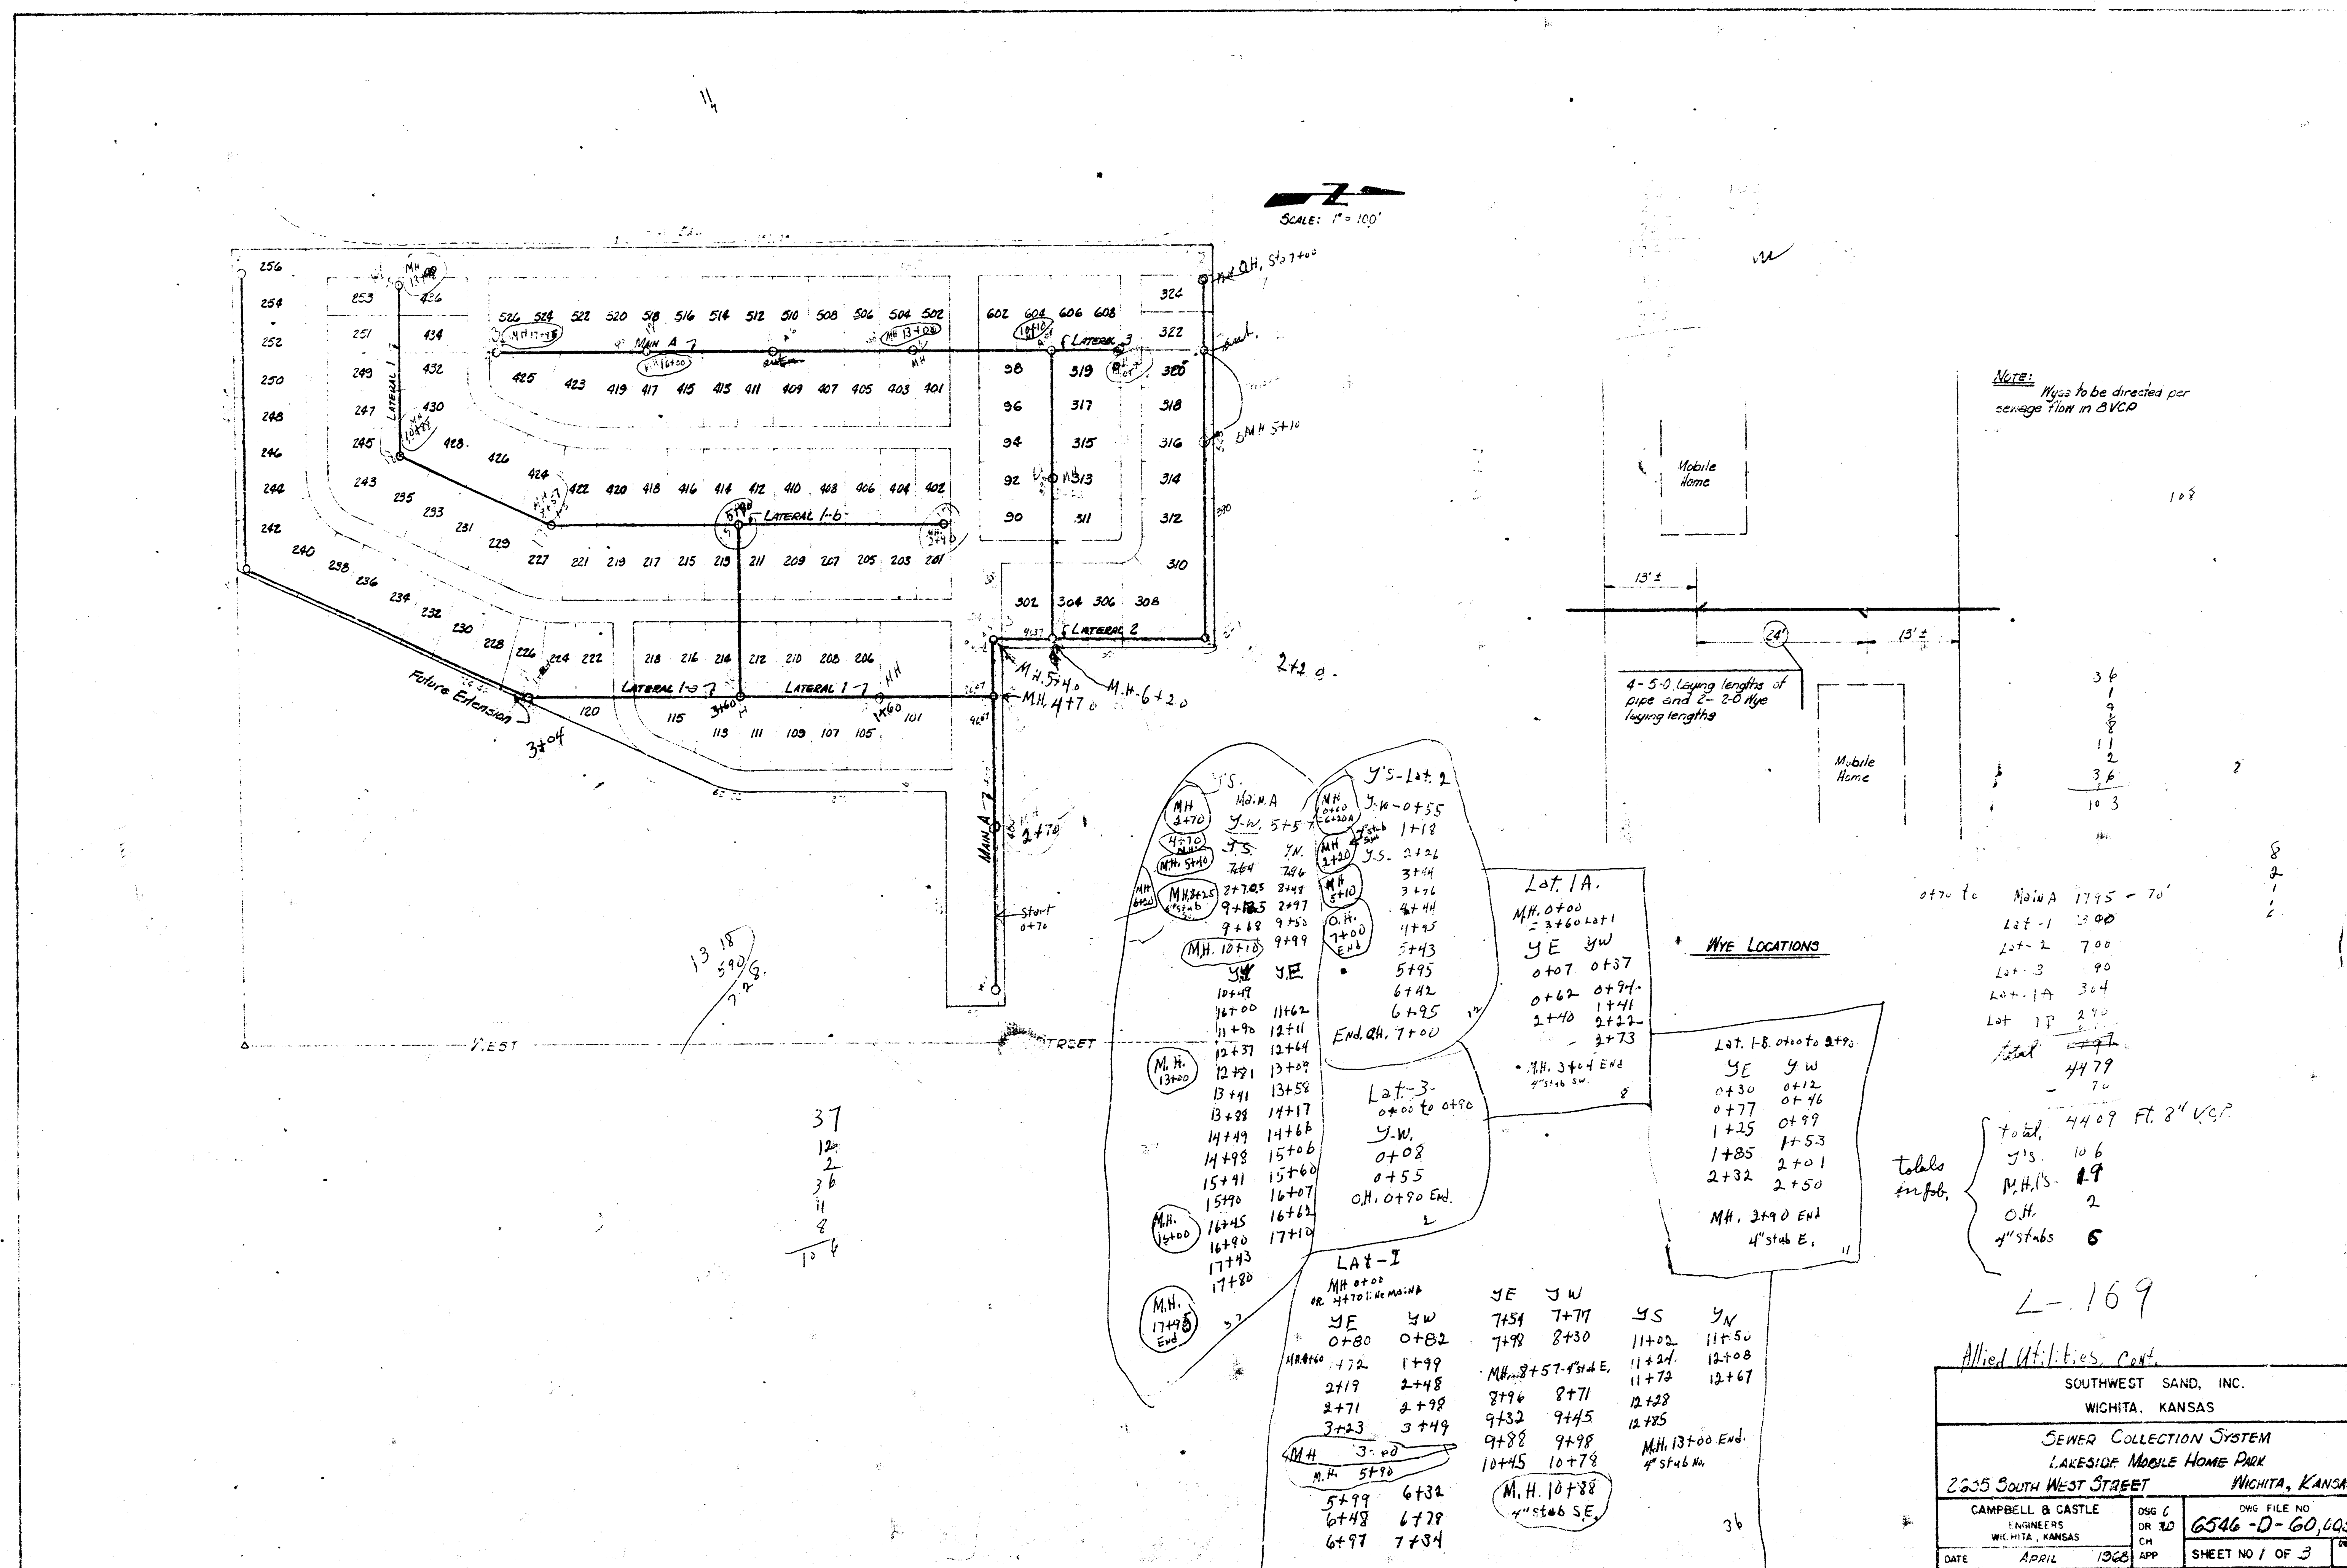

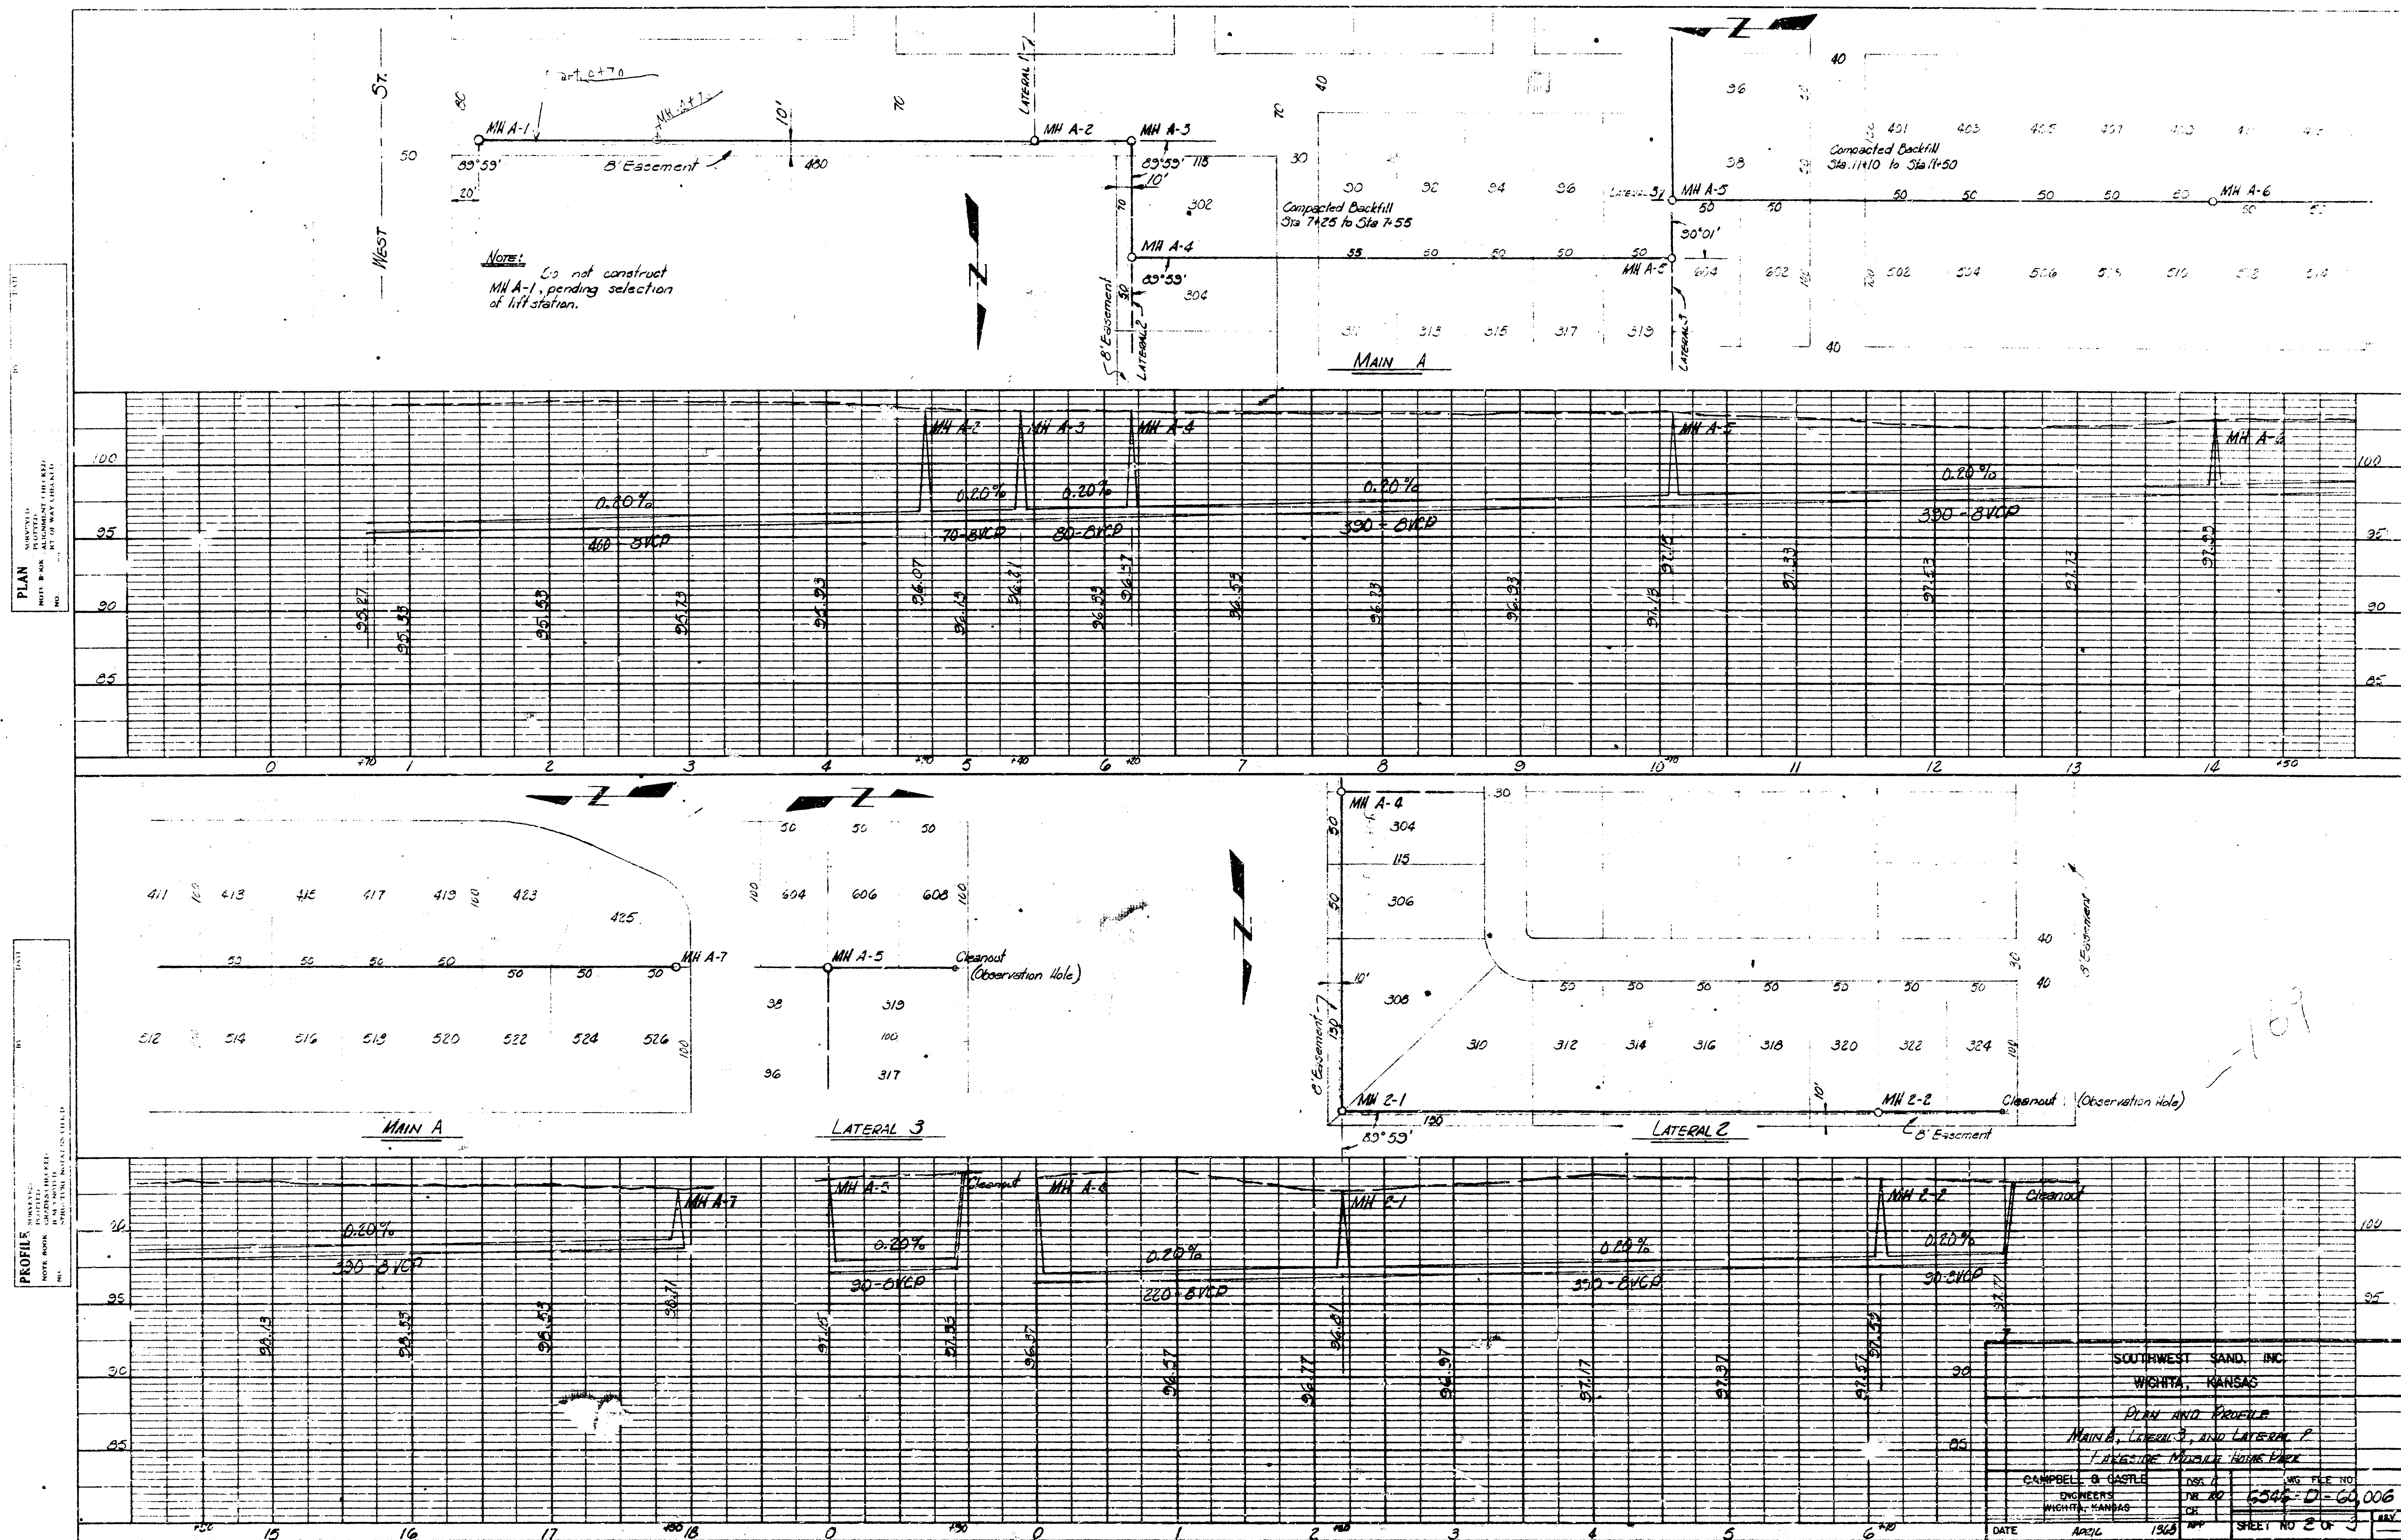

PLAN
 UNADJUSTED
 ELEVATIONS
 BASED ON
 DATUM
 100.00
 BY
 J. W. B. 1968

PROFILE
 UNADJUSTED
 ELEVATIONS
 BASED ON
 DATUM
 100.00
 BY
 J. W. B. 1968

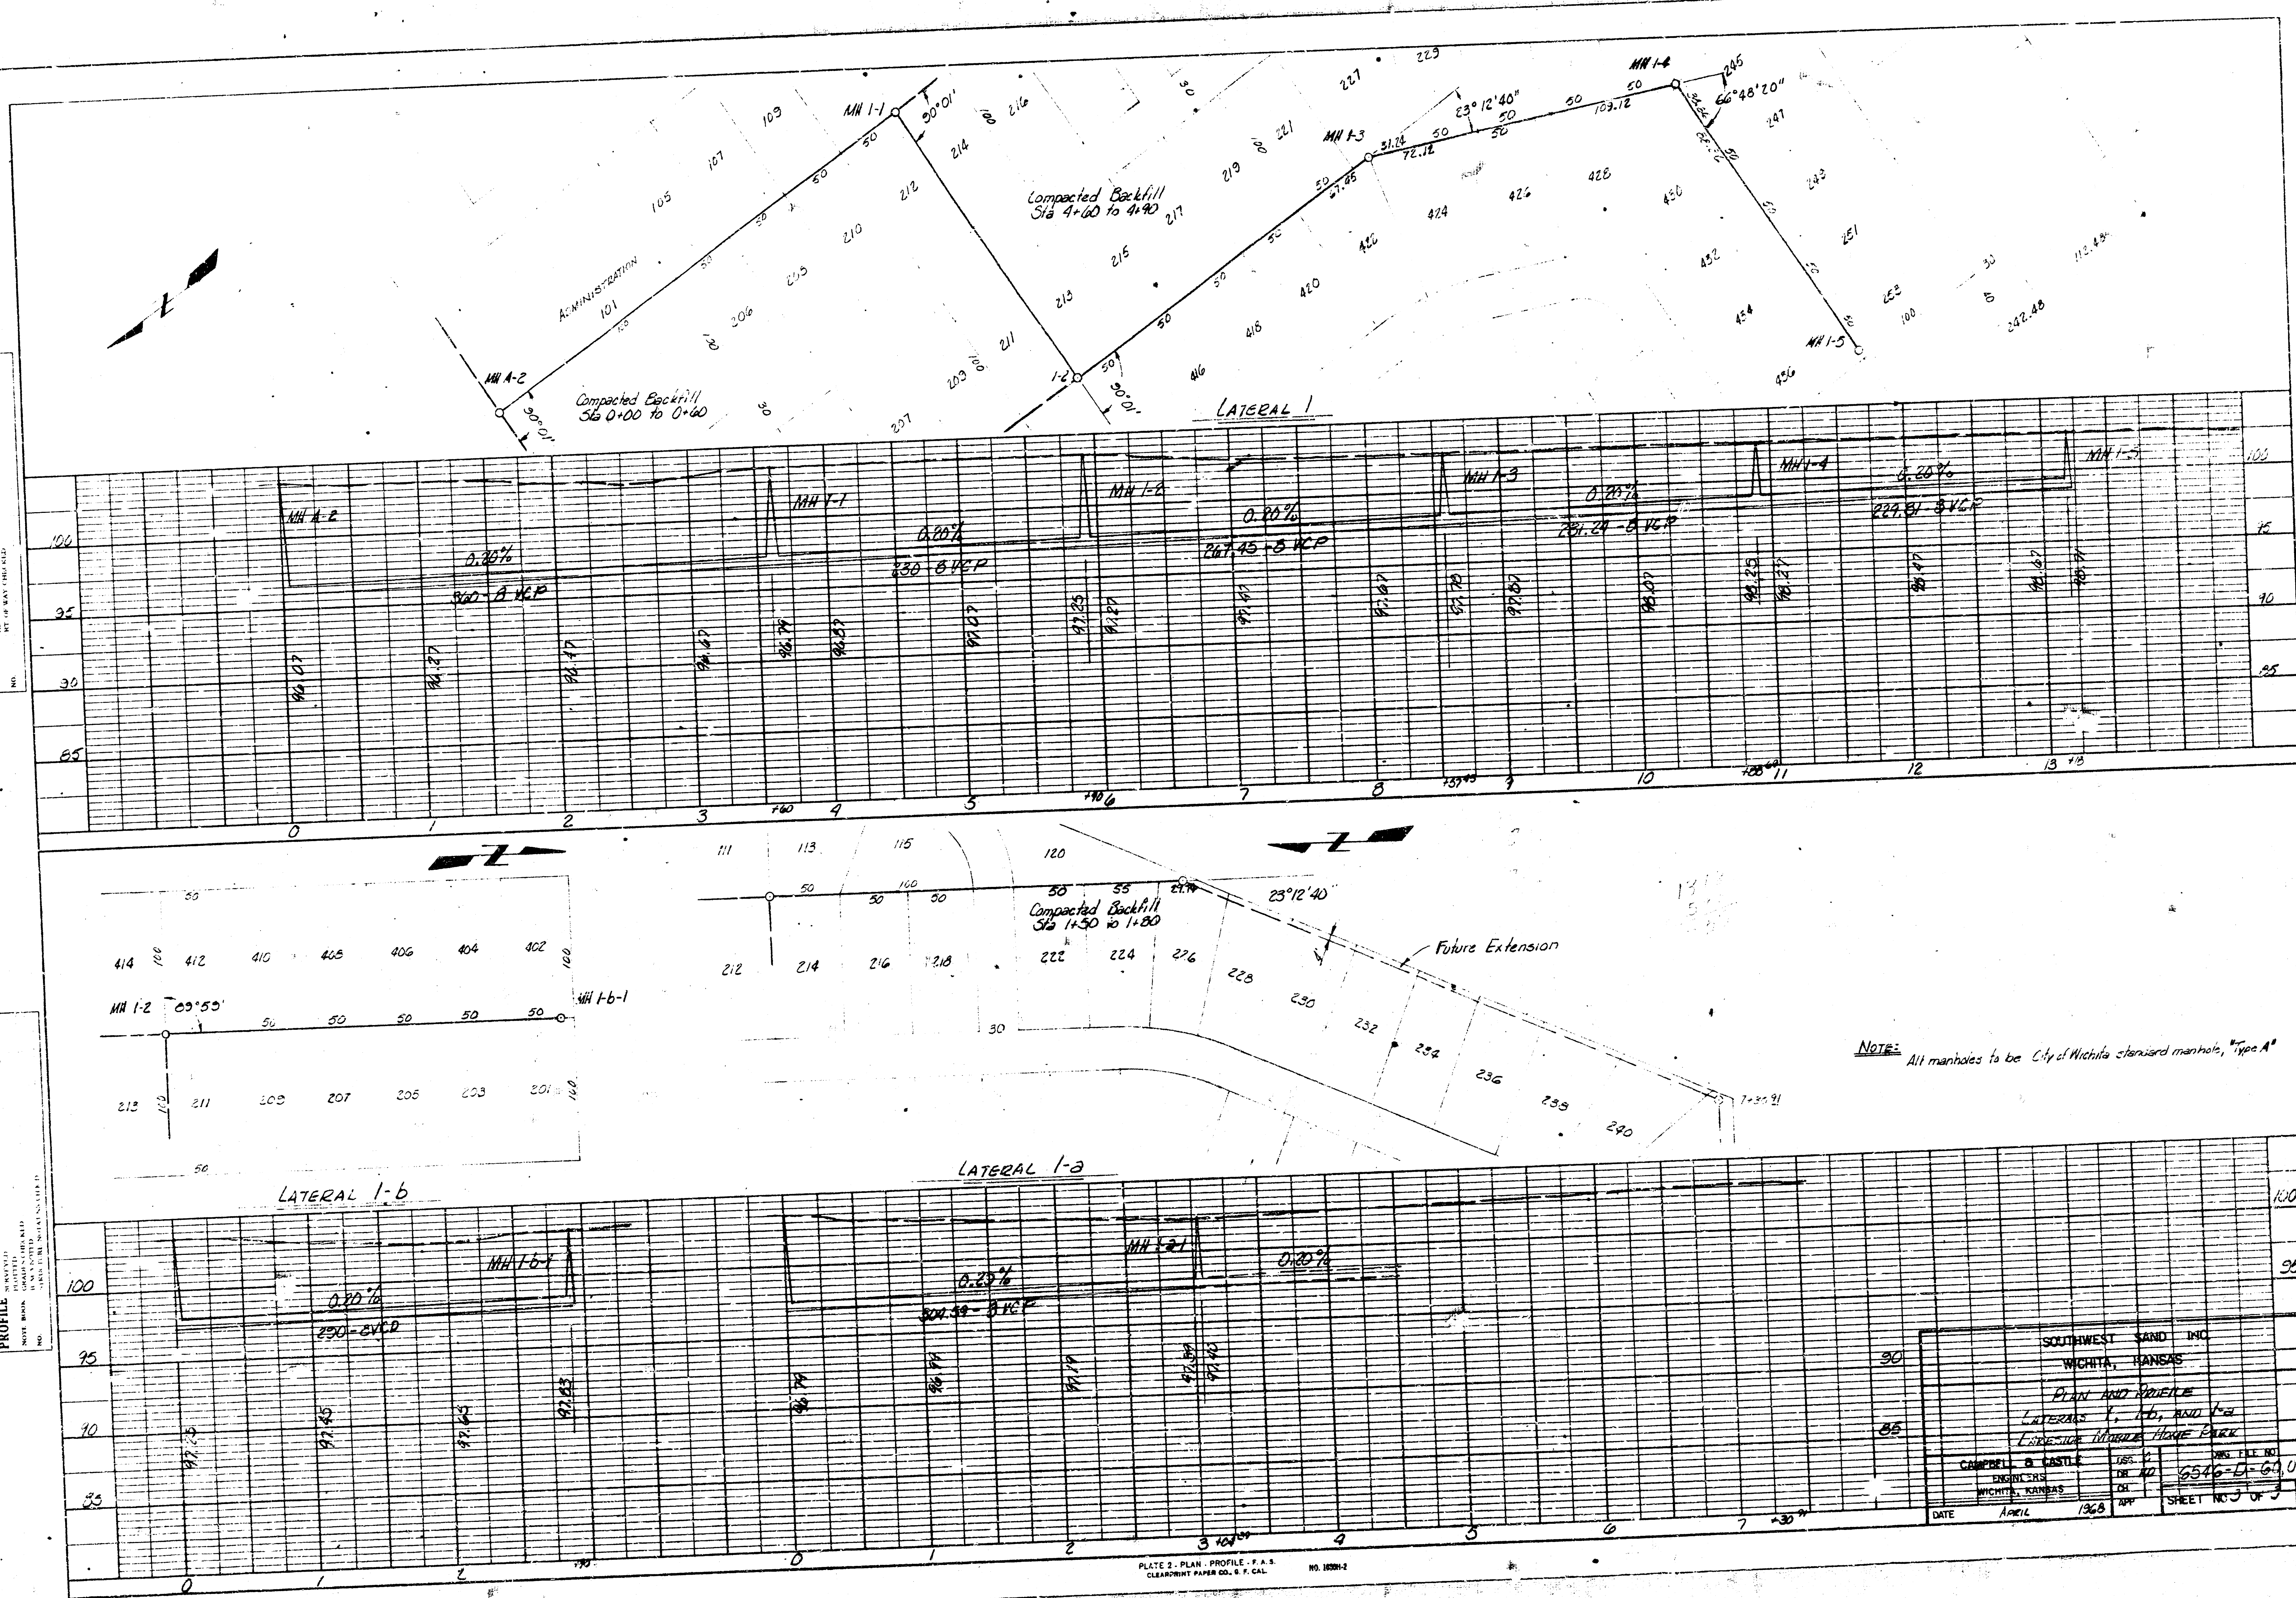


PLATE 2: PLAN - PROFILE, P.A.S.
 CLEARPRINT PAPER CO. & P. CO.
 NO. 1000-2

SOUTHWEST SAND INC.		WICHITA, KANSAS	
PLAN AND PROFILE		LATERALS 1, 1-b, AND 1-c	
LATERAL 1-b		LATERAL 1-c	
CAMPBELL & CASTLE	DES. 12	DATE	APRIL 1968
ENGINEERS	WICHITA, KANSAS	NO. 12	5516-6-68, 007
DATE		SHEET NO. 3 OF 3	