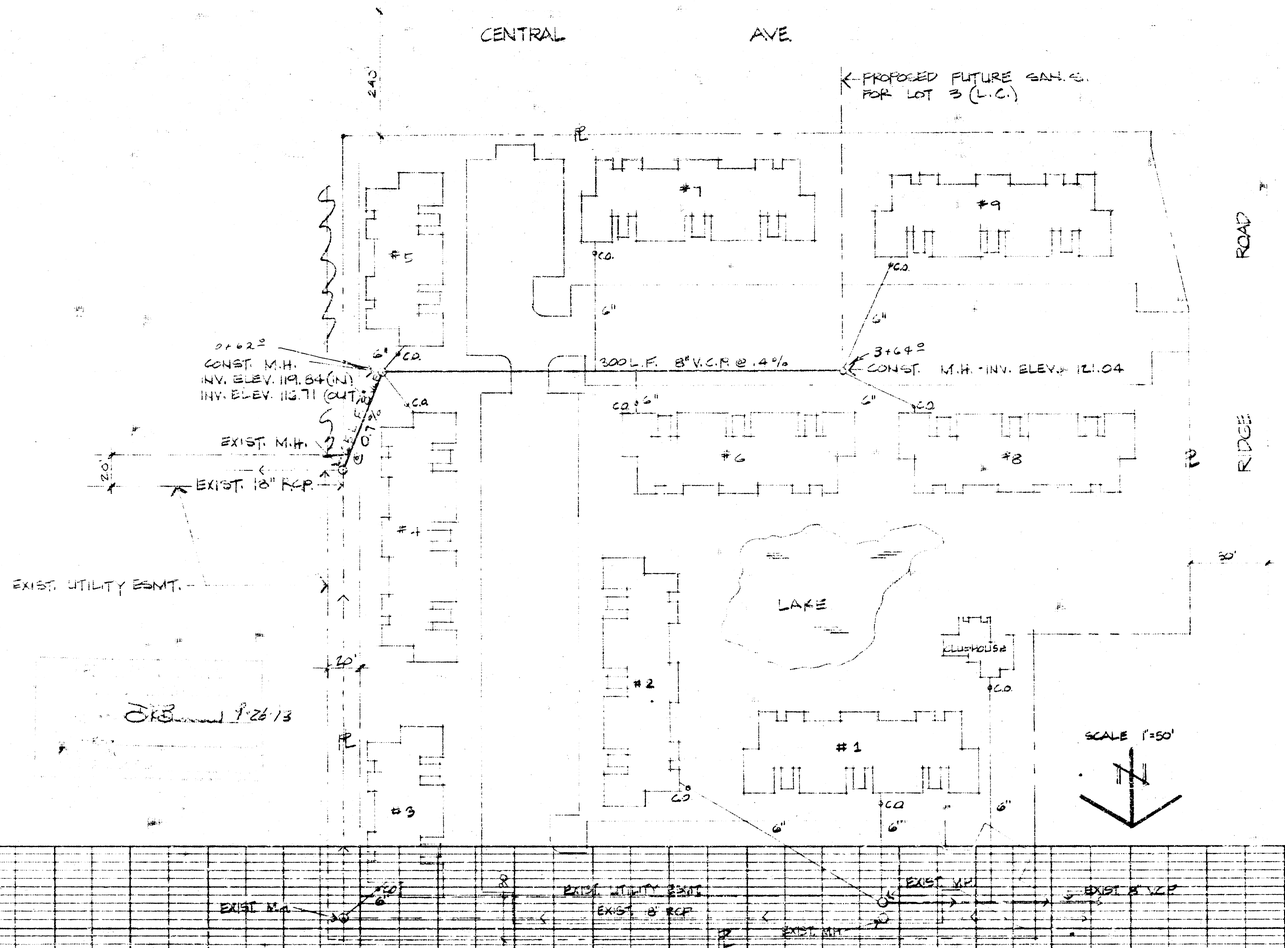

NOTE TO CONTRACTOR

This project will be constructed under the supervision of the CITY ENGINEER and conforming to the SPECIFICATIONS of the CITY OF WICHITA. The CONTRACTOR will reimburse the City of Wichita for all cost of Engineering, Plans, and Inspection.

SANITARY SEWER

LAKEWOOD VILLAGE

As Built Final Meas. K-100
REVISION 9-26-13
BY MW

BHKB 502058

PLATE I - PLAN - PROFILE - F.A.S.