PLANS

FOR

PHASE IV

SANITARY SEWER SYSTEM

FOR

LAMPLIGHTER MOBILE HOME PARK

WICHITA, SEDGWICK COUNTY, KANSAS

CITY OF WICHITA PRIVATE PROJECT NO. ~~466-76-245-8000, C-0-000-055~~ 407 PPS (607861)

1986

APPROVED AS NOTED
By CITY ENGINEER OF WICHITA
Sanitary Sewers 11-12-86
Storm Sewers
Driveway Approaches
Water Mains
Paving

NOTE TO CONTRACTOR

This project will be constructed under the supervision of the CITY ENGINEER and conforming to the SPECIFICATIONS of the CITY OF WICHITA. The CONTRACTOR will pay the City of Wichita for all costs of plan review, inspection and booking per contract.

INDEX OF SHEETS

SHEET 1 TITLE SHEET
SHEET 2 LAYOUT MAP
SHEET 3 UTILITY MAP
SHEET 4 MAIN 1
SHEET 5 LATERAL A
SHEET 6 LATERAL B
SHEET 7 LATERALS C, C-1, D, & E
SHEET 8 LATERALS F,G,H,I, & J
SHEET 9 TYPE "A" & "B" MANHOLES & CONCRETE ENCASEMENT
SHEET 10 SHALLOW MANHOLES, TYPE "A" & "B"
SHEET 11 MANHOLE ADJUSTMENT DETAILS
SHEET 12 RISER DETAILS
SHEET 13 MANHOLE DETAIL, TYPE "C"

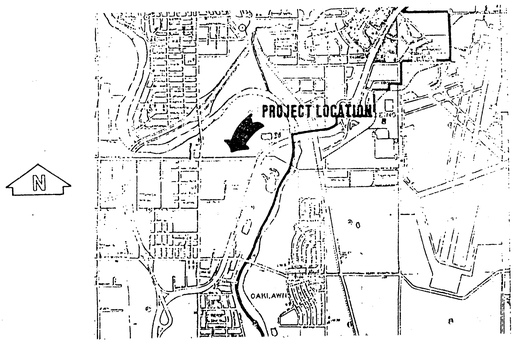

BM:
RAILROAD SPIKE IN POWER POLE AT THE SW COR. OF THE PLAT.
ELEV. 85.23
CITY OF WICHITA DATUM

Booked 11-5-93
JKB
From As Builts

NOTE:
CONTRACTOR HAS THE OPTION OF USING THE TYPE "C" MANHOLE WITH APPROVAL OF THE ENGINEER

Phase IV Revised as built 10-9-95 (Lat. I-H) JCR (SRB)
Phase III Revised as built 8-27-92 (Main 1) Sta. 14+31 to 16+74 (3+19.1 to 5+68.5) Baughman Co.
Phase II Revised as built 7-5-90 (Lat. F & G and Main 1, Sta. 0+00 (11+12) to 3+19.1 (14+31)).

REISS & GOODNESS ENGINEERS
2160 WEST 21ST STREET
WICHITA, KANSAS 67203
(316) 832-0213

REVISION	DRAWN BY	CHECKED BY	DESIGNED BY	PROJECT	CUSTOMER	SCALE	PROJECT NO.
						DATE	SHEET 1 OF 13

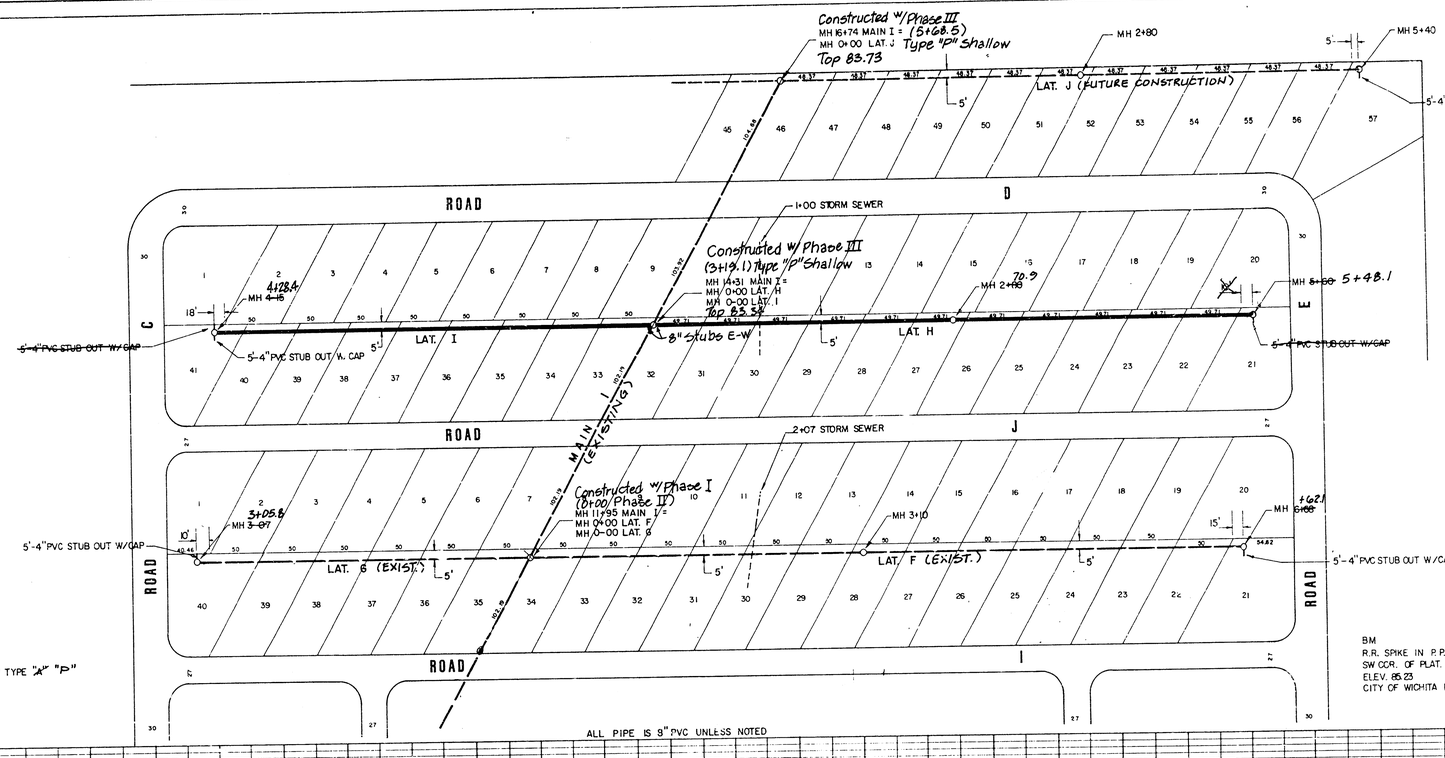

Revised as built 10-9-95 JCR
As-built notations from previous phases added 8-16-95 JCR (SRB)

REISS & GOODNESS ENGINEERS
2100 WEST 21ST STREET
WICHITA, KANSAS 67203
(316) 832-0213

REVISION	DRAWN BY	CHECKED BY	PROJECT	CUSTOMER	SCALE NOTED	PROJECT NO. MS 1205
					DATE 4/1/85	SHEET 8 OF 13

SANITARY SEWER EXTENSIONS LAT'S. F, G, H, I, J

LAMPLIGHTER MOBILE PARK

407 PPS (607861)