

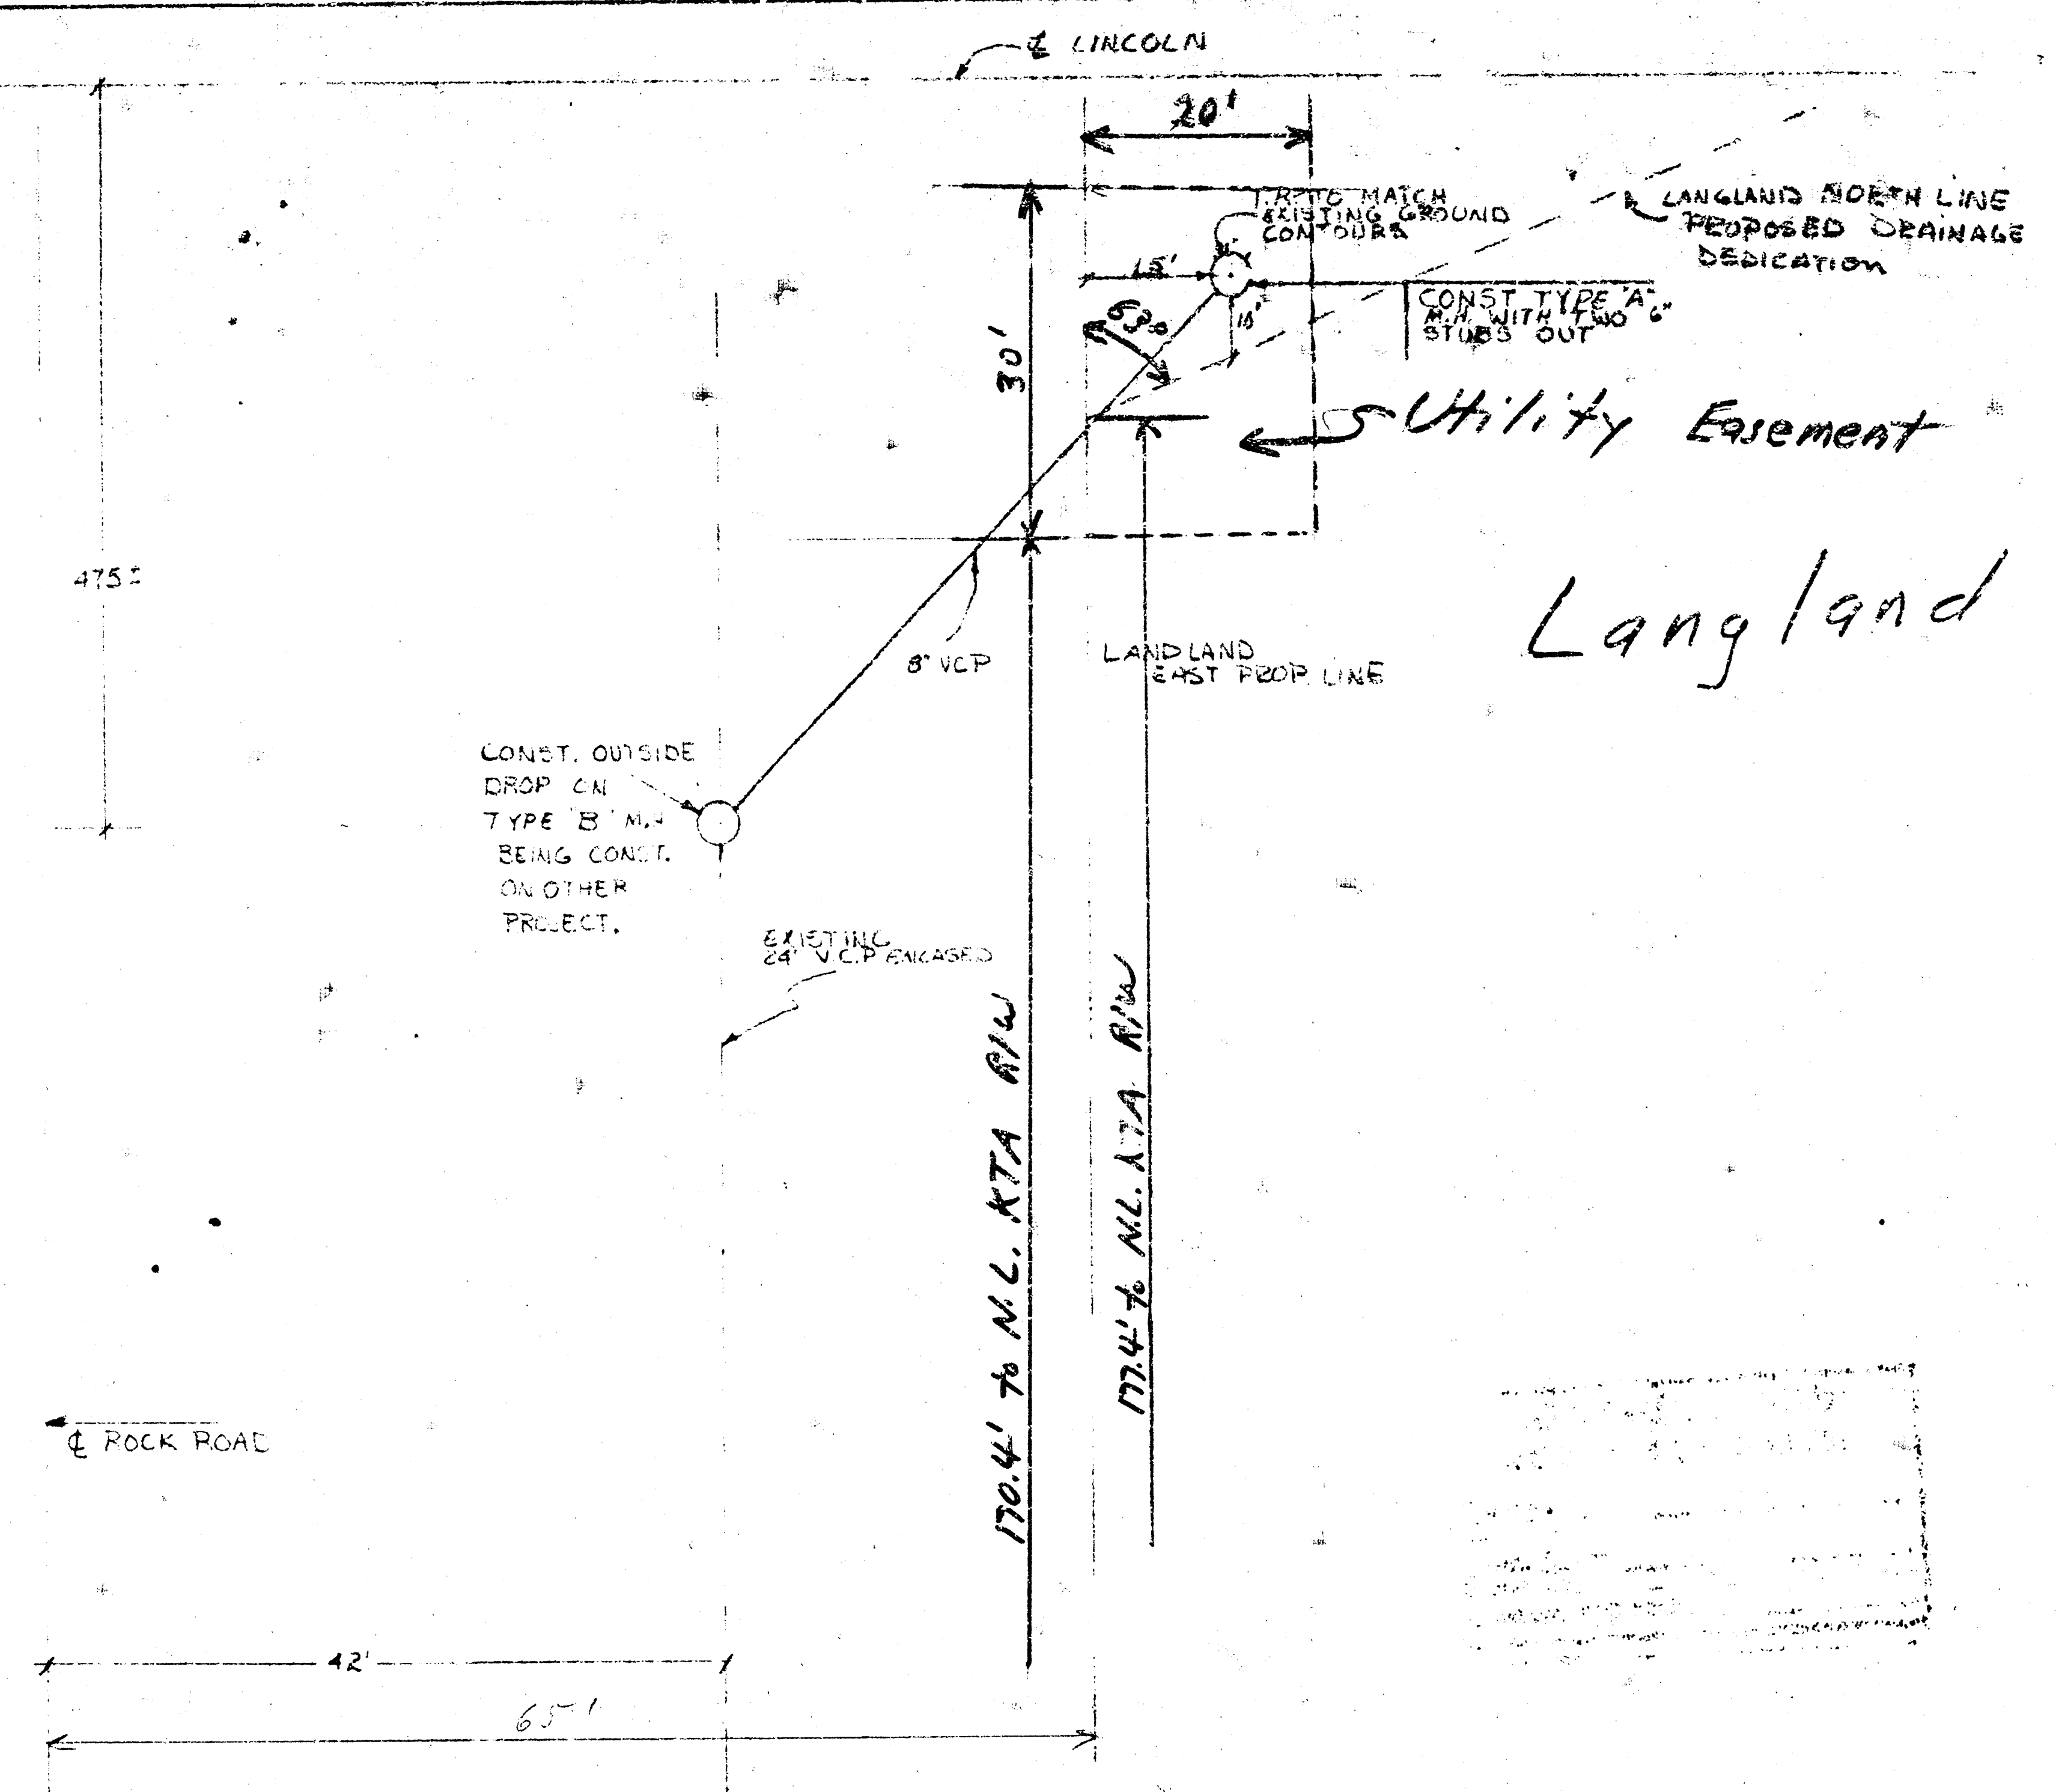


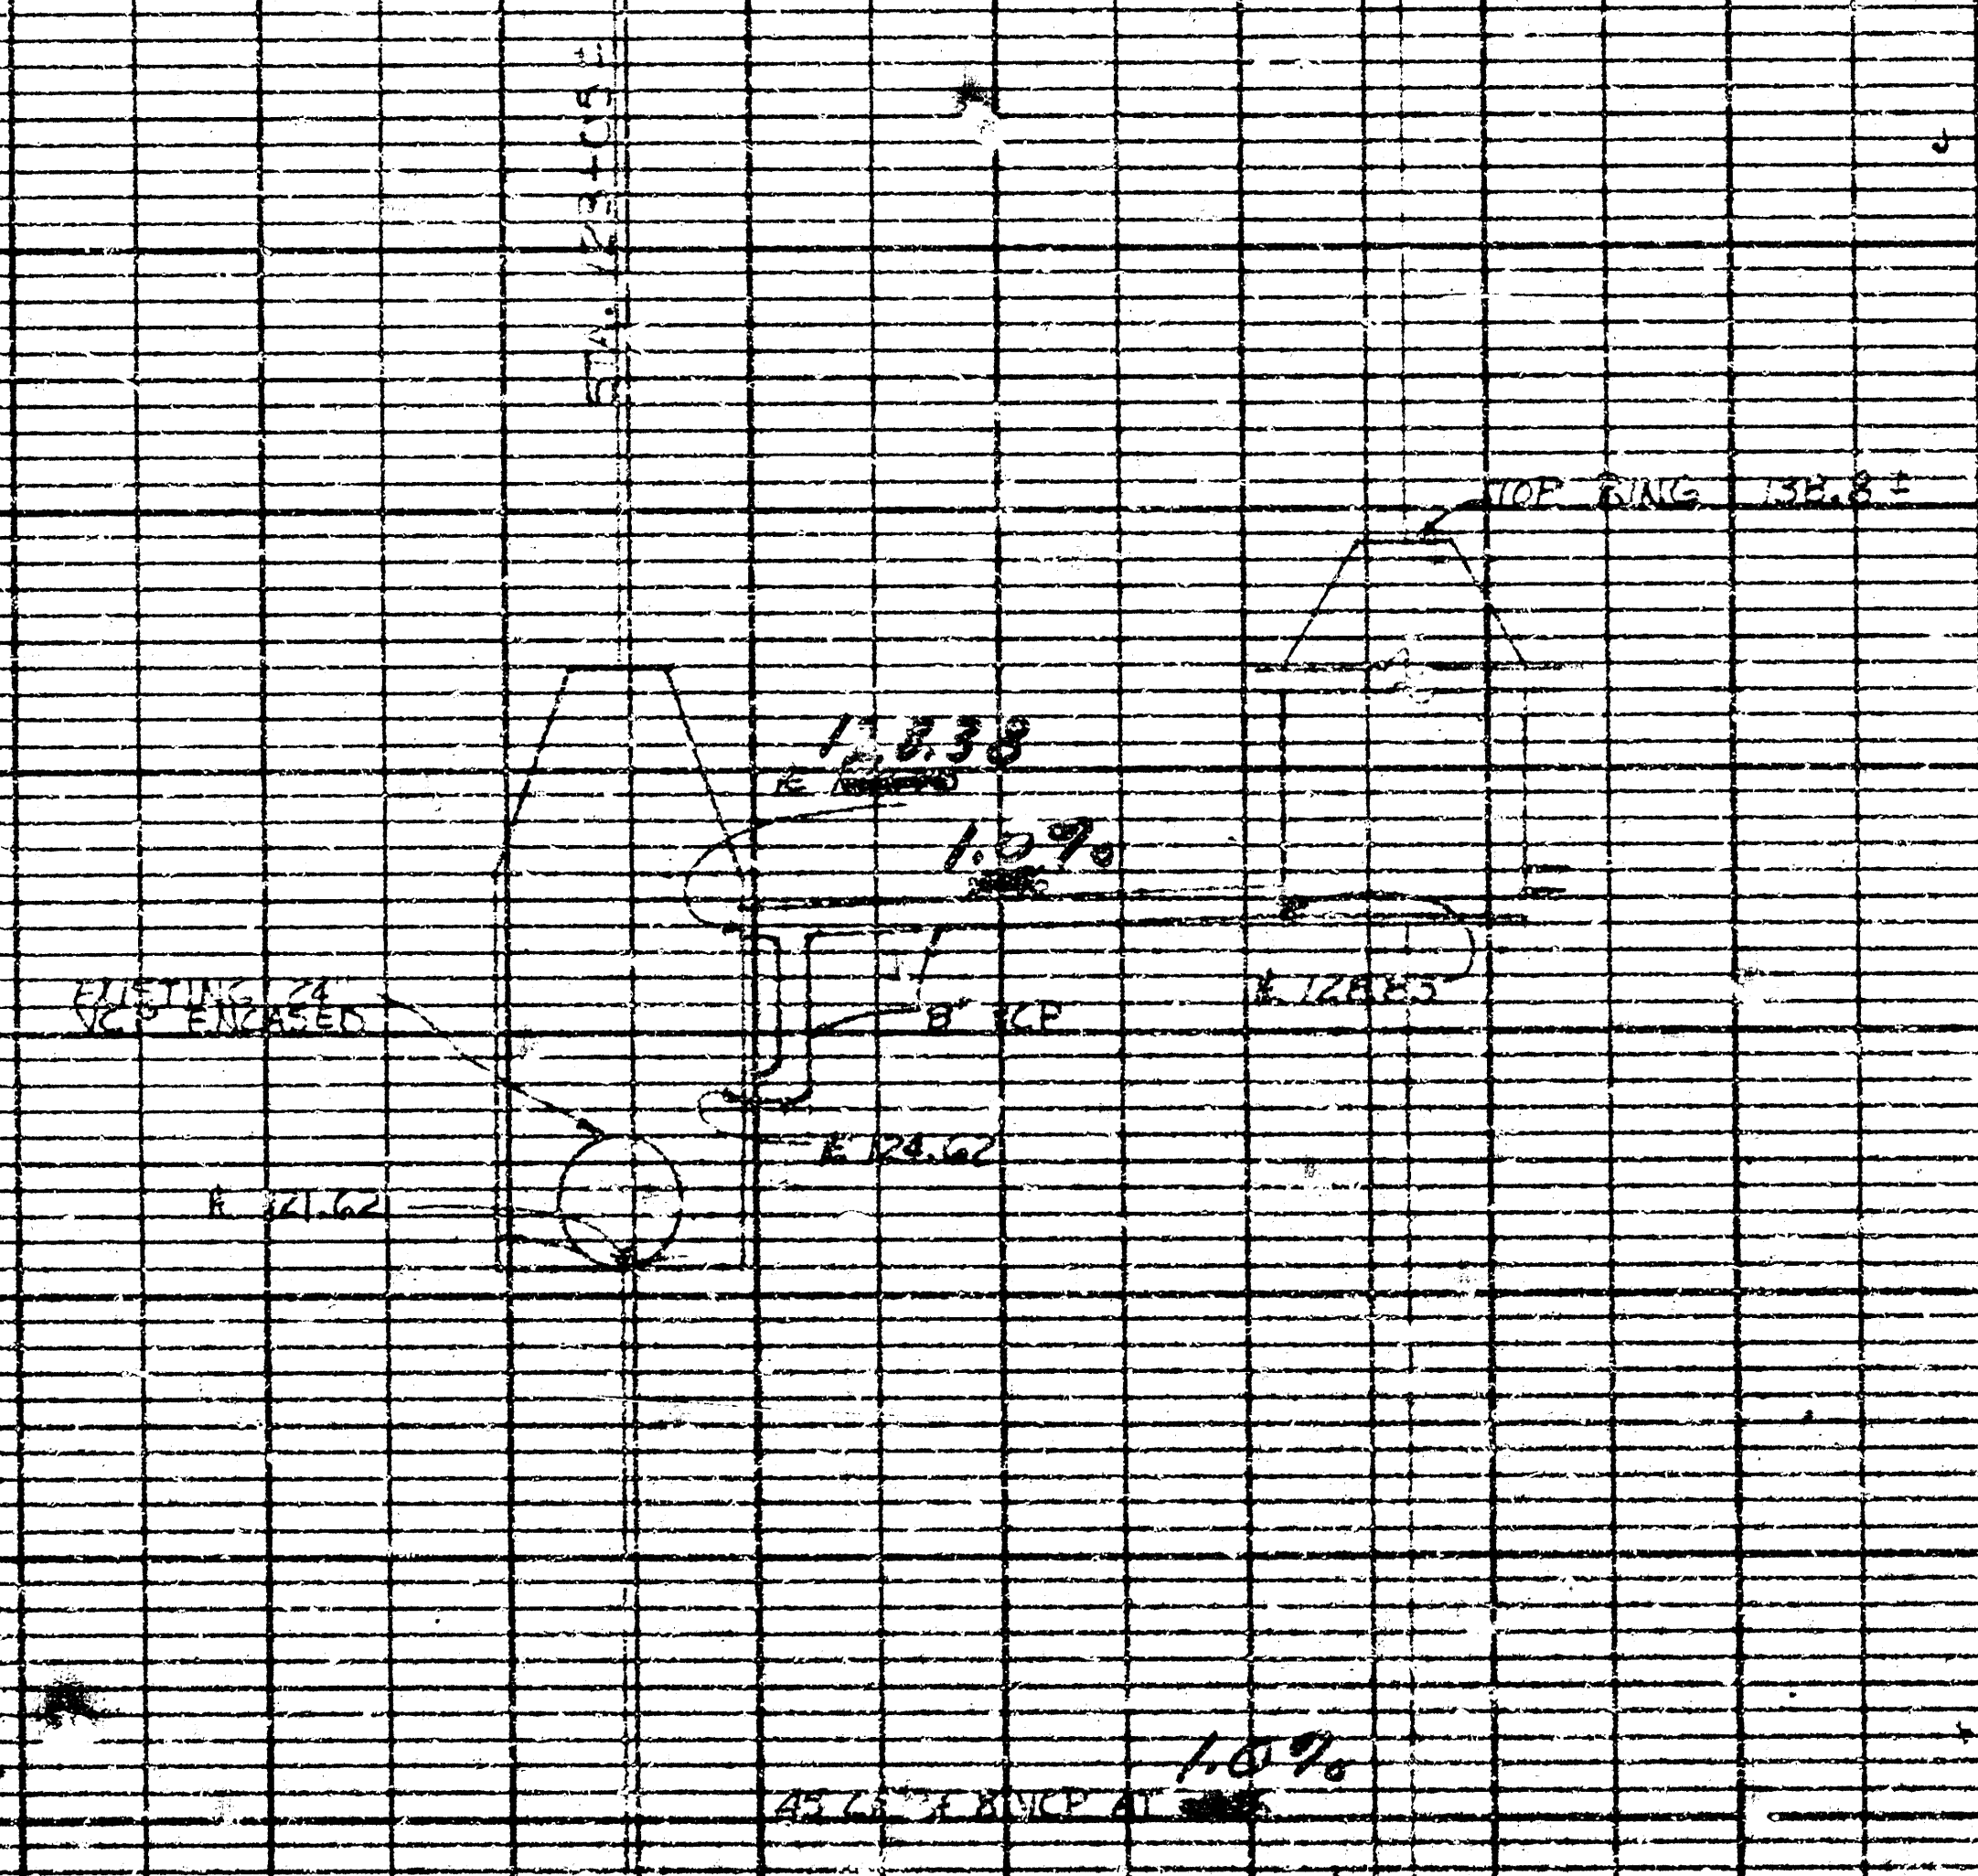

Langland Addn.

7-15-76
 APPROVED AS NOTED
 By CITY ENGINEER OF WICHITA
 Sanitary Sewers _____
 Storm Sewers D.E.S.
 Driveway Approaches _____

ENGINEER
 KAYE W. HARRIS
 KAYE W. HARRIS & ASSOCIATES

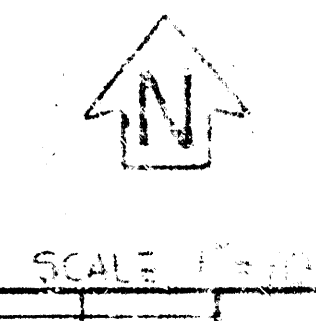

Langland Addn. San. Sewer
 CLOYD LANGLAND
 SANITARY SEWER
 UTILITY CONTRACTORS
 0751
 1/16/76
 PROJ. NO. DSKN 006043