


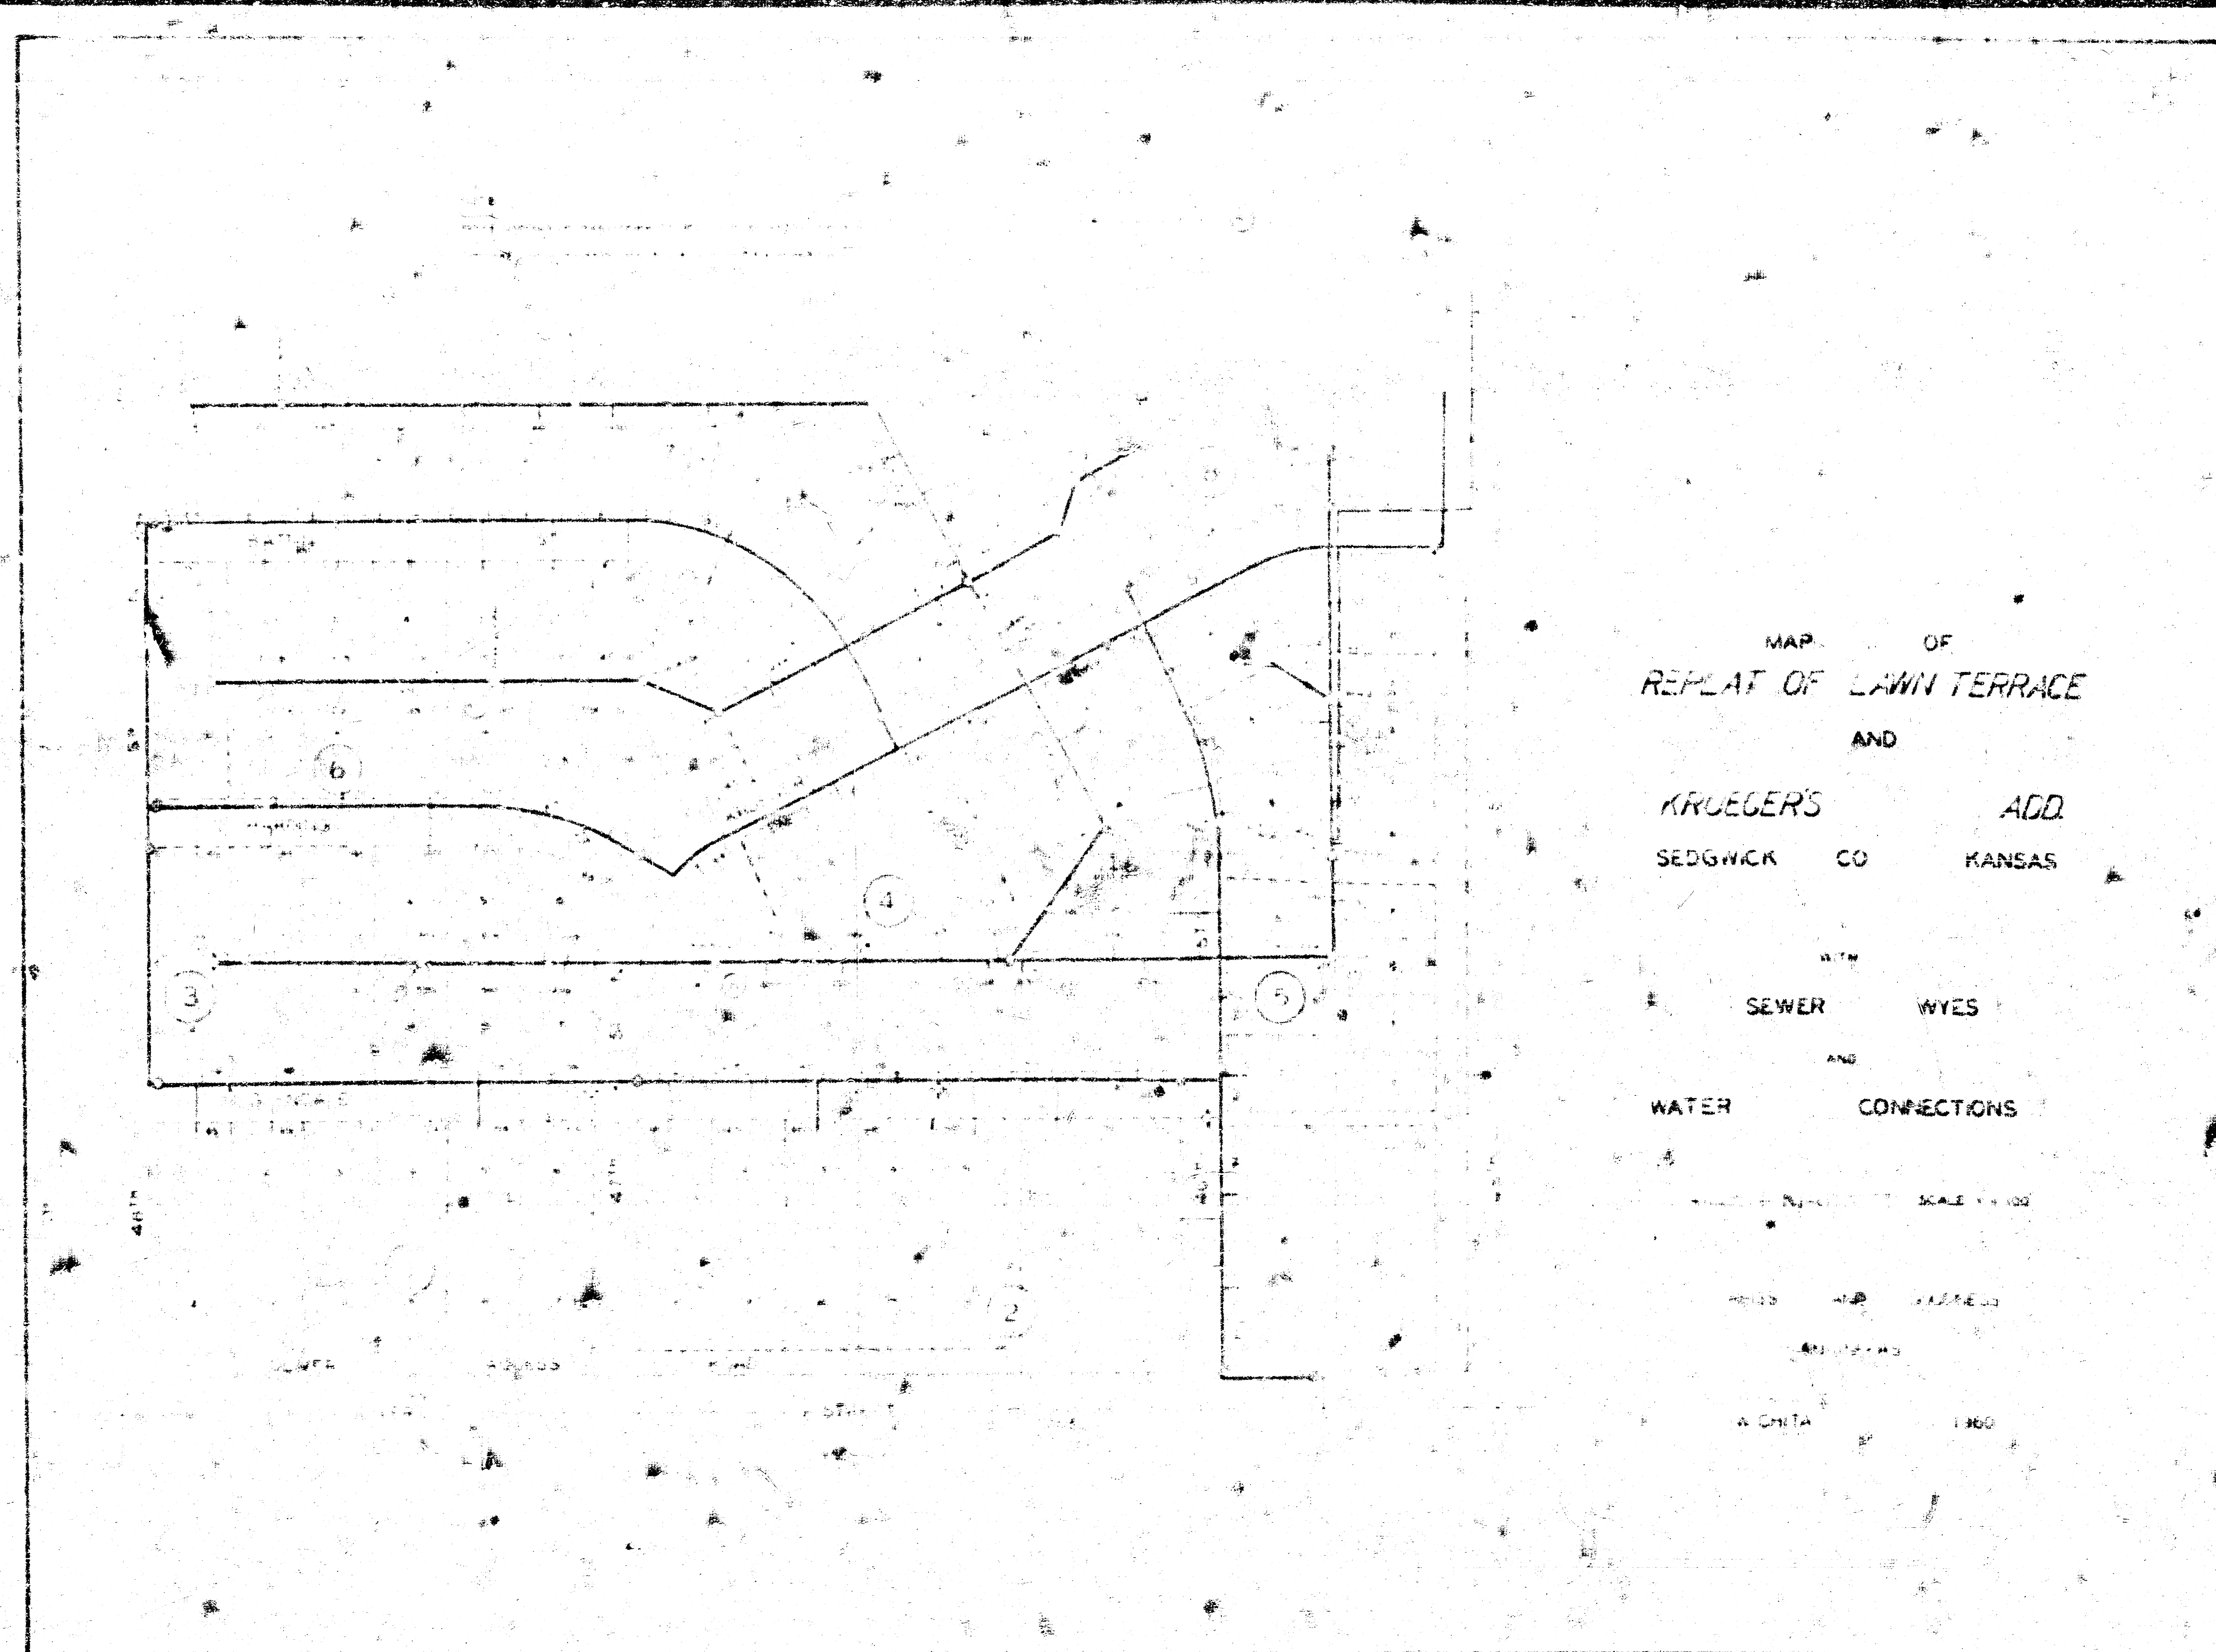

MAP OF
REPLAT OF LAWN TERRACE
AND
KRUEGER'S ADD.
SEDGWICK CO KANSAS

WITH
SEWER WYES
AND
WATER CONNECTIONS


SCALE 1/4" = 100'



W. CHITA


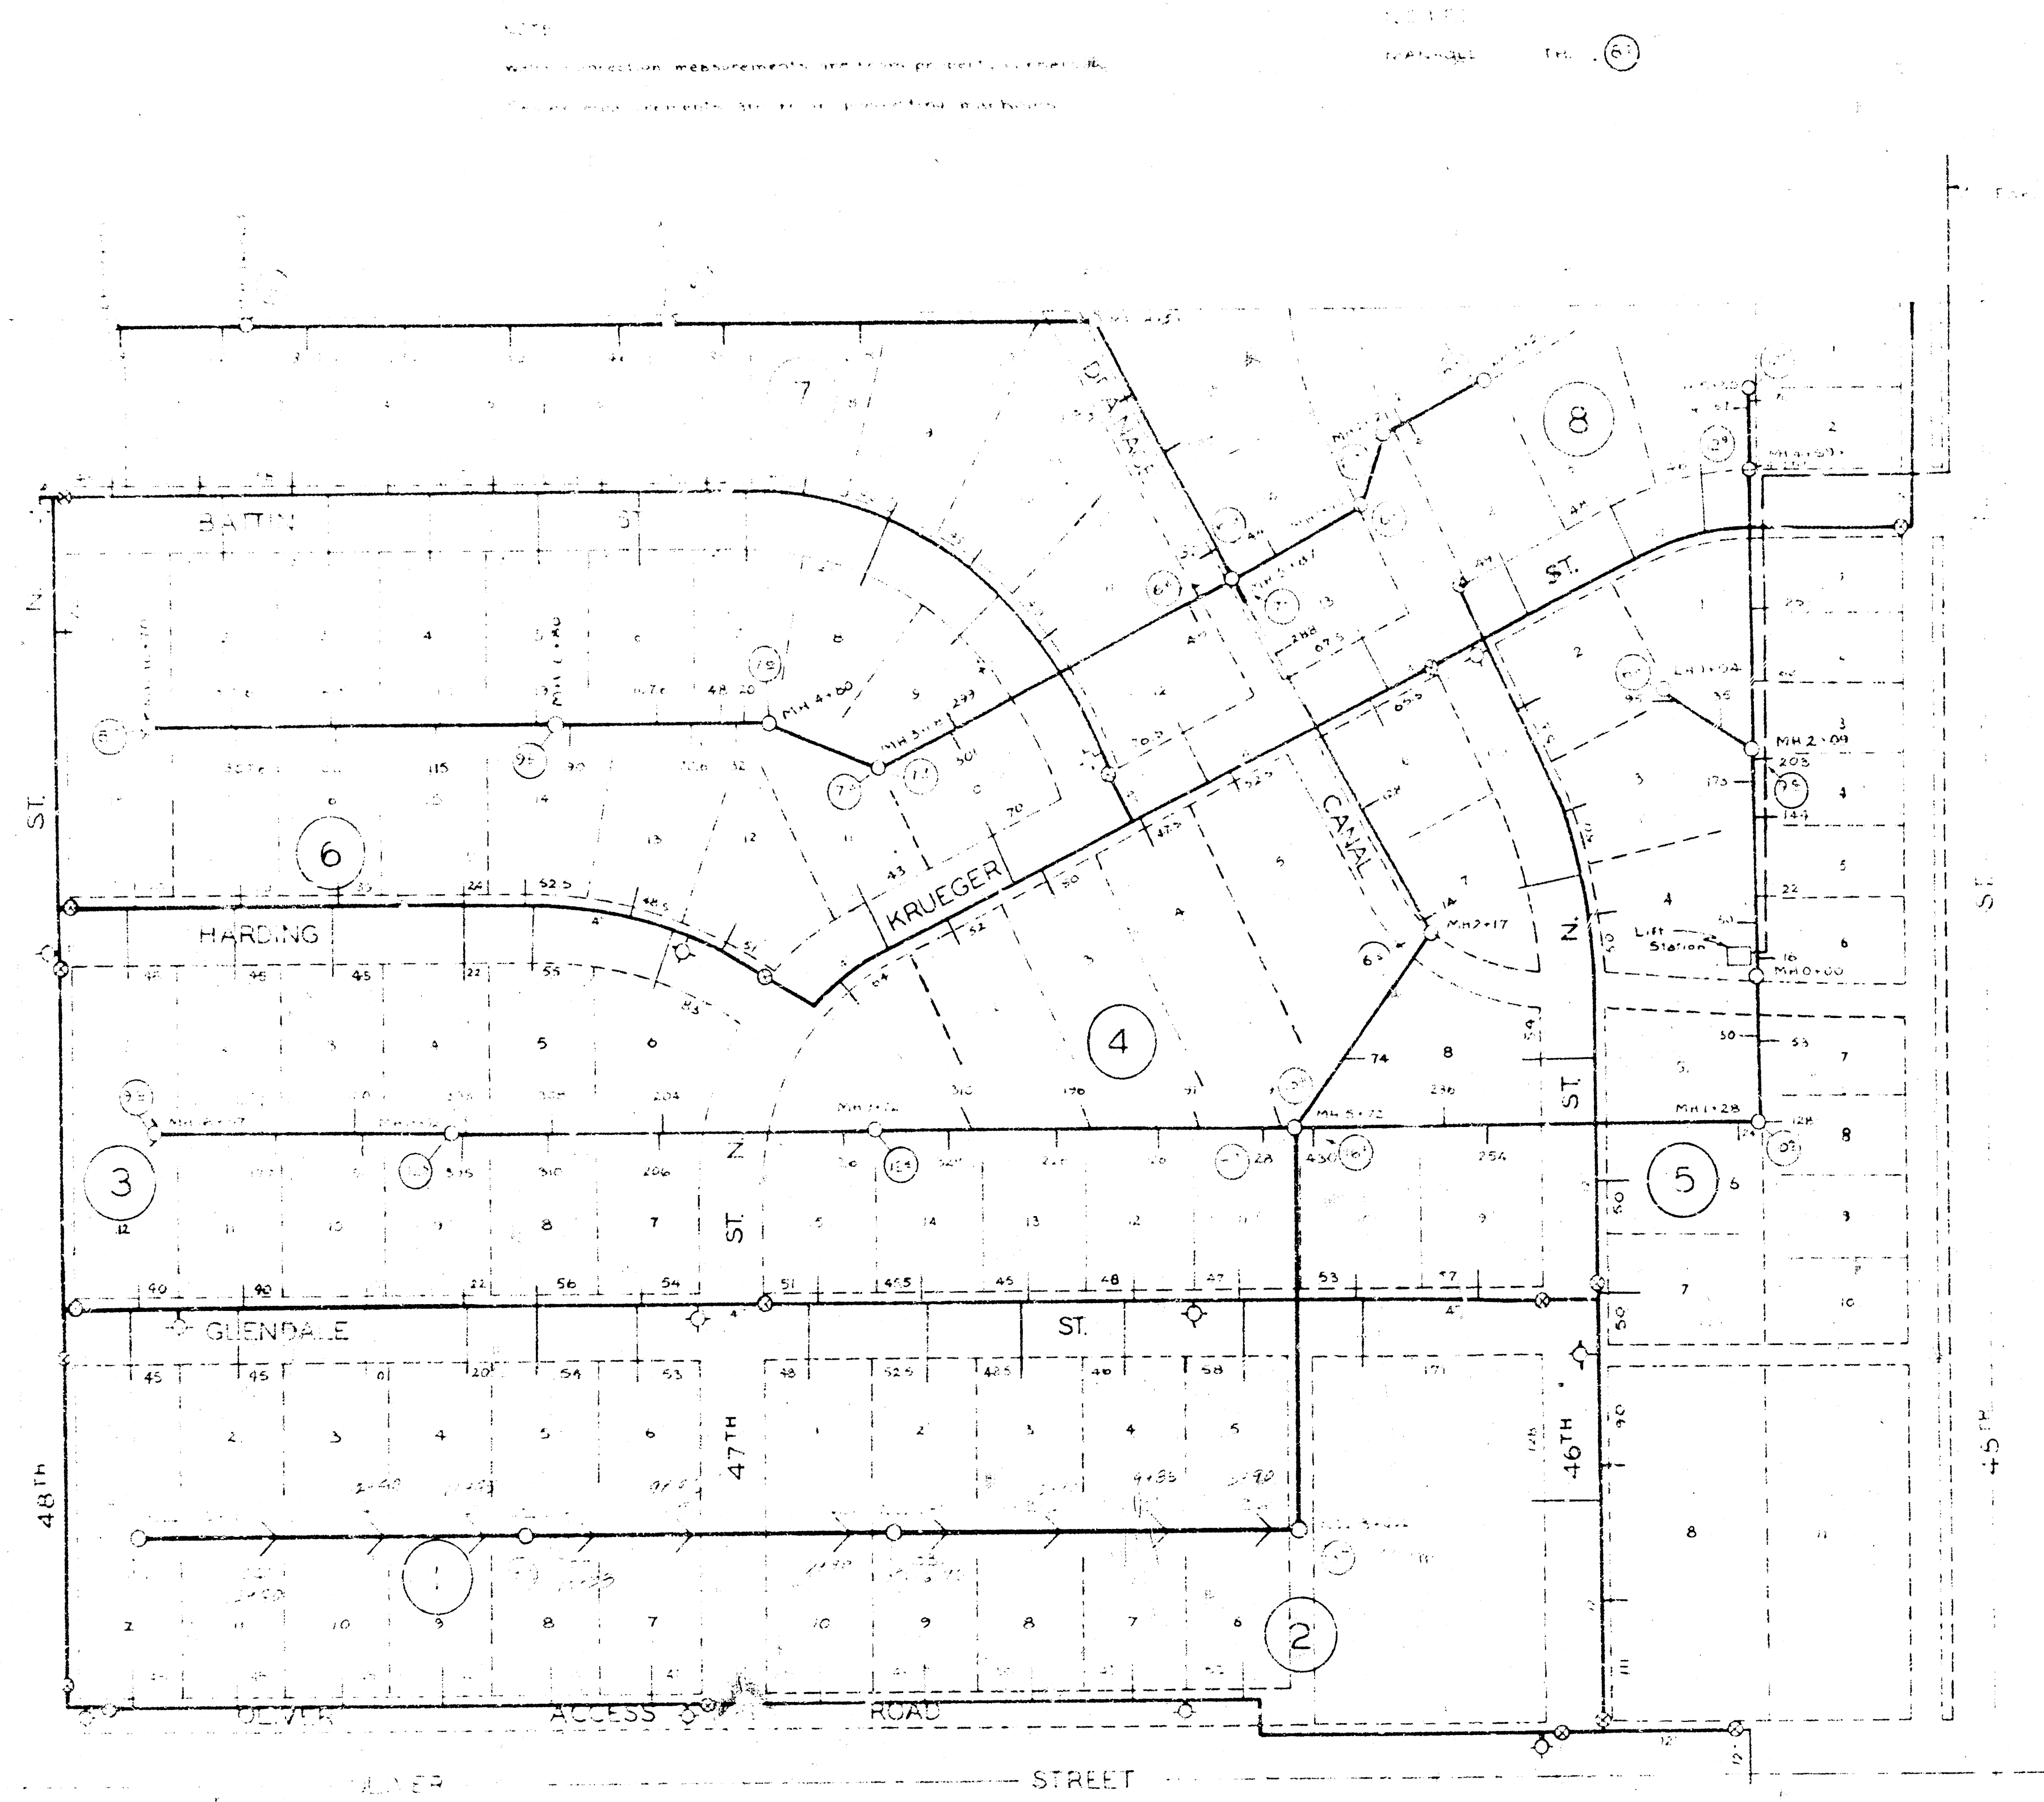

MAP OF
 REPLAT OF LAWN TERRACE
 AND
 KRUEGER'S ADD.
 SEDGWICK CO. KANSAS

WITH
 SEWER WYES
 AND
 WATER CONNECTIONS

SCALE 1" = 100'

REISS AND GOODNESS
 ENGINEERS

WICHITA 1960

