
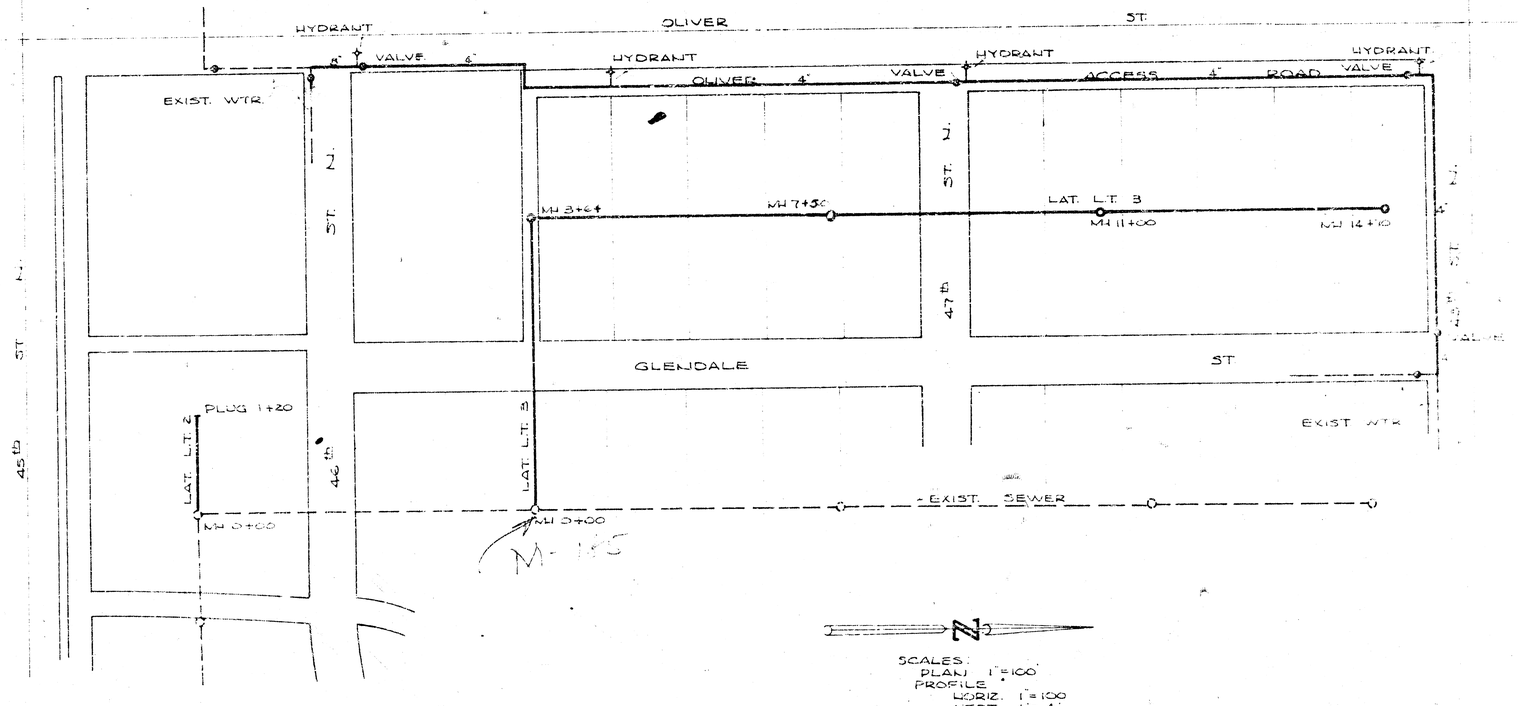


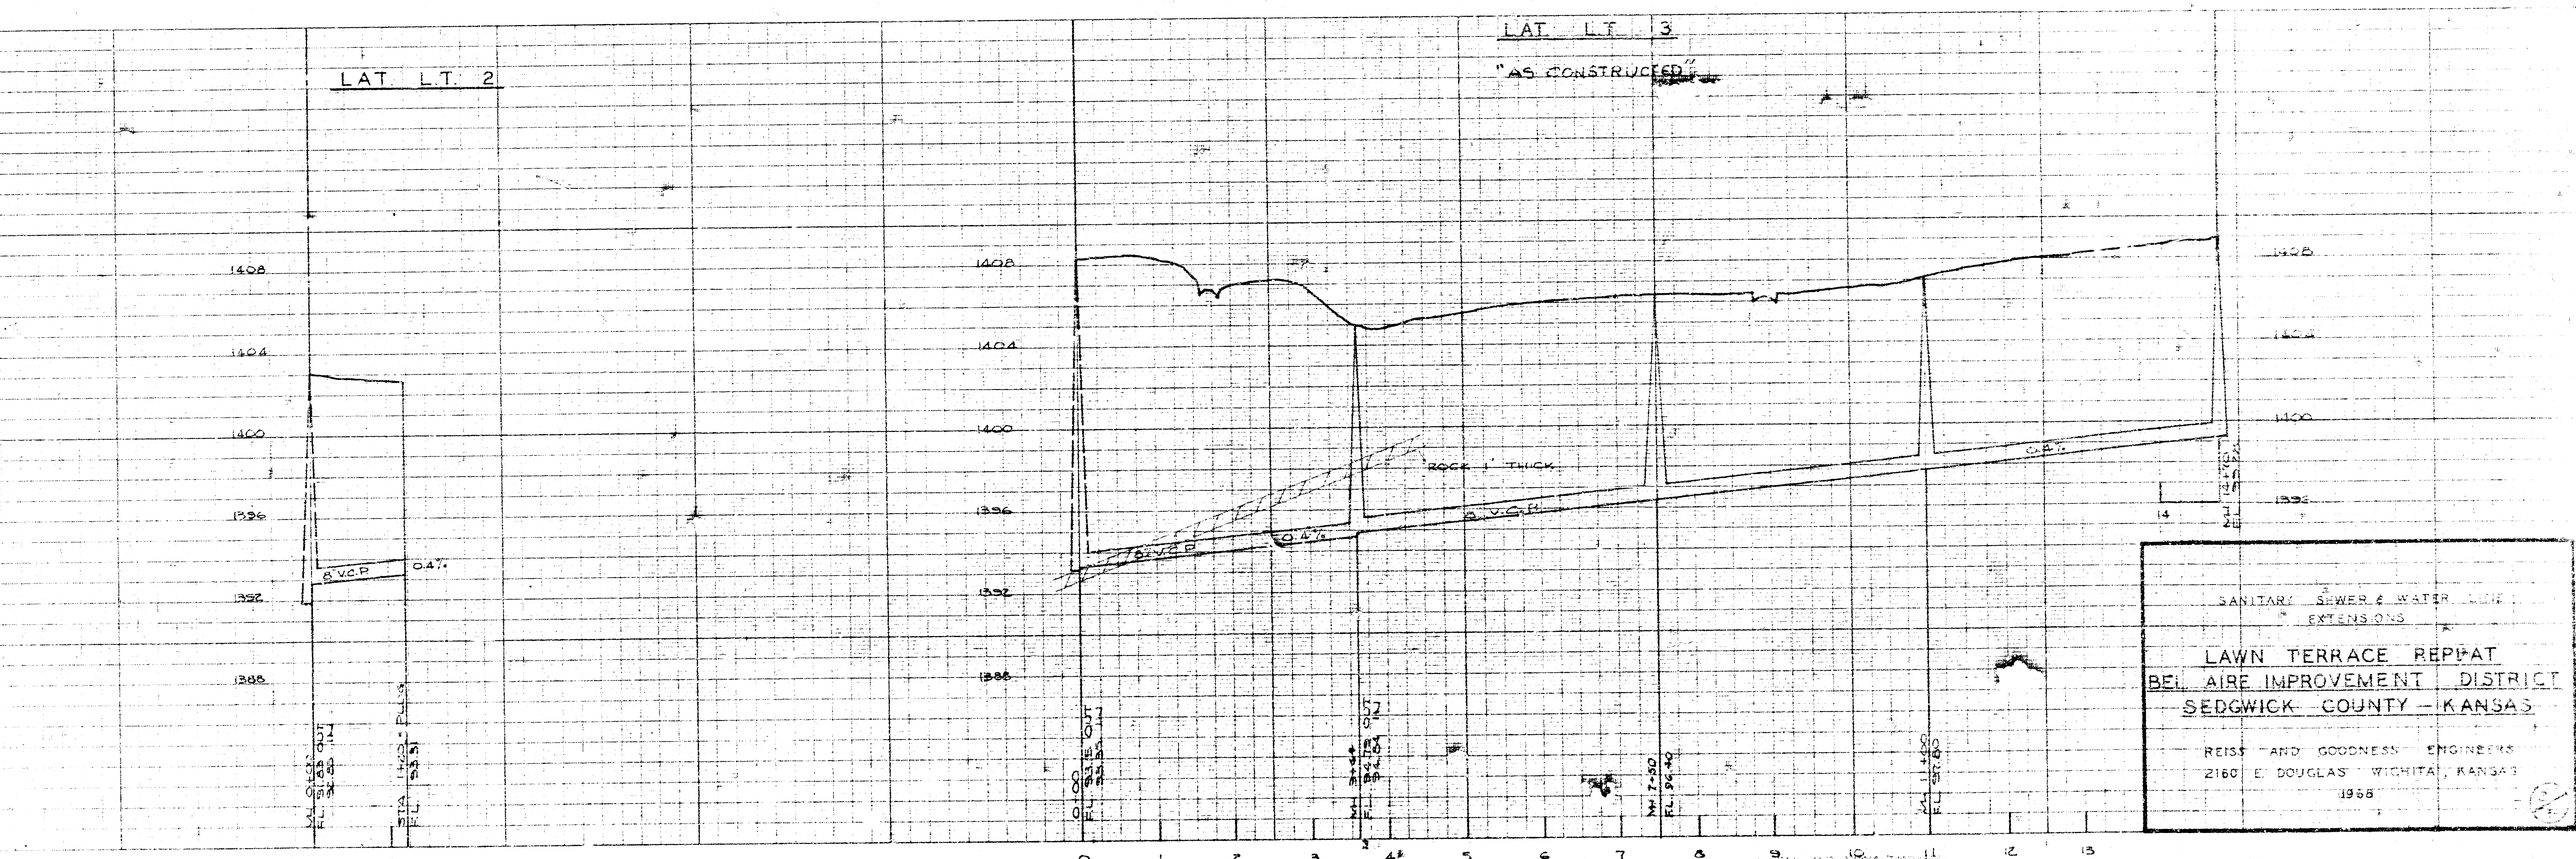

SANITARY SEWER & WATER LINE EXTENSIONS

LAWN TERRACE REPPAT

BEL AIRE IMPROVEMENT DISTRICT

SEDGWICK COUNTY — KANSAS

REISS AND GOODNESS ENGINEERS

2160 E. DOUGLAS WICHITA, KANSAS

1968


PLAT OF LAND IN PRAT

MPHILIPS ADD

PARENS

NOTE:
Water connection measurements are from property corners.
Sewer measurements are from preceding manholes.

NOTE:
MANHOLE DEPTH (5')

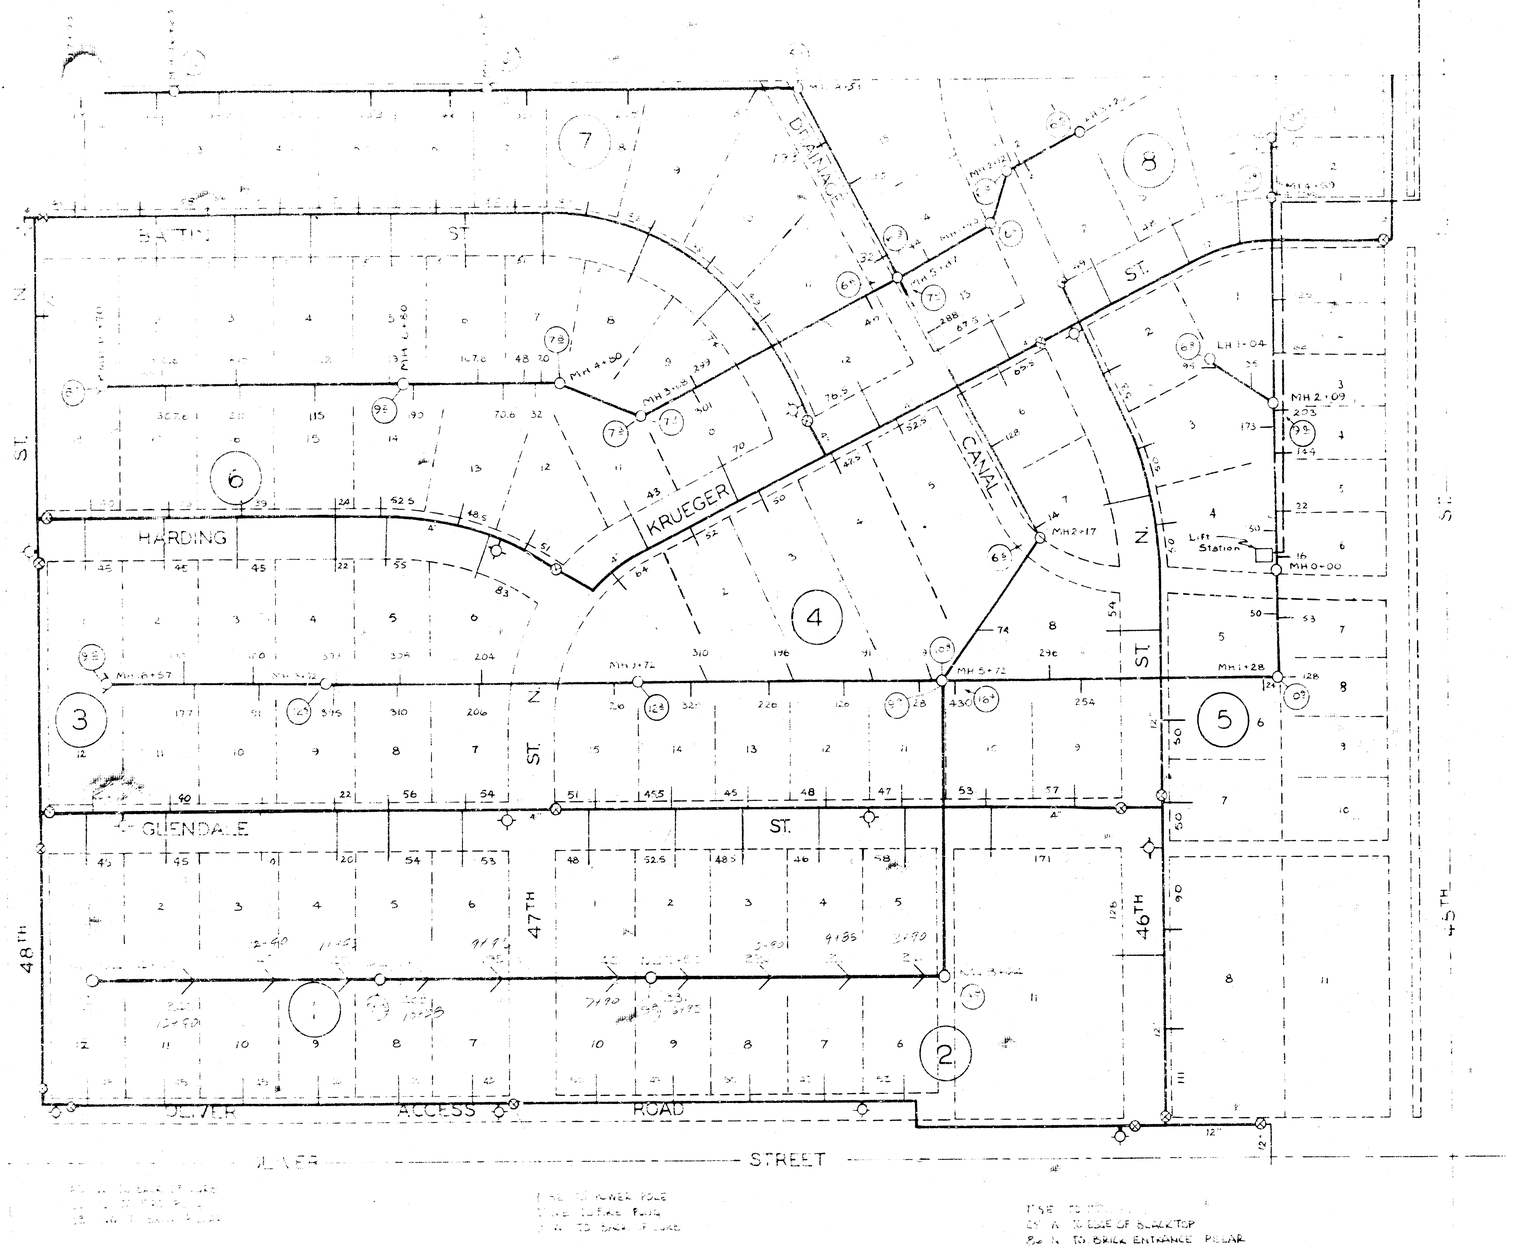

MAP OF
REPLAT OF LAWN TERRACE
AND
KRUEGER'S ADD.
SEDGWICK CO. KANSAS

WITH
SEWER WYES
AND
WATER CONNECTIONS

N SCALE 1" = 100'

REISS AND GOODNESS
ENGINEERS
WICHITA 1960