



SCALES:
 PLAN 1"=100'
 PROFILE 1"=100'
 HORIZ. 1"=100'
 VERT. 1"=4'

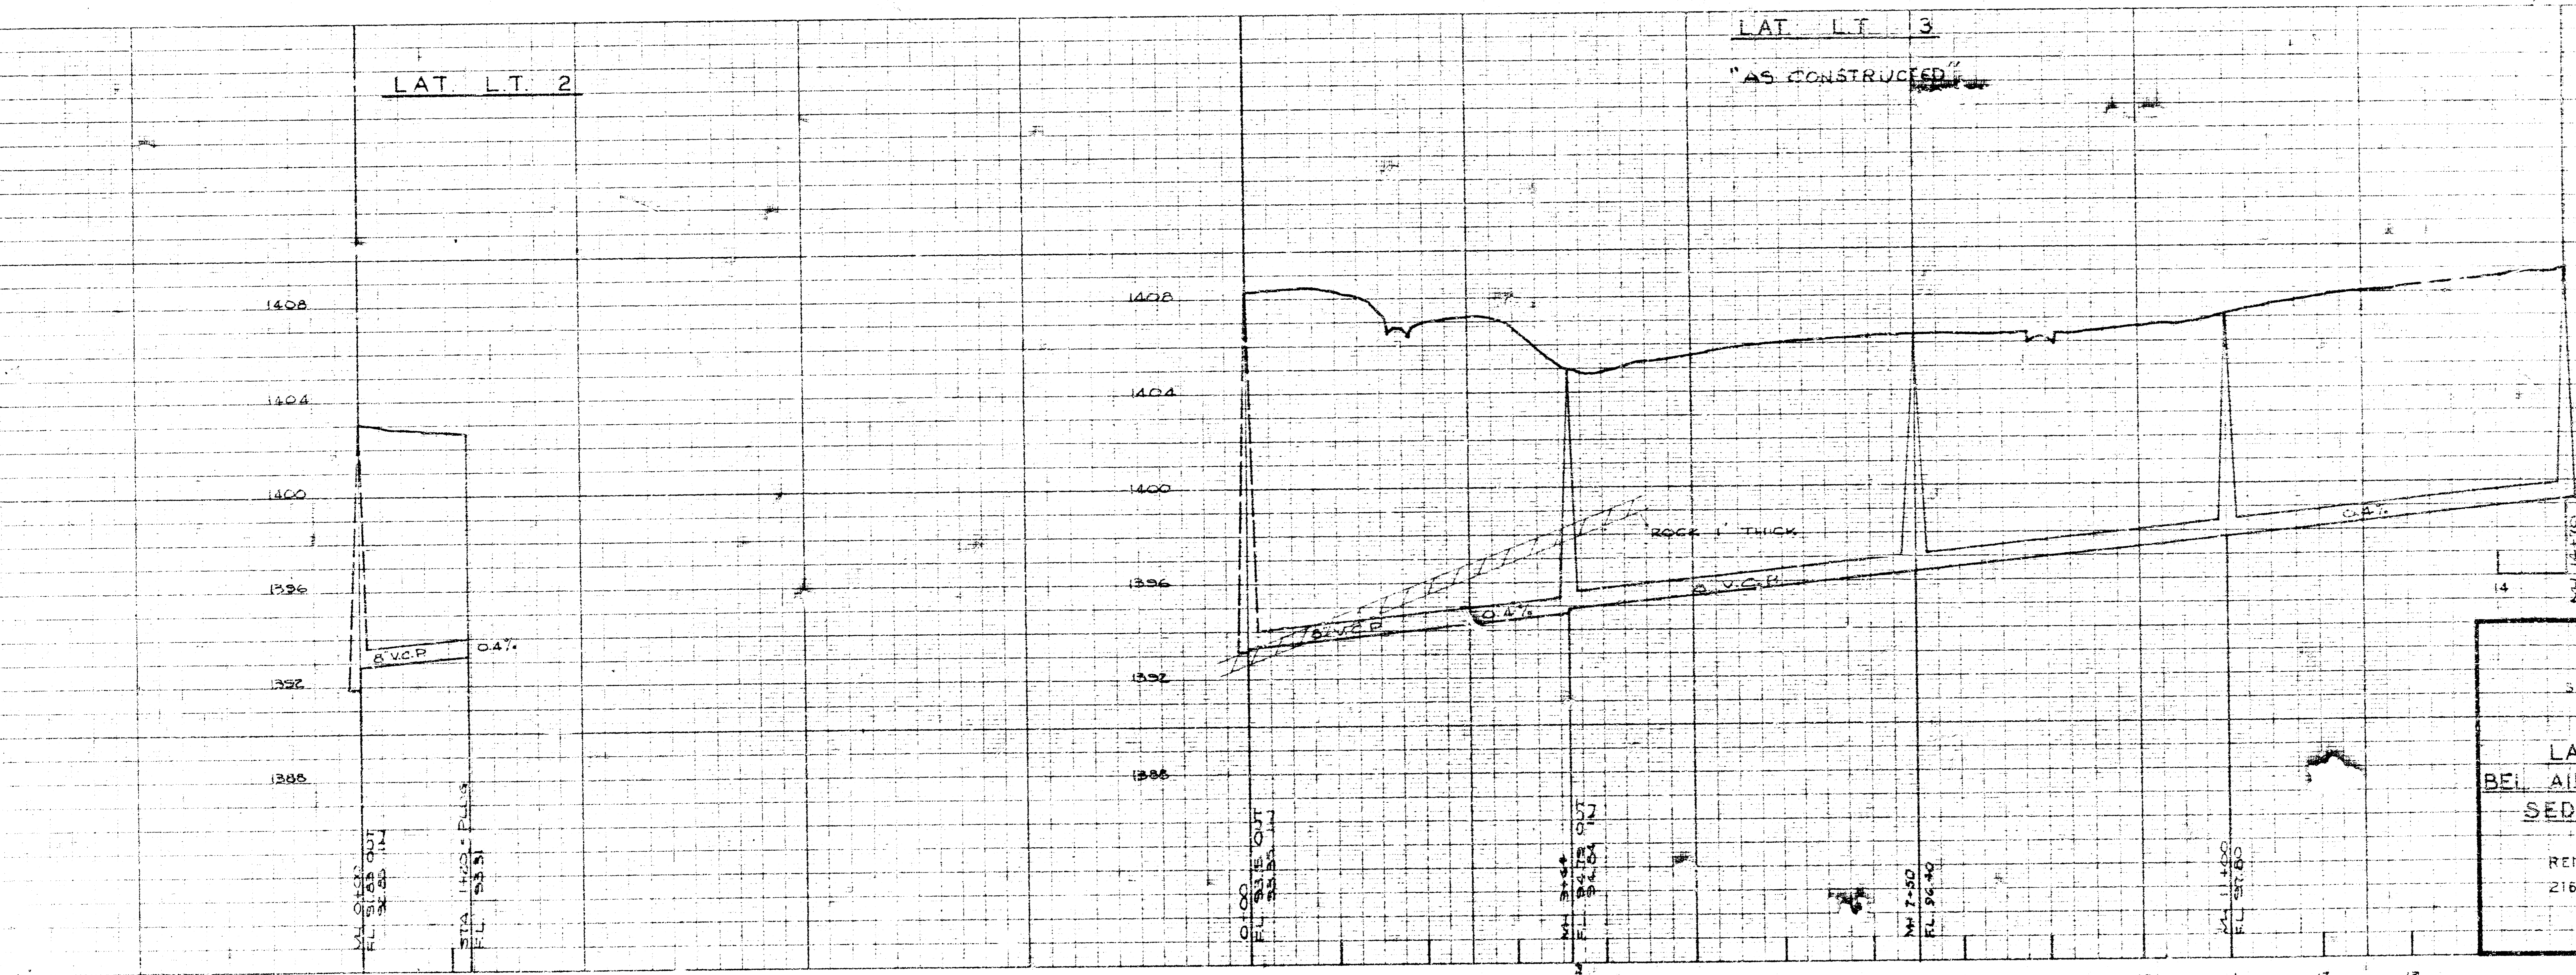

SANITARY SEWER & WATER LINE
 EXTENSIONS

LAWN TERRACE REPEAT
 BEL AIRE IMPROVEMENT DISTRICT
 SEDGWICK COUNTY - KANSAS

REISS AND GOODNESS ENGINEERS
 2160 E. DOUGLAS WICHITA, KANSAS
 1966

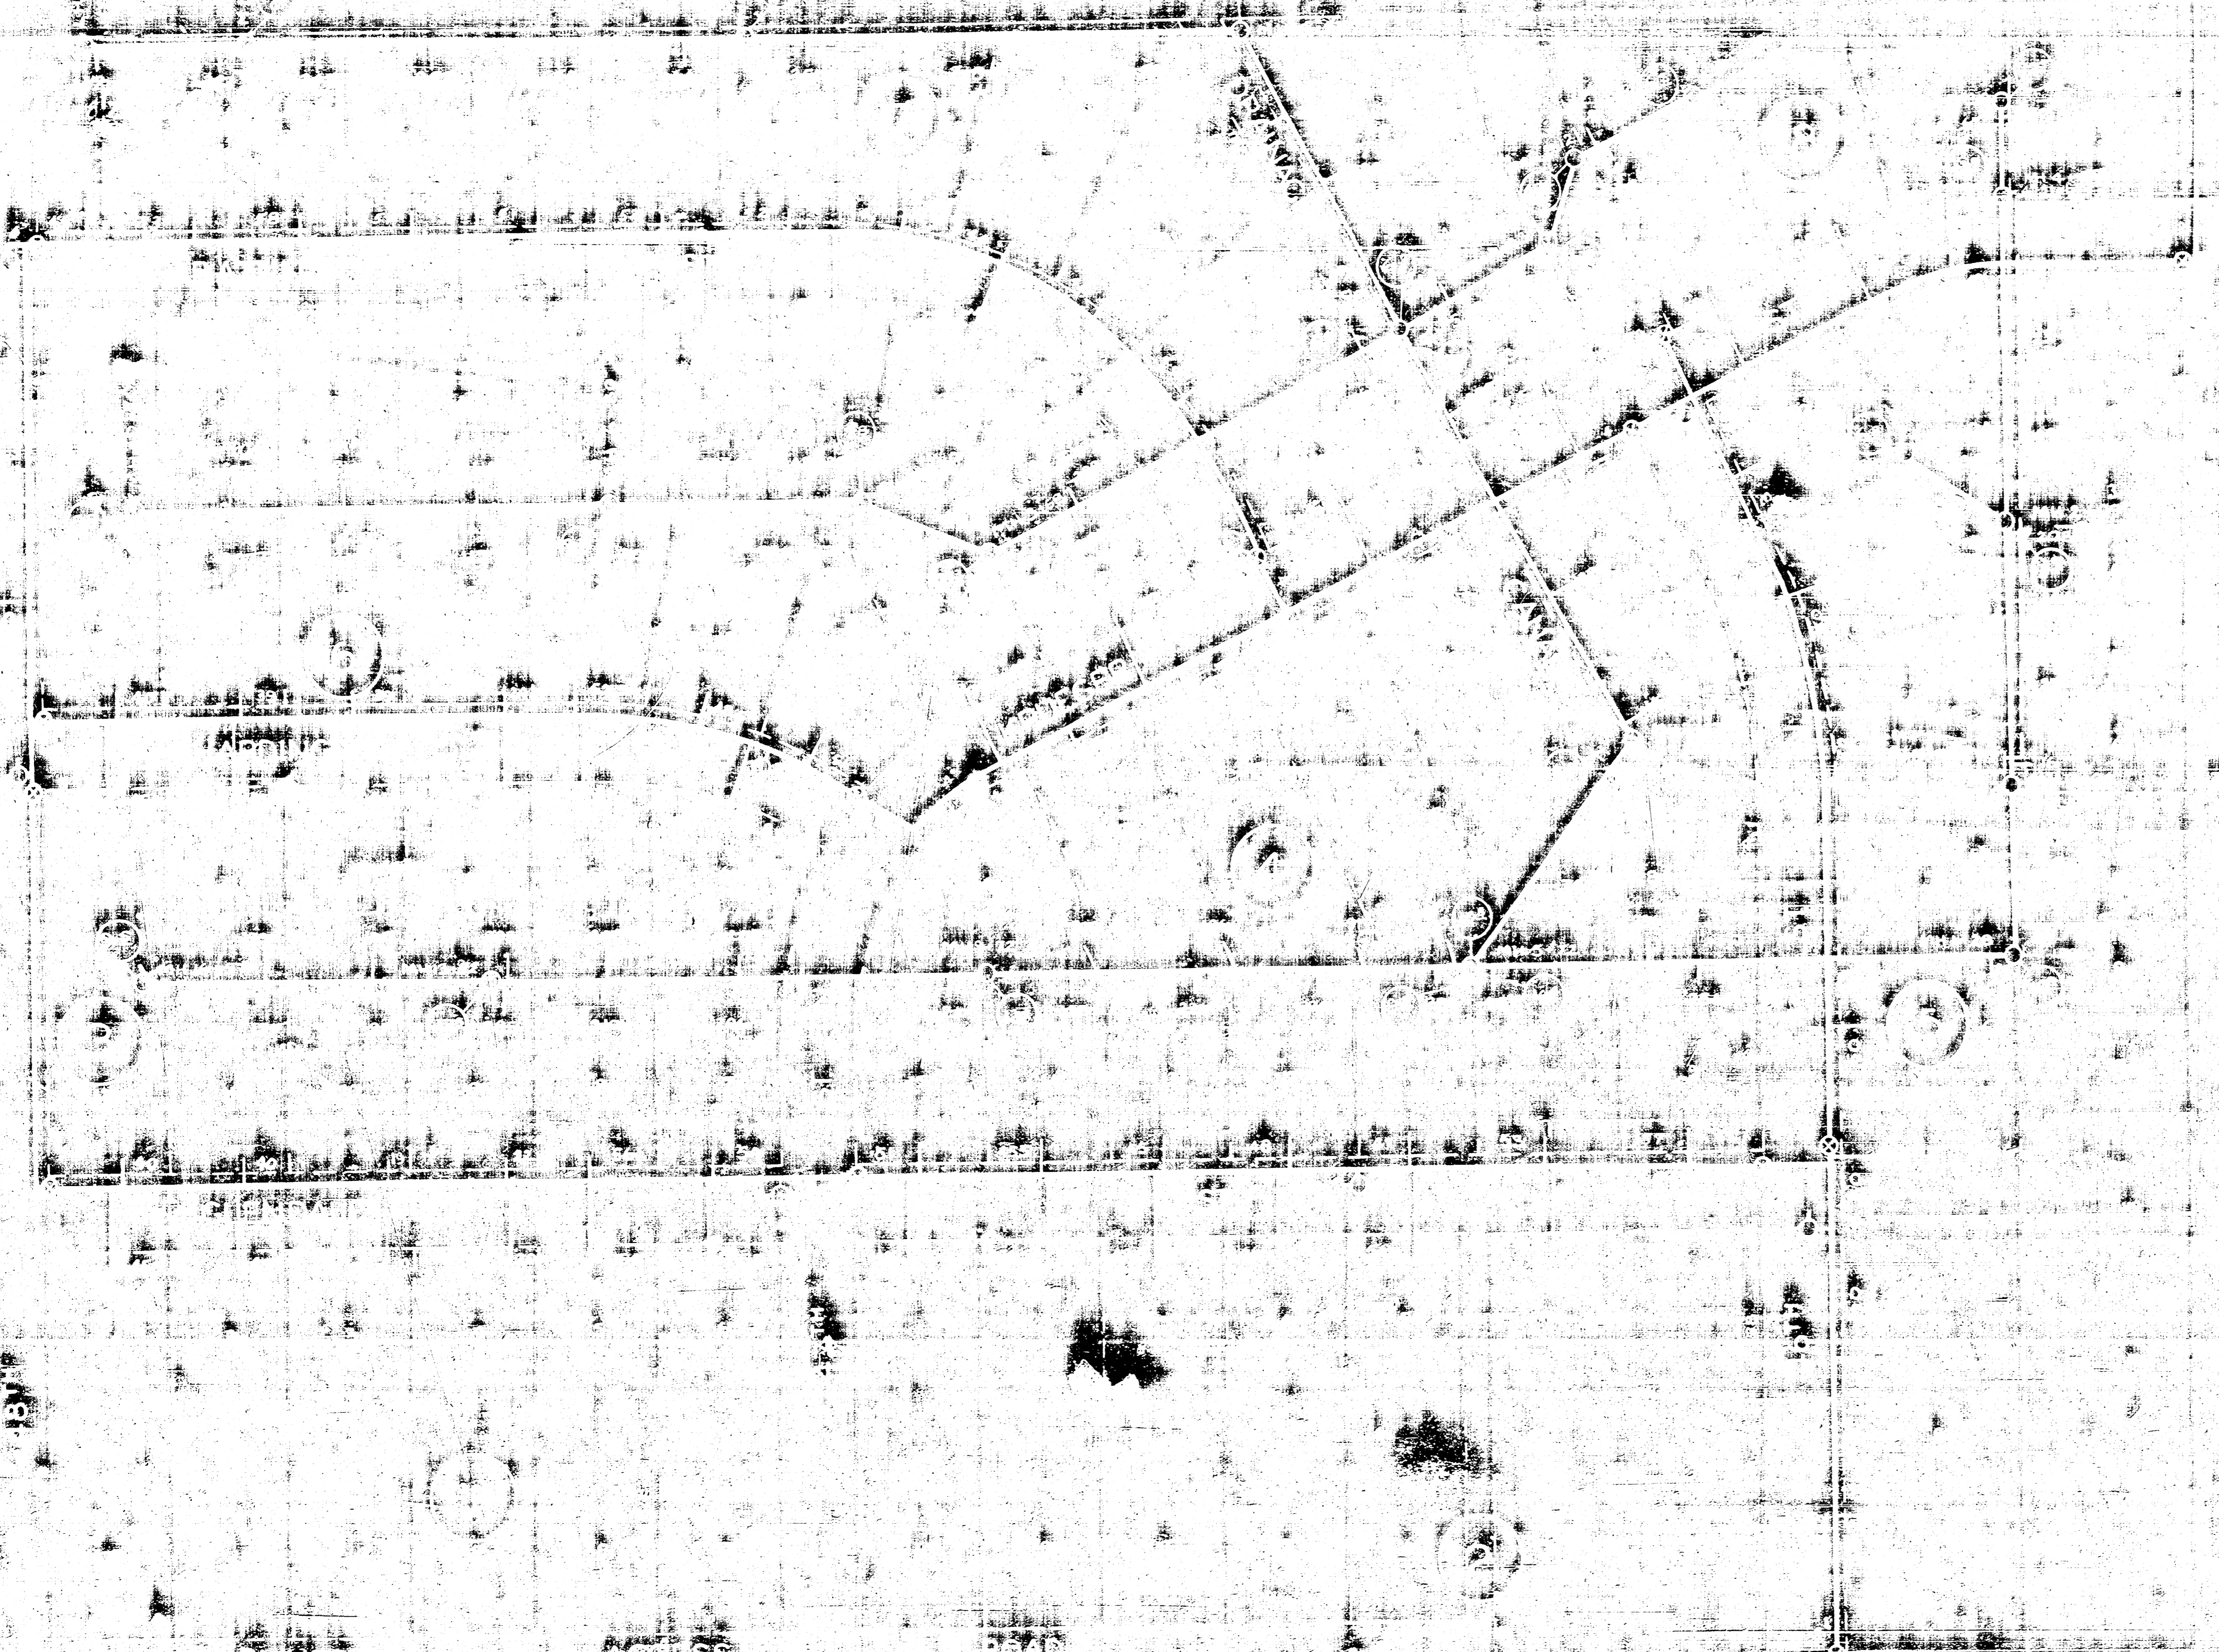

POINT OF LAMP TITRAC








NOTE:
 Water connection measurements are from property corners.
 Sewer measurements are from preceding manholes.

DATE: 11-11-60
 DRAWN BY: BERTH (5)

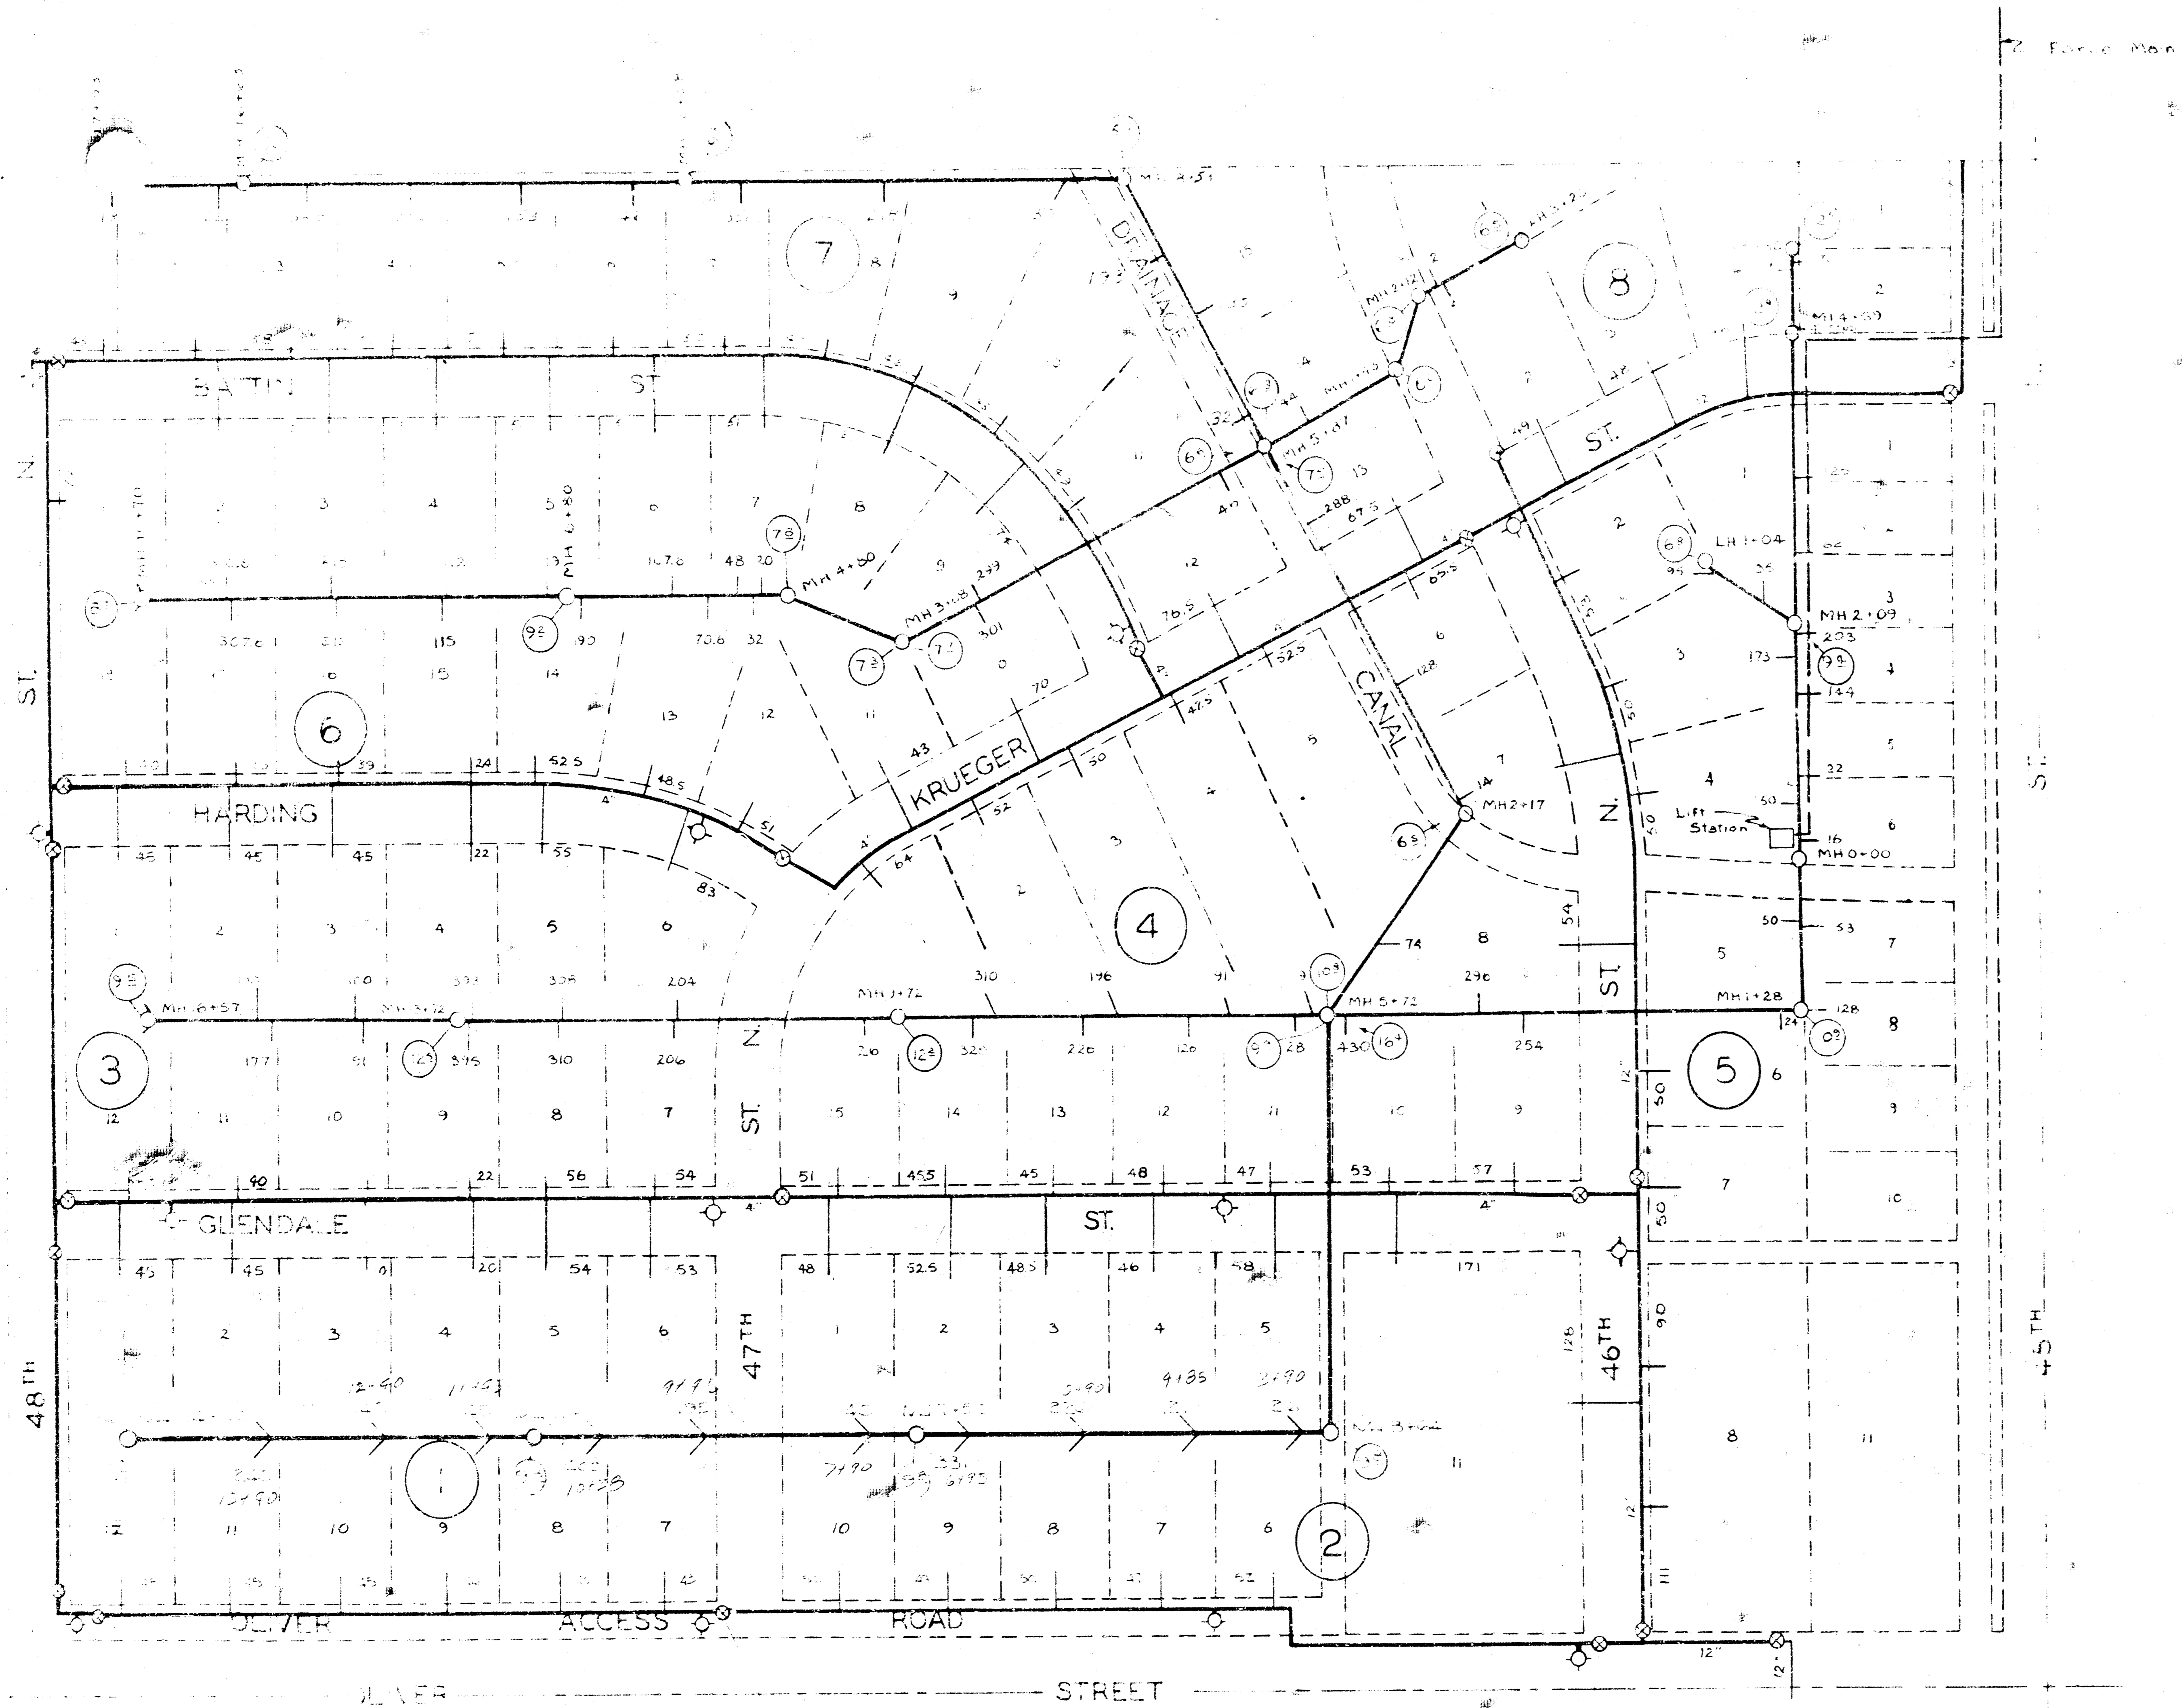

MAP OF
 REPLAT OF LAWN TERRACE
 AND
 KRUEGER'S ADD.
 SEDGWICK CO. KANSAS
 WITH
 SEWER WYES
 AND
 WATER CONNECTIONS

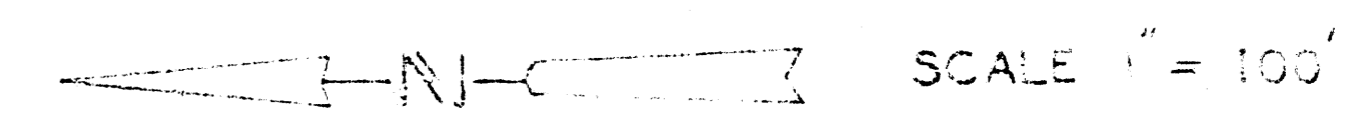

REISS AND GOODNESS
 ENGINEERS

WICHITA 1960




