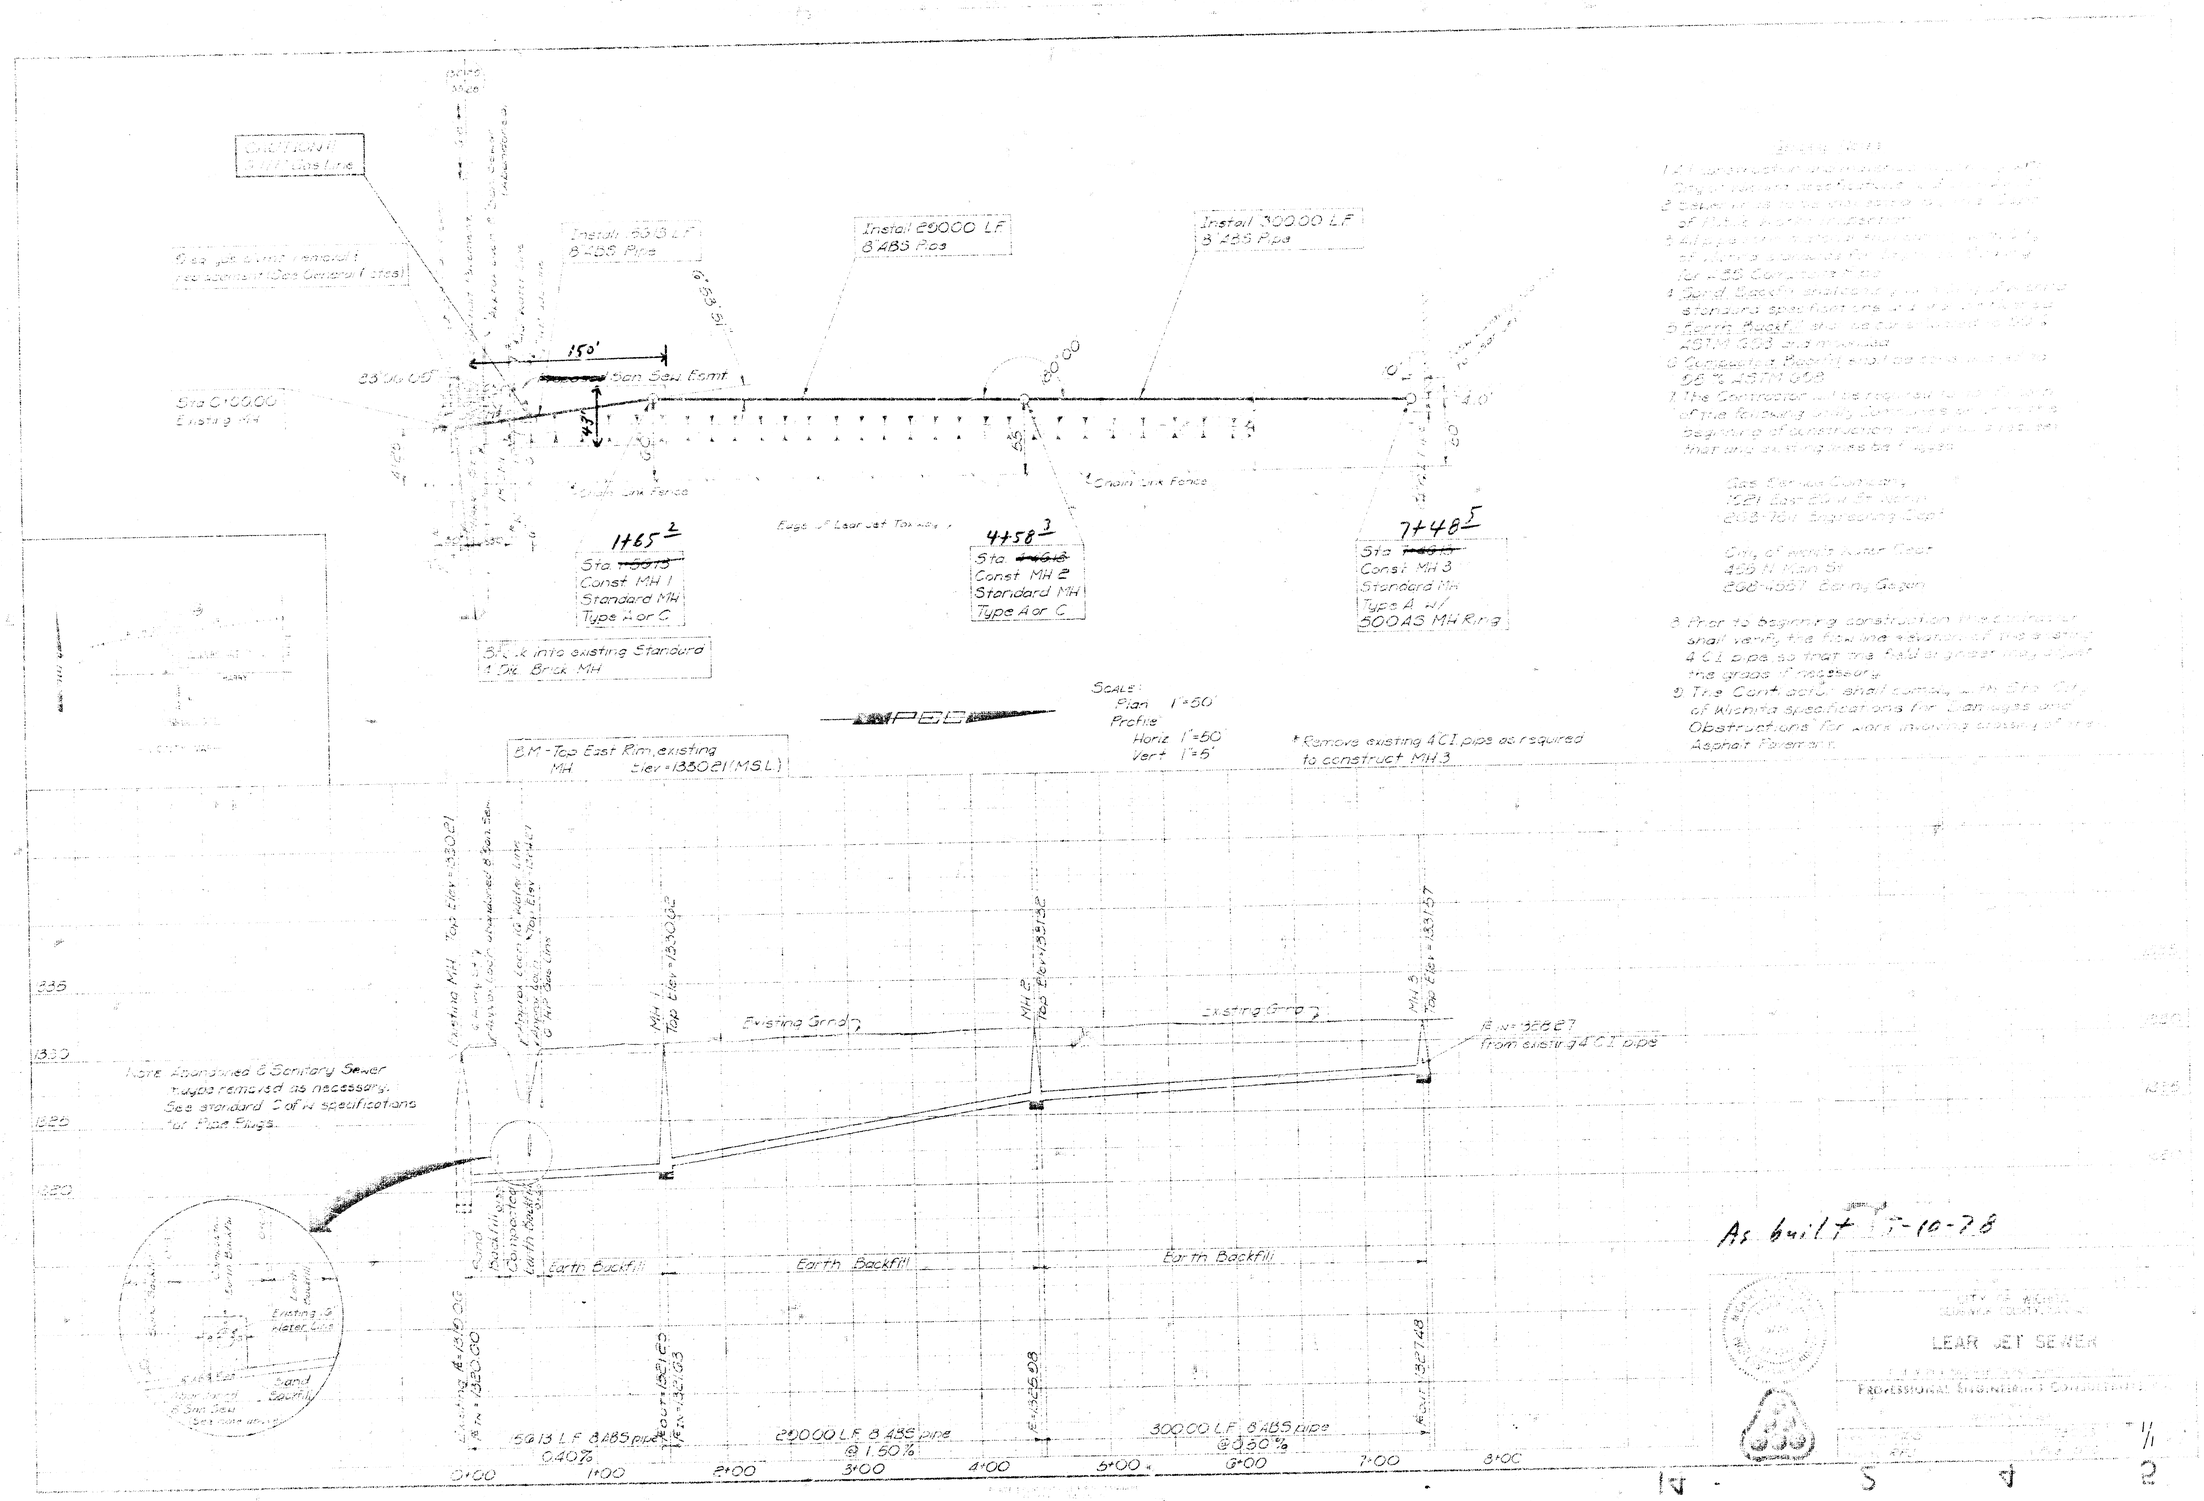
Install 66.8 L.F. 8" ABS Pipe
Install 200.00 L.F. 8" ABS Pipe
Install 300.00 L.F. 8" ABS Pipe
150'
Sta 0+00.00 Existing MH
Chain Link Fence
Edge of Lear Jet Taxiway
1+65
Sta
Const MH 1
Standard MH
Type A or C
4+58
Const MH 2
Standard MH
Type A or C
7+48
Const MH 3
Standard MH
Type A w/
500 AS MH Ring
Brick into existing Standard 1 Dia. Brick MH
Scale:
Plan 1"=50'
Profile
Horiz 1"=50'
Vert 1"=5'
* Remove existing 4" CI pipe as required to construct MH 3
BM - Top East Rim, existing MH Elev = 1330.21 (MSL)
Existing MH Top Elev = 1330.21
MH 1 Top Elev = 1330.02
MH 2 Top Elev = 1331.02
MH 3 Top Elev = 1331.57
Existing Grade
Note: Abandoned 6" Sanitary Sewer trugs removed as necessary. See standard 2 of 4 specifications for Plug Plugs.
Earth Backfill
Sand Backfill
Compacted Earth Backfill
Existing 6" Water Line
56.13 L.F. 8" ABS pipe @ 0.40%
200.00 L.F. 8" ABS pipe @ 1.50%
300.00 L.F. 8" ABS pipe @ 0.50%
0+00
1+00
2+00
3+00
4+00
5+00
6+00
7+00
8+00
As built 7-10-78
LEAR JET SEWER
PROFESSIONAL ENGINEERS CONSULTANTS