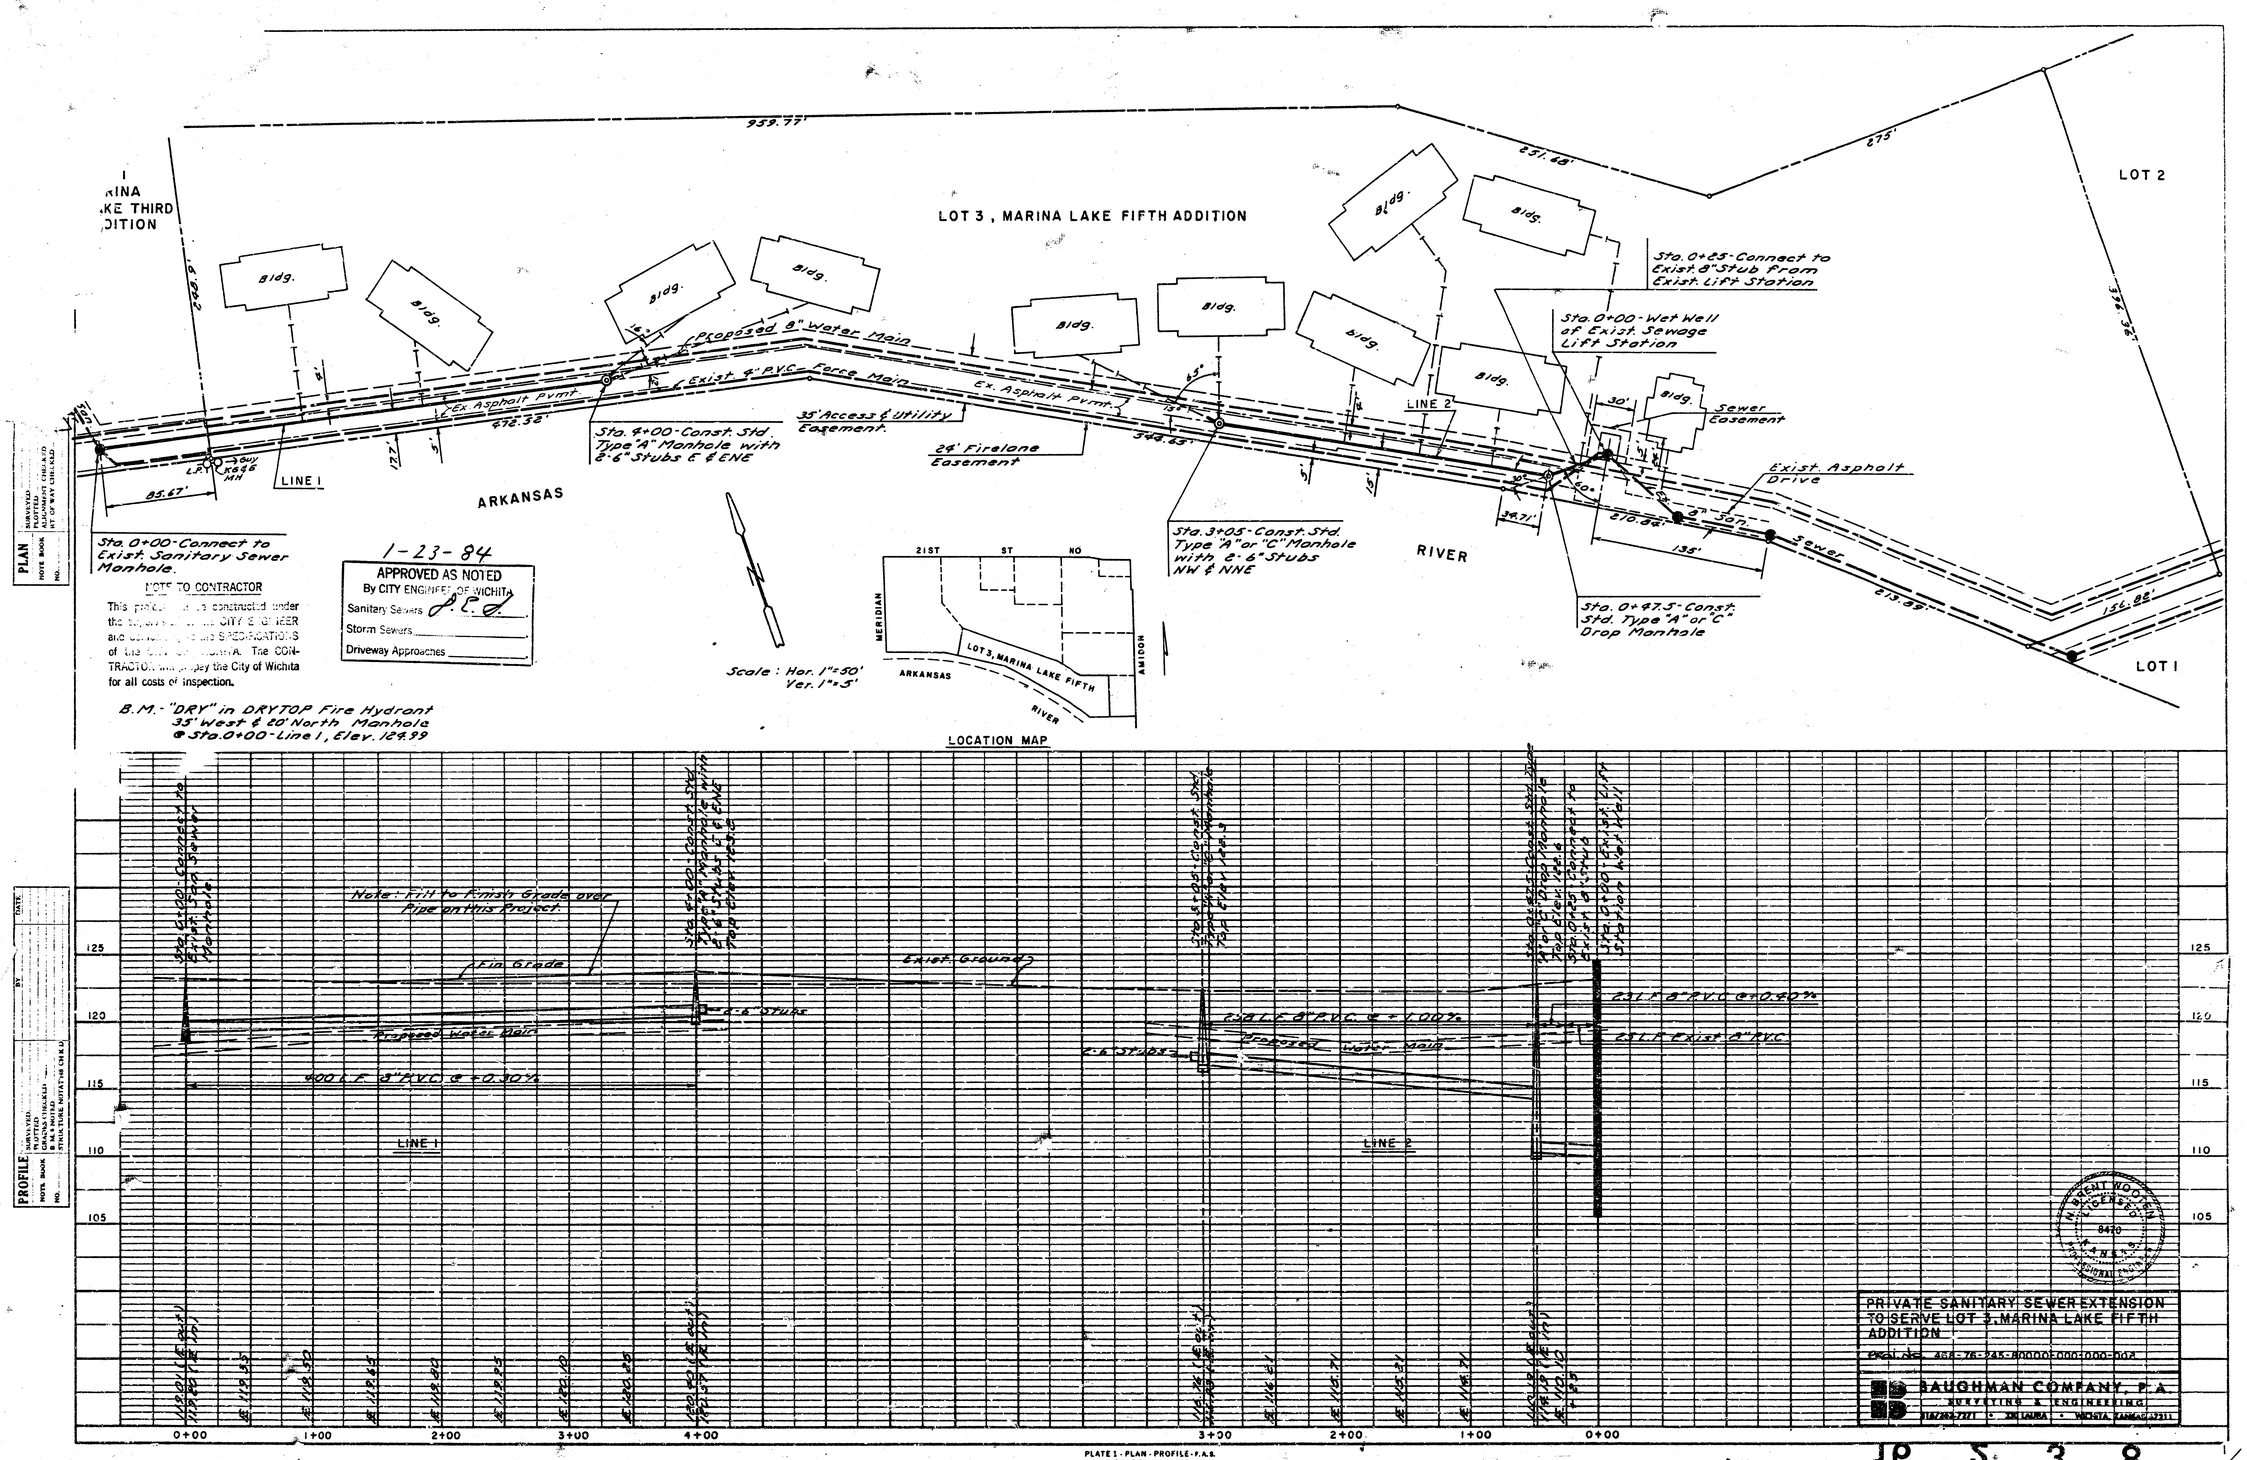

1-23-84

APPROVED AS NOTED
By CITY ENGINEER OF WICHITA
Sanitary Sewers
Storm Sewers
Driveway Approaches

NOTE TO CONTRACTOR

This project is to be constructed under the supervision of the CITY ENGINEER and conforming to the SPECIFICATIONS of the CITY OF WICHITA. The CONTRACTOR will pay the City of Wichita for all costs of inspection.

PLAN — SURVEYED, PLOTTED, ALIGNMENT CHECKED, AT OF WAY CHECKED — NOTE BOOK NO.

PROFILE — SURVEYED, PLOTTED, GRADES CHECKED, B.M. NOTED, STRUCTURE NOTATIONS CHECKED — NOTE BOOK NO.

PRIVATE SANITARY SEWER EXTENSION TO SERVE LOT 3, MARINA LAKE FIFTH ADDITION

Proj. No. 468-76-245-80000-000-000-002

BAUGHMAN COMPANY, P.A.
SURVEYING & ENGINEERING
316/262-7271 • 330 LAURA • WICHITA, KANSAS 67211

N. BRENT WOOTEN LICENSED 8470 KANSAS PROFESSIONAL ENGINEER

PLATE 1 - PLAN - PROFILE - F.A.S.
CLEARPRINT PAPER CO., S.F. CAL.
NO. 1000H-1

1/1