B. M.: 1097' S.E. spike w. side P. Pole on S.W. cor. Woodchuck Ln. & Hendryx St.

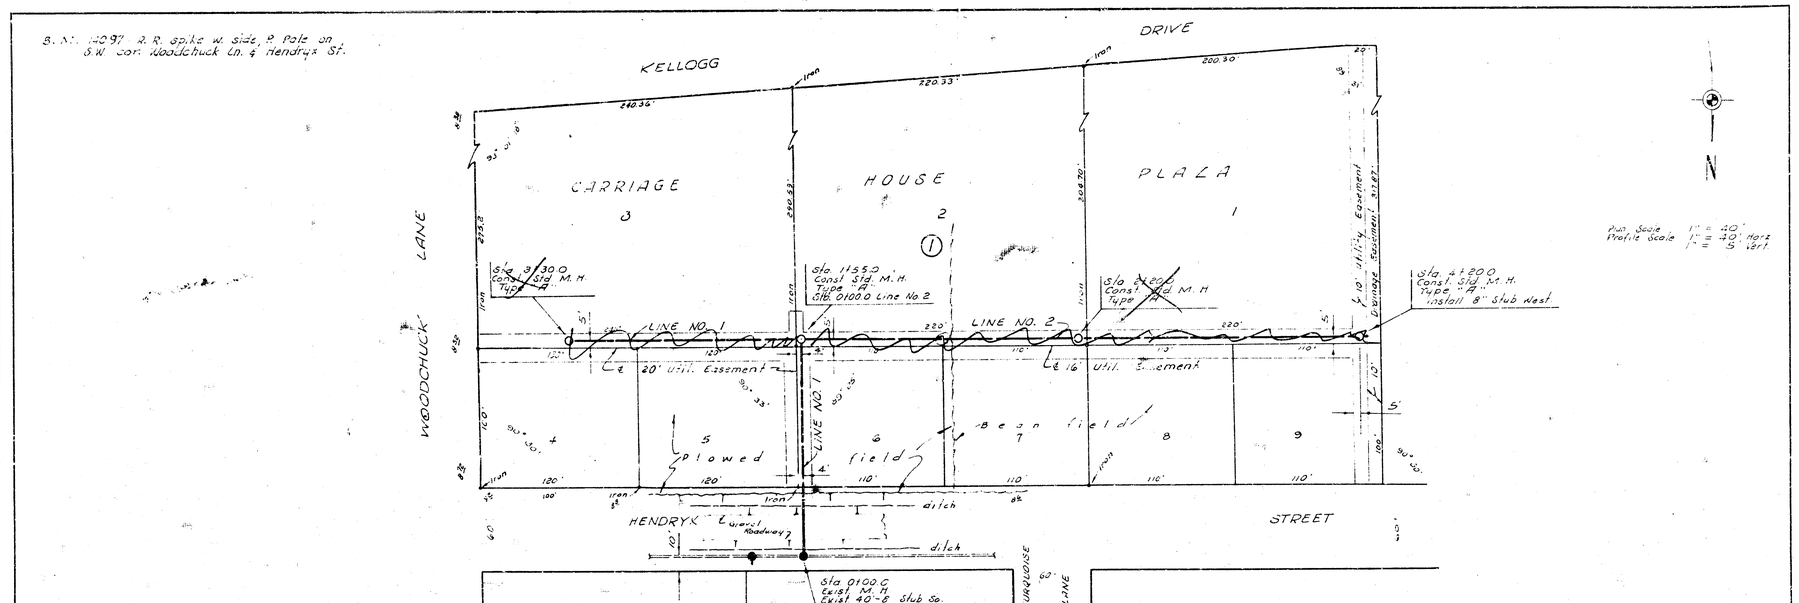

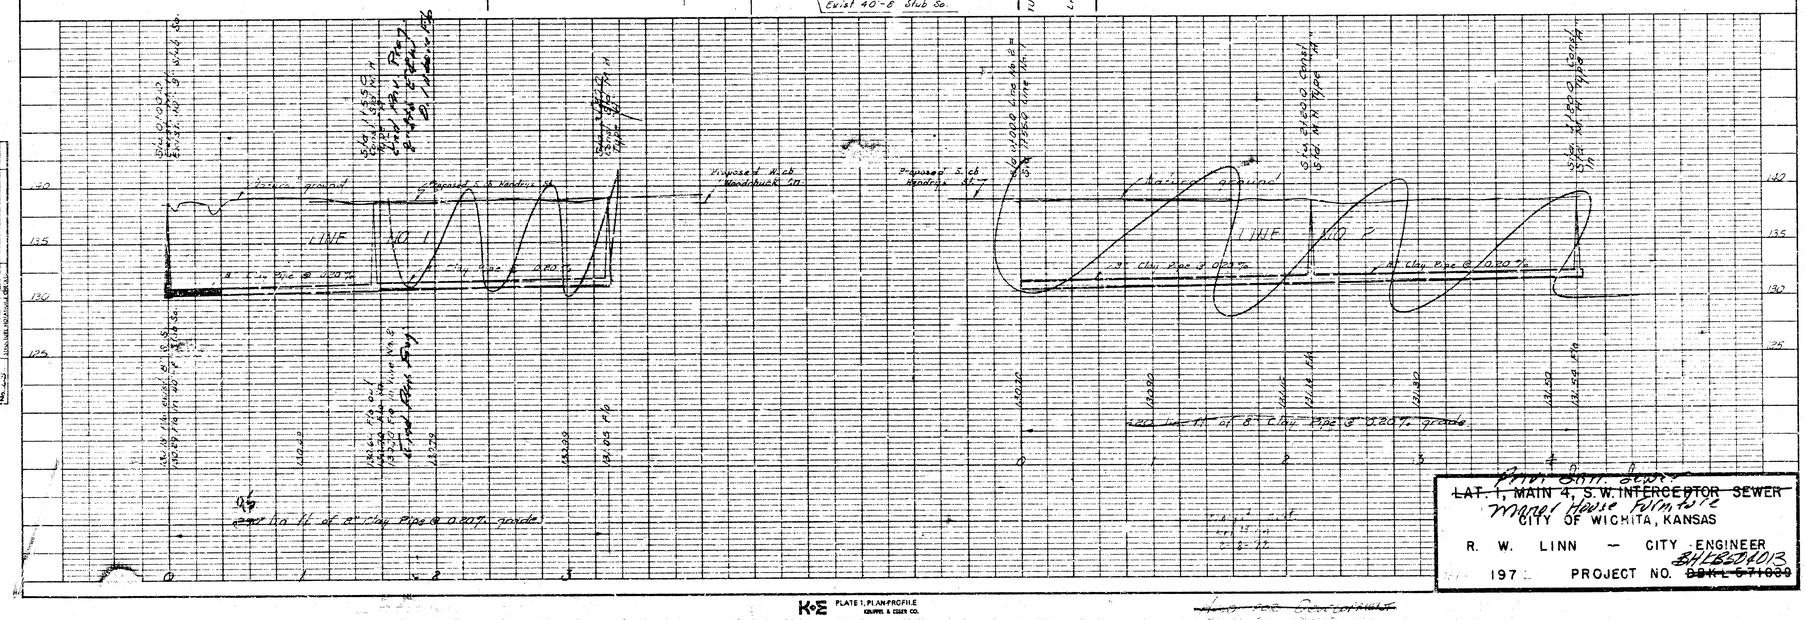

PLAN — NOTE BOOK — No. 60

PROFILE — NOTE BOOK — No. 60

K&E PLATE 1, PLAN-PROFILE KEUFFEL & ESSER CO.

~~LAT. 1, MAIN 4, S.W. INTERCEPTOR SEWER~~
Main Sanit. Sewer
CITY OF WICHITA, KANSAS
R. W. LINN — CITY ENGINEER
197 PROJECT NO. ~~SDW-L-671039~~ SHLSD4013