B. M.: 1409' R. R. spike w. side, P. Pole on S.W. cor. Woodchuck Ln. & Hendryx St.

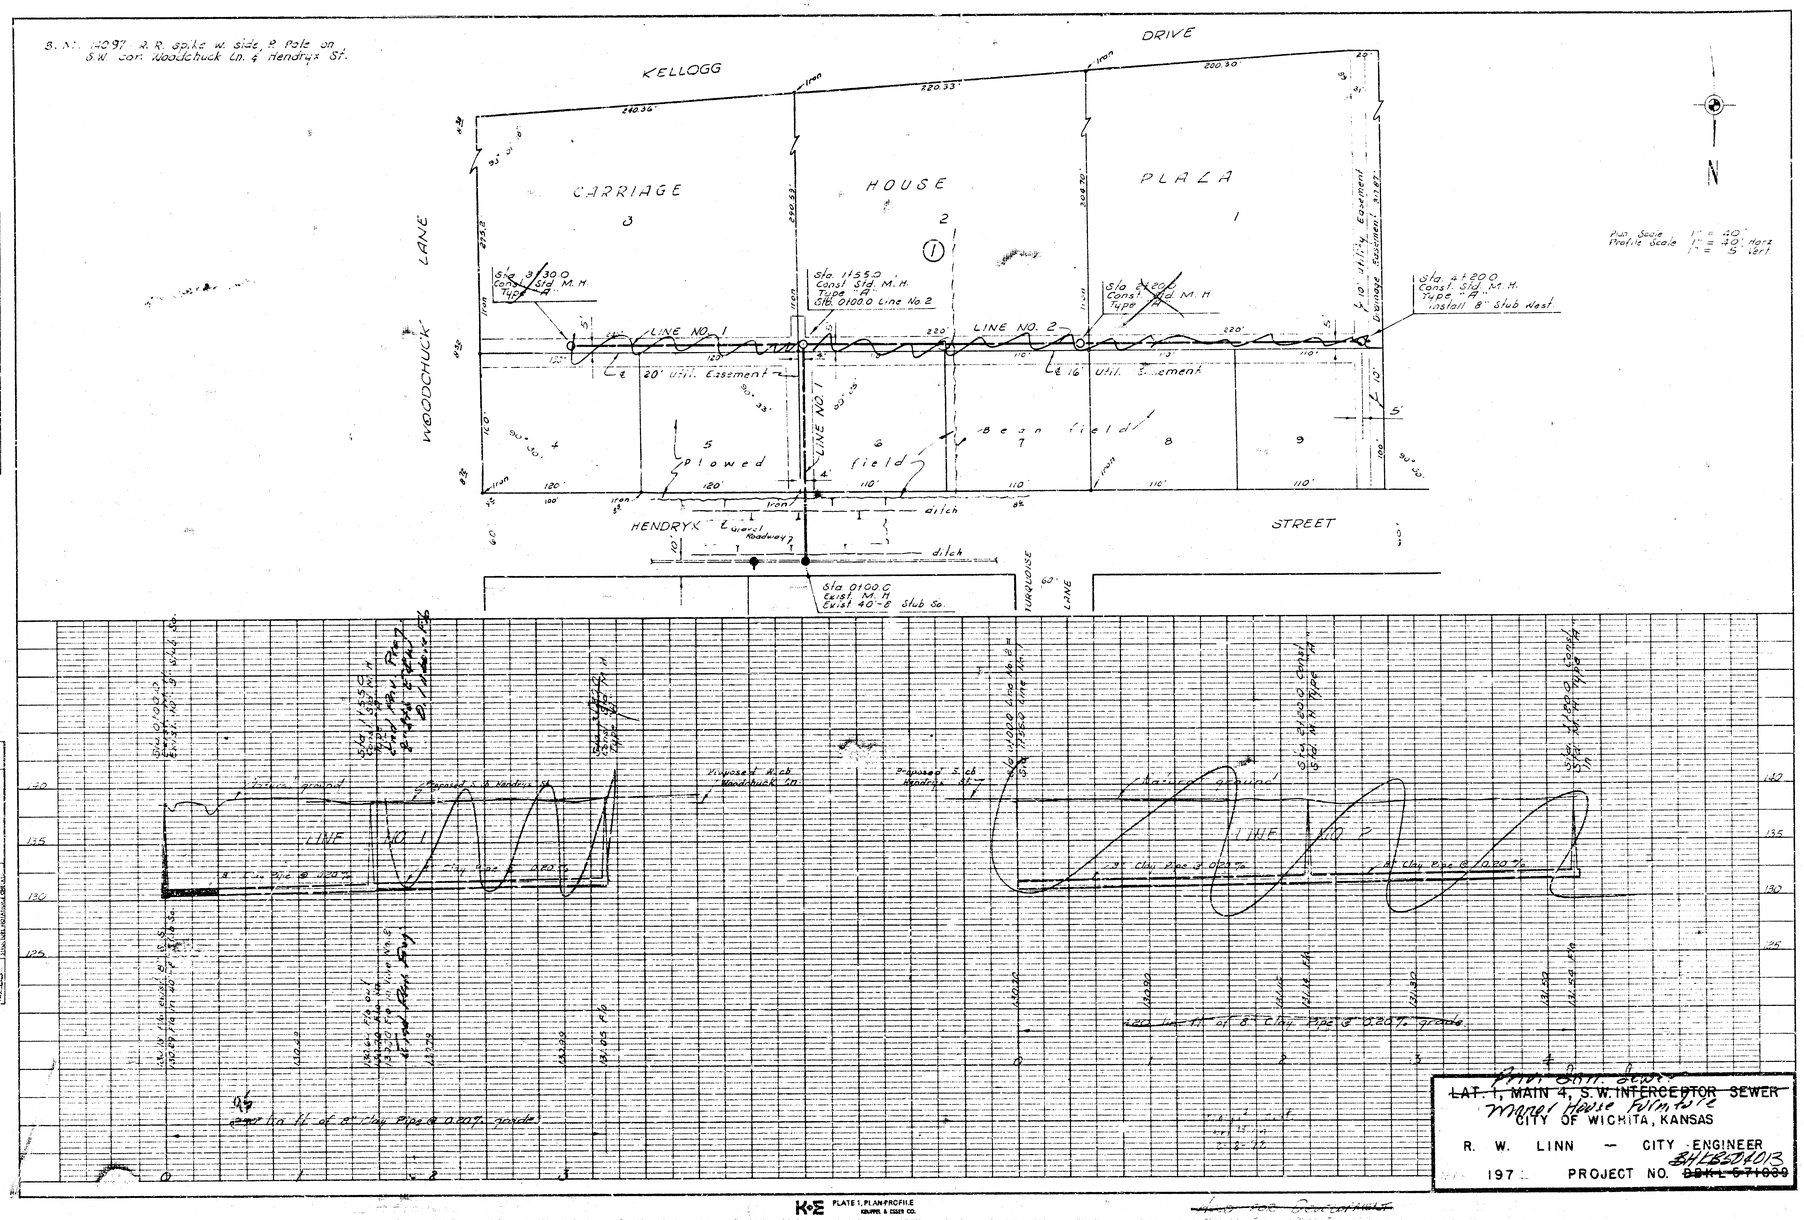

PLAN
NOTE BOOK No. 6-J

PROFILE
NOTE BOOK No. 6-J

K+E PLATE 1, PLAN-PROFILE
KEUFFEL & ESSER CO.