


PLAN
 SURVEYED
 BY
 DATE
 NO. OF SAYS ORDERED
 NO.

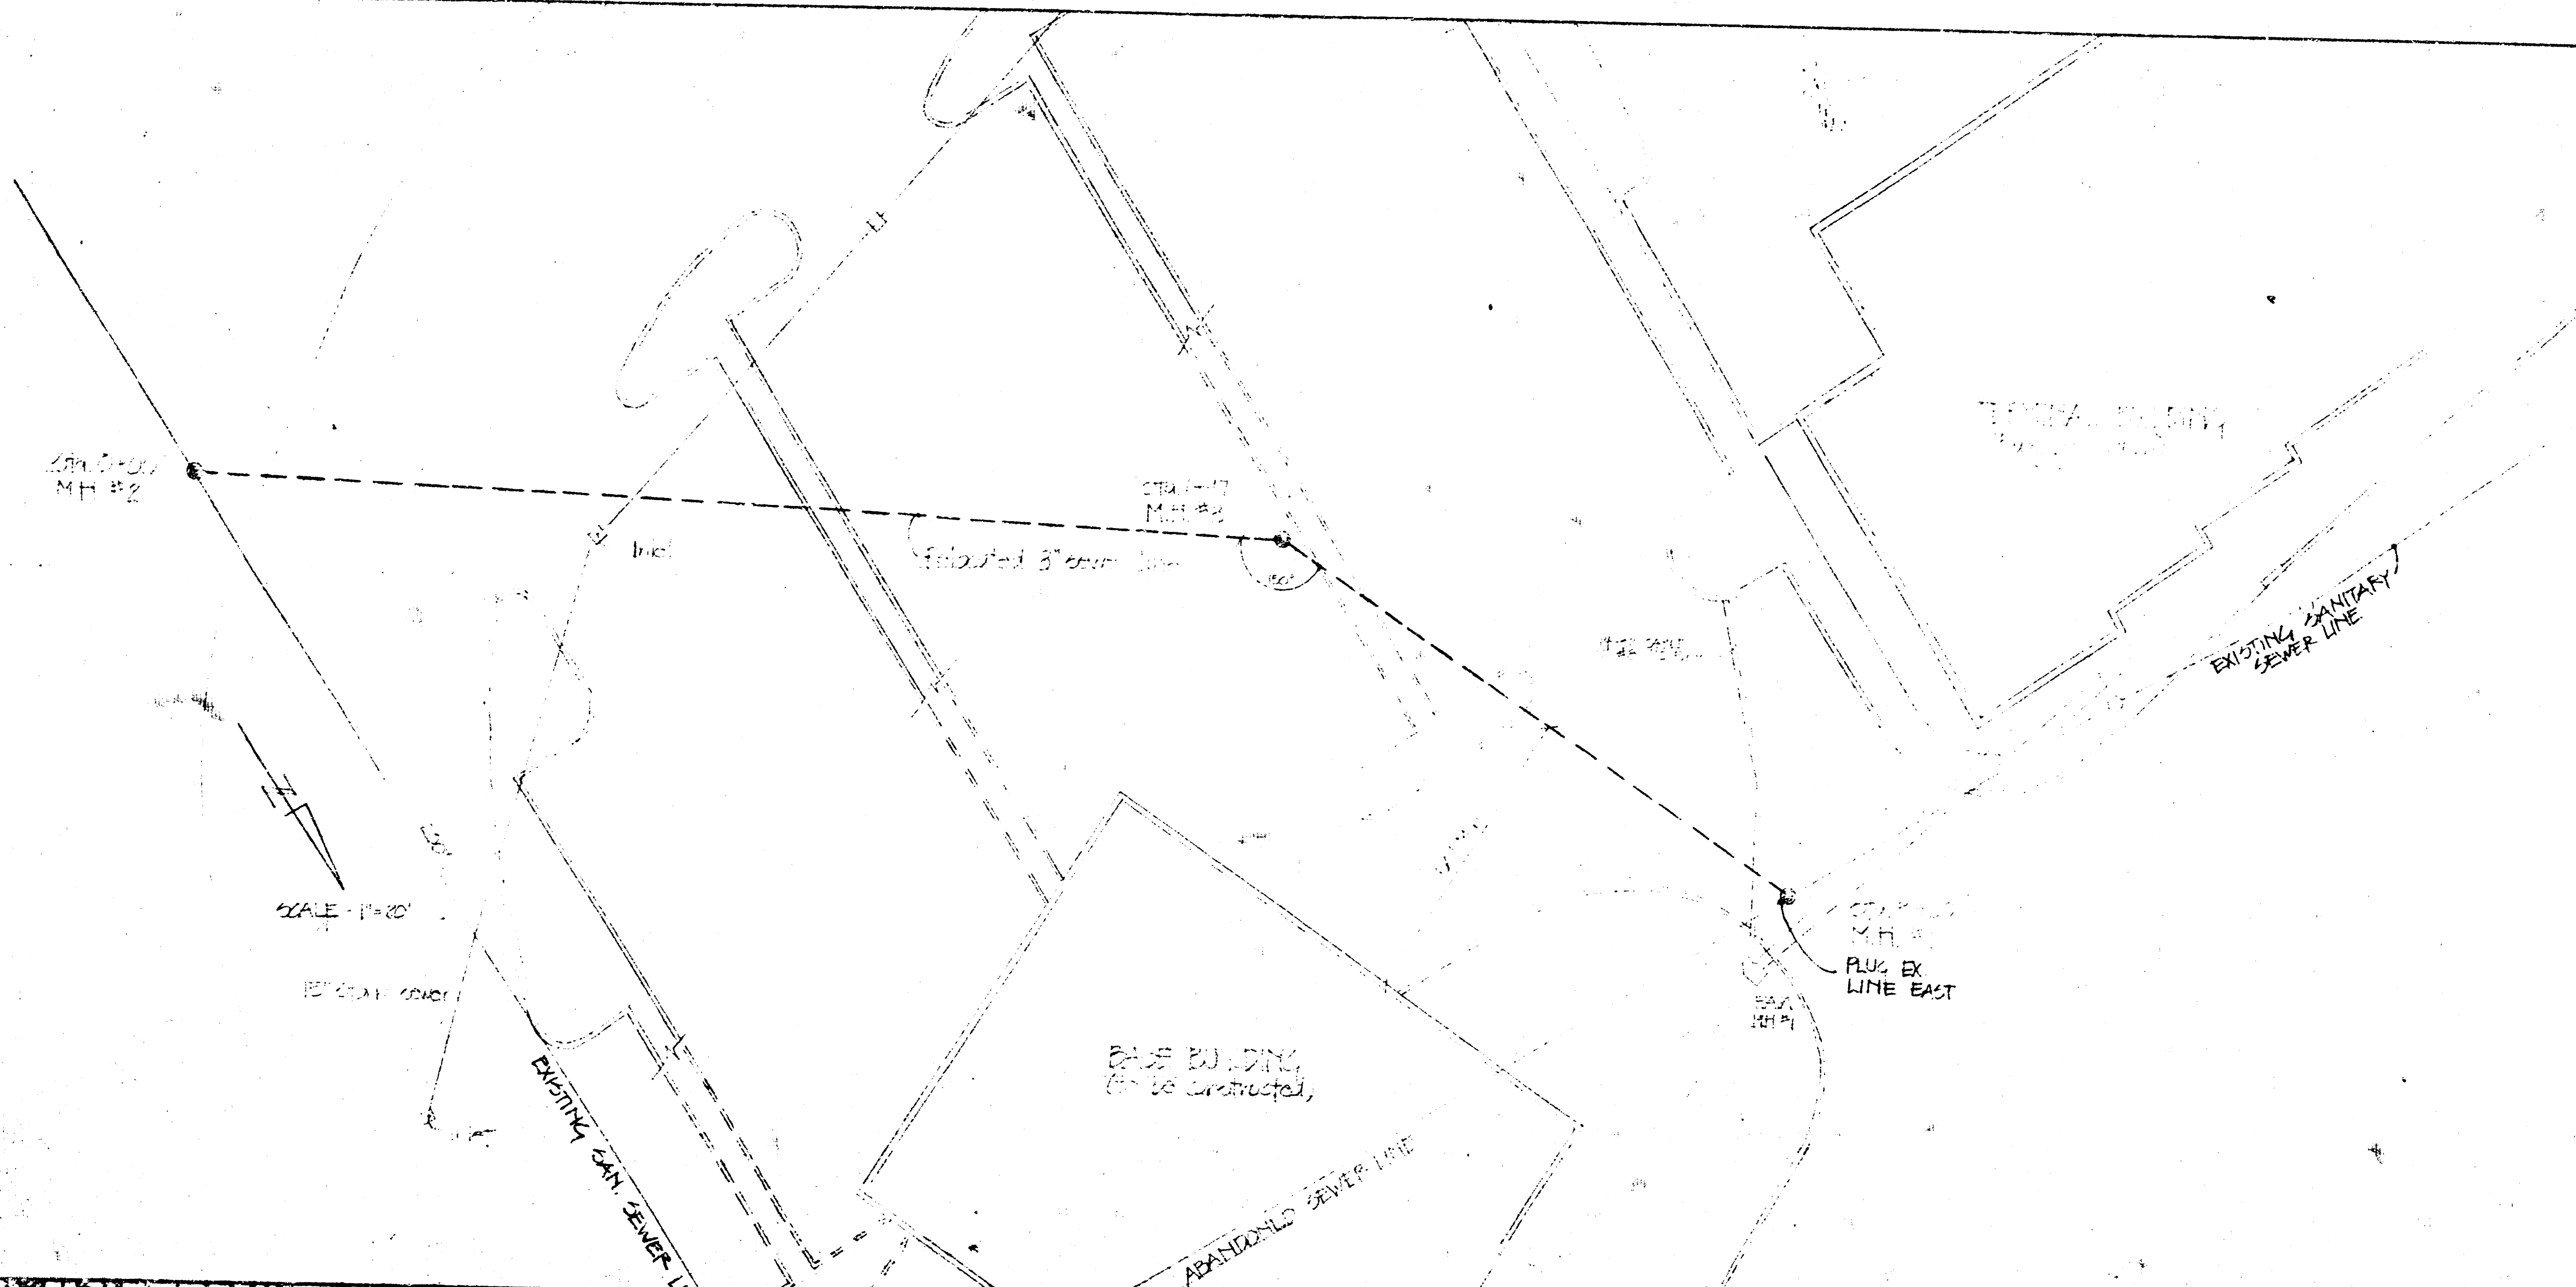

8-1-80
 APPROVED AS NOTED
 BY CITY ENGINEER OF WICHITA
 Sanitary Sewers *ELC*
 Storm Sewers
 Driveway Approaches

NOTE TO CONTRACTOR
 This project will be constructed under the supervision of the CITY ENGINEER and conforming to the SPECIFICATIONS of the CITY OF WICHITA. The CONTRACTOR will reimburse the City of Wichita for all cost of inspection.



PROFILE
 SURVEYED
 BY
 DATE
 NO. OF SAYS ORDERED
 NO.

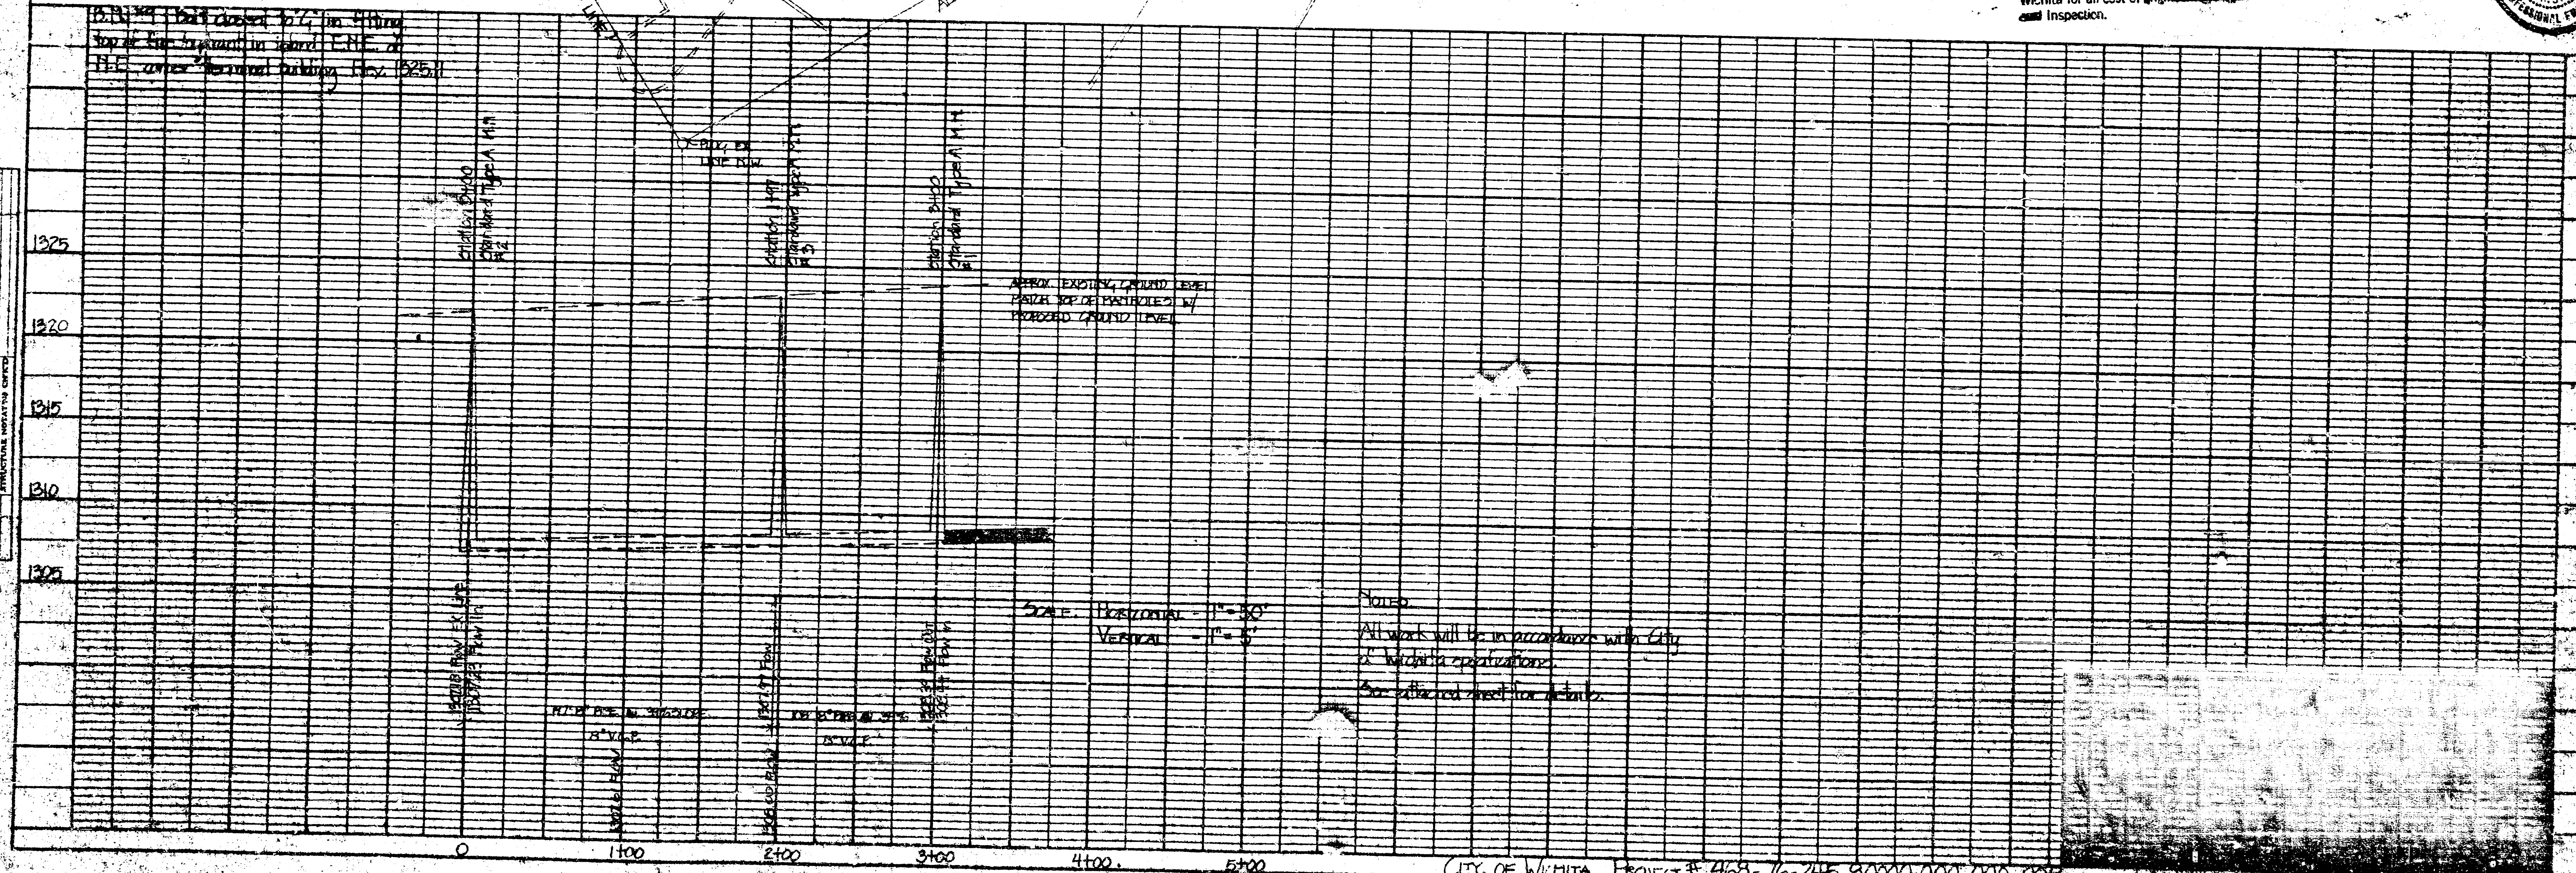


PLATE I - PLAN, PROFILE - F.A.S.
 CLEARPRINT PAPER CO., S.F. CAL.
 NO. 10061

CITY OF WICHITA PROJECT # 468-16-745-80000-000-008



AVAILABLE COPY ...
 FILMED FROM THE BEST