

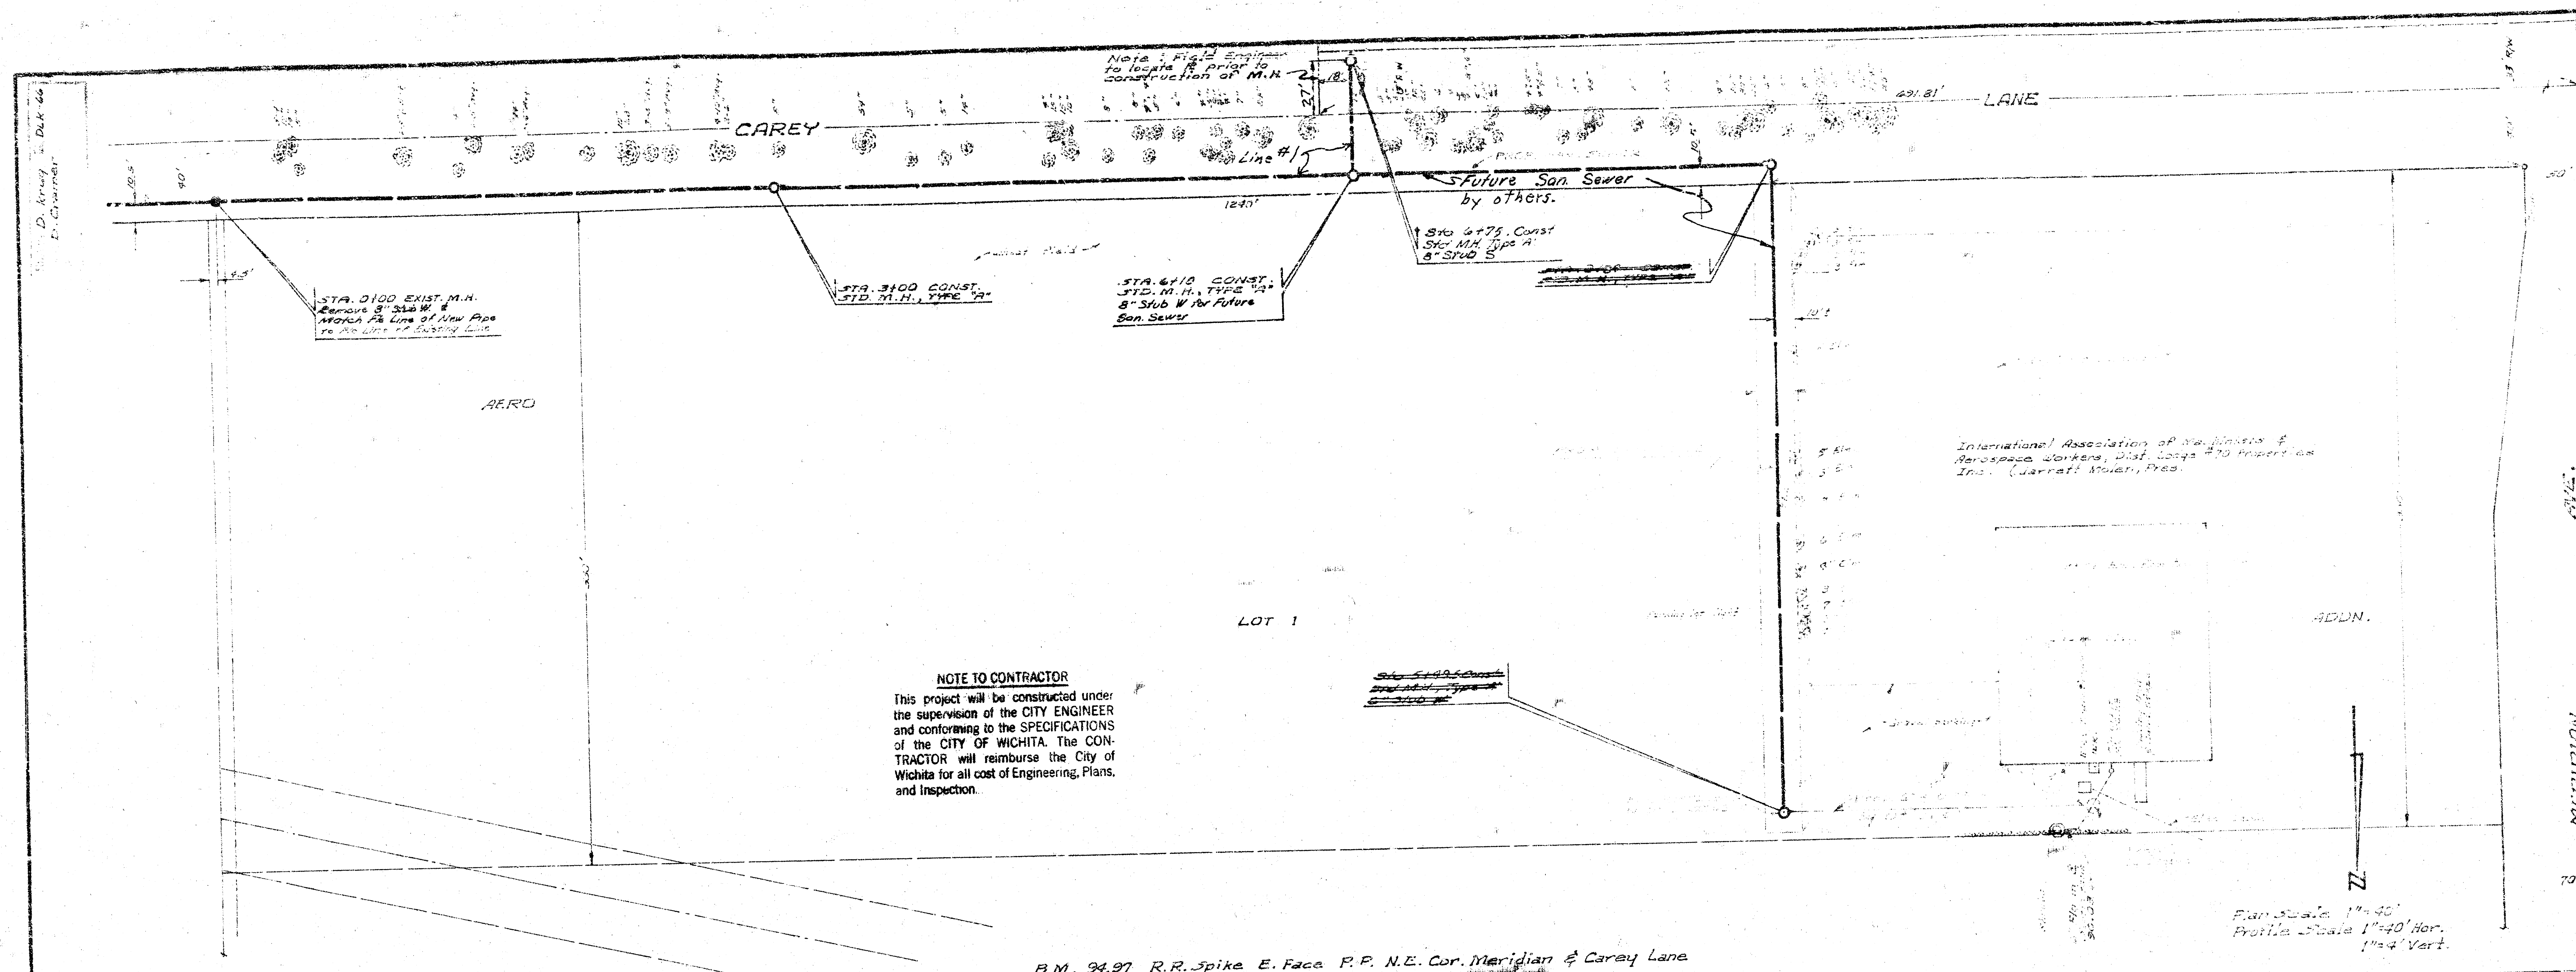


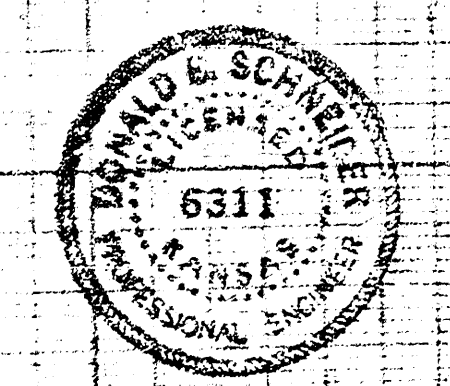

NOTE TO CONTRACTOR
 This project will be constructed under the supervision of the CITY ENGINEER and conforming to the SPECIFICATIONS of the CITY OF WICHITA. The CONTRACTOR will reimburse the City of Wichita for all cost of Engineering, Plans, and Inspection.

B.M. 94.97 R.R. Spike E. Face P.P. N.E. Cor. Meridian & Carey Lane

Plan Scale 1"=40'
 Profile Scale 1"=40' Hor.
 1"=4' Vert.

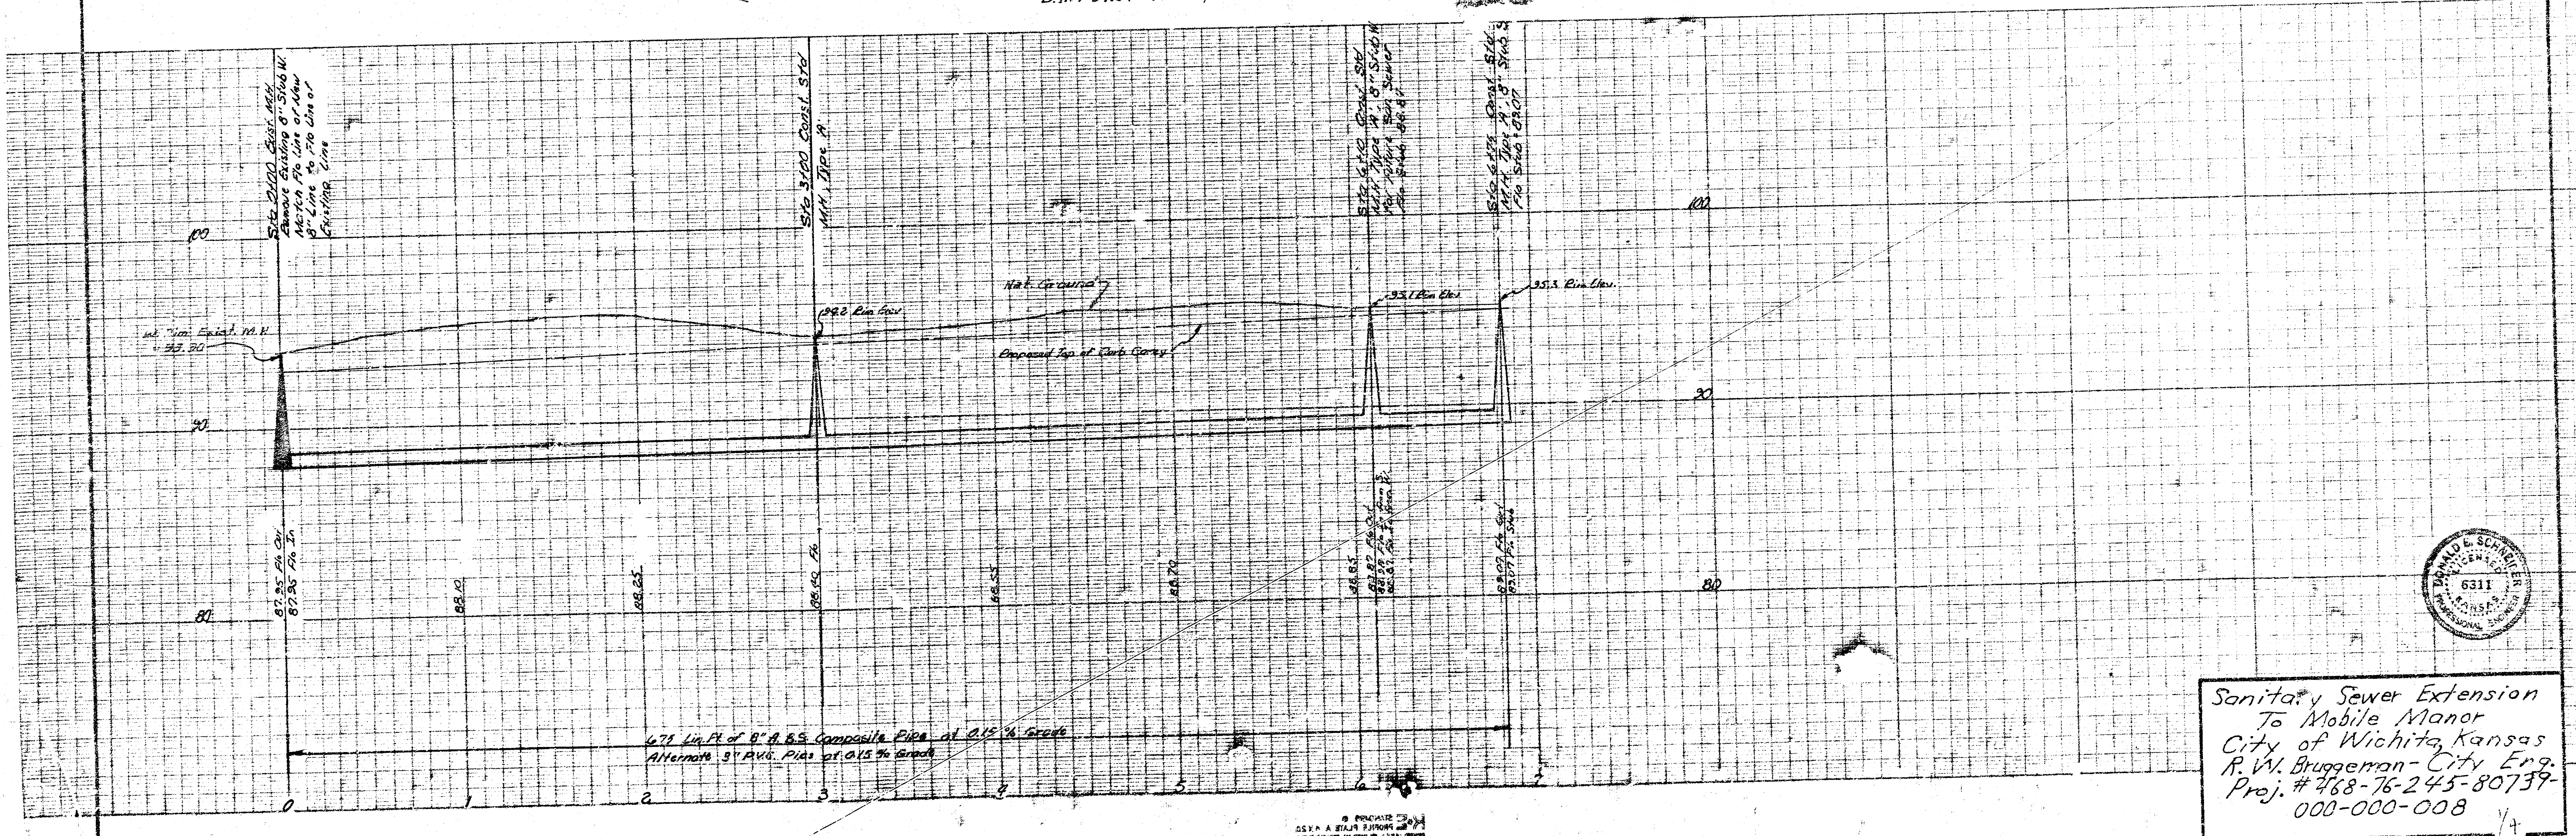

Sanitary Sewer Extension
 To Mobile Manor
 City of Wichita, Kansas
 R.W. Bruggeman - City Eng.
 Proj. # 768-76-245-80737
 000-000-008

