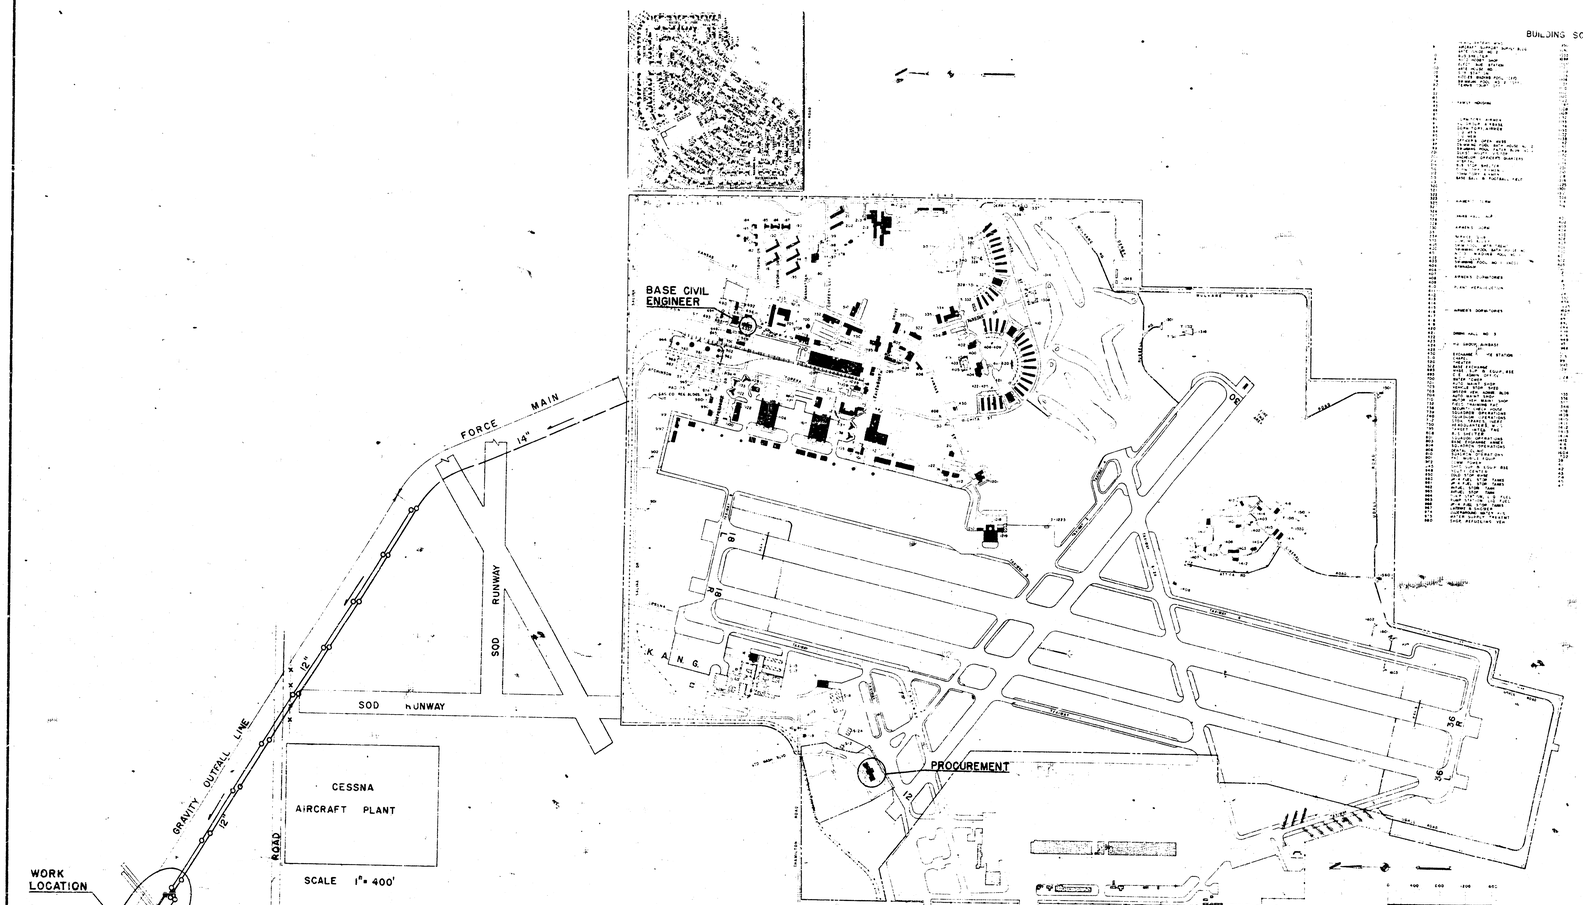


BUILDING SCHEDULE

SITE PLAN

NOTE TO CONTRACTOR
This project will be constructed under the supervision of the CITY ENGINEER and conformed to the SPECIFICATIONS of the City of WICHITA. The CONTRACTOR shall procure the City of


APPROVED AS NOTED
By CITY ENGINEER OF WICHITA
Sanitary Sewers 5-24-69
Storm Sewers
Driveway Approaches

REVISION	DATE	DESCRIPTION	BY	APPROVED

DEPARTMENT OF THE AIR FORCE
TACTICAL AIR COMMAND
Mc CONNELL A.F.B. KANSAS
CIVIL ENGINEER OFFICE

REPAIR SANITARY SEWER MAIN
(SITE PLAN)

APPROVED PROJECT ENGINEER	DATE	DESIGNED BY	DATE
APPROVED CHIEF ENGINEER	DATE	CHECKED BY	DATE
APPROVED FIRE CHIEF	DATE	DRAWN BY	
APPROVED USING AGENCY	DATE	PROJECT NR	MCC 33-8
APPROVED CIVIL ENGINEER	DATE	DWG NR	SHEET
APPROVED BASE COMMANDER	DATE	34-69	1 of 3

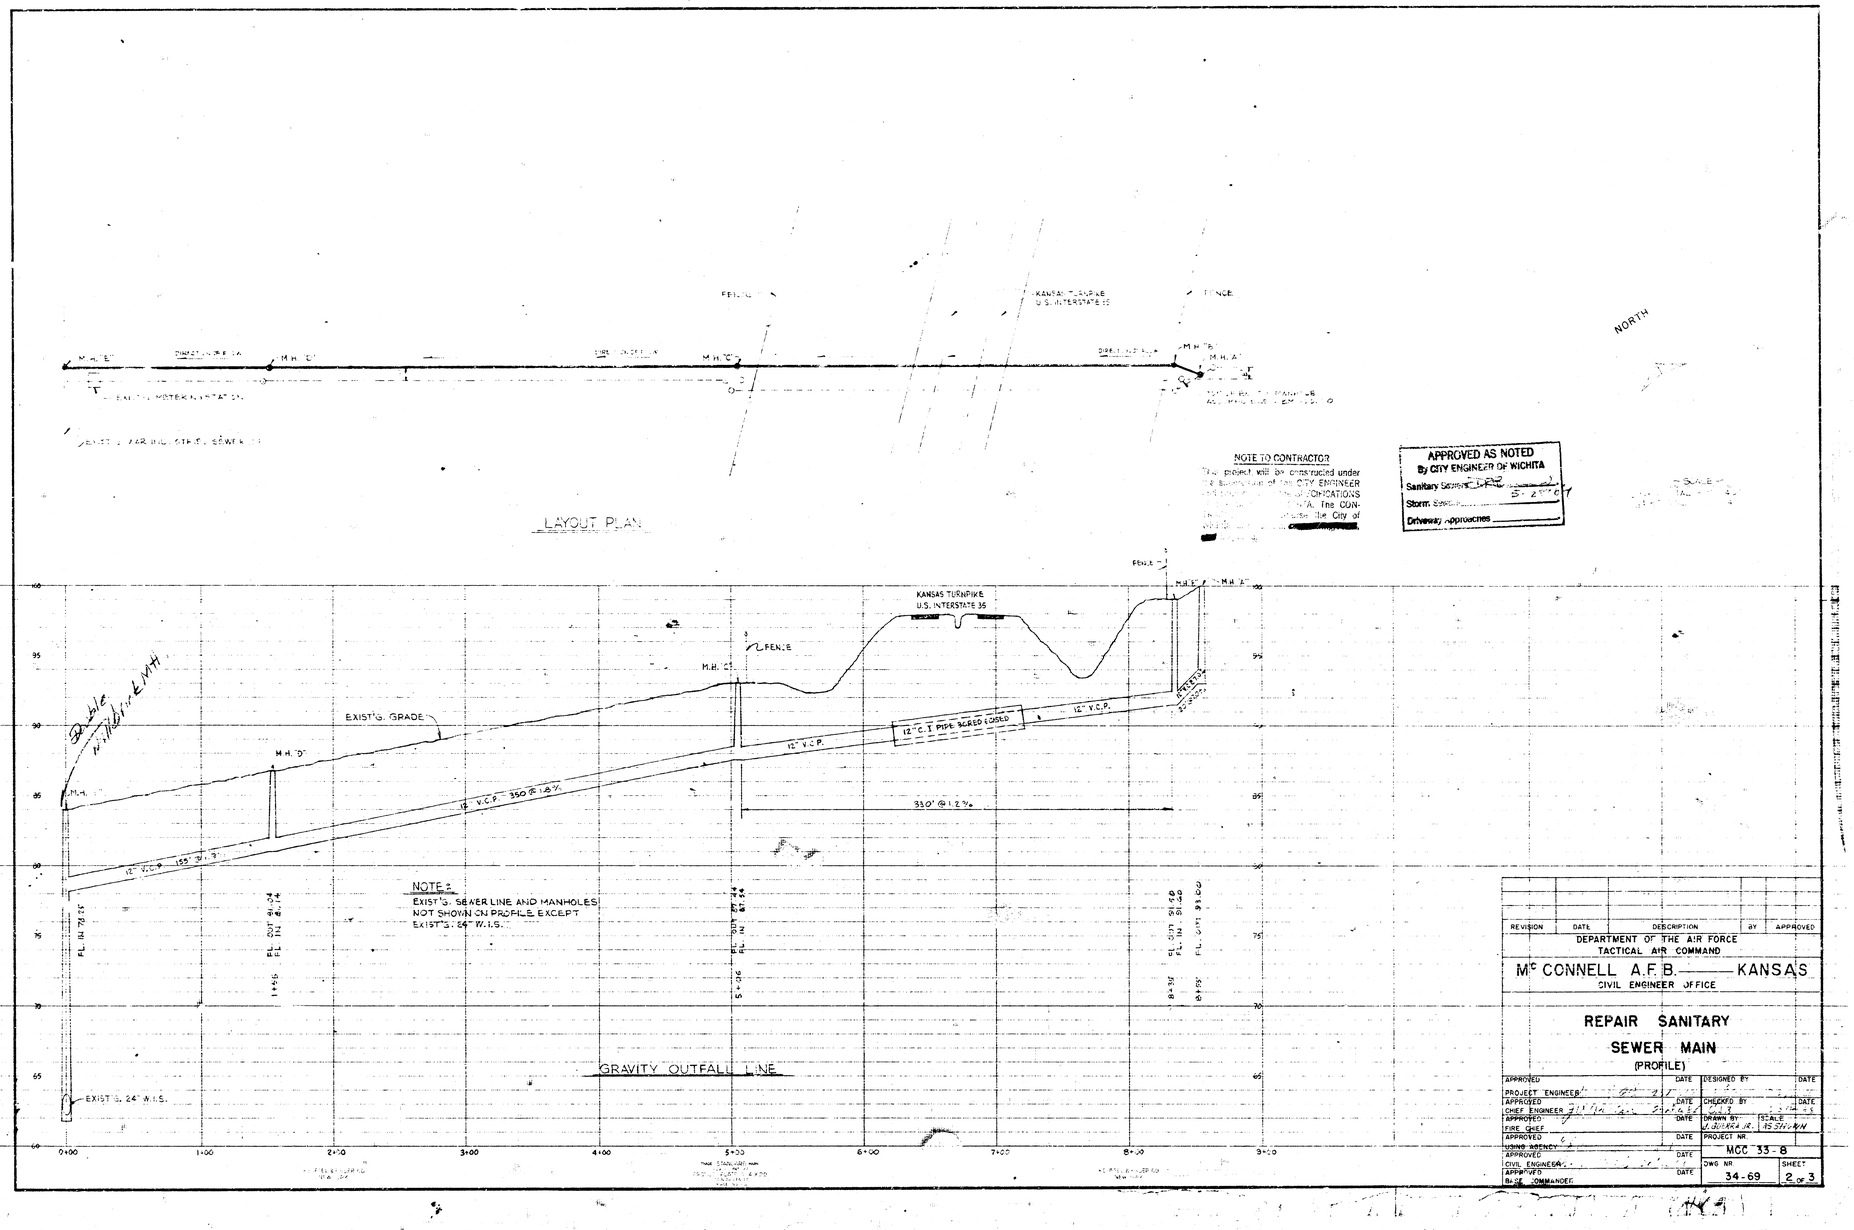


REVISION	DATE	DESCRIPTION	BY	APPROVED

DEPARTMENT OF THE AIR FORCE
TACTICAL AIR COMMAND

McCONNELL A.F.B. ——— KANSAS
CIVIL ENGINEER OFFICE


REPAIR SANITARY SEWER MAIN
(PROFILE)

APPROVED PROJECT ENGINEER	DATE	DESIGNED BY	DATE
APPROVED CHIEF ENGINEER	DATE	CHECKED BY	DATE
APPROVED FIRE CHIEF	DATE	DRAWN BY: J. JOHNSON JR.	SCALE AS SHOWN
APPROVED USING AGENCY	DATE	PROJECT NR	MCC 33-8
APPROVED CIVIL ENGINEER	DATE	DWG NR	SHEET
APPROVED BASE COMMANDER	DATE	34-69	2 OF 3

 


TYPICAL SECTION WITH
USE AT MANHOLE NO. 1

TYPICAL SECTION WITH

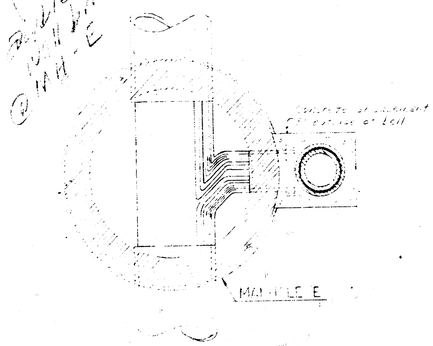

MANHOLE E

SECTION A-A

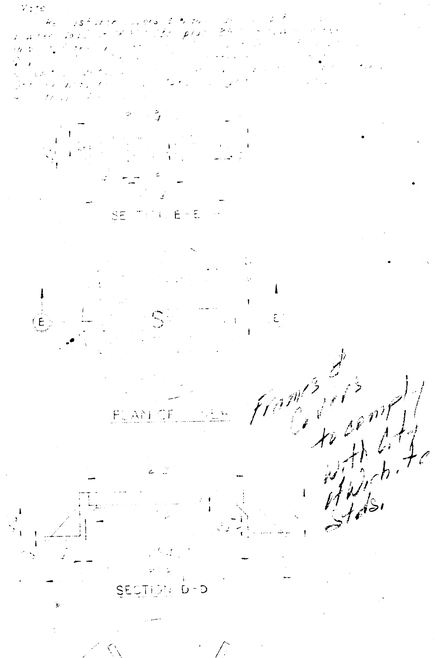


SECTION E-E

PLAN OF MH



SECTION D-D

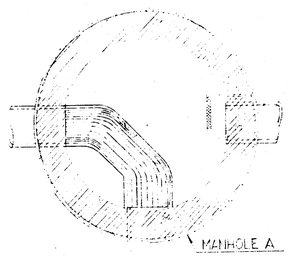

MANHOLE A

SECTION B-B

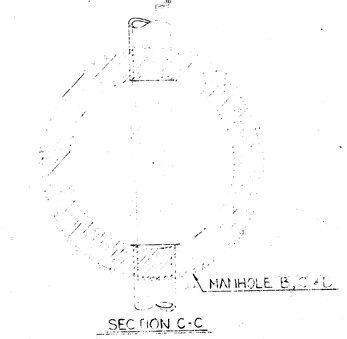


MANHOLE B, C & L

SECTION C-C

Manhole Details

SCALE

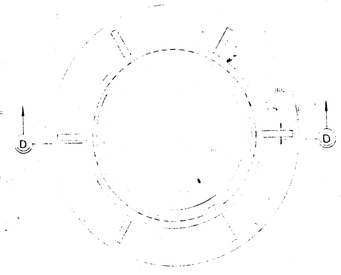

PLAN OF FRAME

CAST IRON COVER & COVER FRAME

NO SCALE

APPROVED AS NOTED
By CITY ENGINEER OF WICHITA
Sanitary Sewers 5-28-69
Storm Sewers
Driveway Approaches

NOTE TO CONTRACTOR

This project will be constructed under the supervision of the CITY ENGINEER and conforming to the SPECIFICATIONS of the CITY OF WICHITA. The CONTRACTOR will reimburse the City of Wichita for the cost of [illegible] inspection.

REVISION	DATE	DESCRIPTION	BY	APPROVED

DEPARTMENT OF THE AIR FORCE
TACTICAL AIR COMMAND

Mc CONNELL A.F.B. ——— KANSAS
CIVIL ENGINEER OFFICE

REPAIR SANITARY SEWER MAIN
(DETAILS)

APPROVED PROJECT ENGINEER	DATE	DESIGNED B	DATE
APPROVED CHIEF ENGINEER	DATE	CHECKED BY	DATE
APPROVED FIRE CHIEF	DATE	DRAWN BY	SCALE
APPROVED USING AGENCY	DATE	PROJECT NR. MCC 33-8	
APPROVED CIVIL ENGINEER	DATE	DWG NR. 34-69	SHEET 3 of 3
APPROVED BASE COMMANDER			