

BUILDING SCHEDULE



NO.	DESCRIPTION	DATE
1
2
SITE PLAN


APPROVED AS NOTED
By CITY ENGINEER OF WICHITA
Sanitary Sewer: *[Signature]*
Storm Sewer: *[Signature]*
Driveway Approaches: *[Signature]*

NOTE TO CONTRACTOR
This project will be constructed under the supervision of the CITY ENGINEER and conforming to the SPECIFICATIONS of the CITY OF WICHITA. The CONTRACTOR shall advise the City of any changes or corrections.

REVISION	DATE	DESCRIPTION	BY	APPROVED
DEPARTMENT OF THE AIR FORCE TACTICAL AIR COMMAND				
M ^C CONNELL A.F.B. — KANSAS				
CIVIL ENGINEER OFFICE				
REPAIR SANITARY SEWER MAIN (SITE PLAN)				
APPROVED	DATE	DESIGNED BY	DATE	
PROJECT ENGINEER	11/22	<i>[Signature]</i>	CHECKED BY	DATE
APPROVED	DATE	CHECKED BY	DATE	
CHIEF ENGINEER	11/22	<i>[Signature]</i>	DESIGN BY	DATE
APPROVED	DATE	DESIGN BY	DATE	
FIRE CHIEF	DATE	PROJECT NO.	DATE	
APPROVED	DATE	PROJECT NO.	DATE	
USING AGENCY	DATE	PROJECT NO.	DATE	
APPROVED	DATE	PROJECT NO.	DATE	
CIVIL ENGINEER	DATE	PROJECT NO.	DATE	
APPROVED	DATE	PROJECT NO.	DATE	
BASE COMMANDER	DATE	PROJECT NO.	DATE	
34-69		1		3

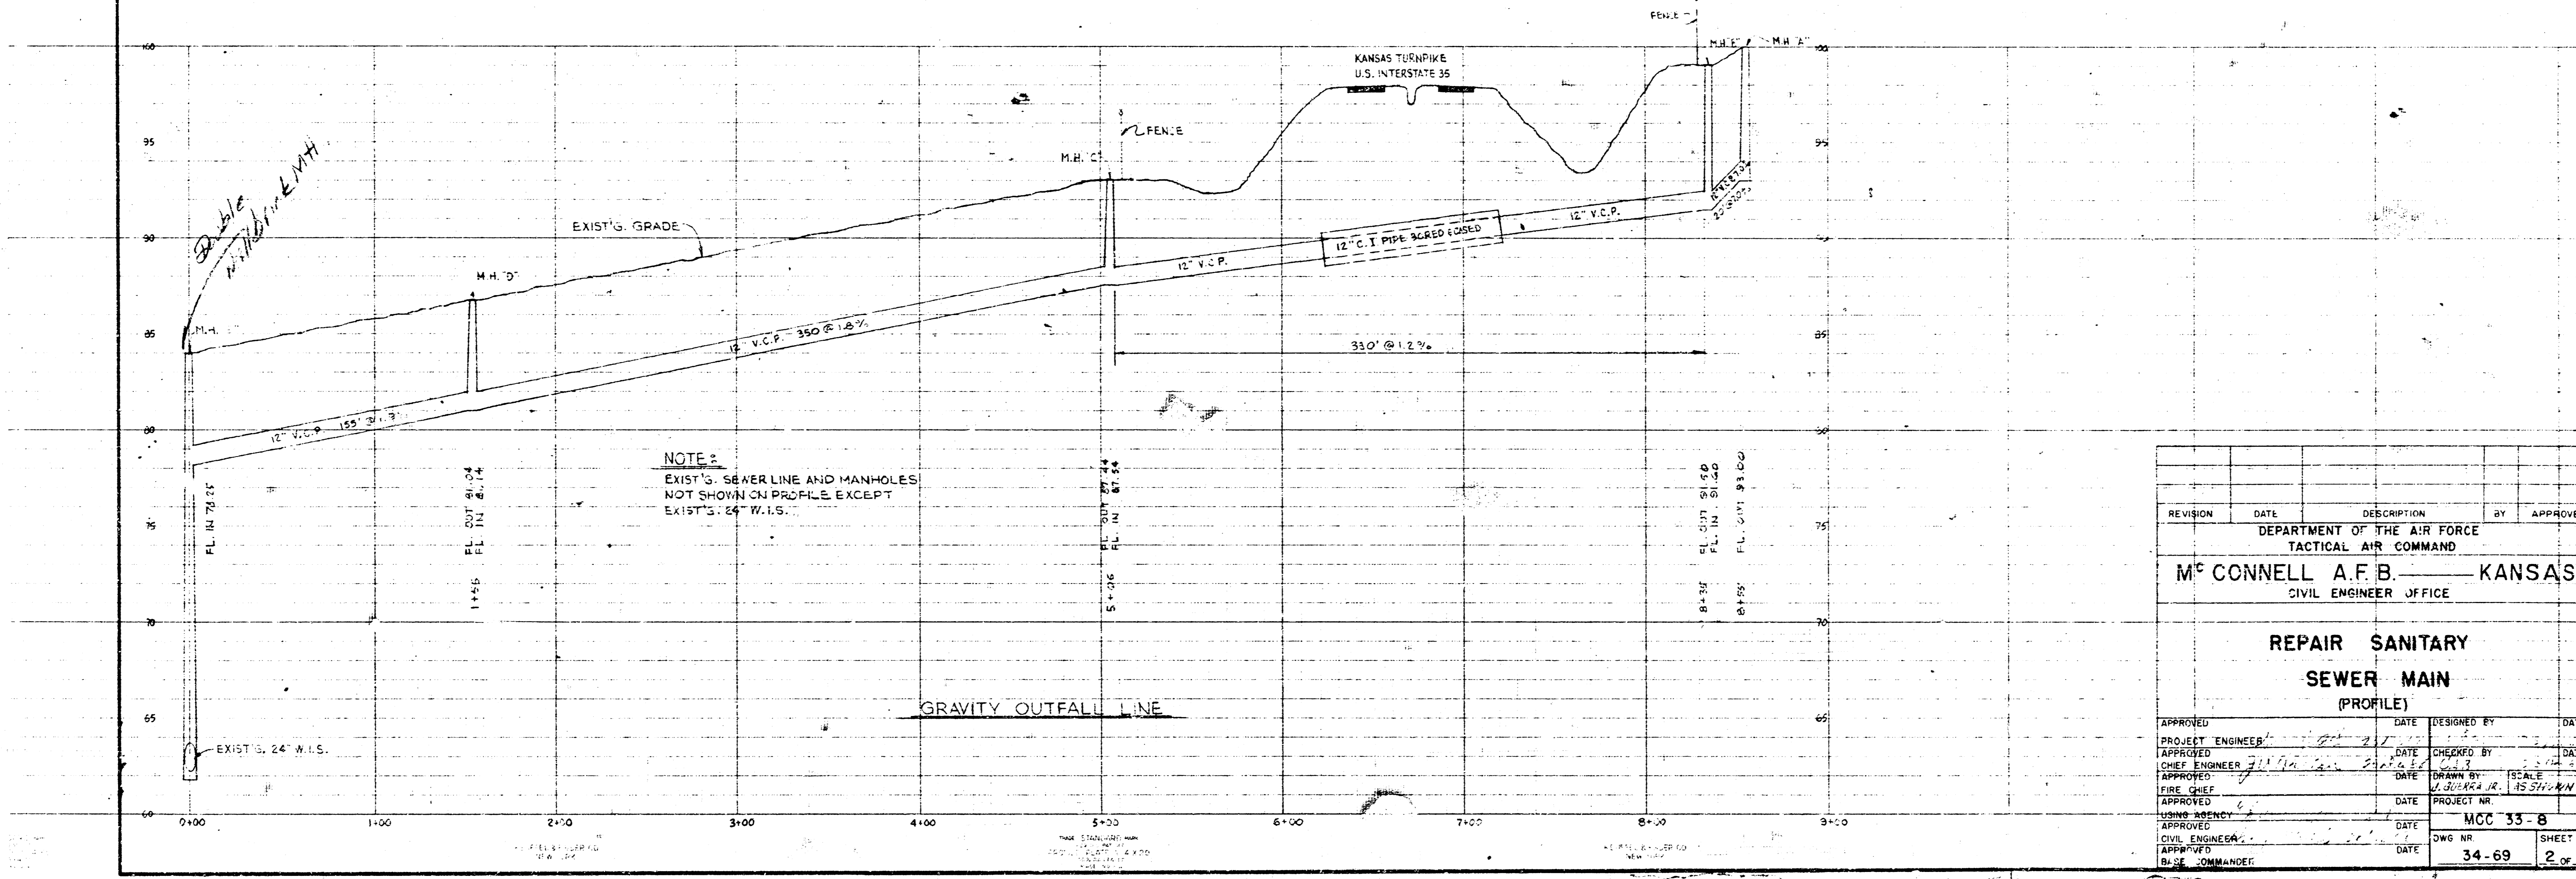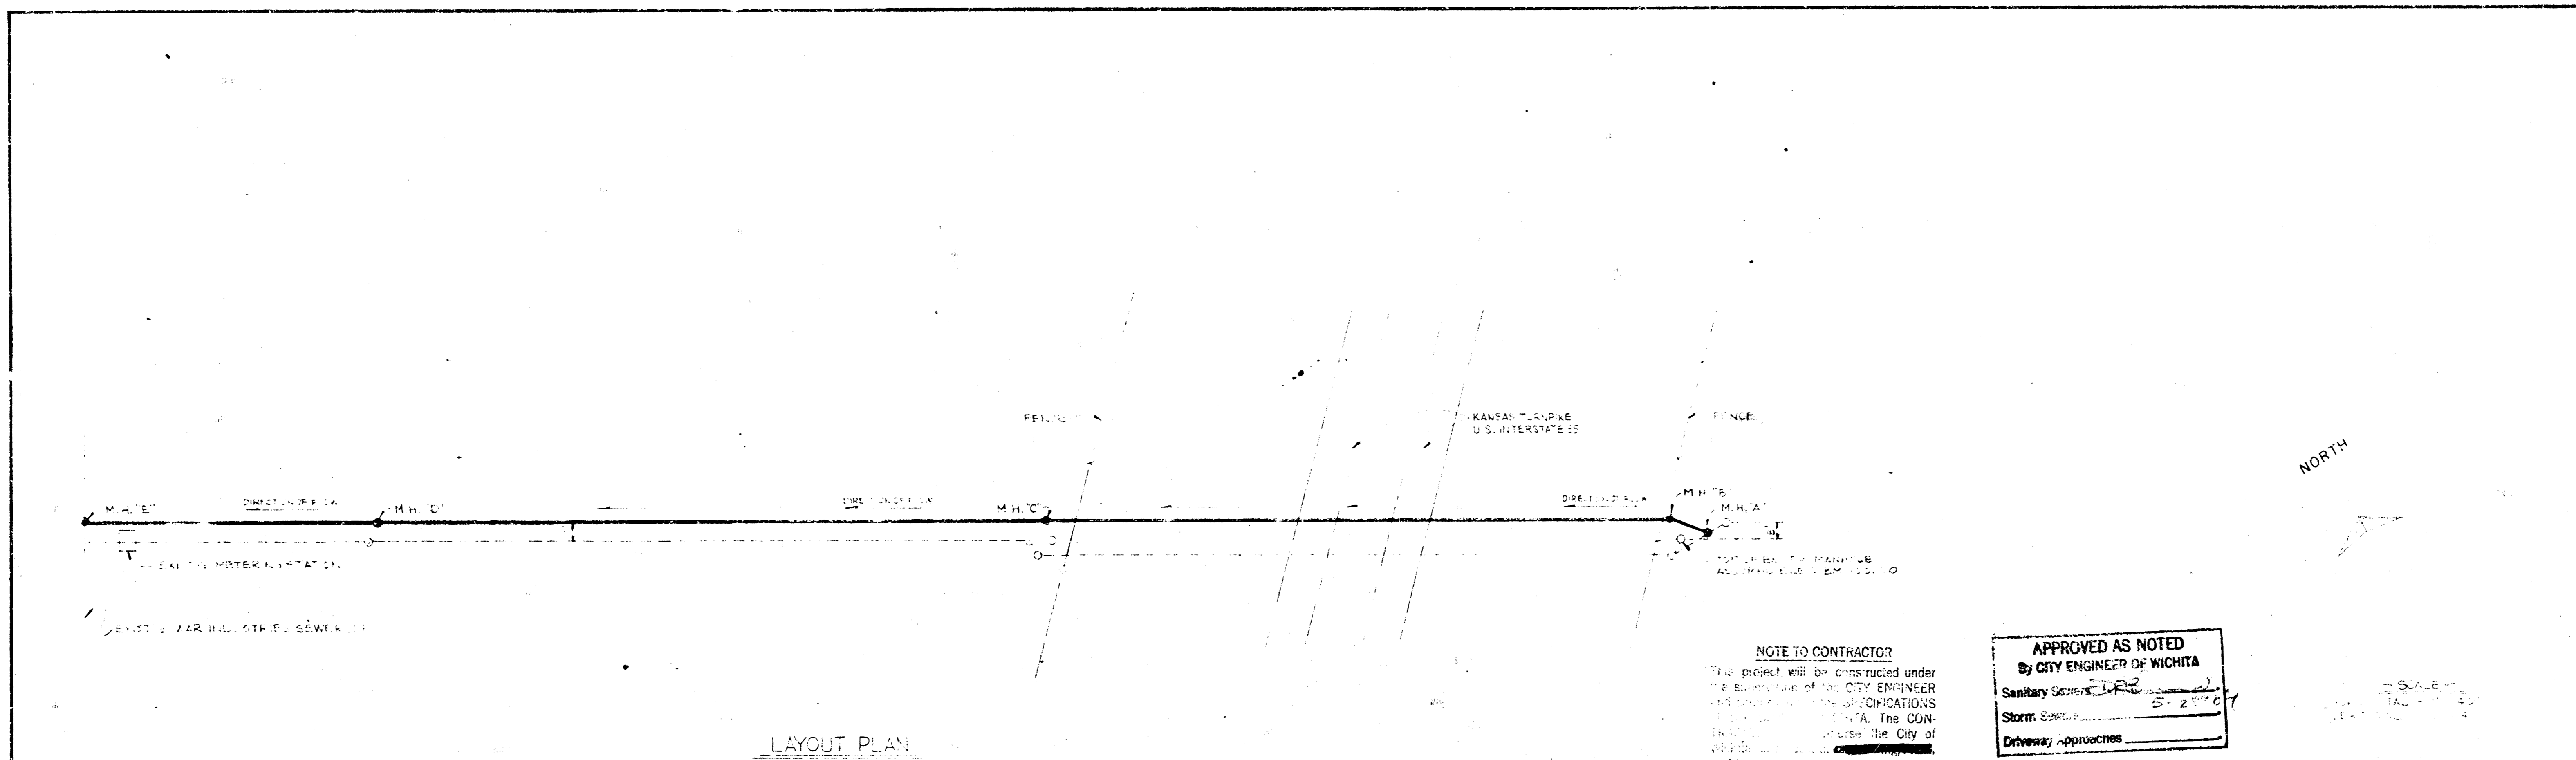

REVISION	DATE	DESCRIPTION	BY	APPROVED
DEPARTMENT OF THE AIR FORCE TACTICAL AIR COMMAND				
M ^o CONNELL A.F.B. — KANSAS				
CIVIL ENGINEER OFFICE				
REPAIR SANITARY SEWER MAIN (PROFILE)				
APPROVED	DATE	DESIGNED BY	DATE	
PROJECT ENGINEER			CHECKED BY	DATE
APPROVED	DATE	DESIGNED BY	DATE	
CHIEF ENGINEER			CHECKED BY	DATE
PROJECT NO. MCC 33-8			SHEET 2 OF 3	
DATE 34-69			DATE	

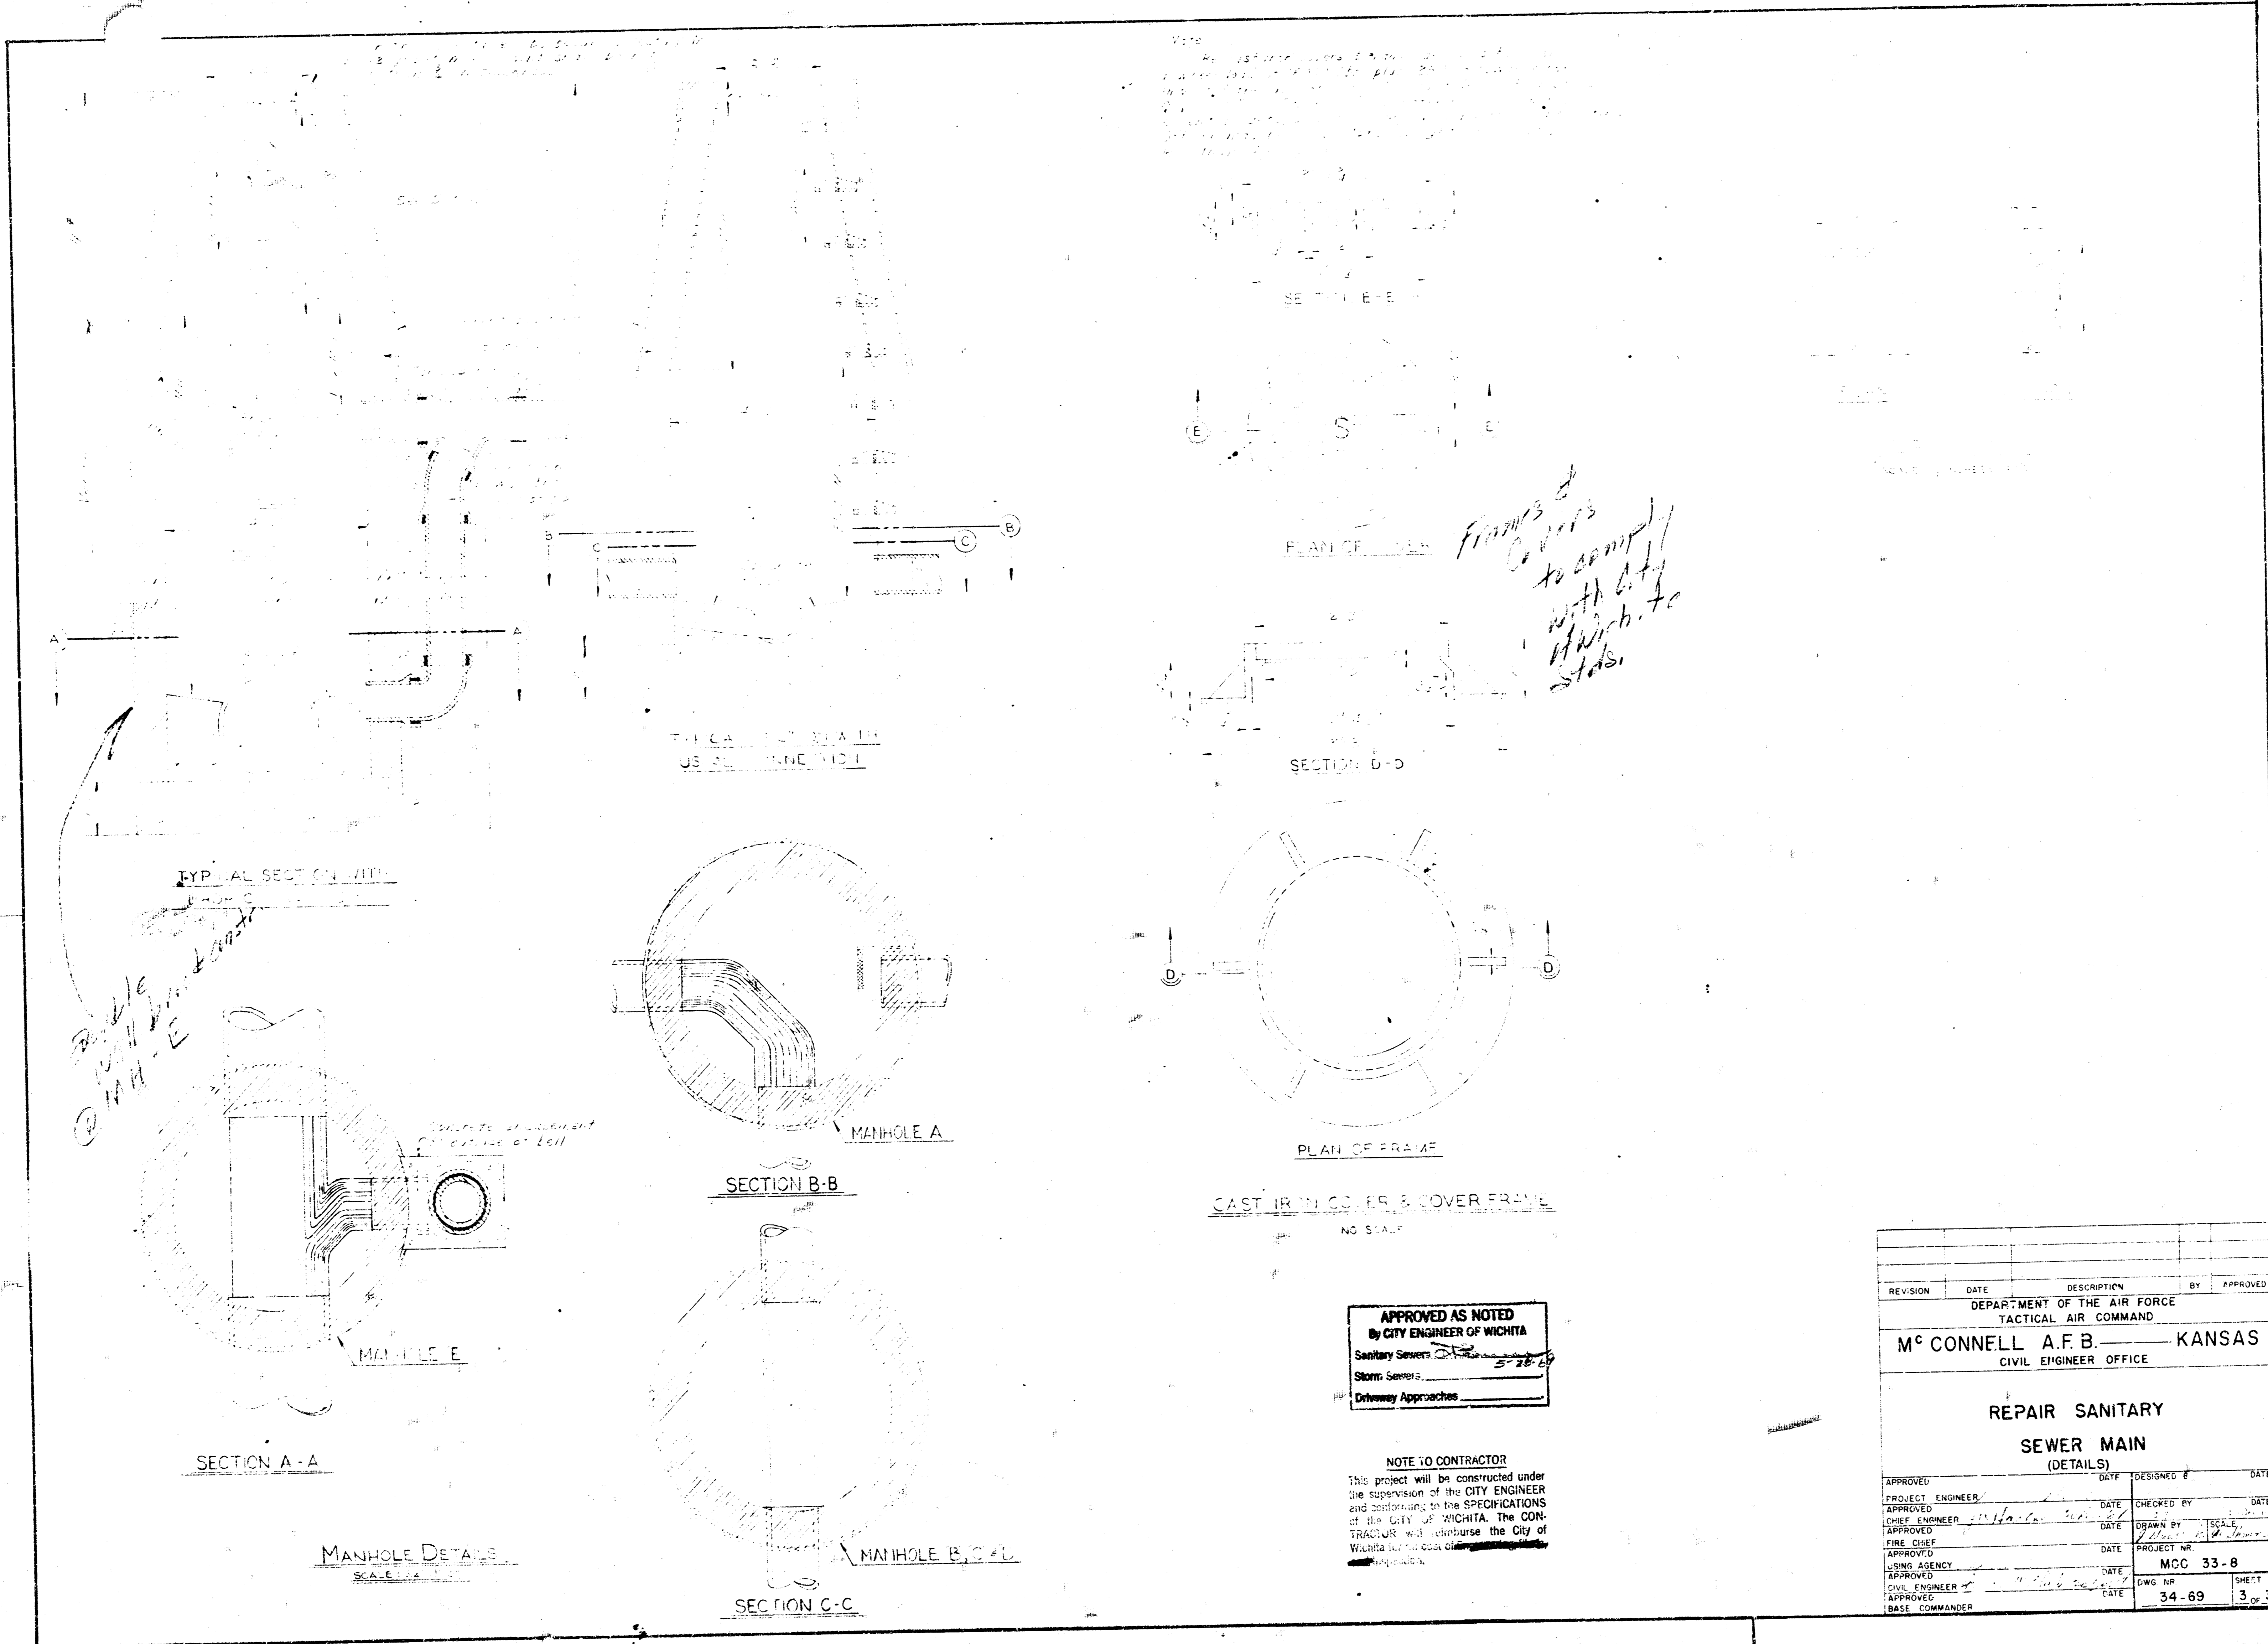

frames & covers to comply with City of Wichita standards.

*Revised 5/28/69
MCC 33-8*

APPROVED AS NOTED
By CITY ENGINEER OF WICHITA
Sanitary Sewers *[Signature]*
Storm Sewers
Driveway Approaches

NOTE TO CONTRACTOR
This project will be constructed under the supervision of the CITY ENGINEER and conforming to the SPECIFICATIONS of the CITY OF WICHITA. The CONTRACTOR will reimburse the City of Wichita for the cost of *[illegible]*

REVISION	DATE	DESCRIPTION	BY	APPROVED
DEPARTMENT OF THE AIR FORCE TACTICAL AIR COMMAND				
M ^c CONNELL A.F.B. — KANSAS			CIVIL ENGINEER OFFICE	
REPAIR SANITARY SEWER MAIN (DETAILS)				
APPROVED	DATE	DESIGNED BY	DATE	
PROJECT ENGINEER			CHECKED BY	DATE
APPROVED	DATE	DESIGNED BY	DATE	
CHIEF ENGINEER			CHECKED BY	DATE
APPROVED	DATE	DESIGNED BY	DATE	
FINE CHIEF			CHECKED BY	DATE
APPROVED	DATE	DESIGNED BY	DATE	
LSMR AGENCY			PROJECT NR	
APPROVED	DATE	DESIGNED BY	DATE	
CIVIL ENGINEER			DWG NR	SHEET
APPROVED	DATE	DESIGNED BY	DATE	
BASE COMMANDER			34-69	3 of 3