


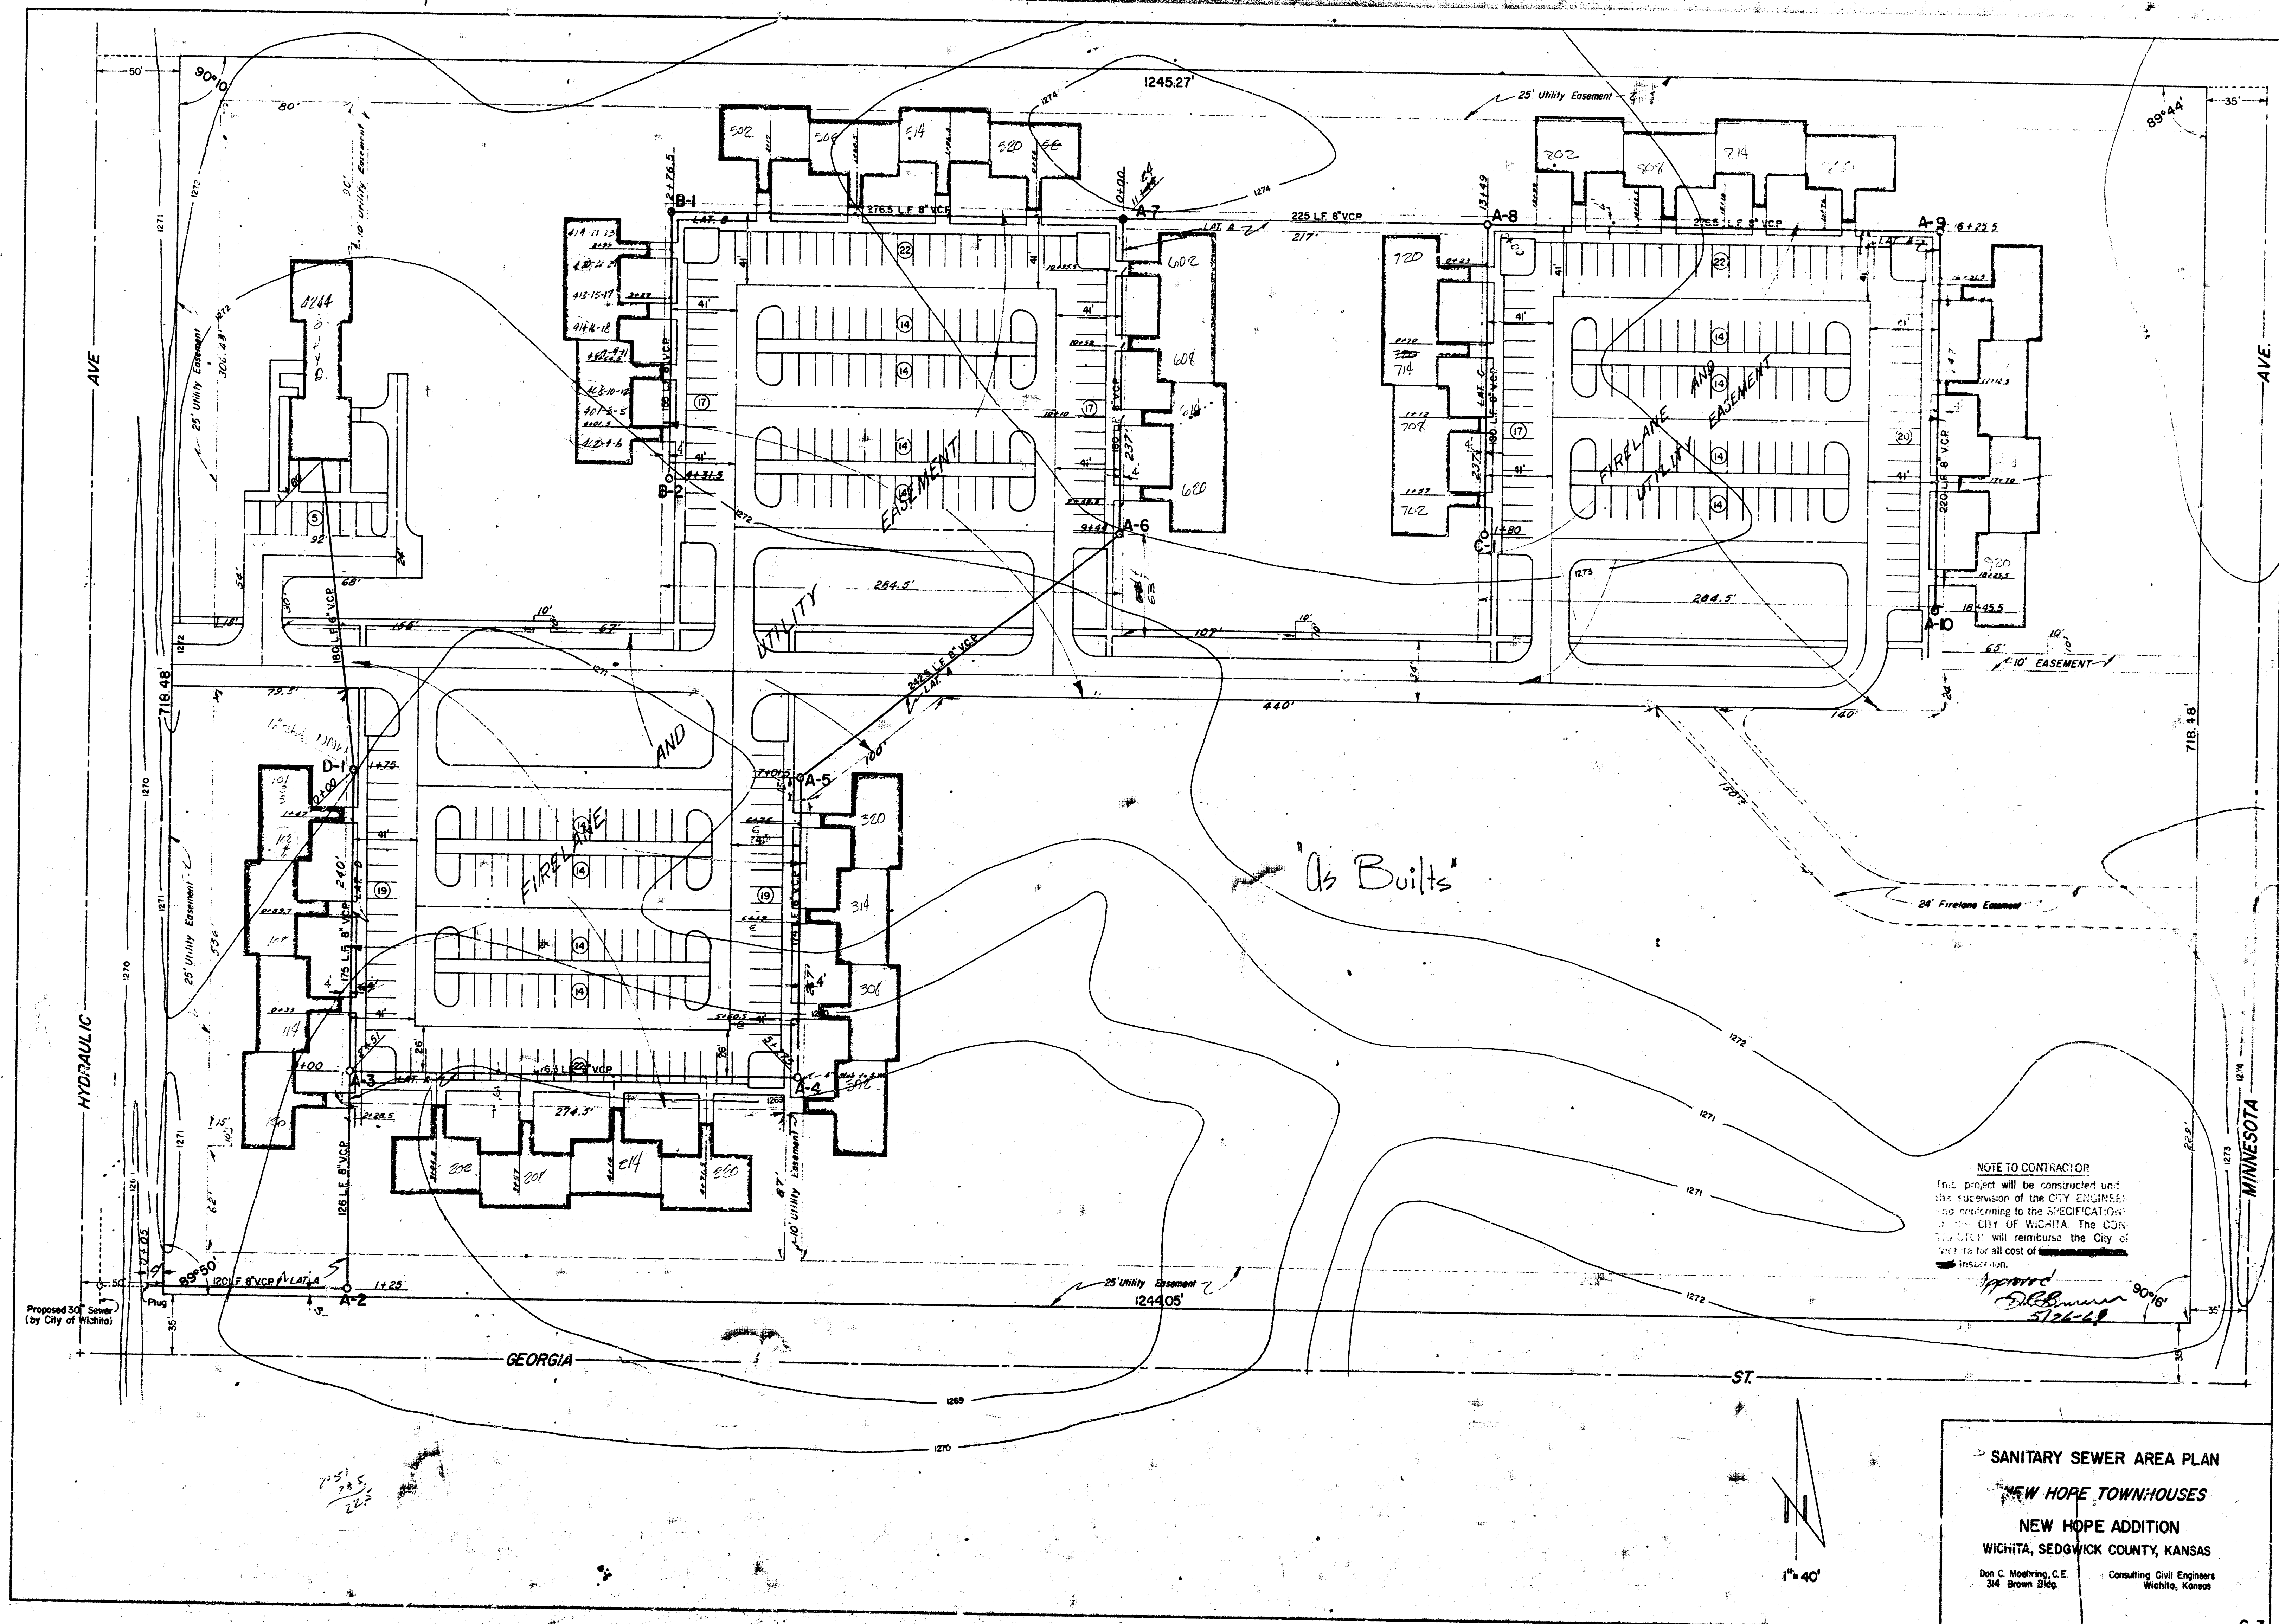


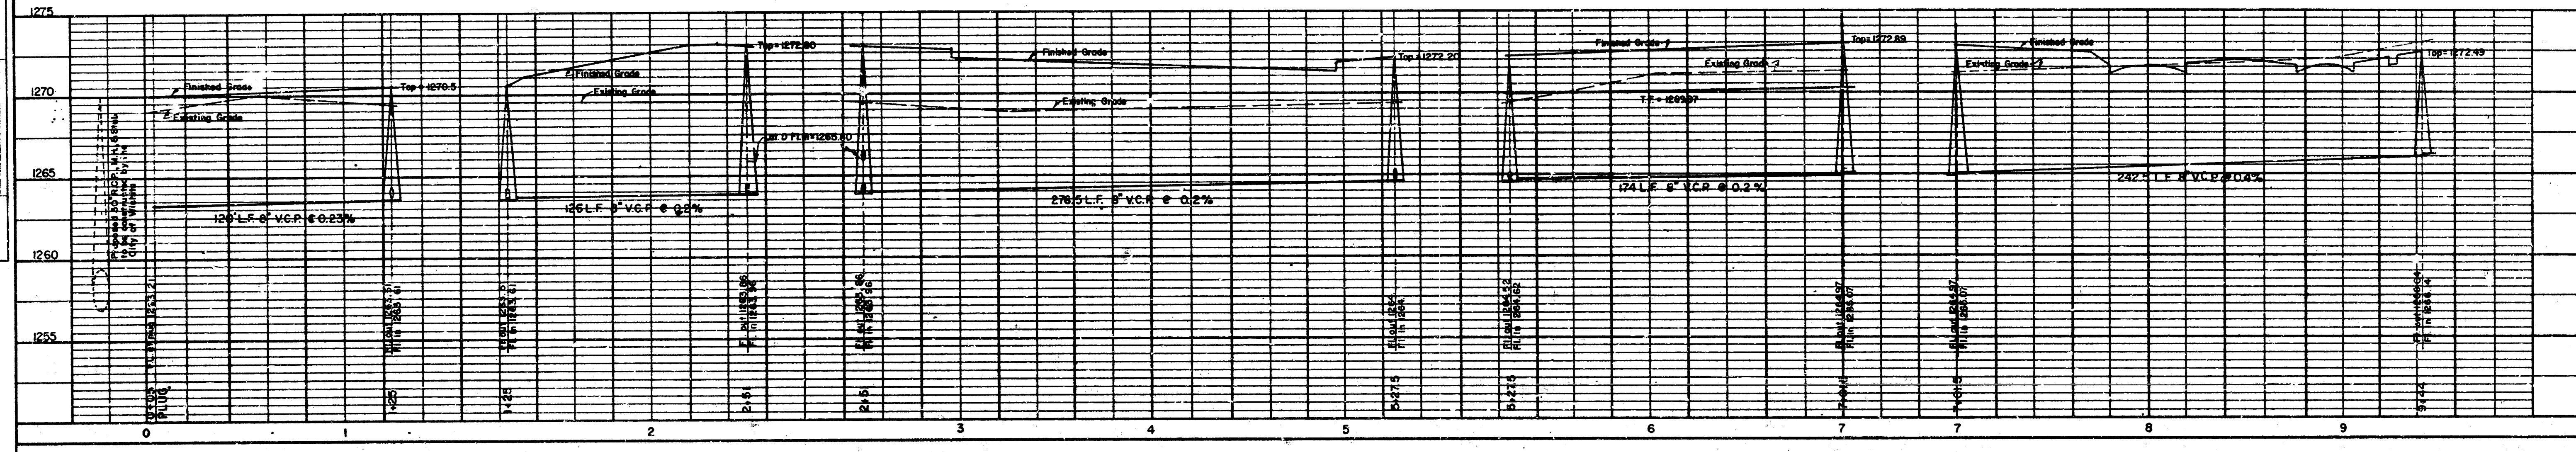

PLAN
 DATE: _____ BY: _____
 CHECKED: _____
 NOTE: BOOK NO. OF WAY CHECKED

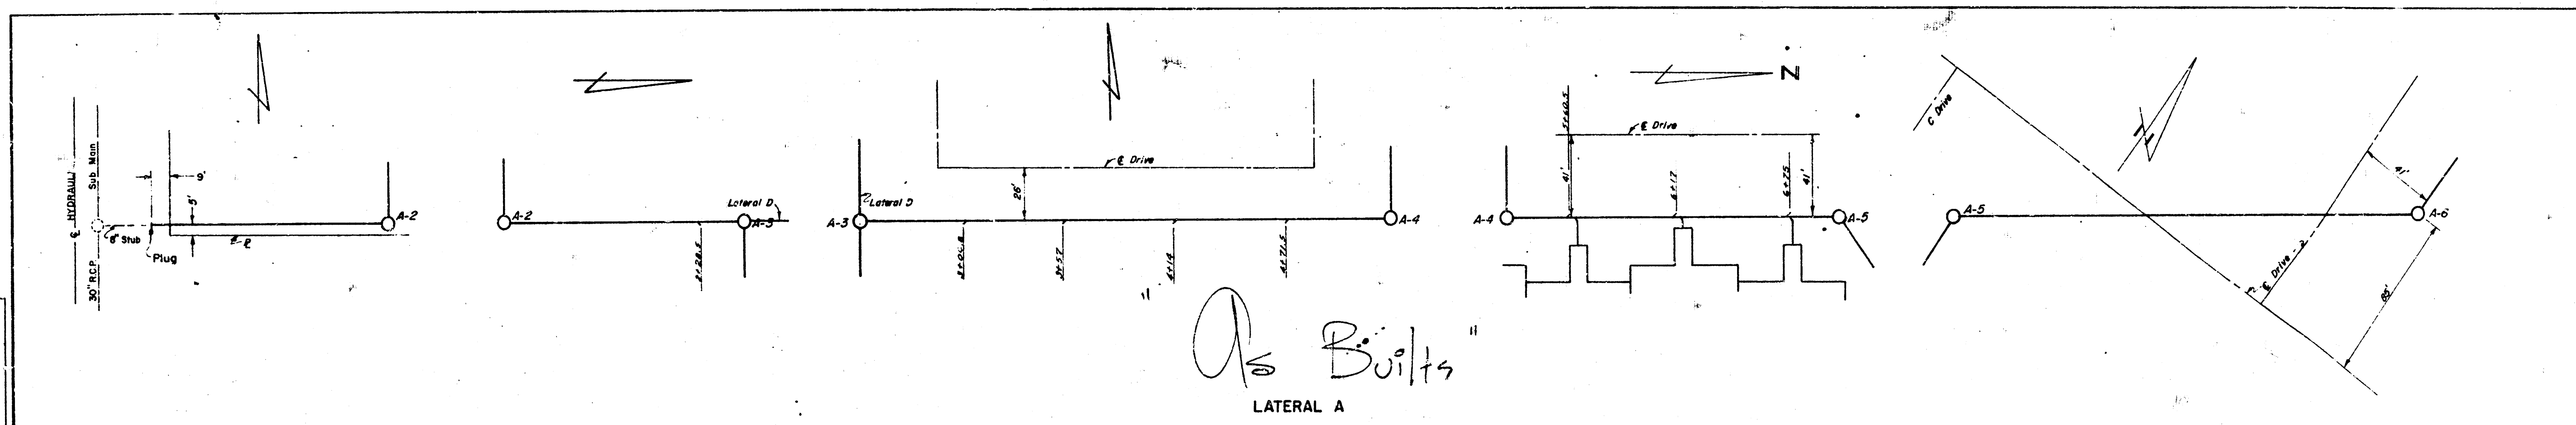


PROFILE
 DATE: _____ BY: _____
 CHECKED: _____
 NOTE: BOOK NO. OF WAY CHECKED

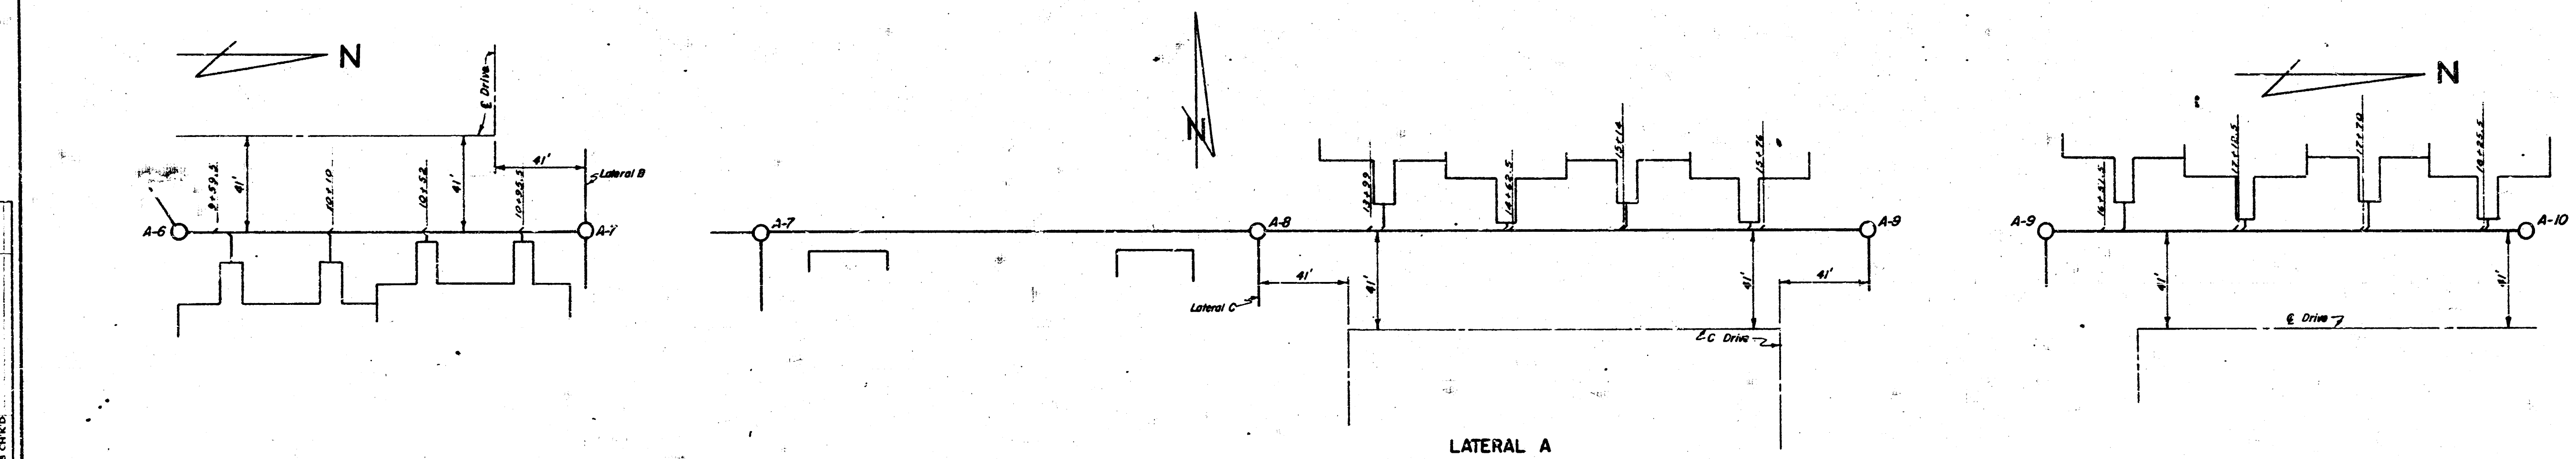


Approved
[Signature]
 5-21-67

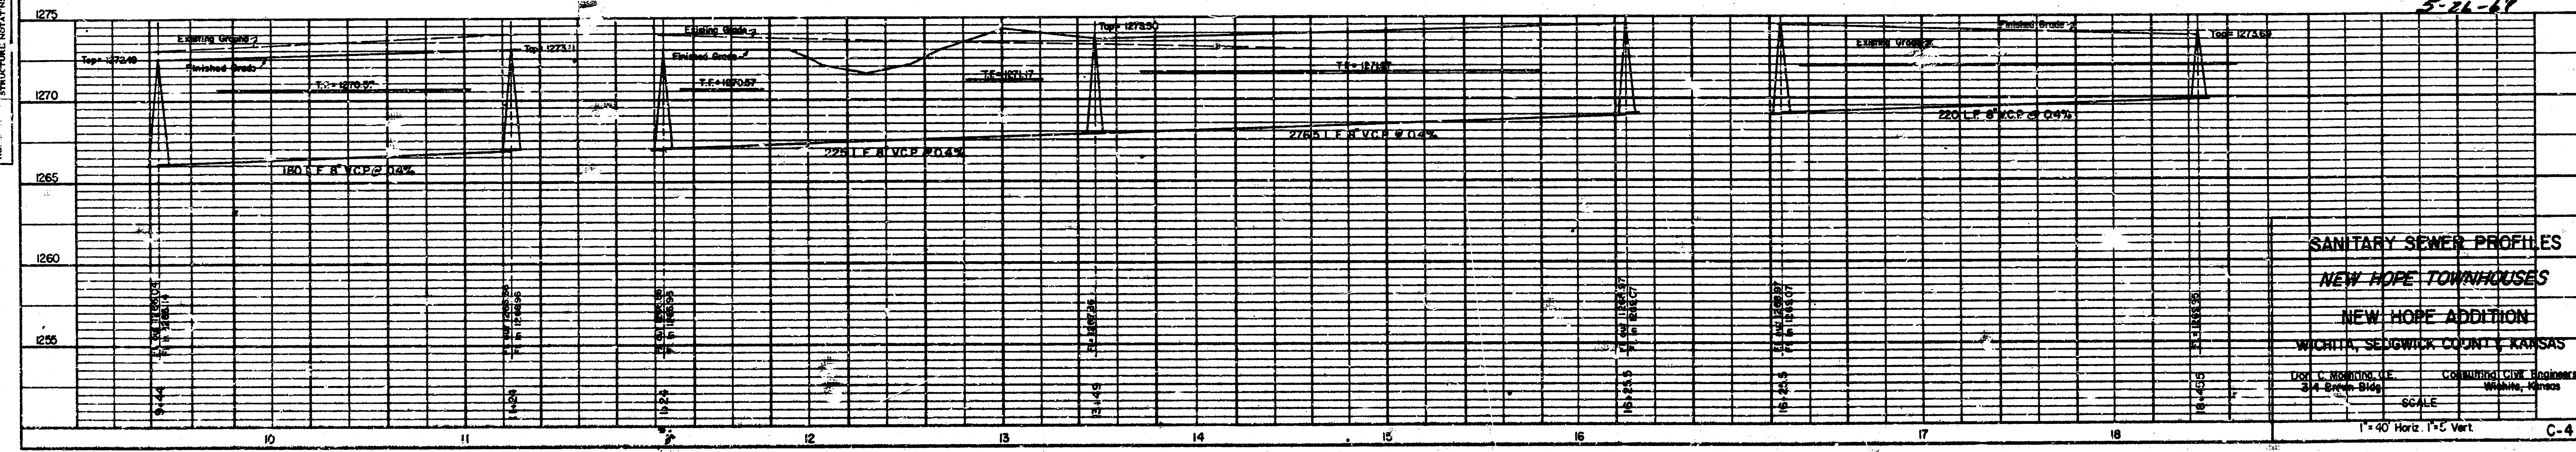

SANITARY SEWER PROFILES
 NEW HOPE TOWNHOUSES
 NEW HOPE ADDITION
 WICHITA, SEDGWICK COUNTY, KANSAS
 WICHITA, KANSAS
 SCALE
 1" = 40' Horiz. 1" = 5' Vert.
 C-4














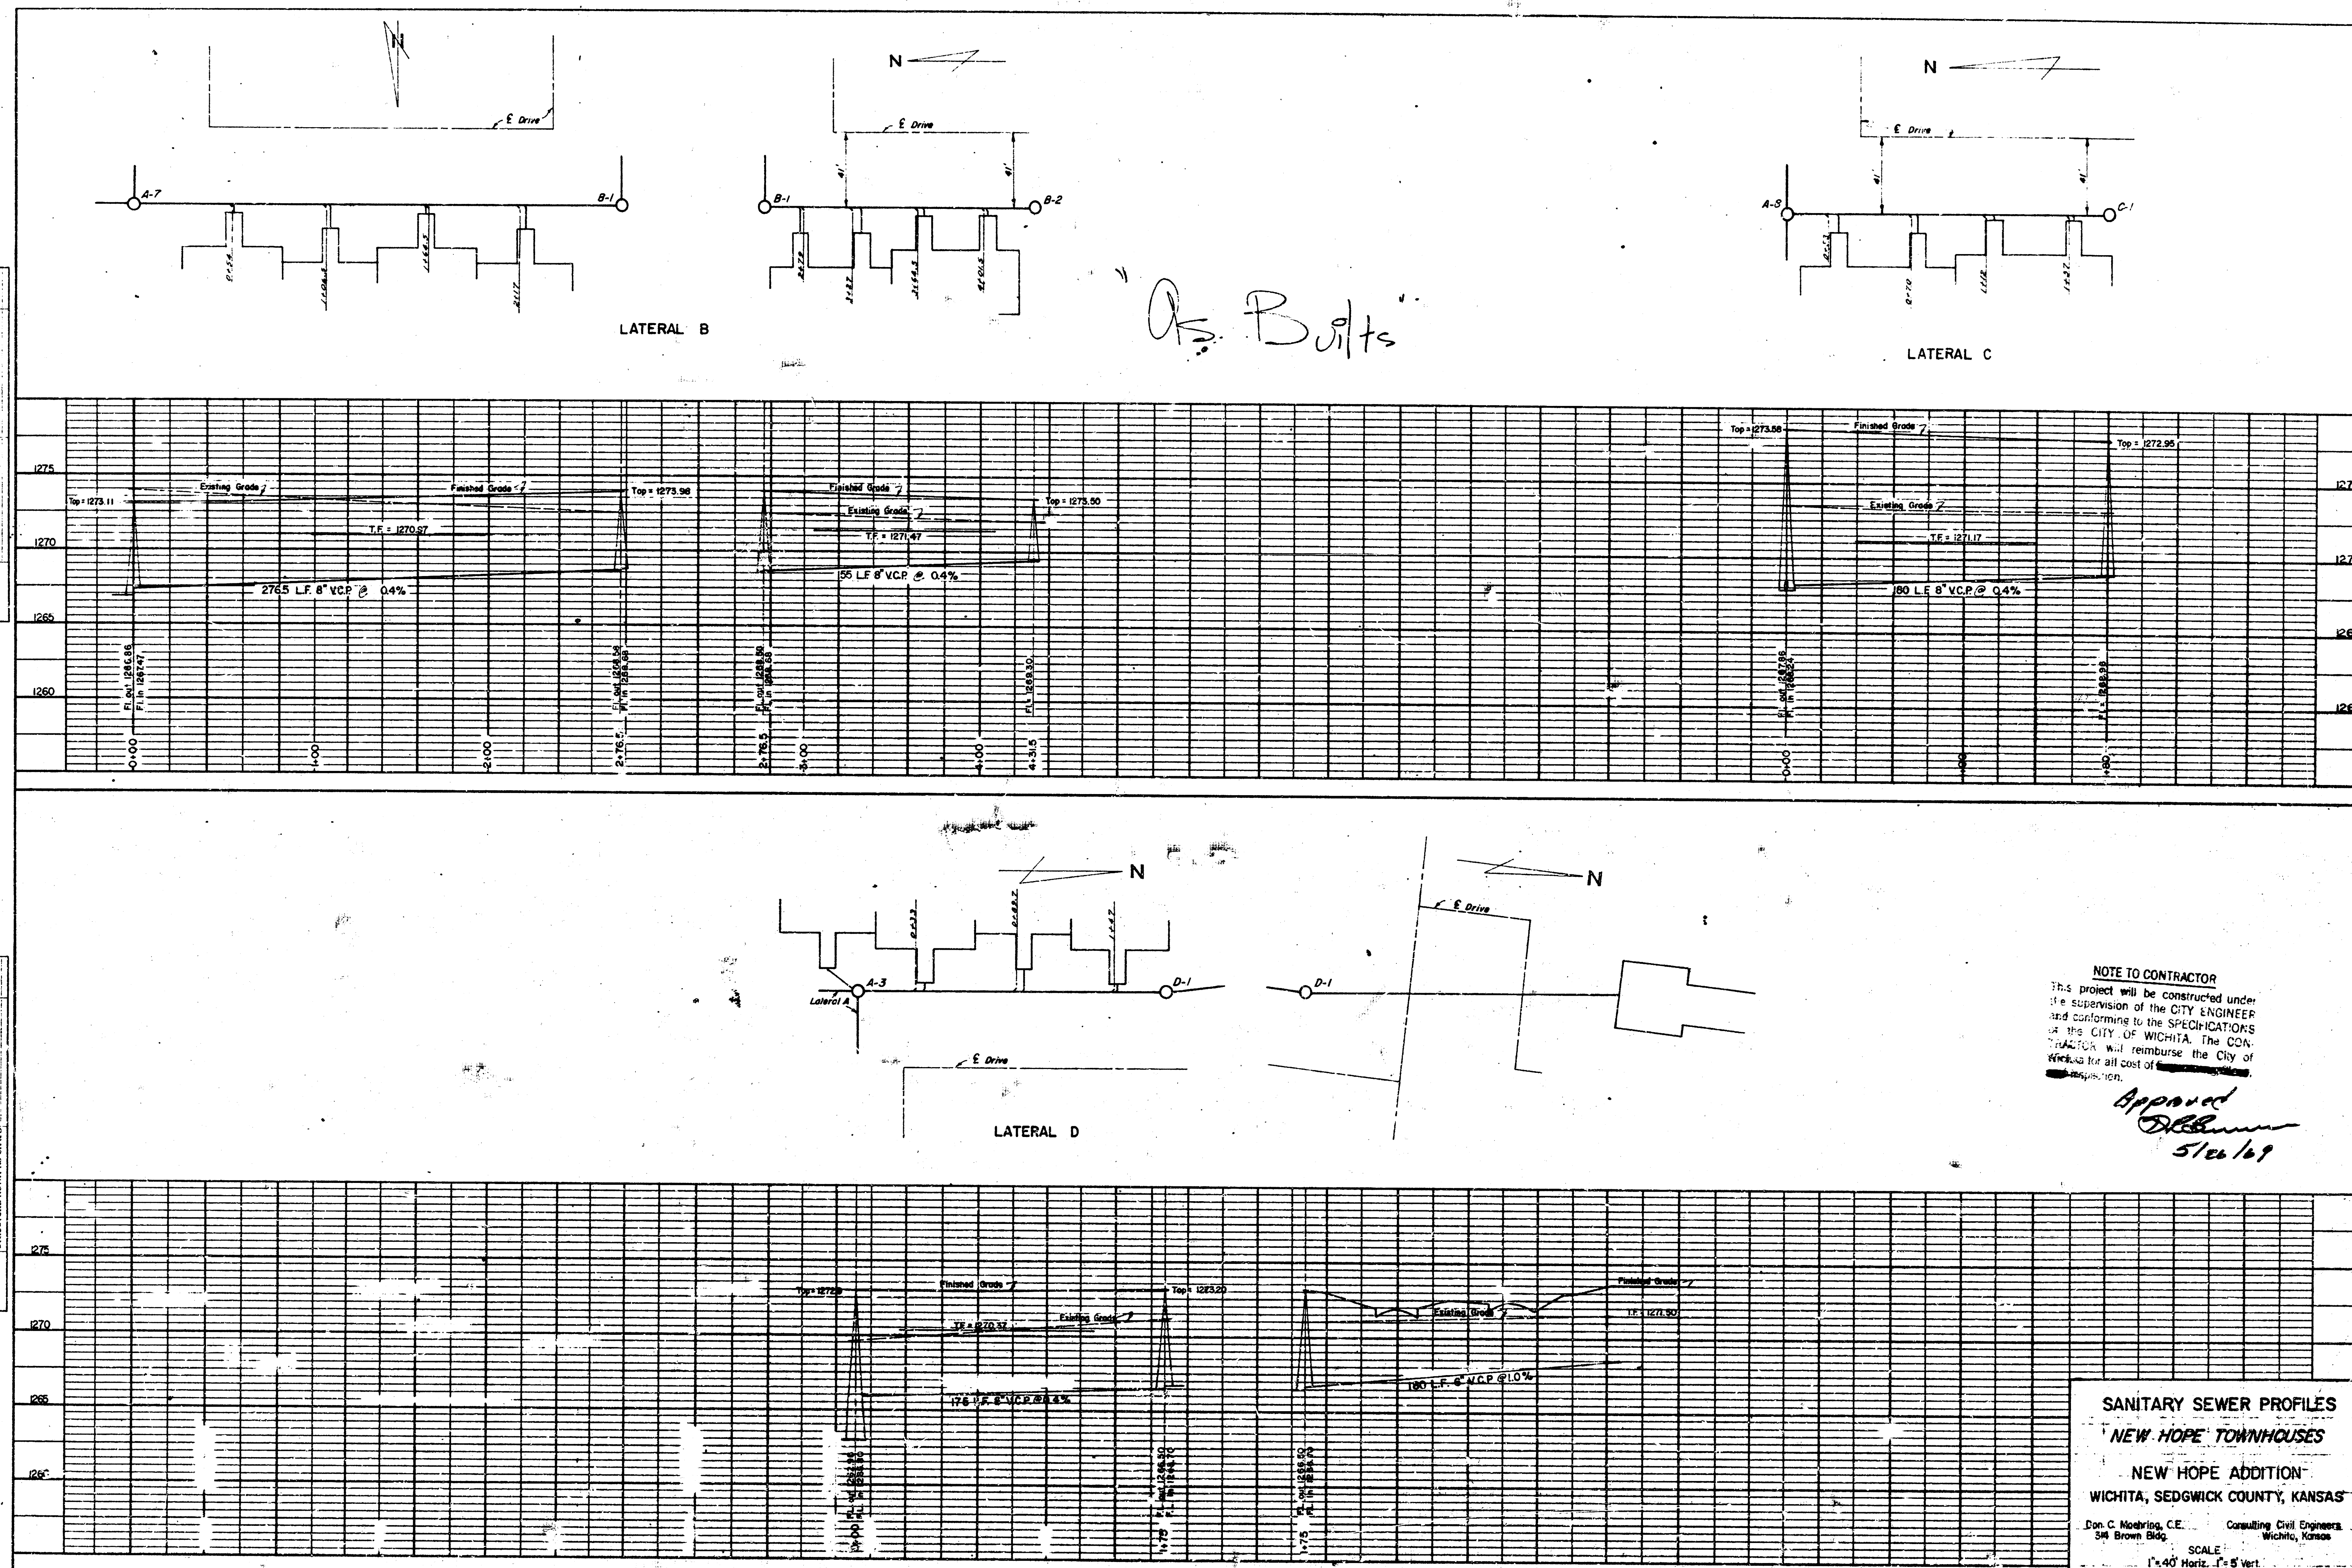


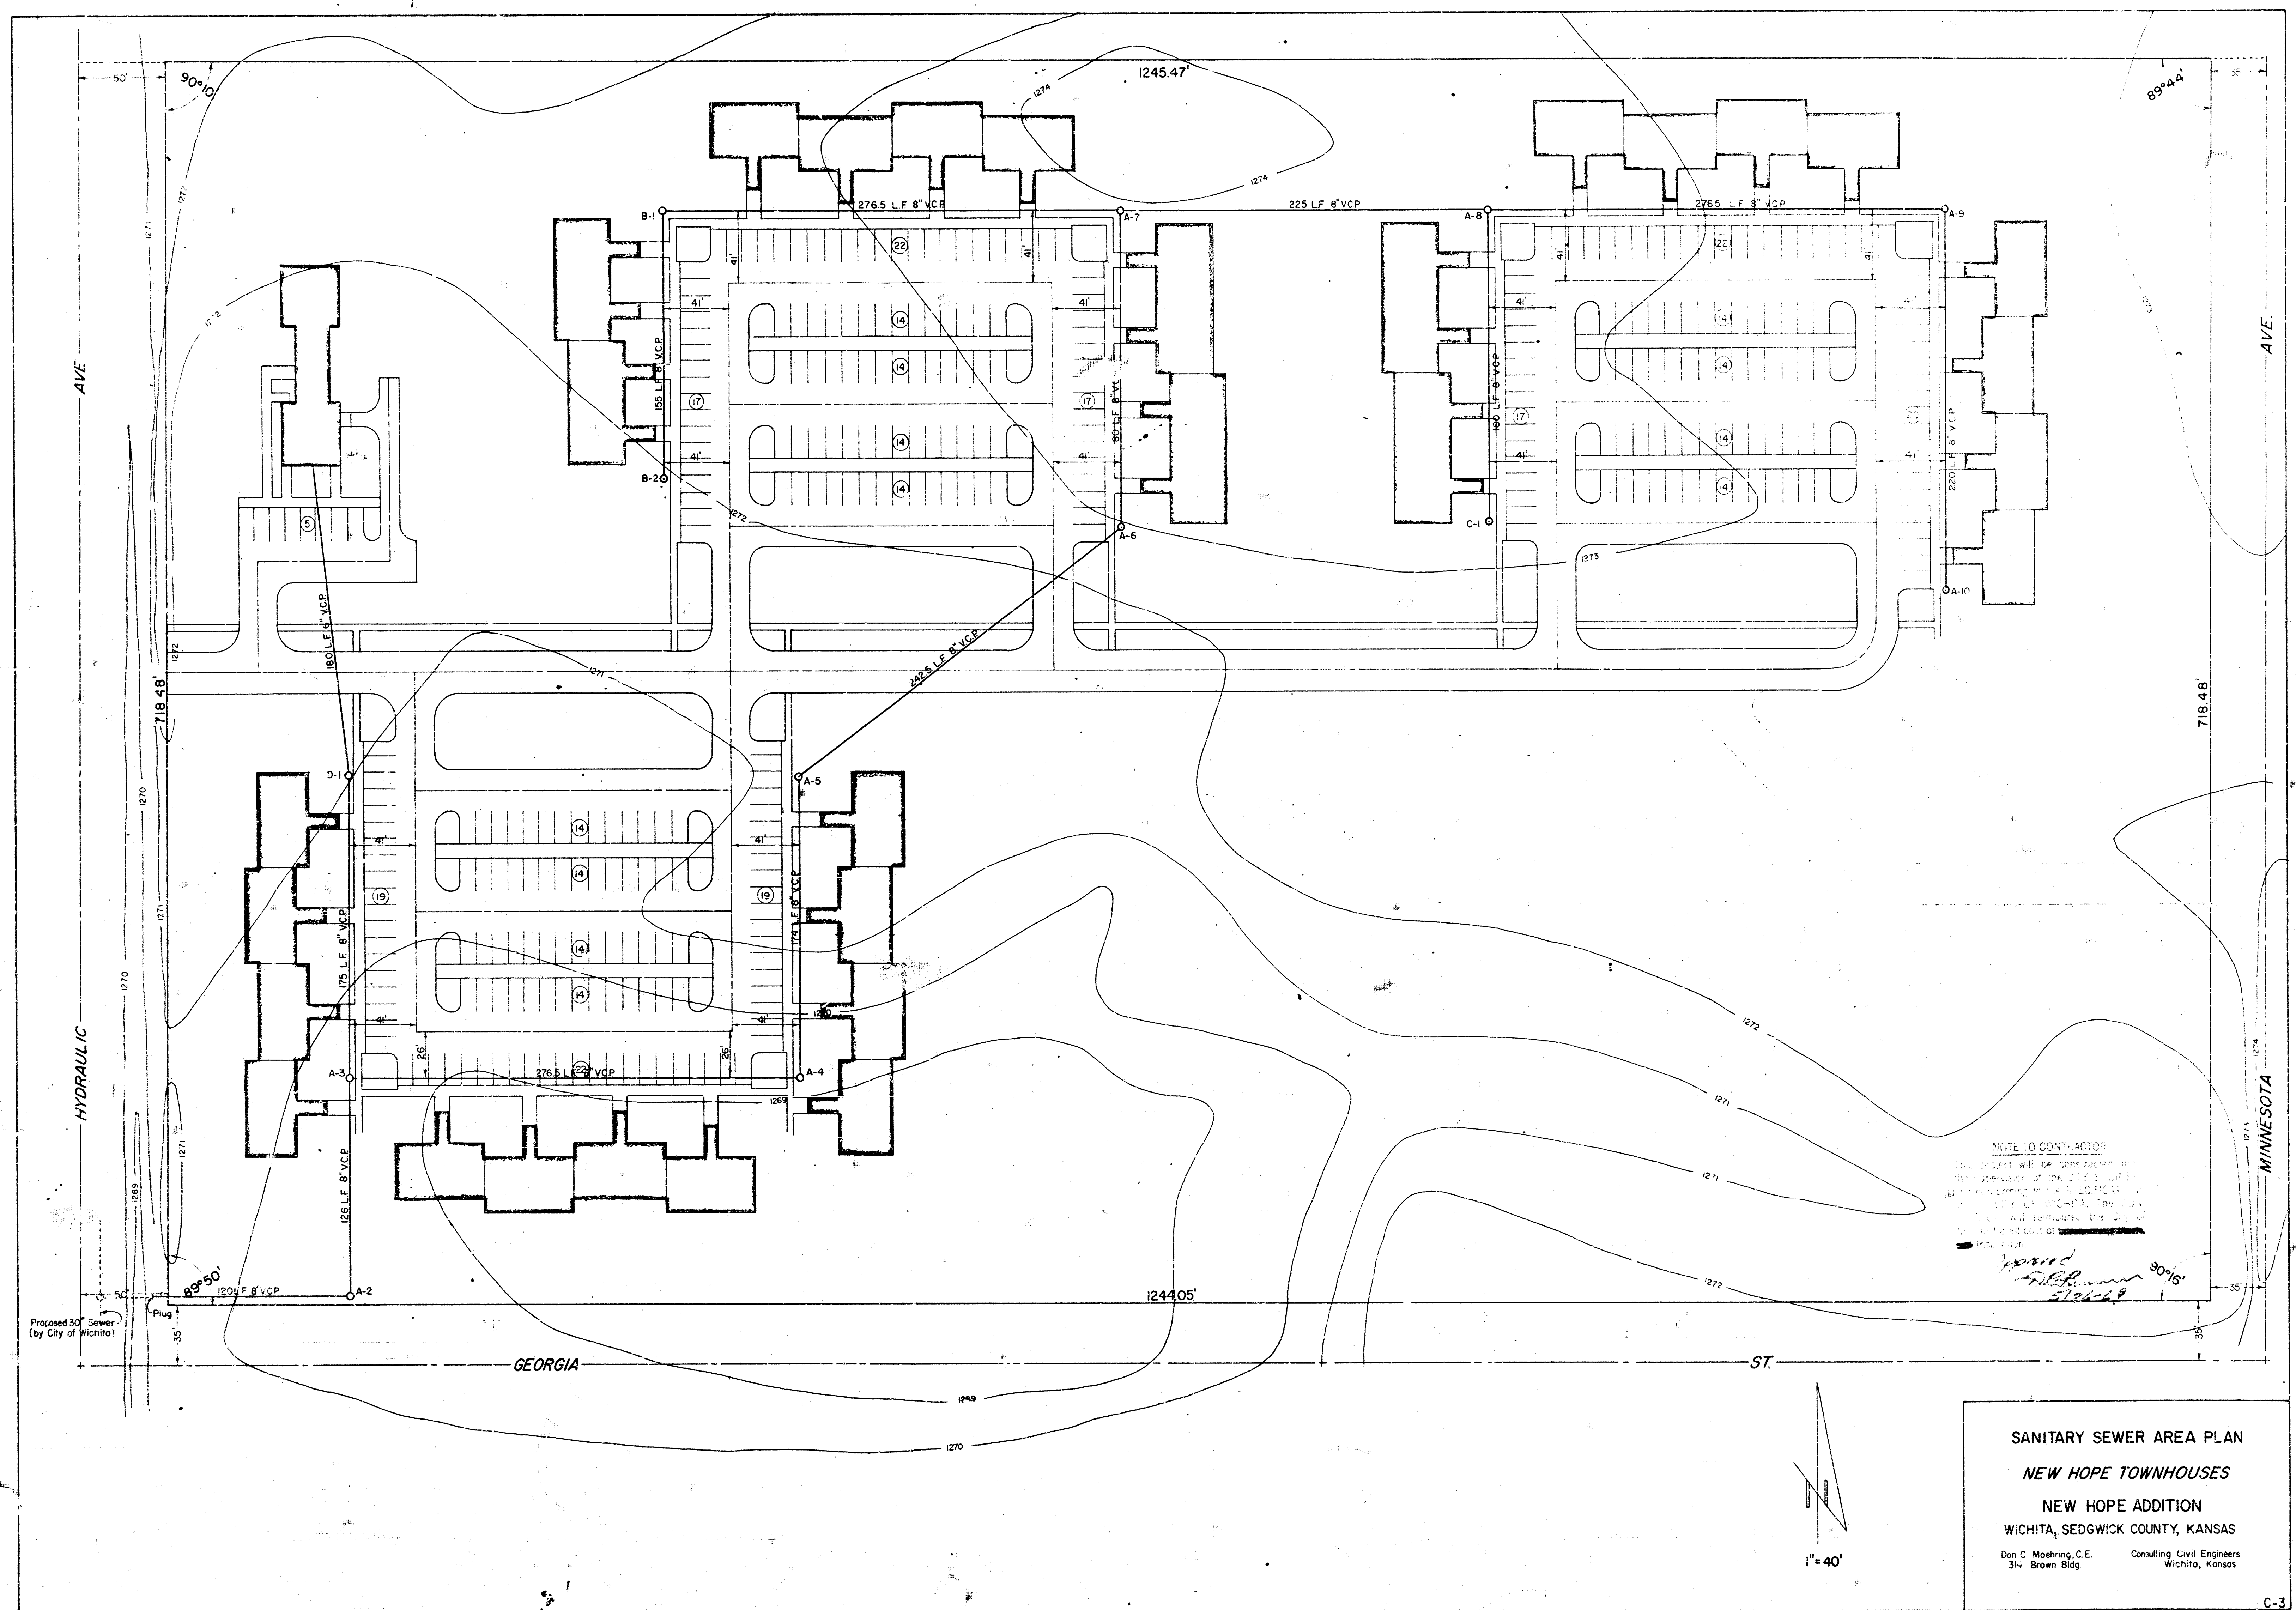


PLAN
 SANITARY SEWER
 NEW HOPE TOWNHOUSES
 NEW HOPE ADDITION
 WICHITA, SEDGWICK COUNTY, KANSAS

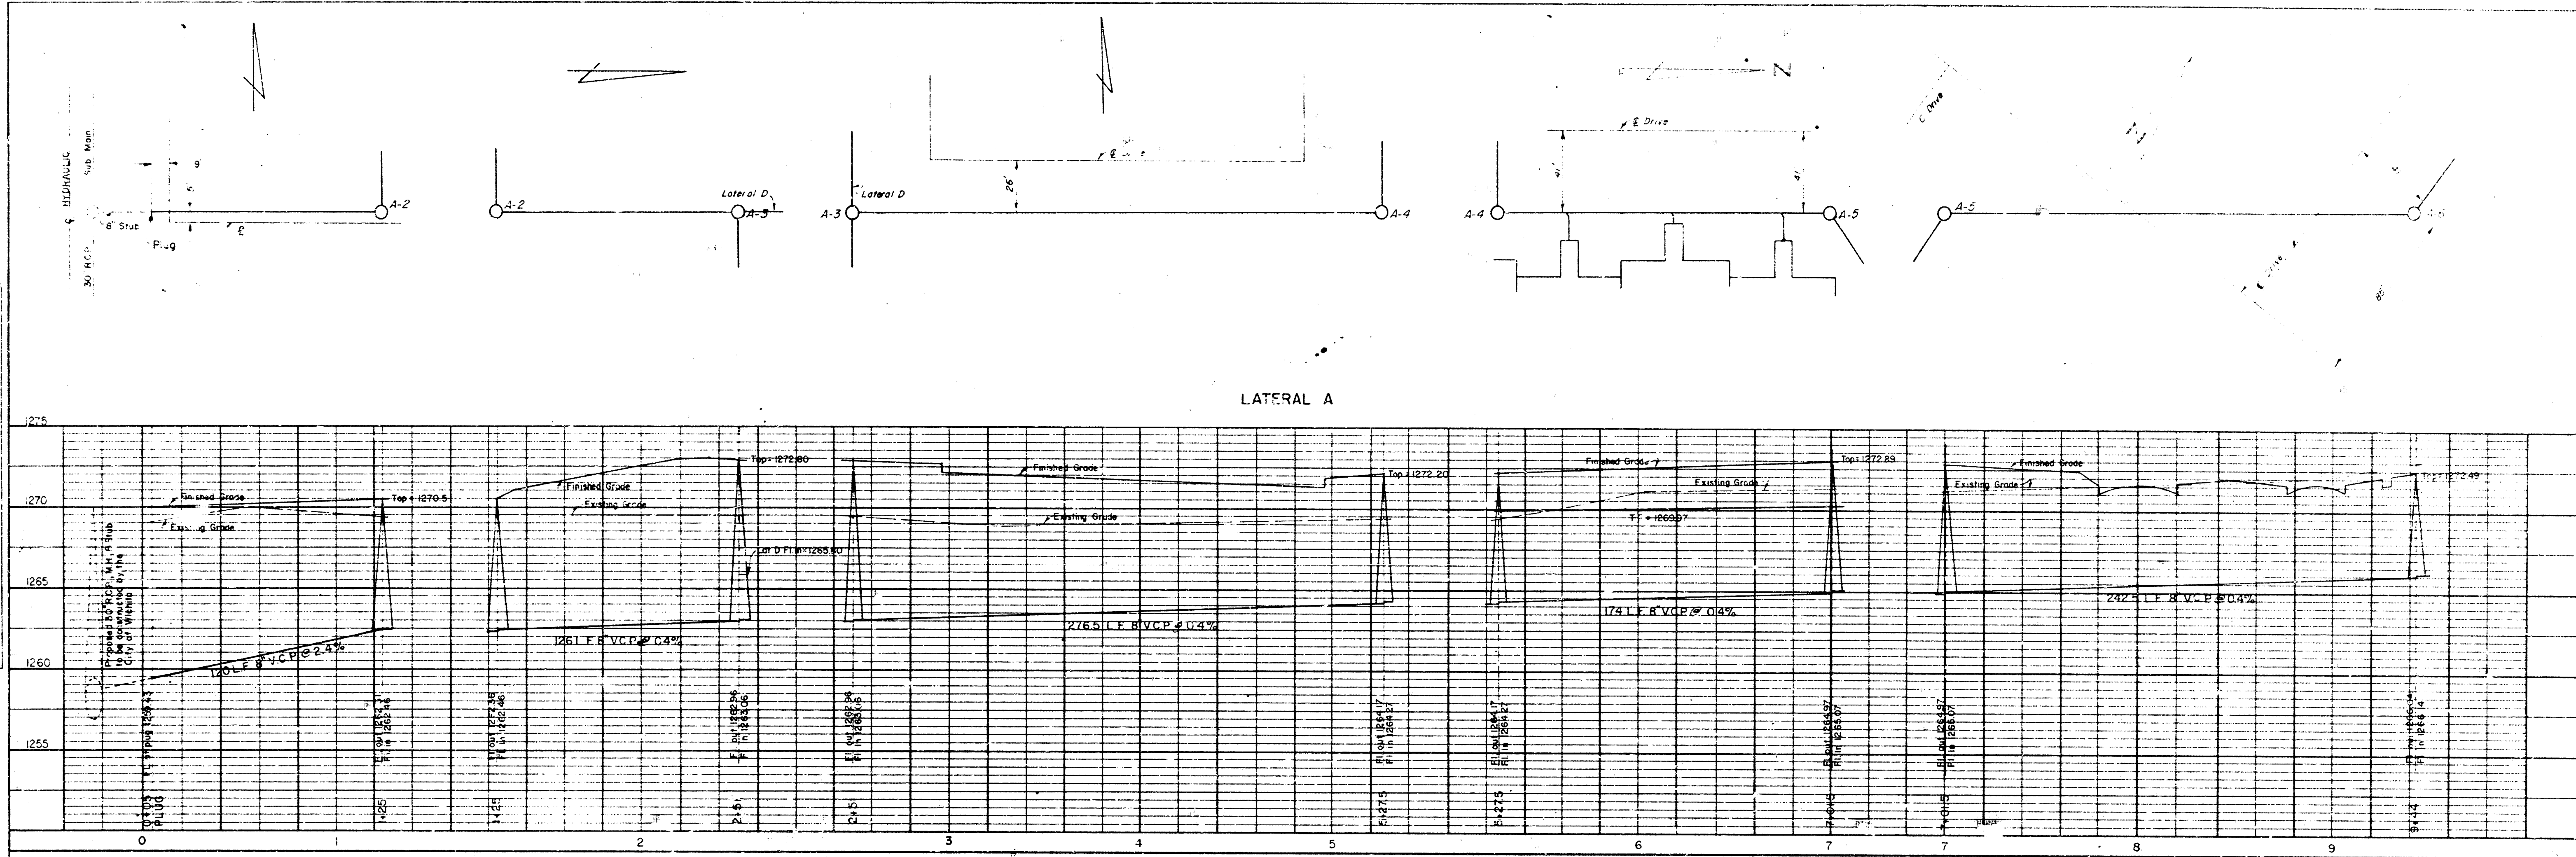


PROFILE
 SANITARY SEWER
 NEW HOPE TOWNHOUSES
 NEW HOPE ADDITION
 WICHITA, SEDGWICK COUNTY, KANSAS

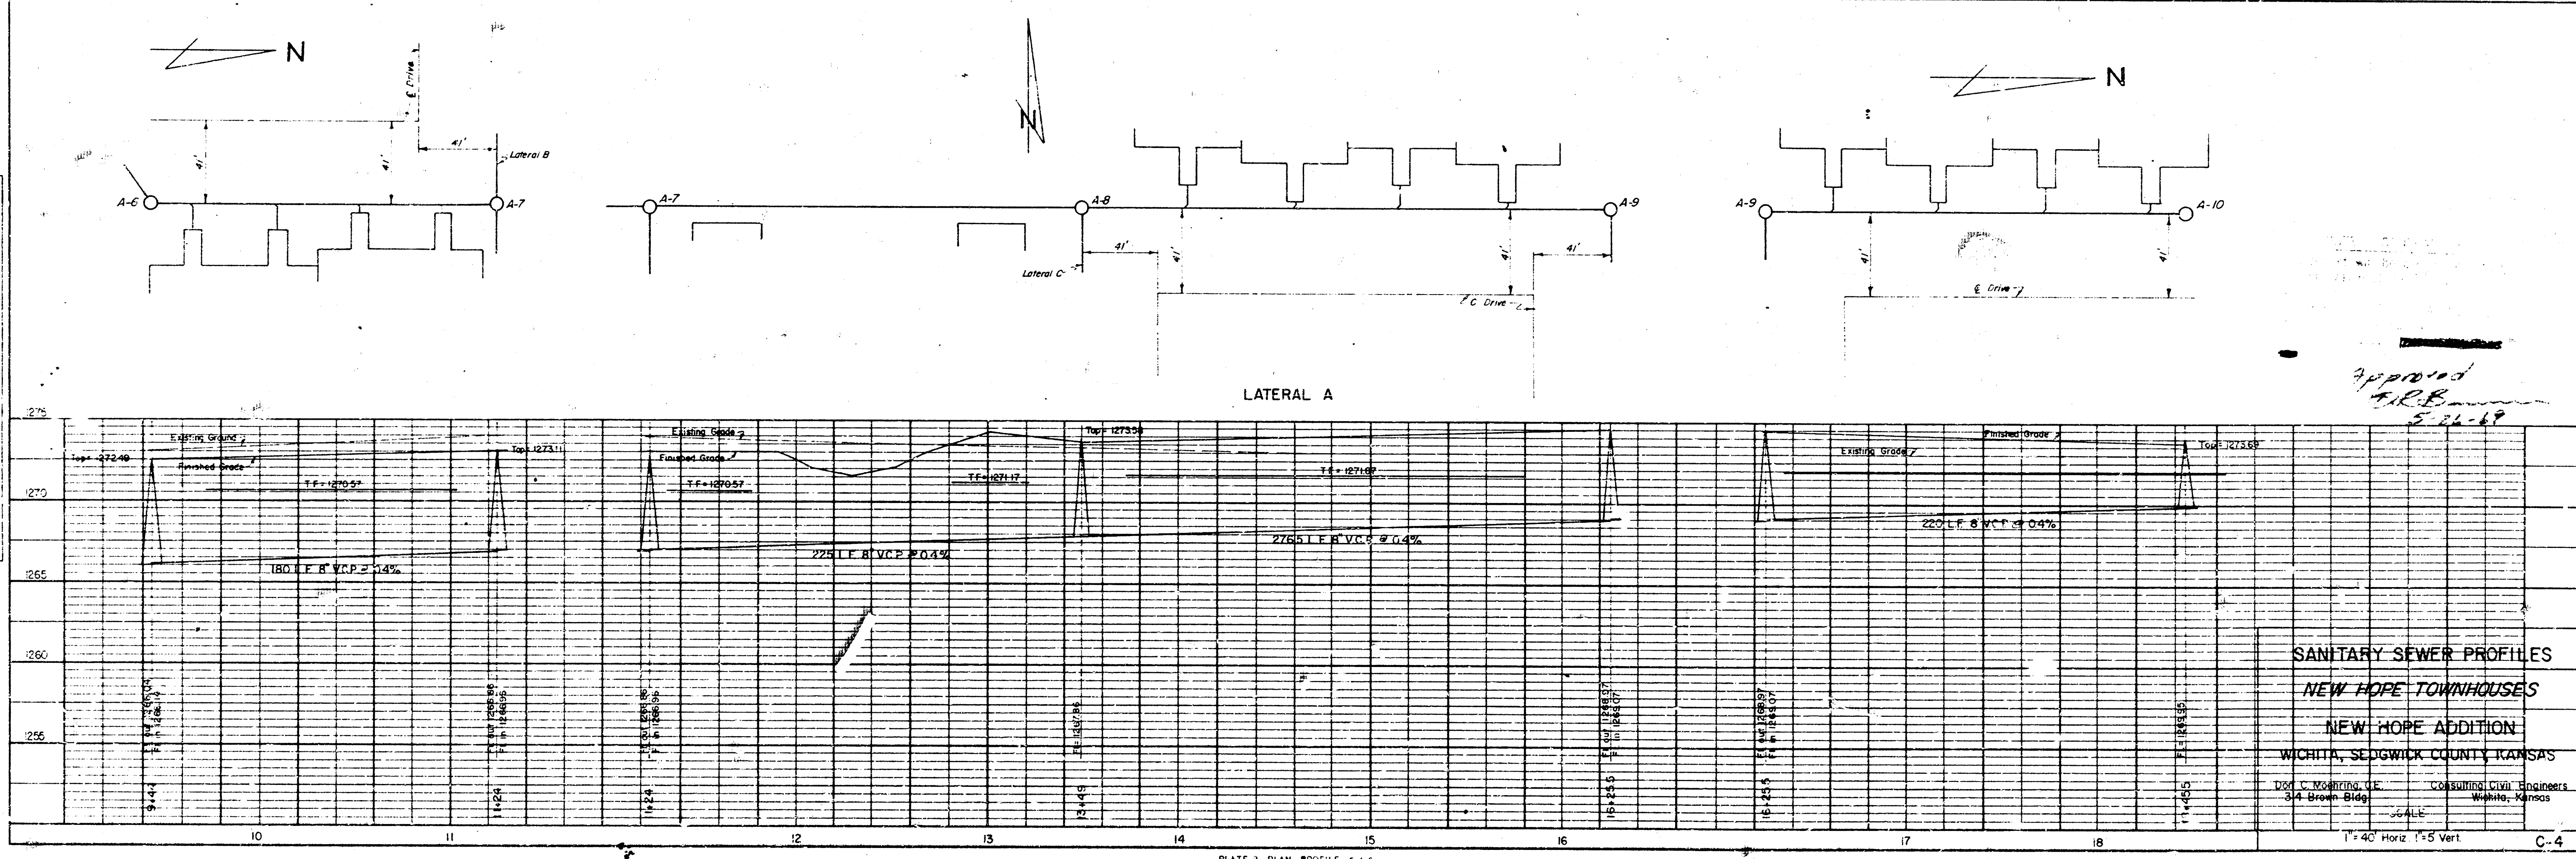


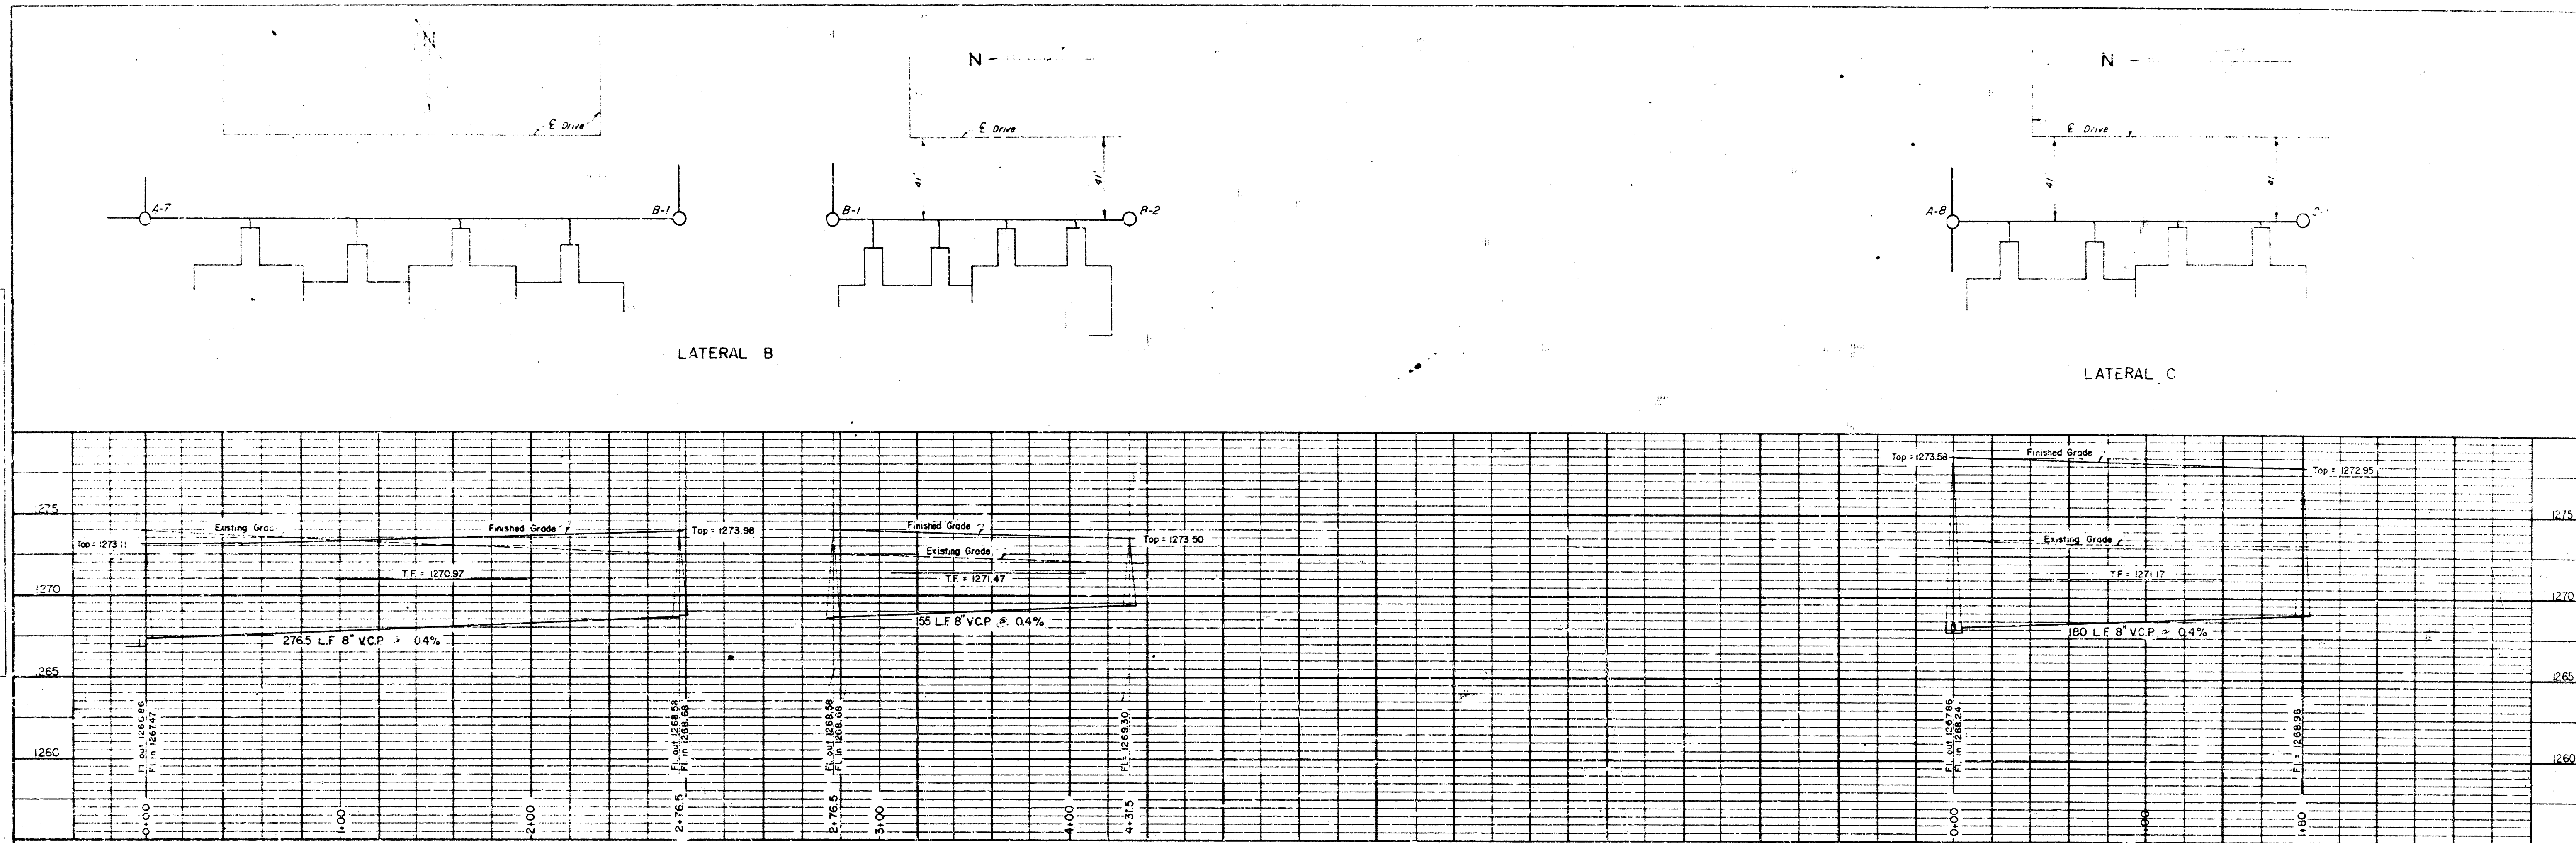


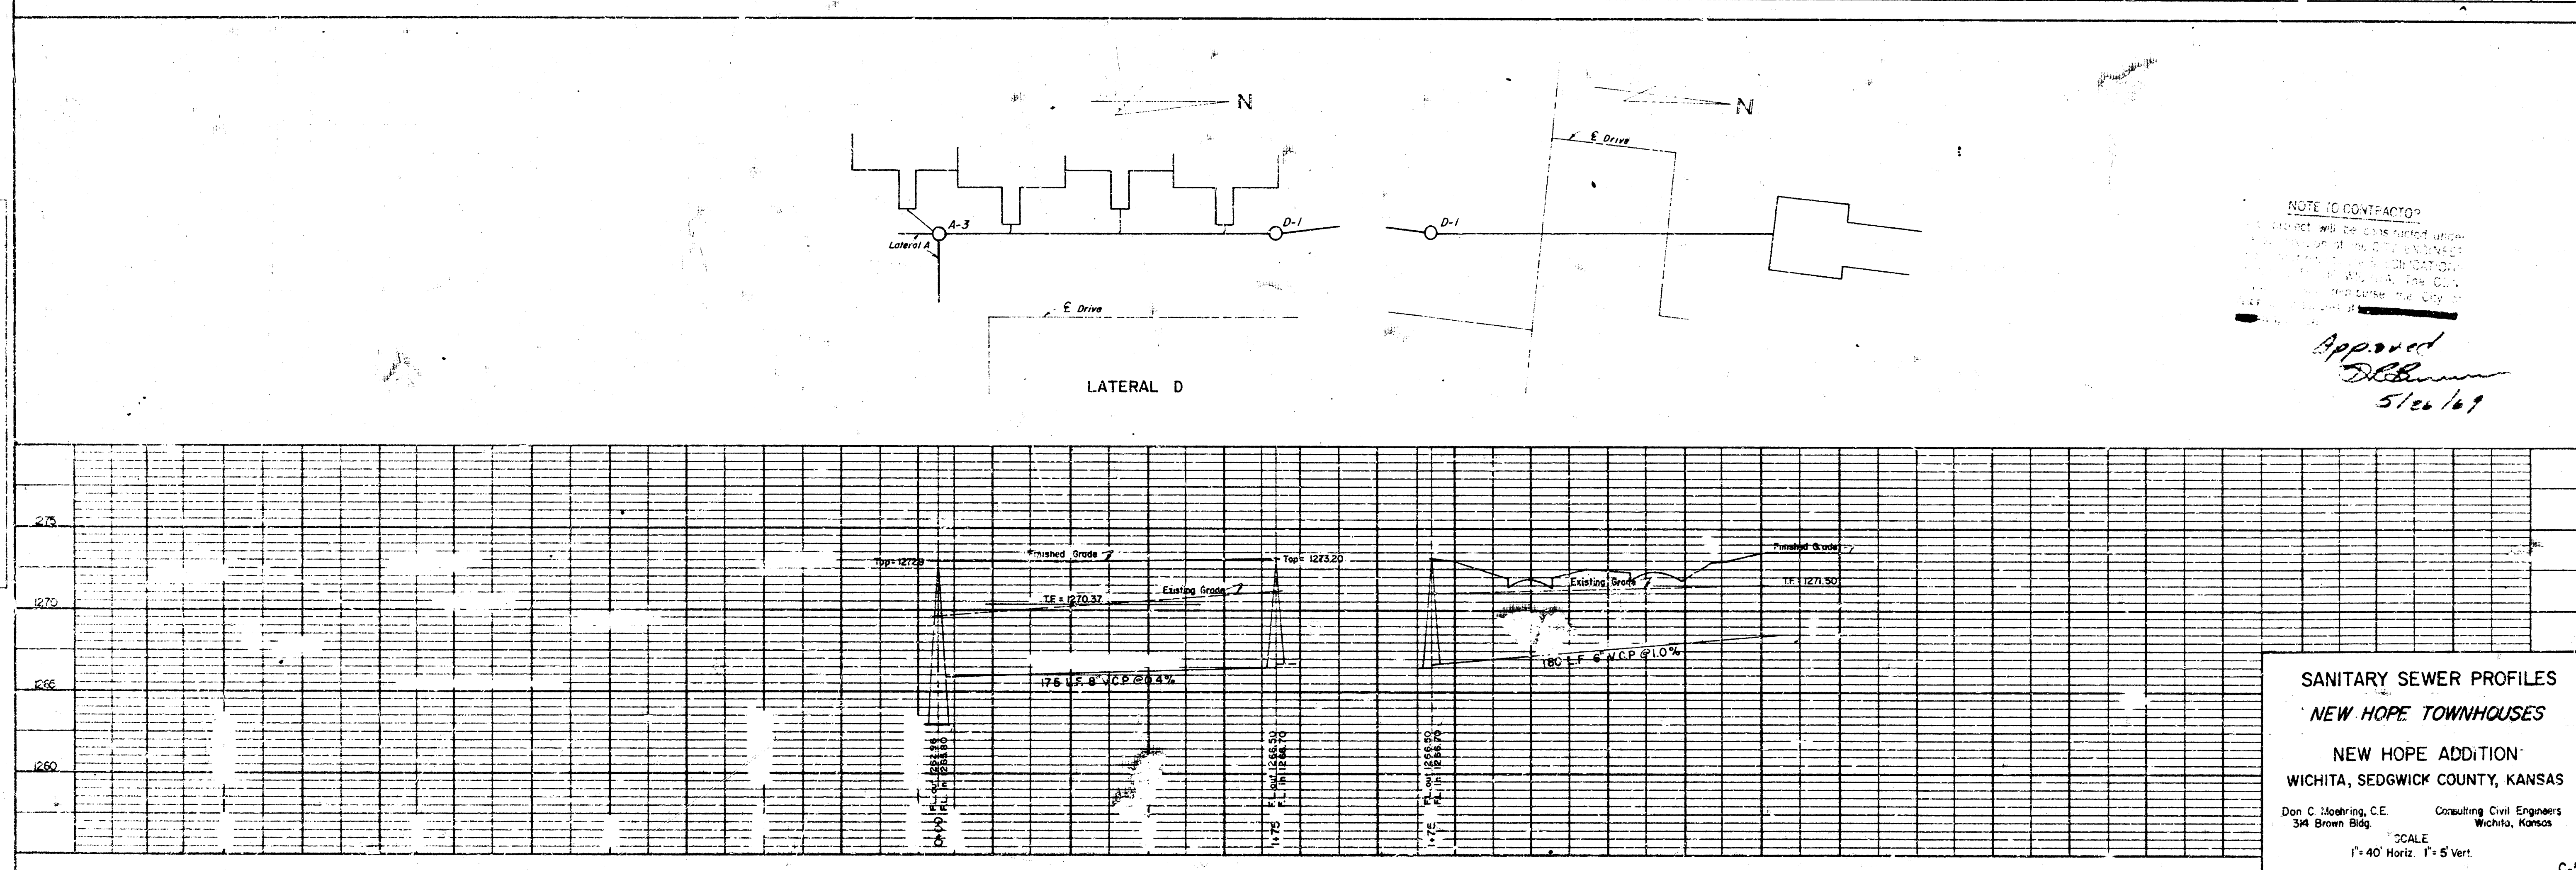

NOTE TO CONTRACTOR:
APPROVED

SANITARY SEWER PROFILES
NEW HOPE TOWNHOUSES
NEW HOPE ADDITION
WICHITA, SEDGWICK COUNTY, KANSAS
Don C. Mooring, C.E. Consulting Civil Engineers
314 Brown Bldg. Wichita, Kansas