
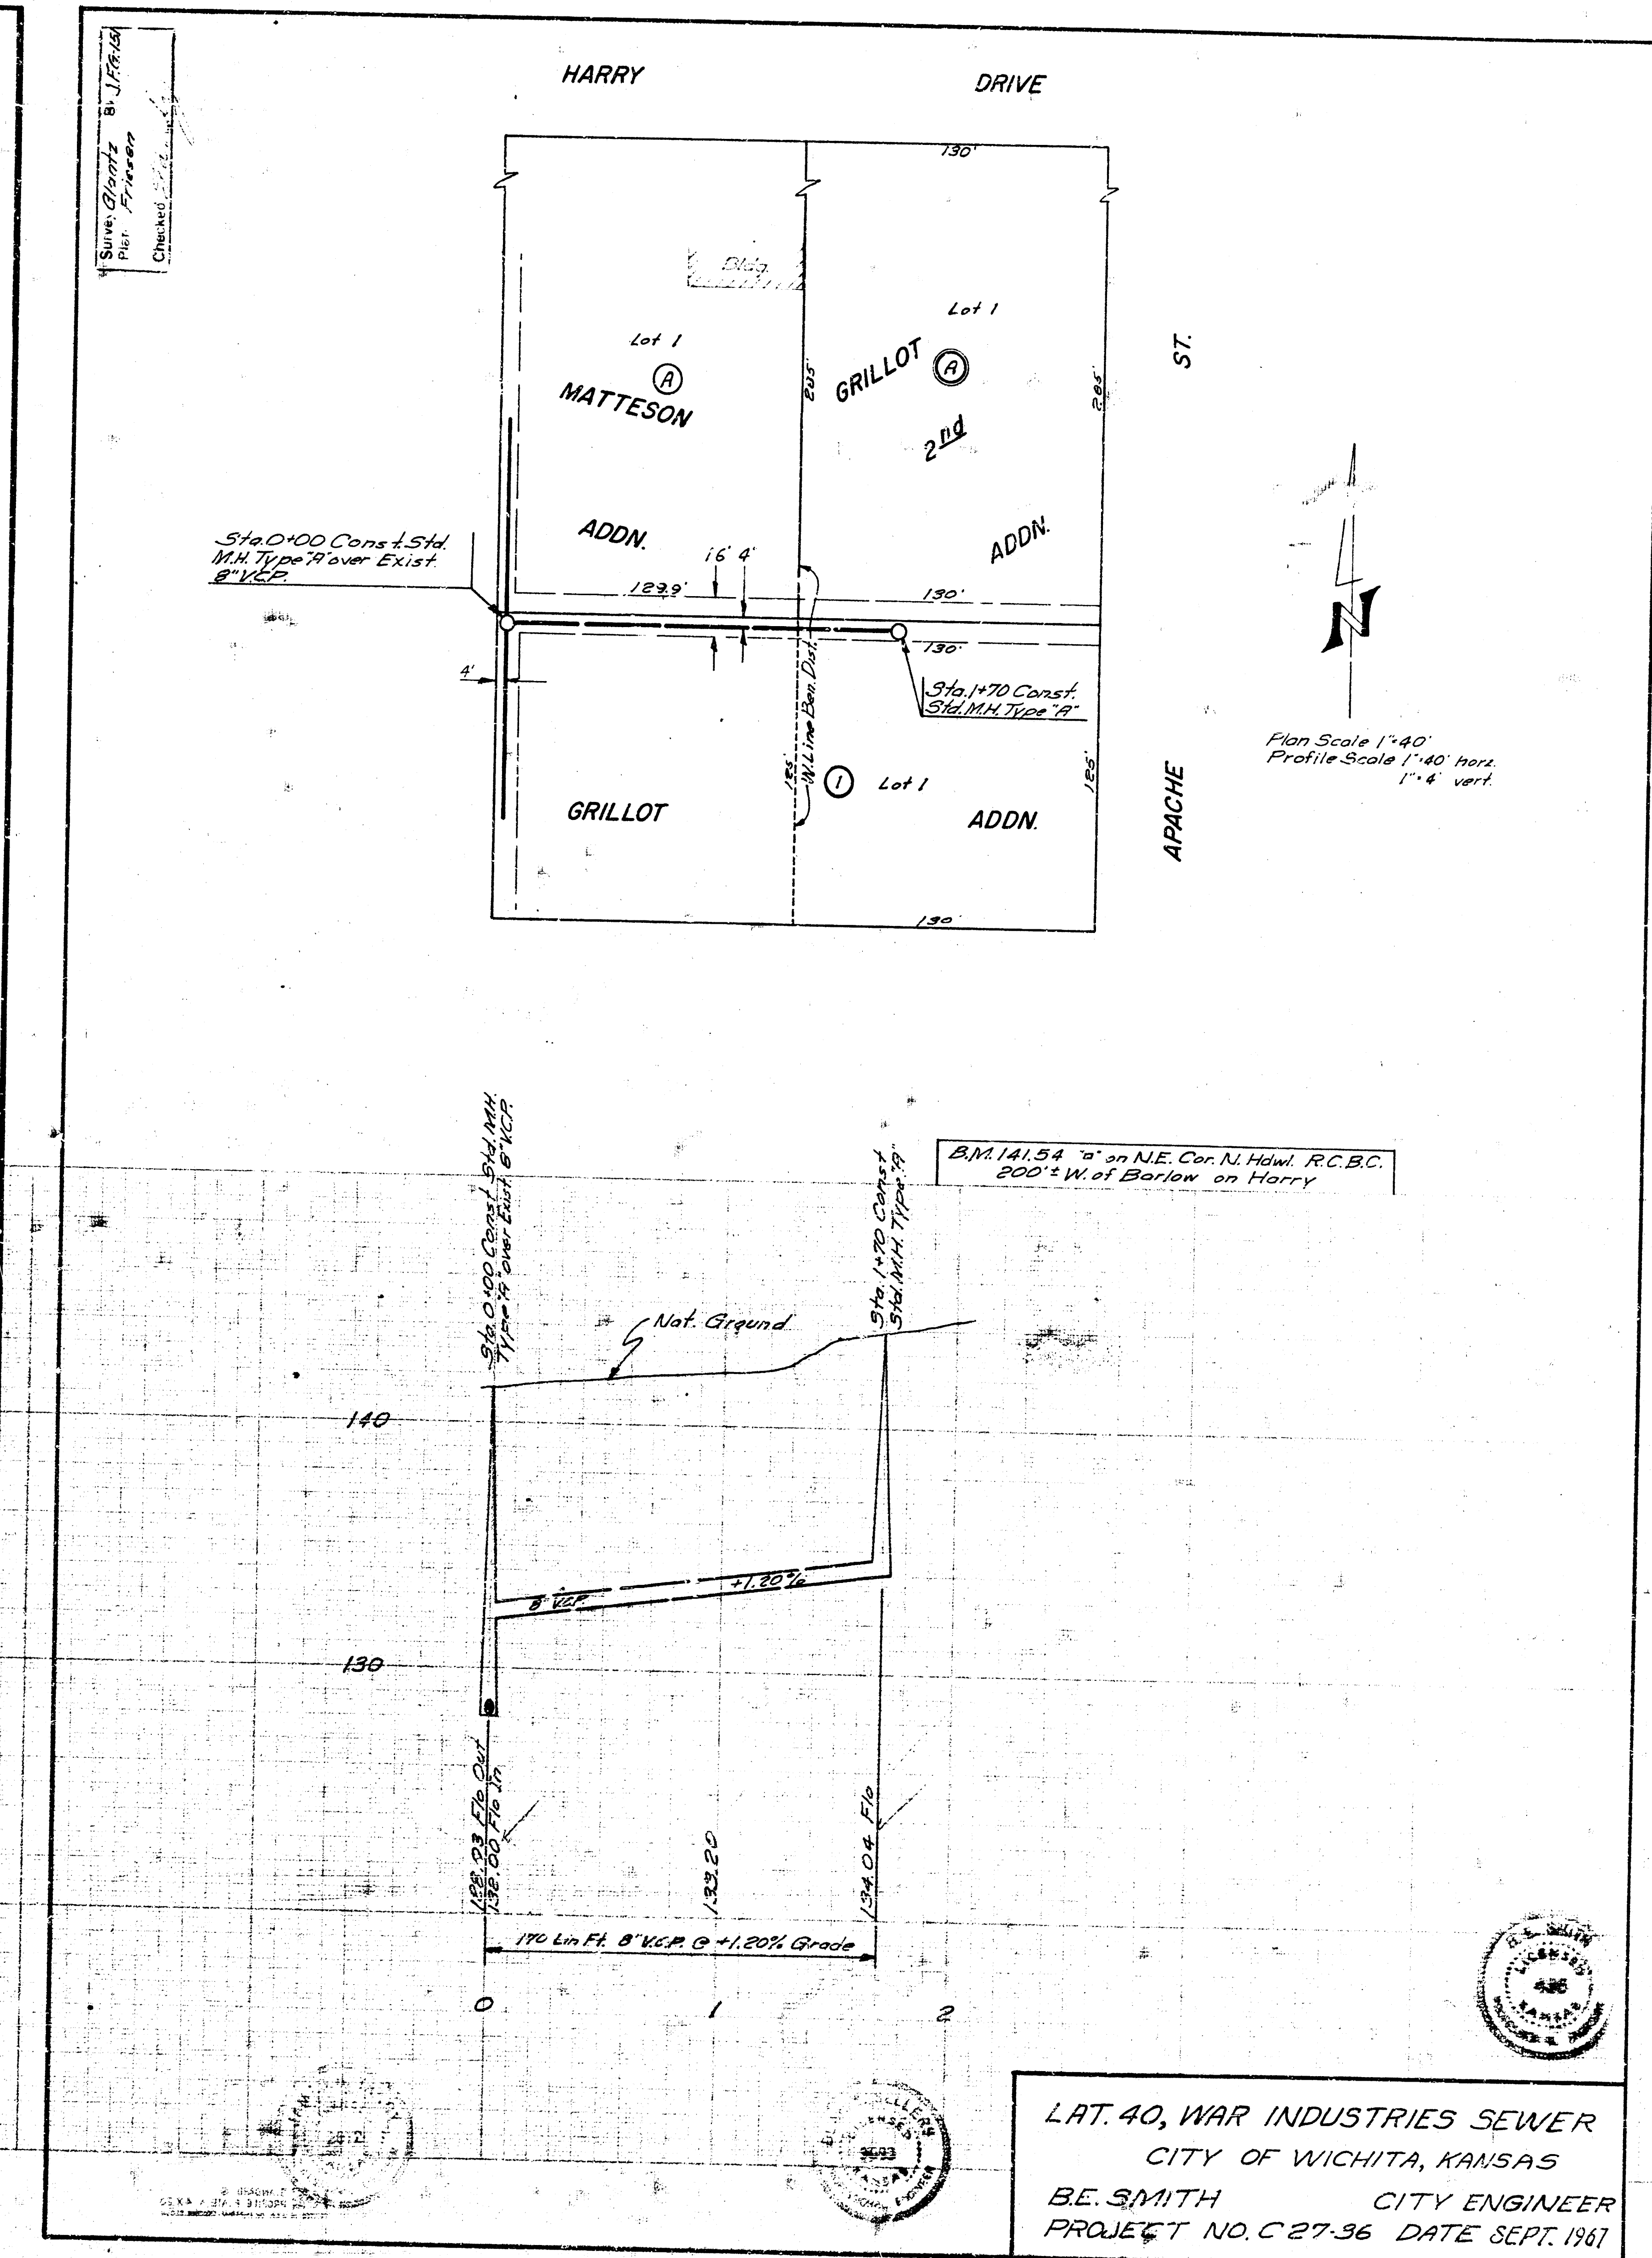
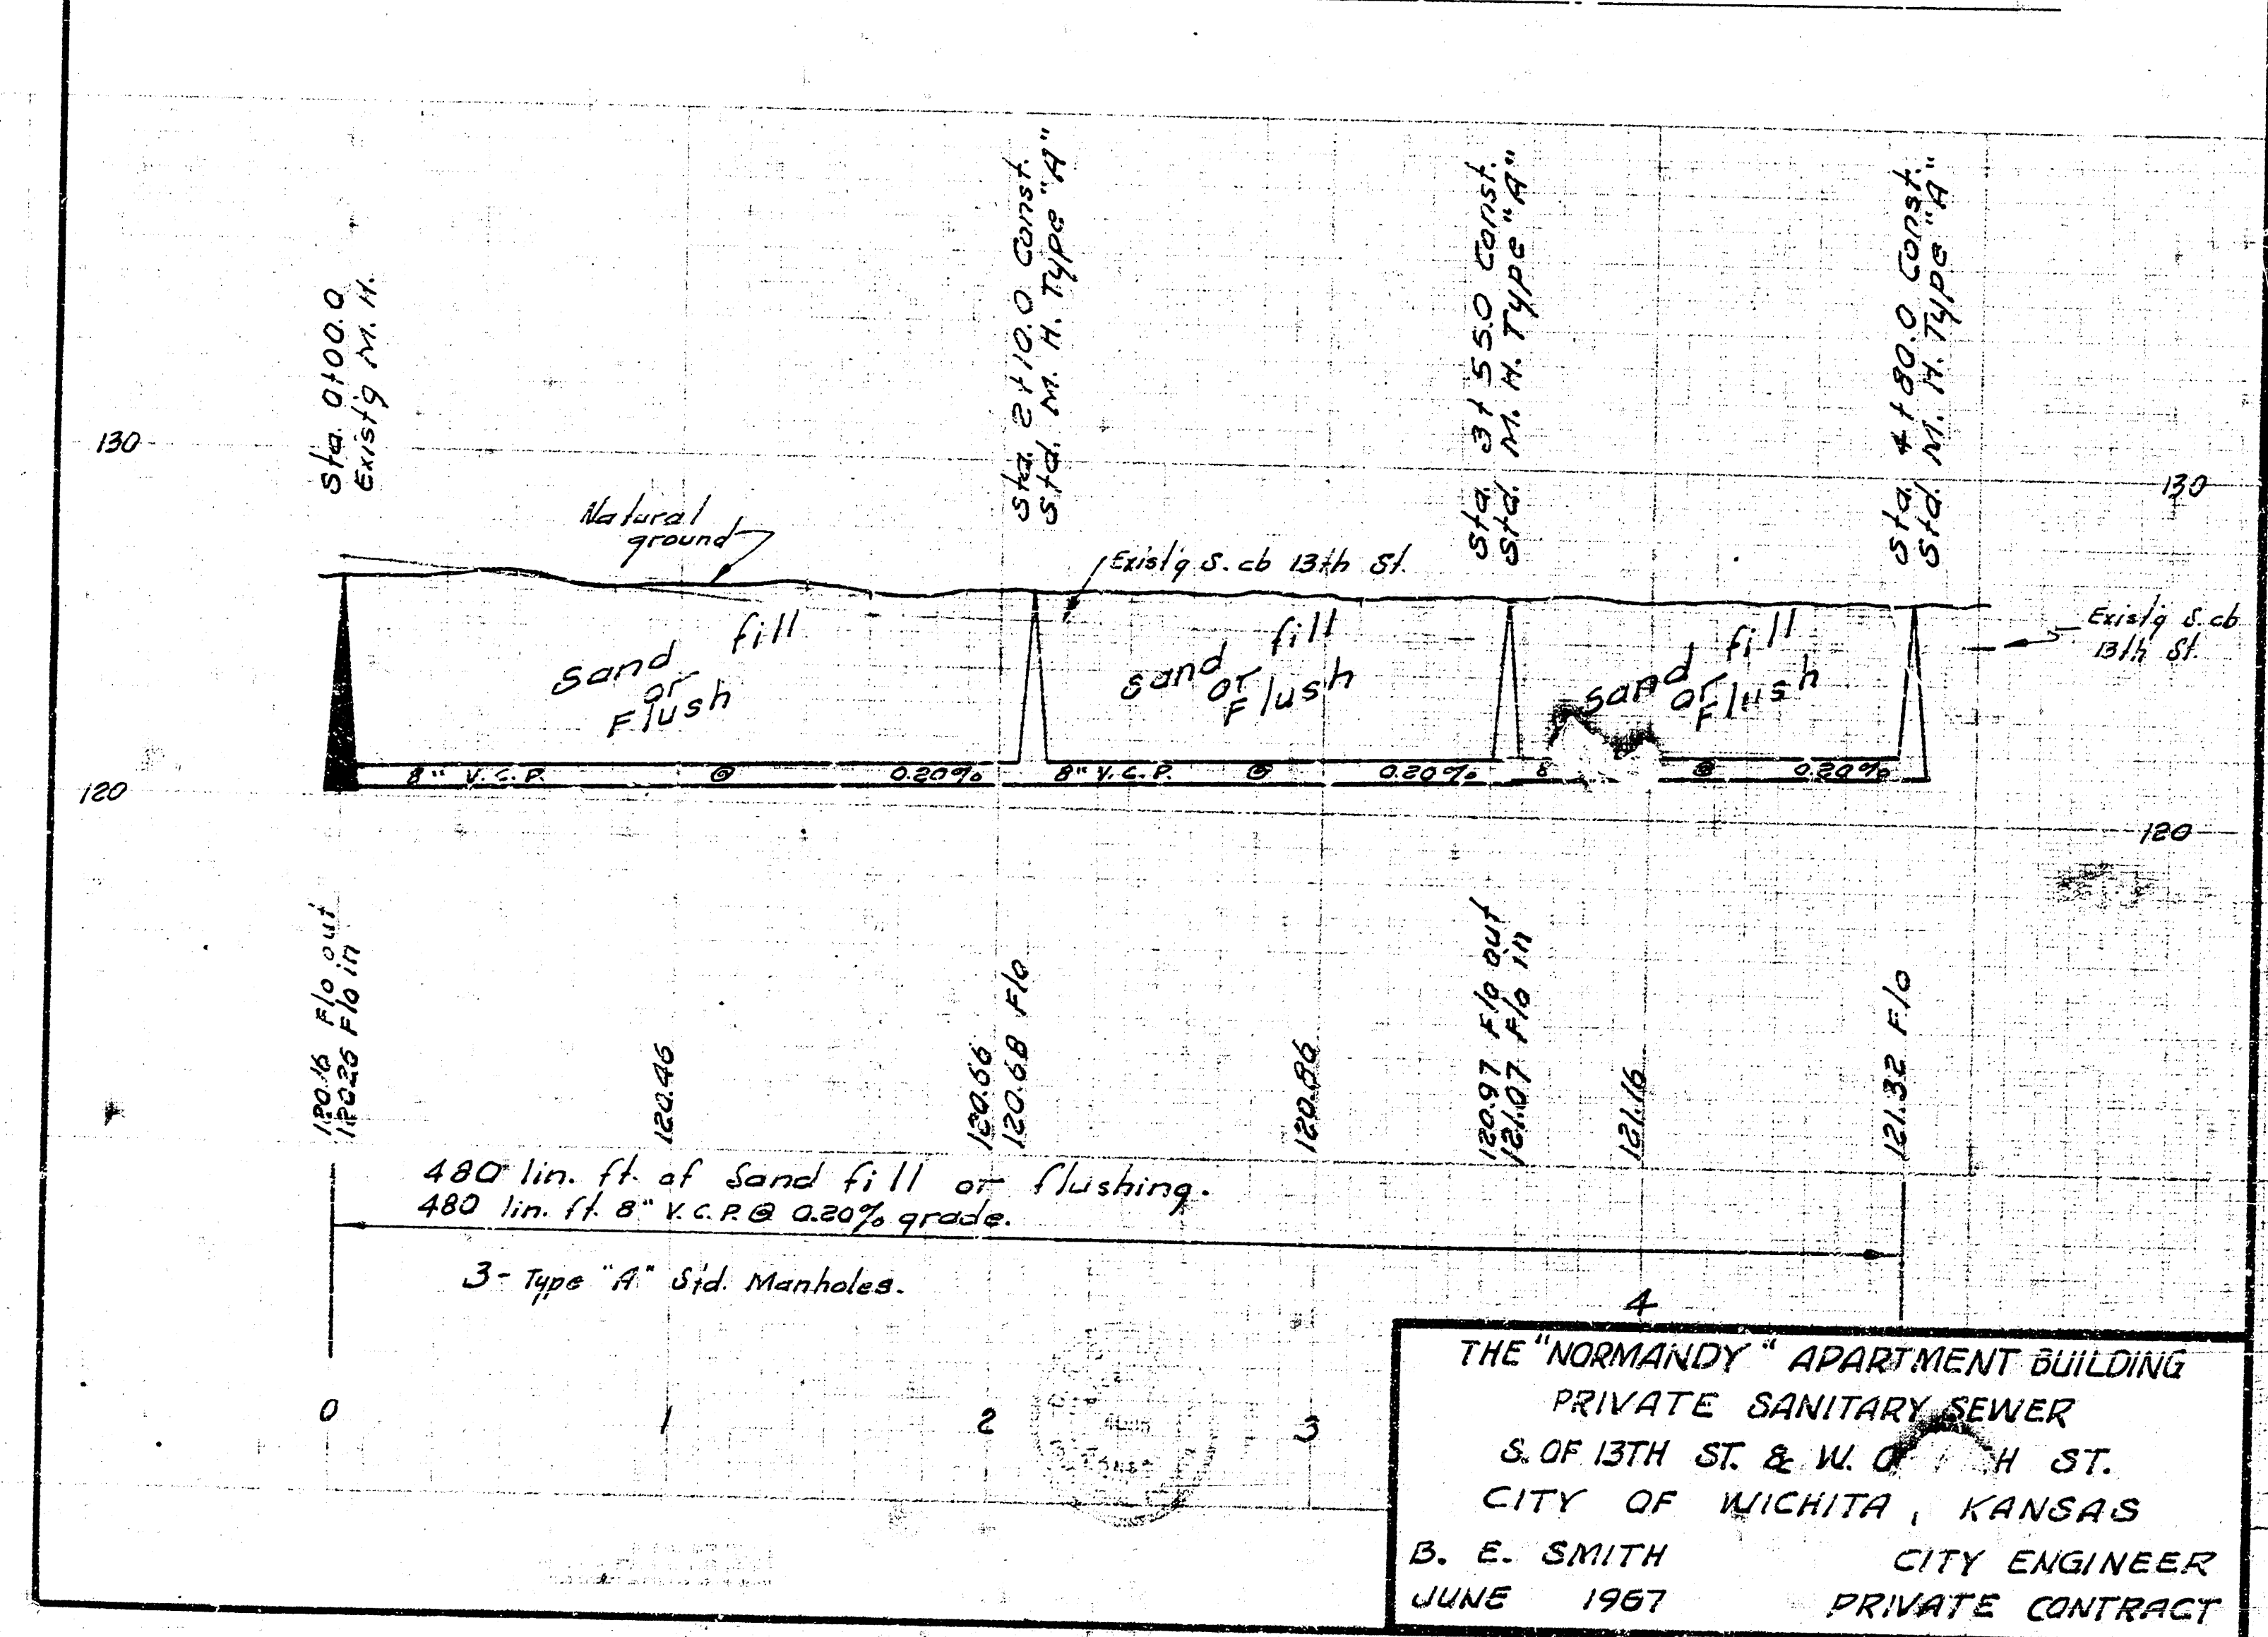


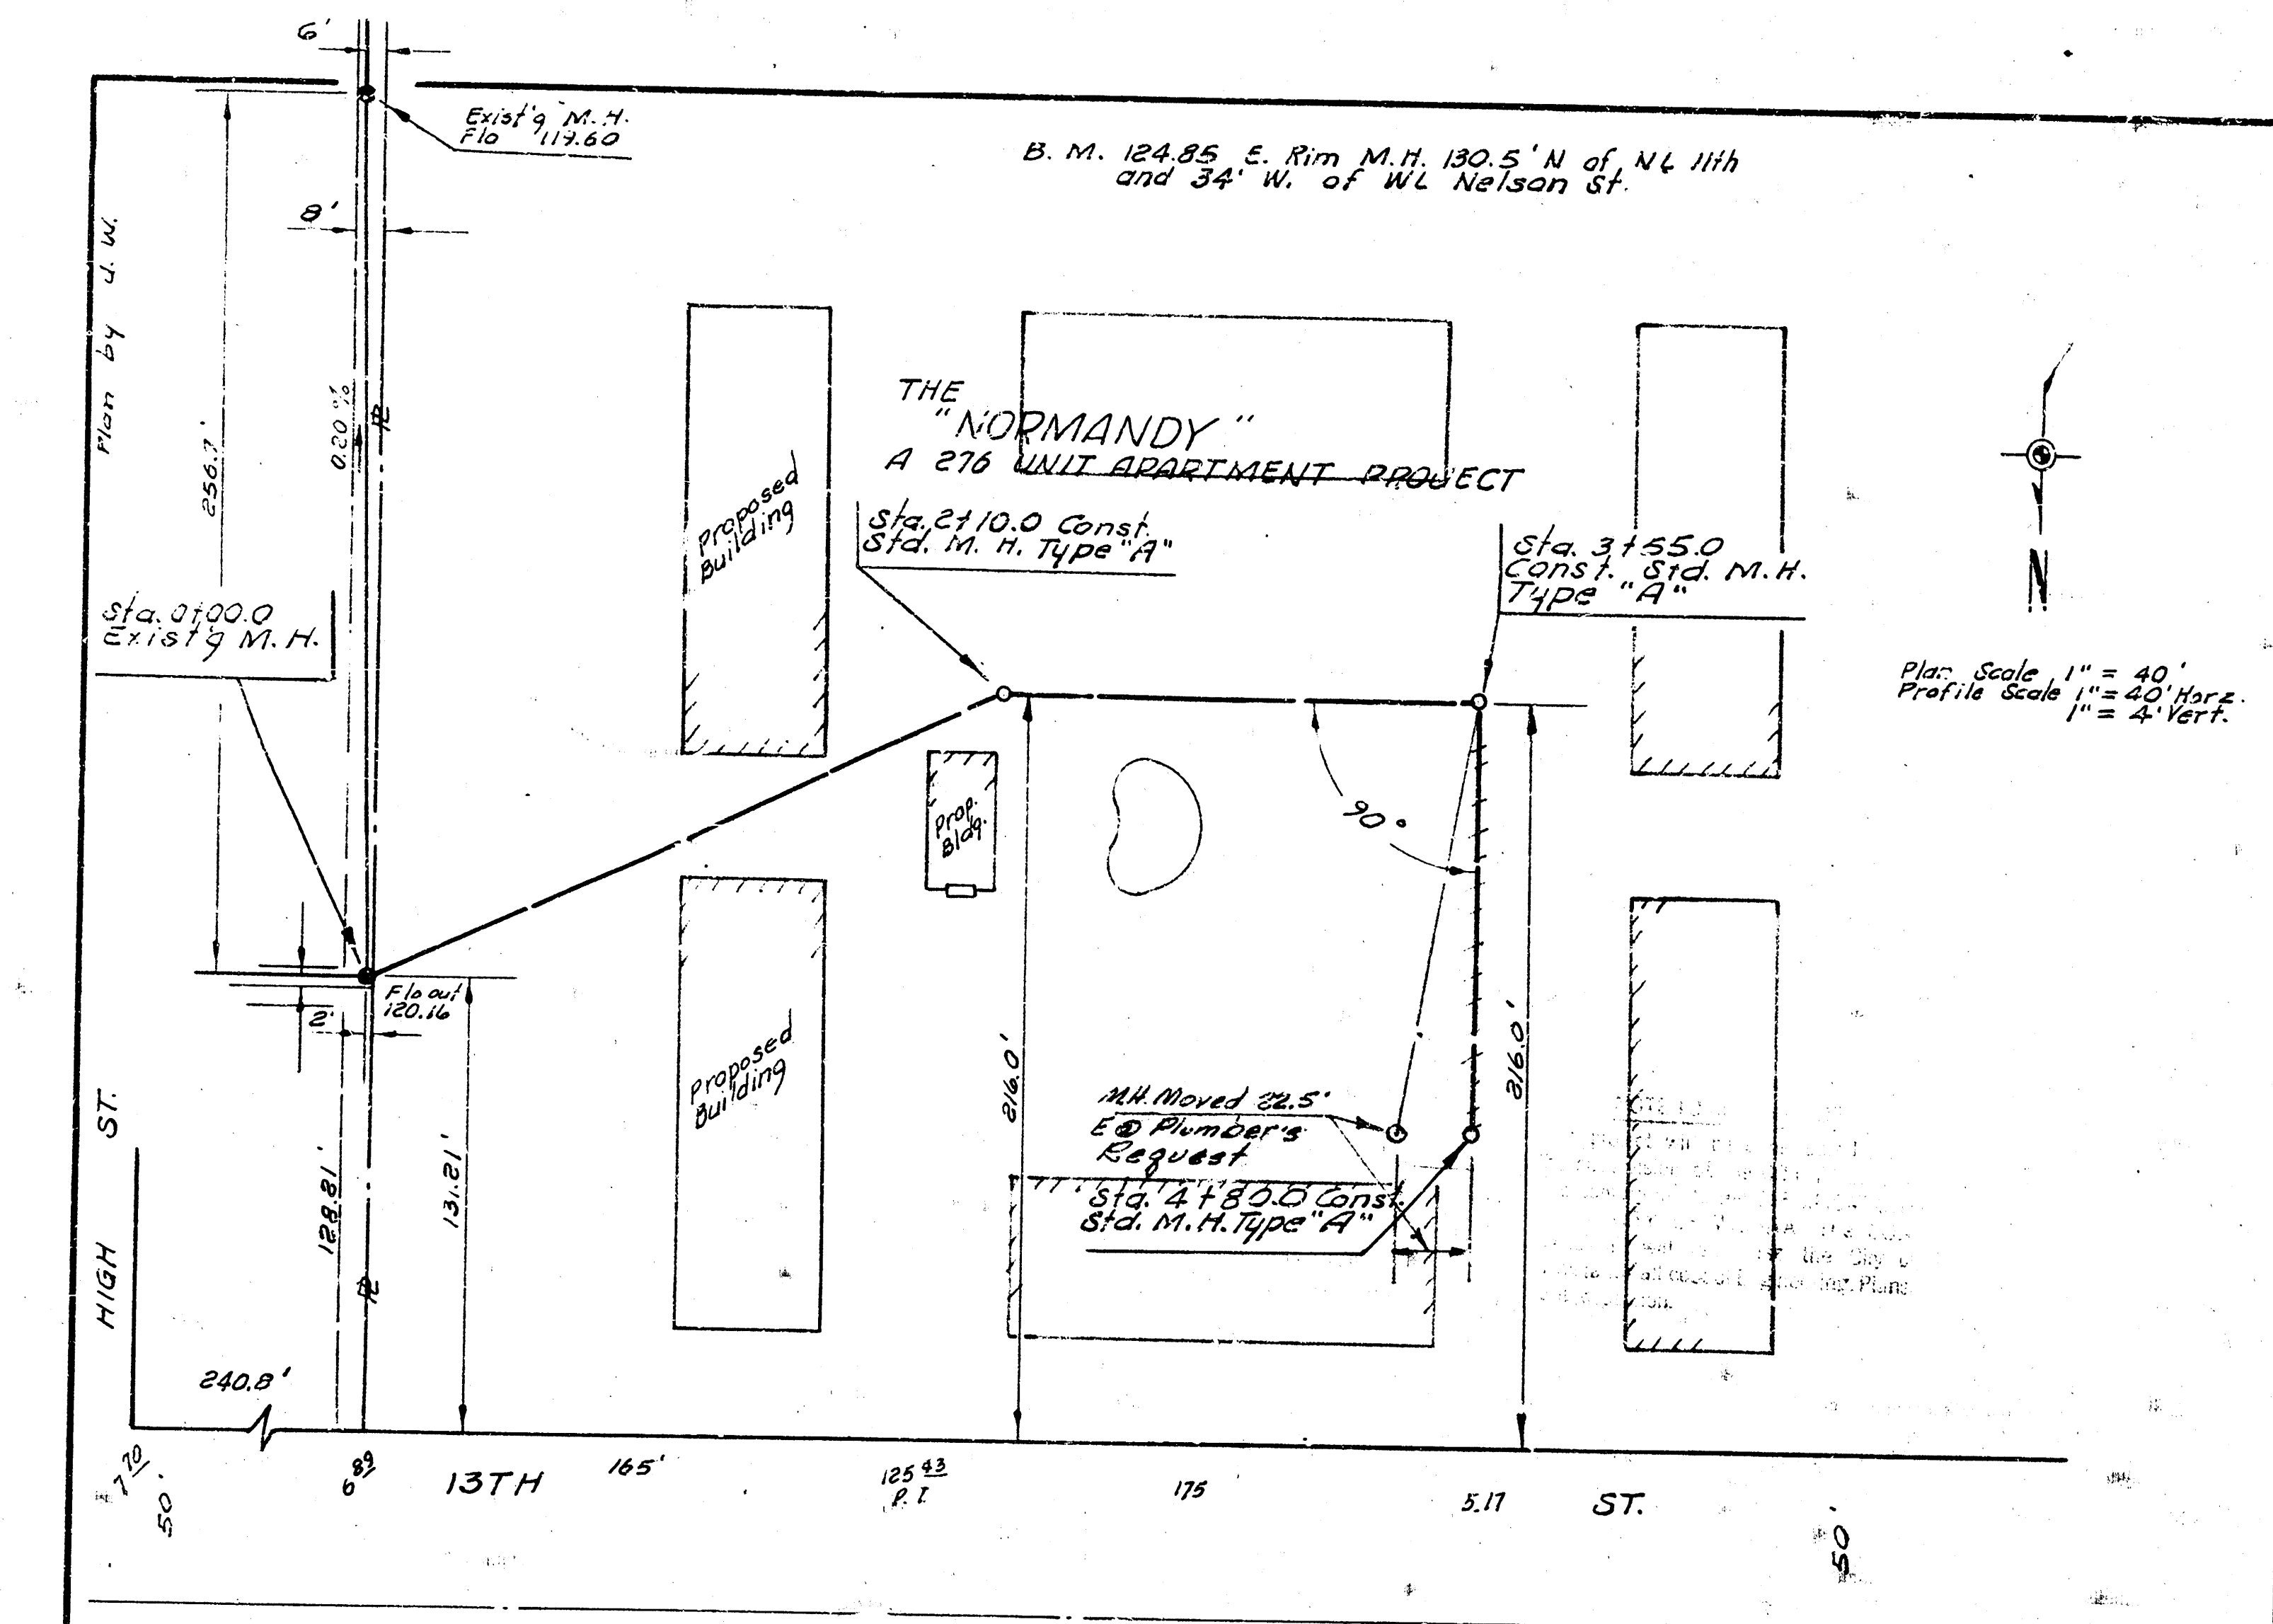

THE "NORMANDY" APARTMENT BUILDING
PRIVATE SANITARY SEWER
S. OF 13TH ST. & W. OF 14TH ST.
CITY OF WICHITA, KANSAS
B. E. SMITH CITY ENGINEER
JUNE 1967 PRIVATE CONTRACT

LAT. 40, WAR INDUSTRIES SEWER
CITY OF WICHITA, KANSAS
B. E. SMITH CITY ENGINEER
