BENCH MARK:
CITY STANDARD DISC, 42' EAST AND 34' NORTH
OF THE CENTER LINES OF AMIDON AND 33RD ST.

ELEVATION = 1313.38 CITY DATUM

GENERAL NOTES

1. The Contractor shall be responsible for preserving property irons. The Contractor will be required to re-establish any property irons which are damaged or destroyed by his construction operations. Such irons shall be re-established by a licensed land surveyor in accordance with state law.
2. Traffic will not be affected by construction of this project.
3. Contractor shall restore project area as required by City of Wichita administration regulations.

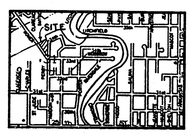

LOCATION MAP

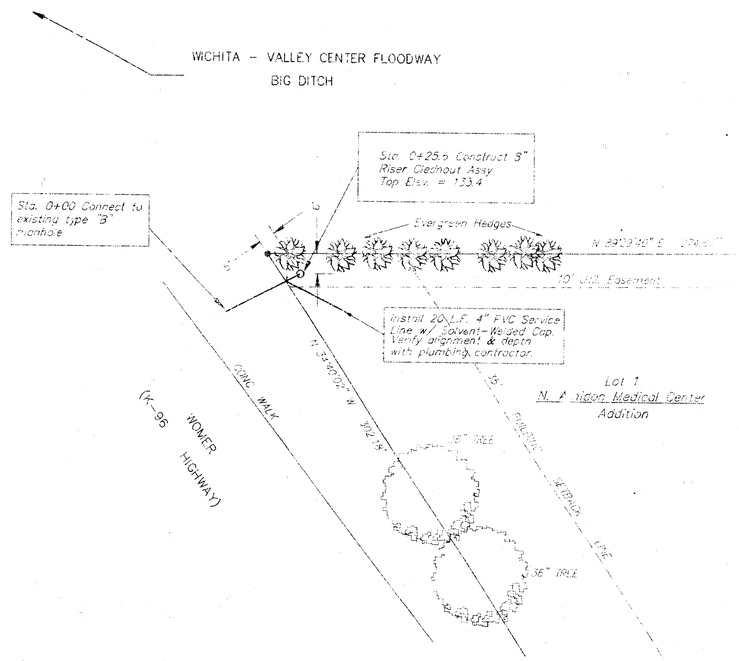

APPROVED AS NOTED
BY CITY ENGINEER, CITY OF WICHITA

Sanitary Sewers VRH 8/13/92

Storm Sewers

Driveway Approaches

Water Mains

Paving

CITY OF WICHITA

Inspection and testing for compliance with specifications provided by a Licensed Engineer shall be performed under contract with the Wichita Waterworks. Solid Inspection to be in accordance with the City of Wichita standard construction inspection practices and certified by a City of Wichita Engineer. No work shall be performed on the rights-of-way or easements of public right-of-way or other facilities without such inspection and approval. No work shall be commenced without written authorization of the City Engineer.

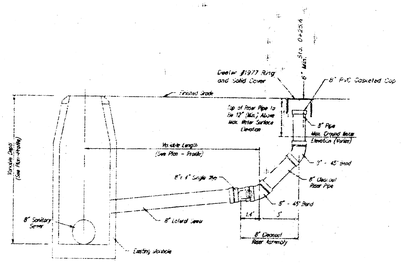

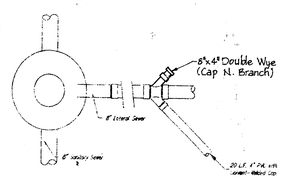

8" CLEANOUT RISER ASSEMBLY DETAIL

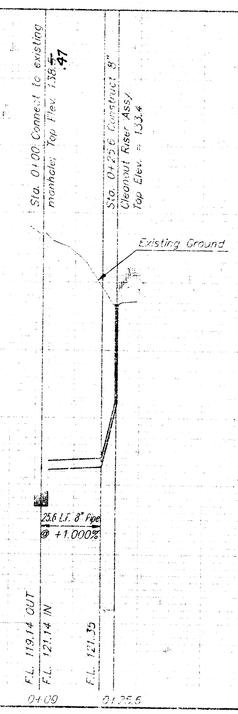

Booked 10-23-92 JKB

THOMAS CHARLES BUBNA LICENSED 9327 KANSAS PROFESSIONAL ENGINEER

No revisions as built 9-14-92 TCR

Private Sanitary Sewer
N. Amidon Medical Center Addition
BAUGHMAN COMPANY, P.A.
ENGINEERING & SURVEYING
WICHITA, KANSAS
357-1115