


COFFEYVILLE RESOURCES CONTACT:
DENNIS YOUNG 620-221-2107

FORCE MAIN CONTACTS:
RAYTHEON:
ROBERT LUHRS 781-768-3995
SHAW ENVIRONMENTAL:
STEVE PARSONS 316-944-5236


FORCE MAIN NOTE:
CONTRACTOR SHALL NOTIFY FORCE
MAIN CONTACTS SEVEN (7) DAYS
PRIOR TO MAKING CONNECTION.
FORCE MAIN CAN ONLY BE
OFFLINE FOR TWO (2) DAYS.

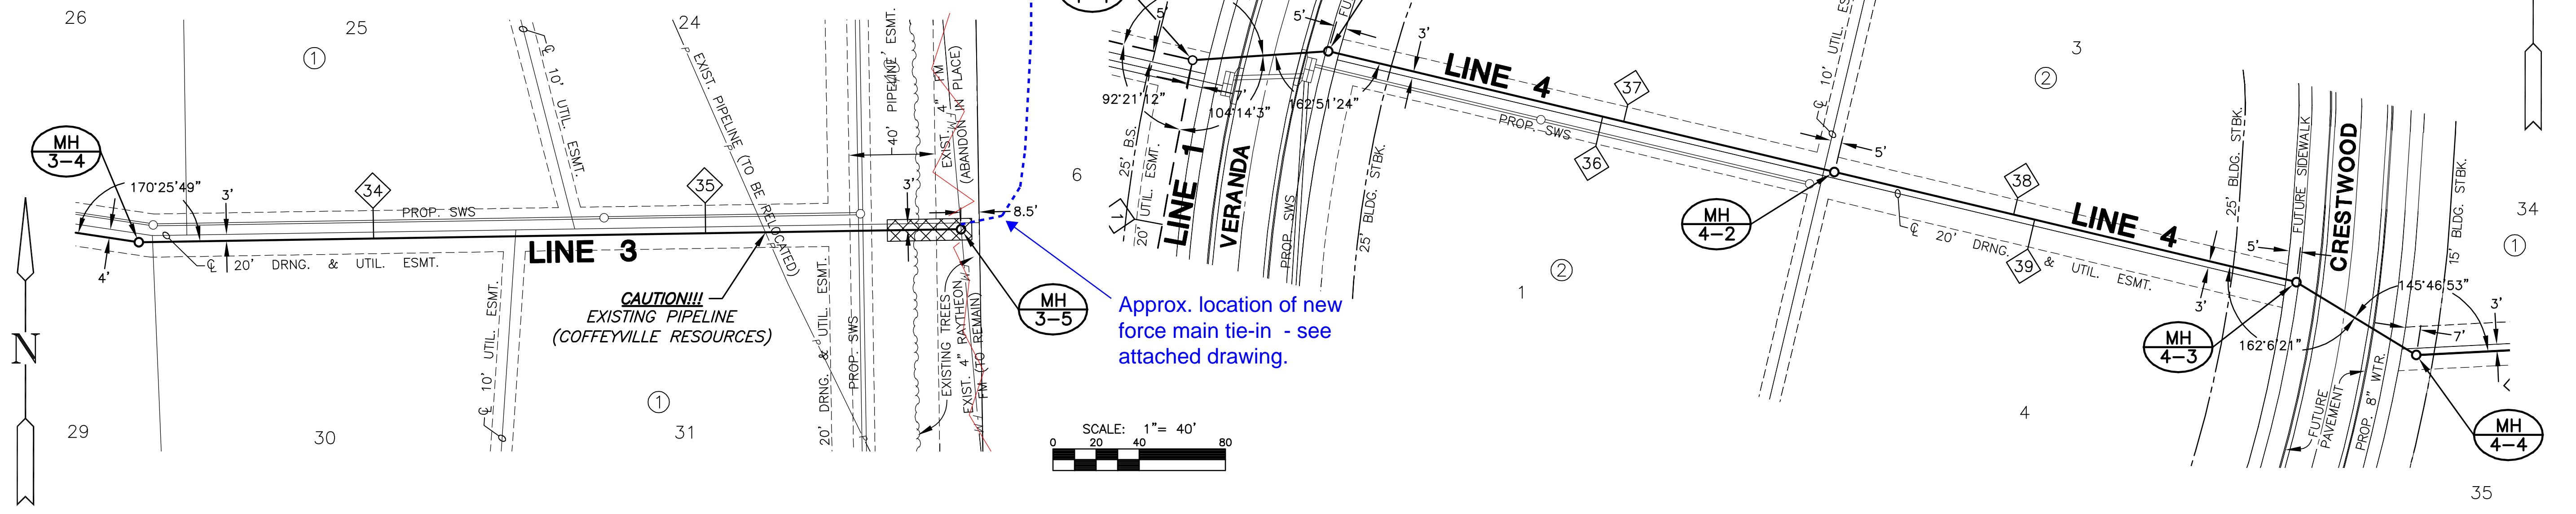

PLAN LINE 3

PLAN LINE 4

NOTE:
CONTRACTOR TO VERIFY THE
DEPTH AND LOCATION OF EXISTING
UTILITIES PRIOR TO CONSTRUCTION.

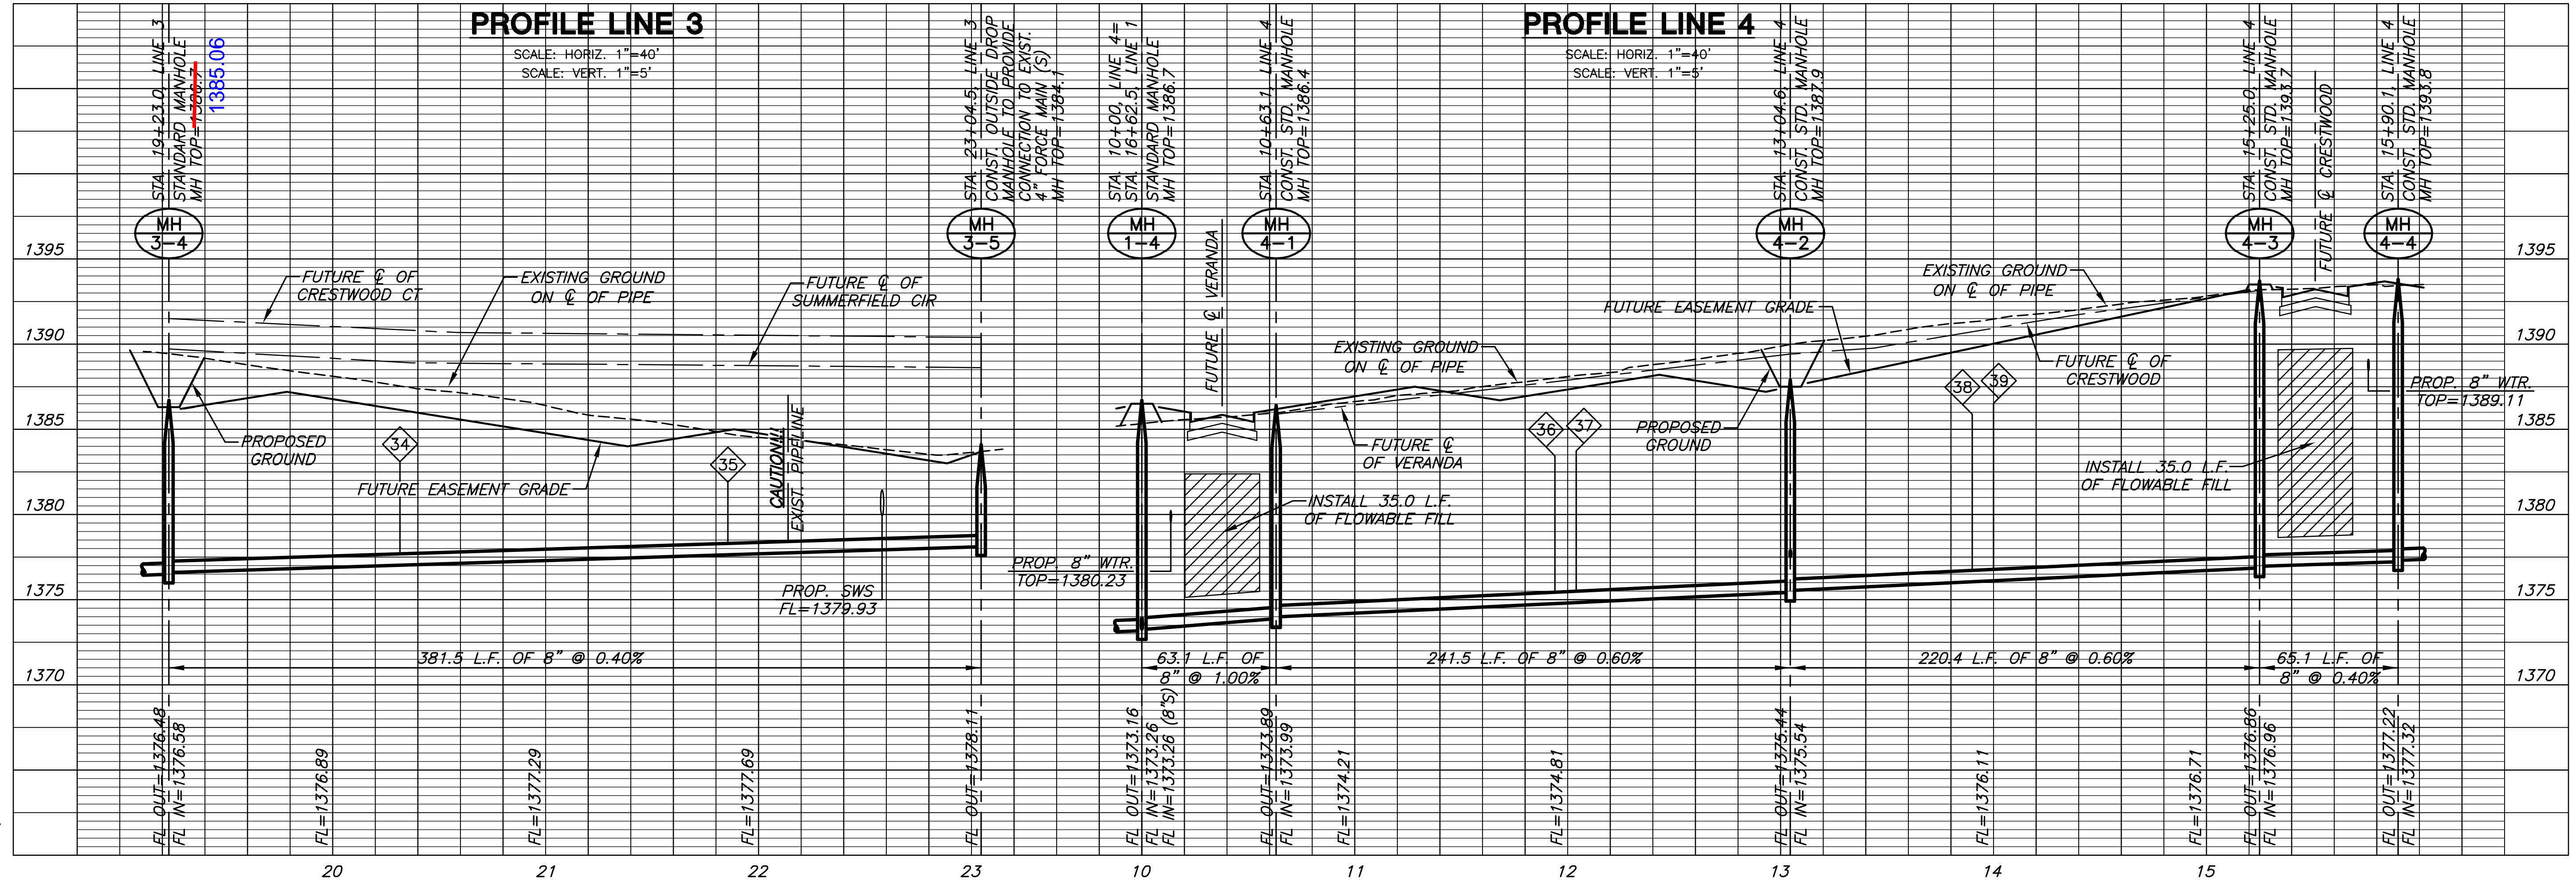

PROFILE LINE 3

PROFILE LINE 4

SANITARY SEWER PLANS FOR
THE WATERFRONT RESIDENTIAL ADD.

LINES 3 & 4
SHEET TITLE
468-84422
PROJECT NUMBER

DESIGN BY: DFL
DRAWN BY: DMU
CHECKED BY: GJA

ISSUED: October 2007
REVISED:

SHEET NO.
11 of 20

PLOTED: Tuesday, October 30, 2007 @ 04:47PM

J:\CIVIL\06266\WVA\SAN\RESIDENTIAL\06266_B7.DWG