

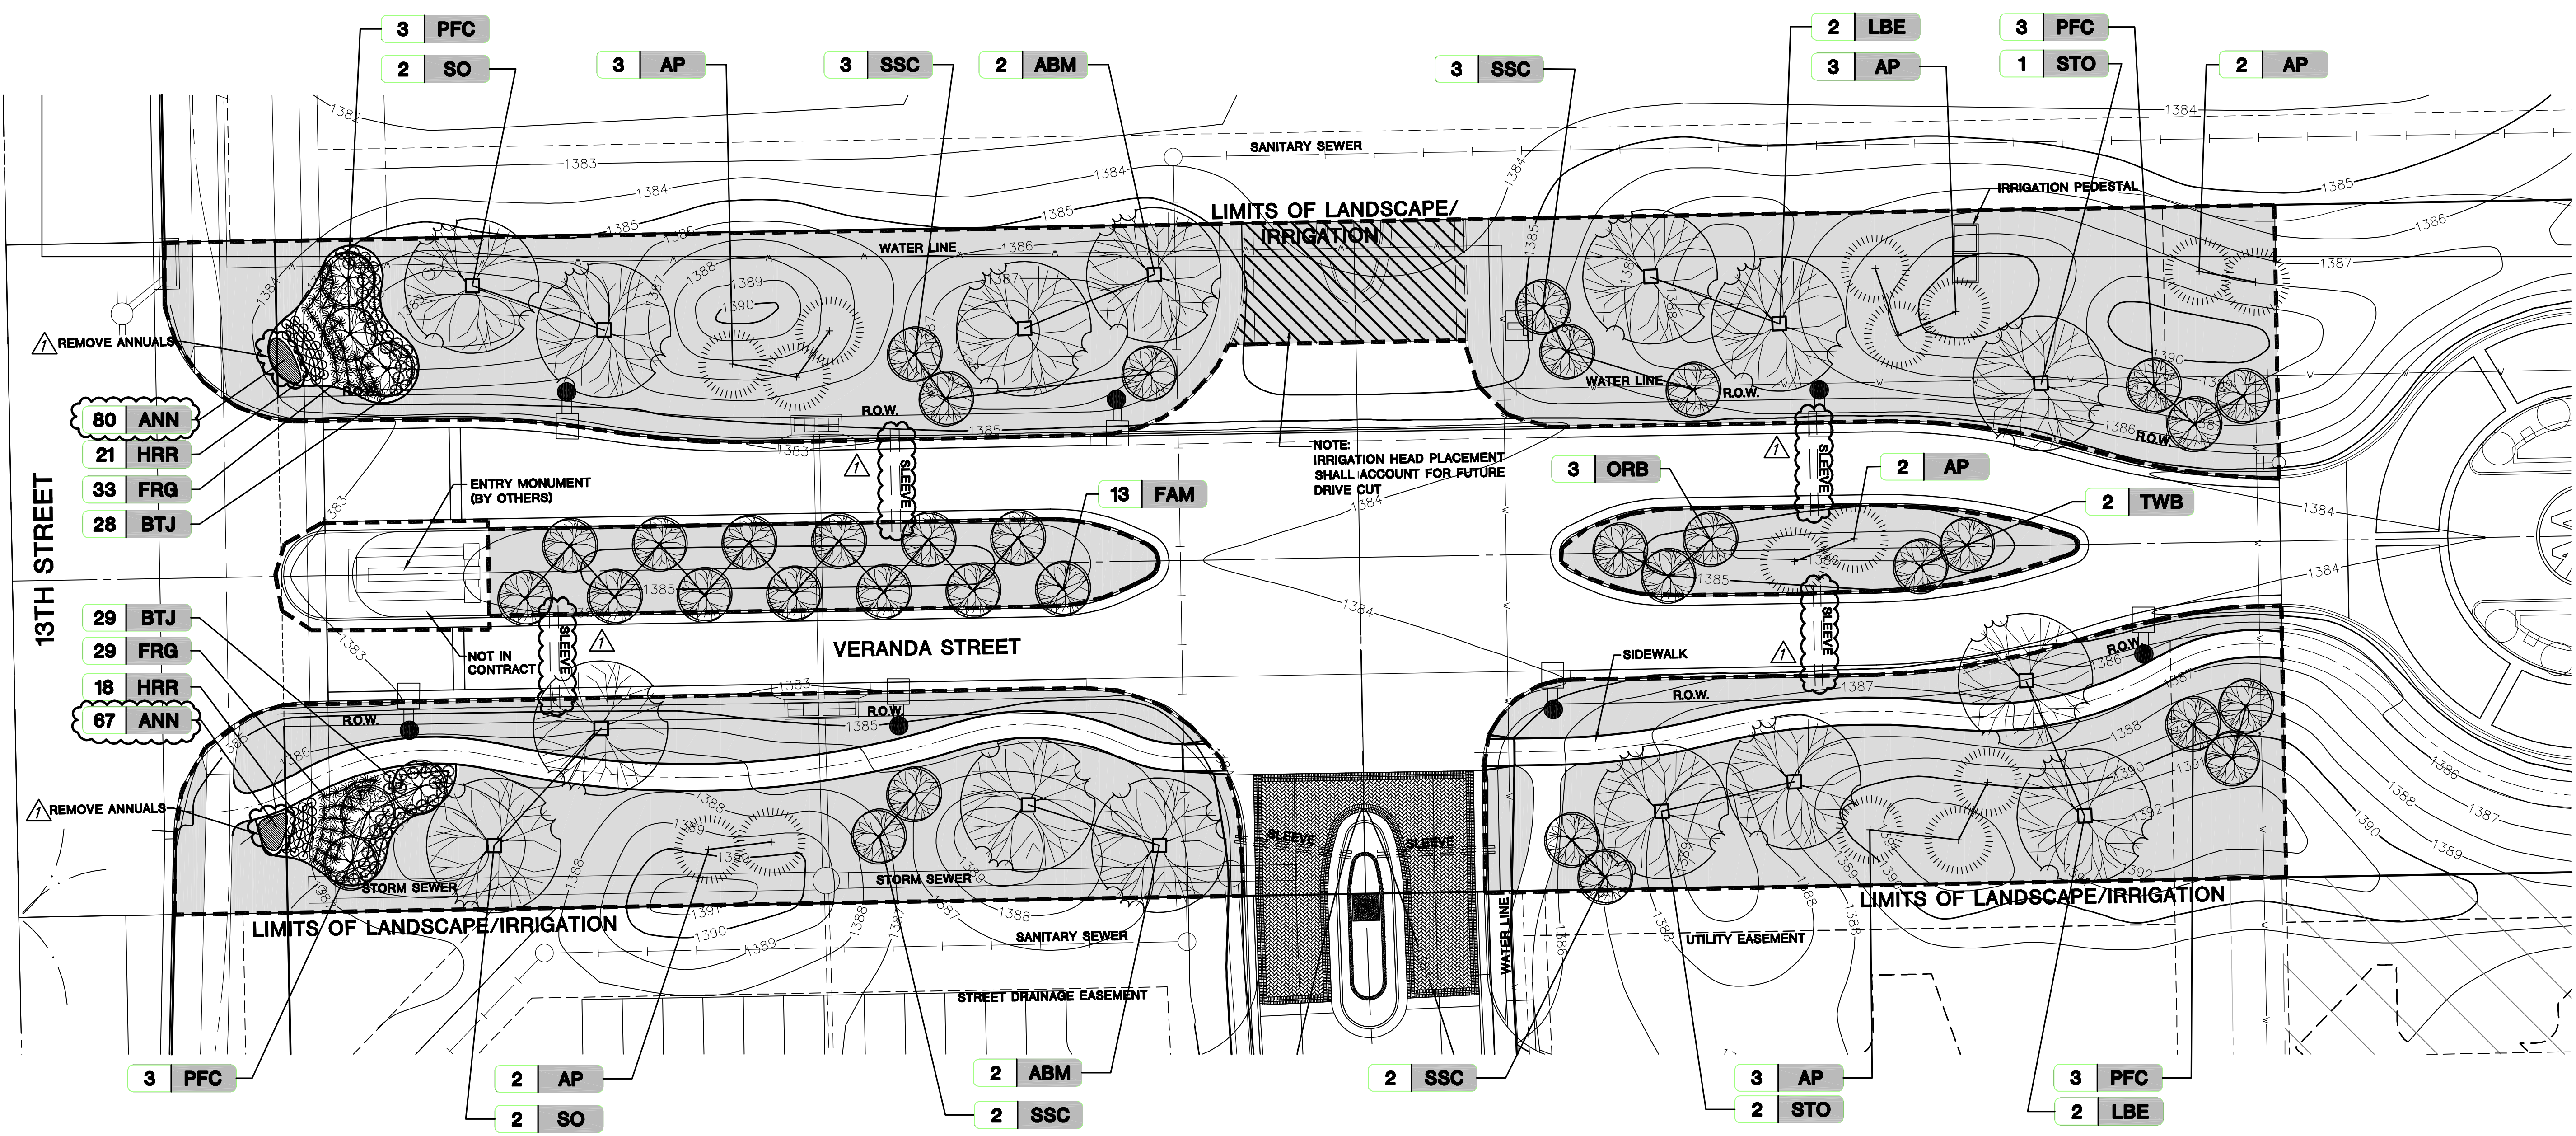


**WATERFRONT RESIDENTIAL**  
ENTRY PHASE - PART B

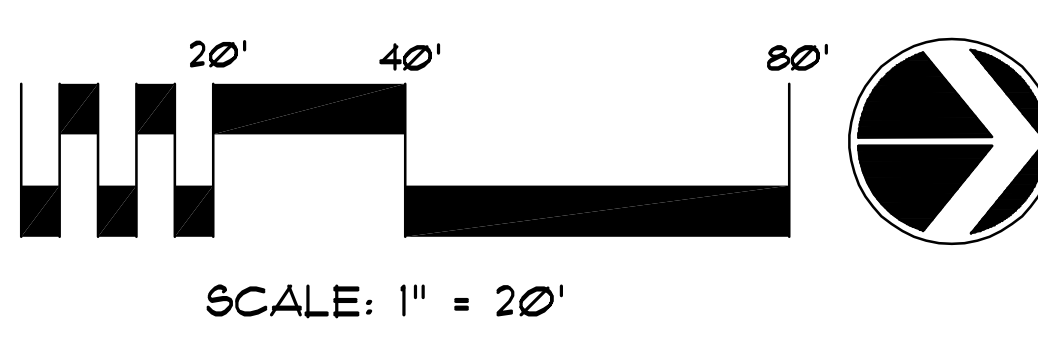

- 80 ANN
- 21 HRR
- 33 FRG
- 28 BTJ
- 29 BTJ
- 29 FRG
- 18 HRR
- 67 ANN

NOTE: IRRIGATION HEAD PLACEMENT SHALL ACCOUNT FOR FUTURE DRIVE CUT

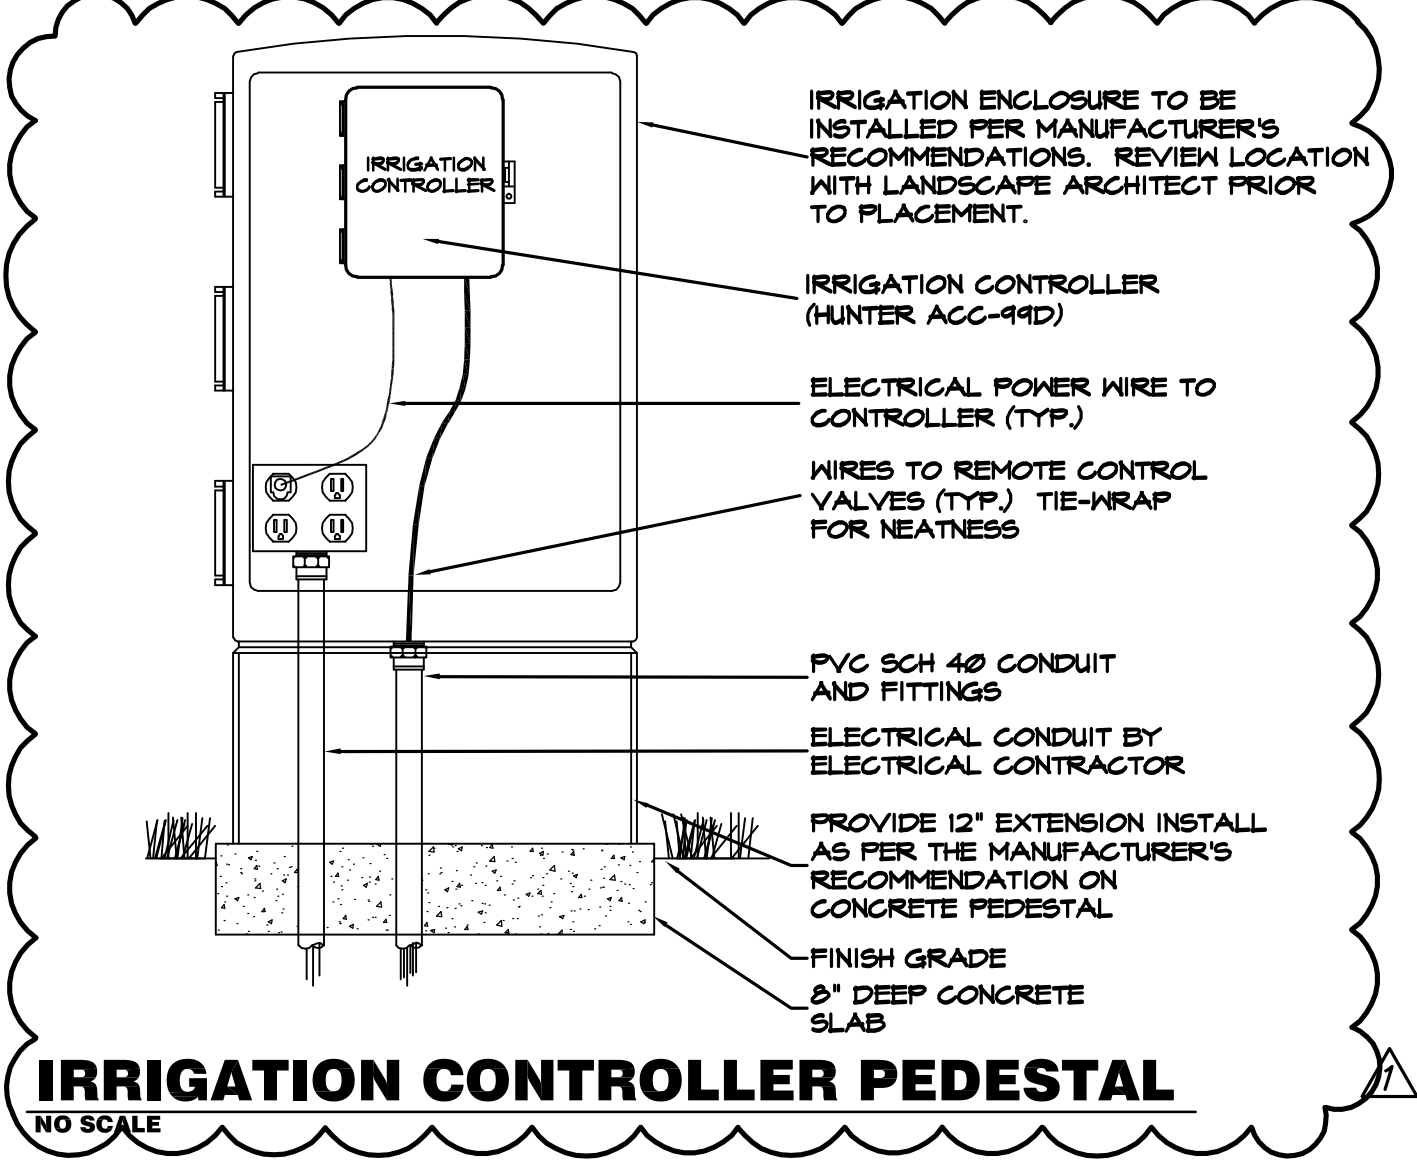

**MASTER PLANT LIST**

KEY	QTY.	COMMON NAME	BOTANICAL NAME	SIZE	COMMENTS
<b>DECIDUOUS TREES</b>					
LBE	4	ALLEE LACEBARK ELM	<i>Ulmus parvifolia 'Allee'</i>	3-4" CAL.	B&B
SO	4	SHUMARDI OAK	<i>Quercus shumardi</i>	3-4" CAL.	B&B
STO	3	SAWTOOTH OAK	<i>Quercus acutissima</i>	3-4" CAL.	B&B
ABM	4	AUTUMN BLAZE MAPLE	<i>Acer x freemanii</i>	3-4" CAL.	B&B
<b>EVERGREEN TREES</b>					
AP	13	AUSTRIAN PINE	<i>Pinus nigra</i>	10'-12' HT.	B&B
<b>ORNAMENTAL TREES</b>					
ORB	3	OKLAHOMA REDBUD	<i>Cercis reniformis 'Oklahoma'</i>	3" CAL.	B&B
TWB	2	TEXAS WHITEBUD	<i>Cercis canadensis 'Texas Whitebud'</i>	3" CAL.	B&B
FAM	13	'FLAME' AMUR MAPLE	<i>Acer ginnala 'Flame'</i>	6'-7' M.T.	B&B
PFC	12	PRARIFIRE CRABAPPLE	<i>Malus sp. 'Prariefire'</i>	3" CAL.	B&B
SSC	10	SPRING SNOW CRABAPPLE	<i>Malus sp. 'Spring Snow'</i>	3" CAL.	B&B
<b>SHRUBS</b>					
BTJ	57	NEW BLUE TAM JUNIPER	<i>Juniperus sabinia 'Tamariscatolia New Blue'</i>	5 GAL.	CONTAINER
HRR	39	'HOMERUN' ROSE	<i>Rosa 'Homerun' (Red)</i>	2 GAL.	CONTAINER
ANN	147	ANNUALS (TYPE TO BE DETERMINED)	(TO BE DETERMINED)	6" POTS	CONTAINER
<b>ORNAMENTAL GRASSES</b>					
FRG	62	FORESTER'S FEATHER REED GRASS	<i>Calamagrostis x acutiflora 'Karl Forester'</i>	3 GAL.	CONTAINER
<b>TURF</b>					
SOD	4,104 S.Y.	WISE FESCUE/BLUE MIXTURE			

**LANDSCAPE PLAN**  
SHEET TITLE  
472-84598  
PROJECT NUMBER

JAG / MKEC / JAG  
DESIGNED DRAWN CHECKED

ISSUED August 2008  
REVISED 08-04-08

SHEET NO.  
6 of 8

PLOTTED: Monday, August 04, 2008 @ 01:28PM  
J:\CIVIL\062605\DWG\LA\ENTRY\VERANDA\_LP\_AND\_DETAILS.DWG