

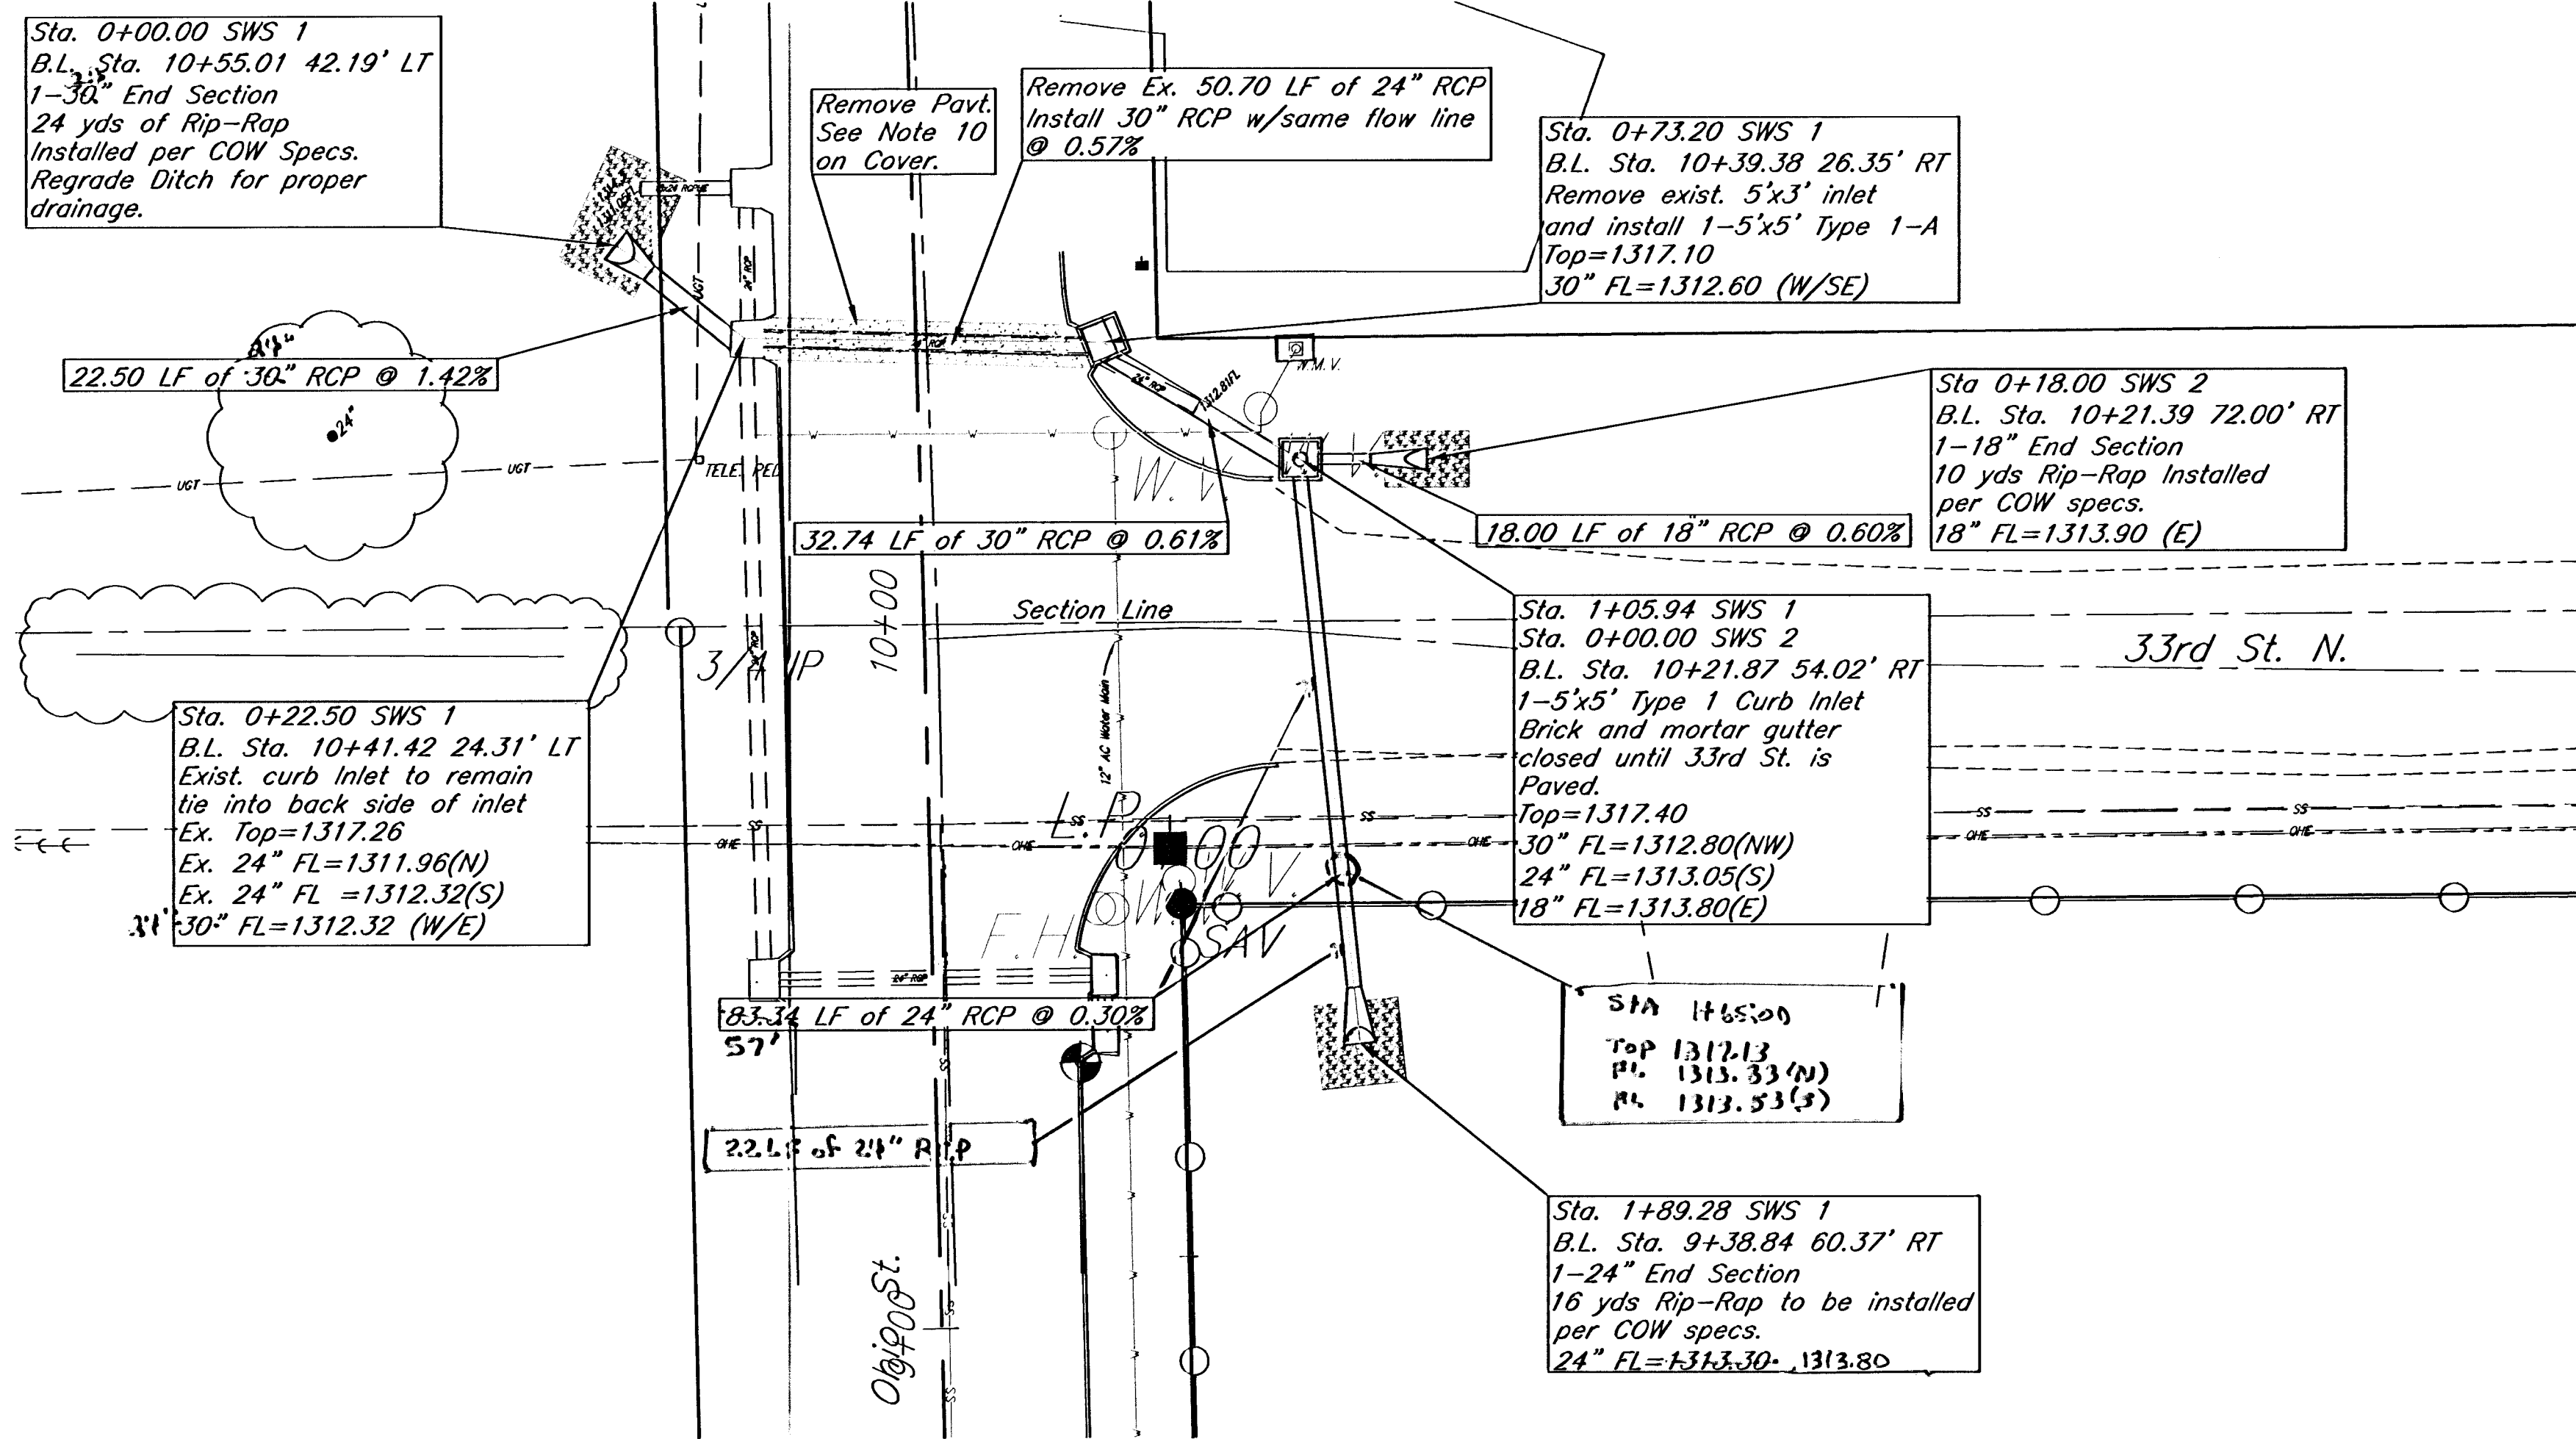
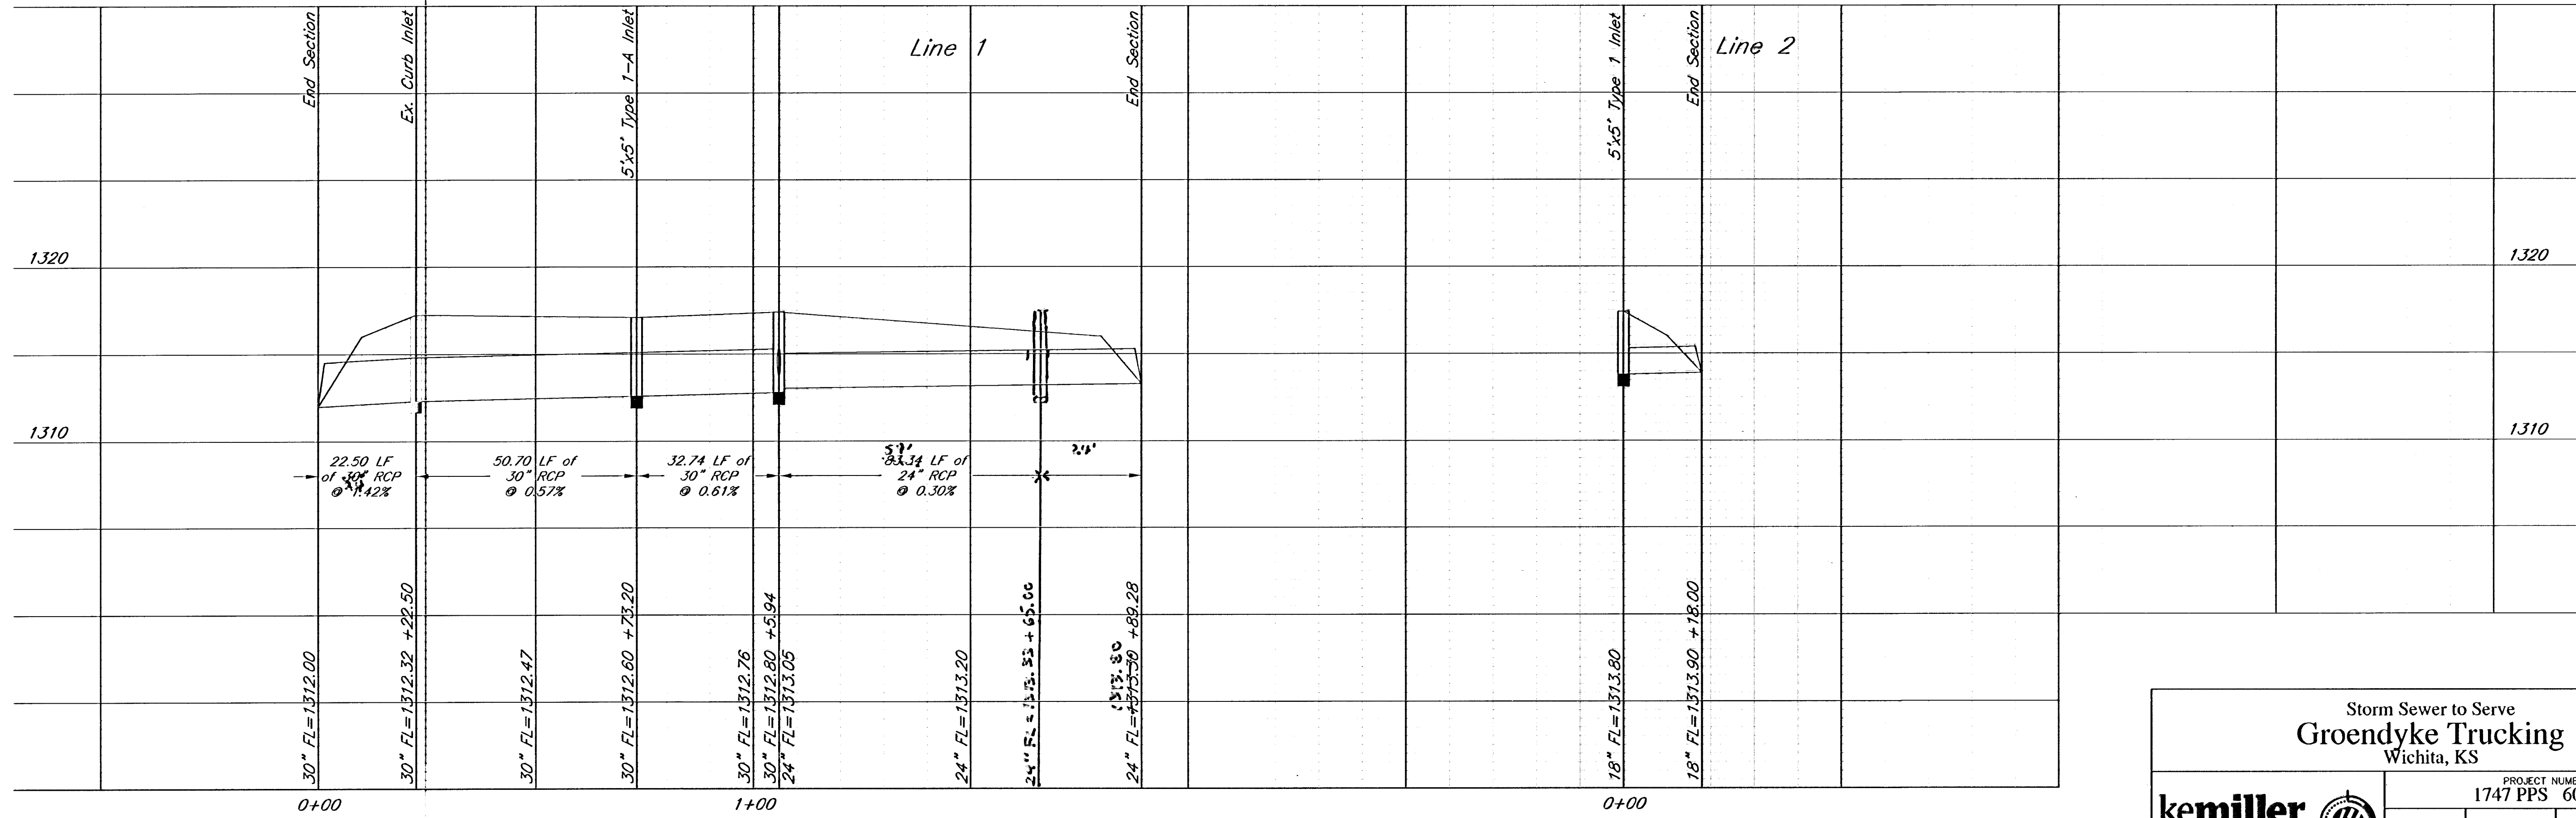


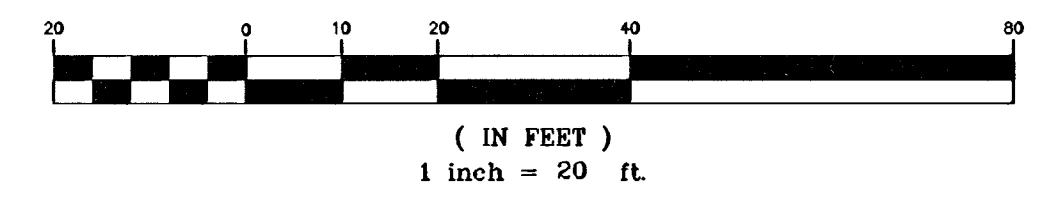

Baseline  
Intersection of Ohio and Quarter  
Section Line, being Sta. 10+00.

Benchmark:  
Rail Road Spike in Hubguard  
SW Corner of RCBG under Ohio  
St. 75' N. of 29th St. N.  
Elev. = 1317.01

On Site BM: "□" on Top of Curb  
at S. End of Catch Basin E. Side  
of Ohio at S. Curb Return.  
Elev. = 1316.75

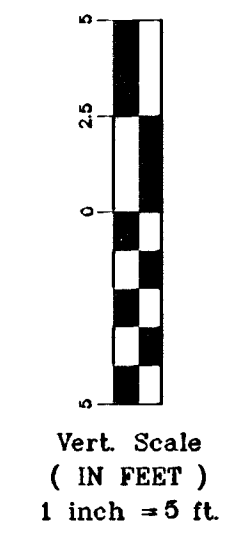

Storm Sewer to Serve  
Groendyke Trucking  
Wichita, KS

kemiller

engineering

PROJECT NUMBER  
1747 PPS 607861

KEM NO.  
06177

DESIGN  
PB

FILE  
PPS

DRAWN  
JO

DATE  
2/07

REVISED  
2/20/07

SHEET  
2

OF  
5

518 S. Market,  
Wichita, KS 67202

316/264-0242