



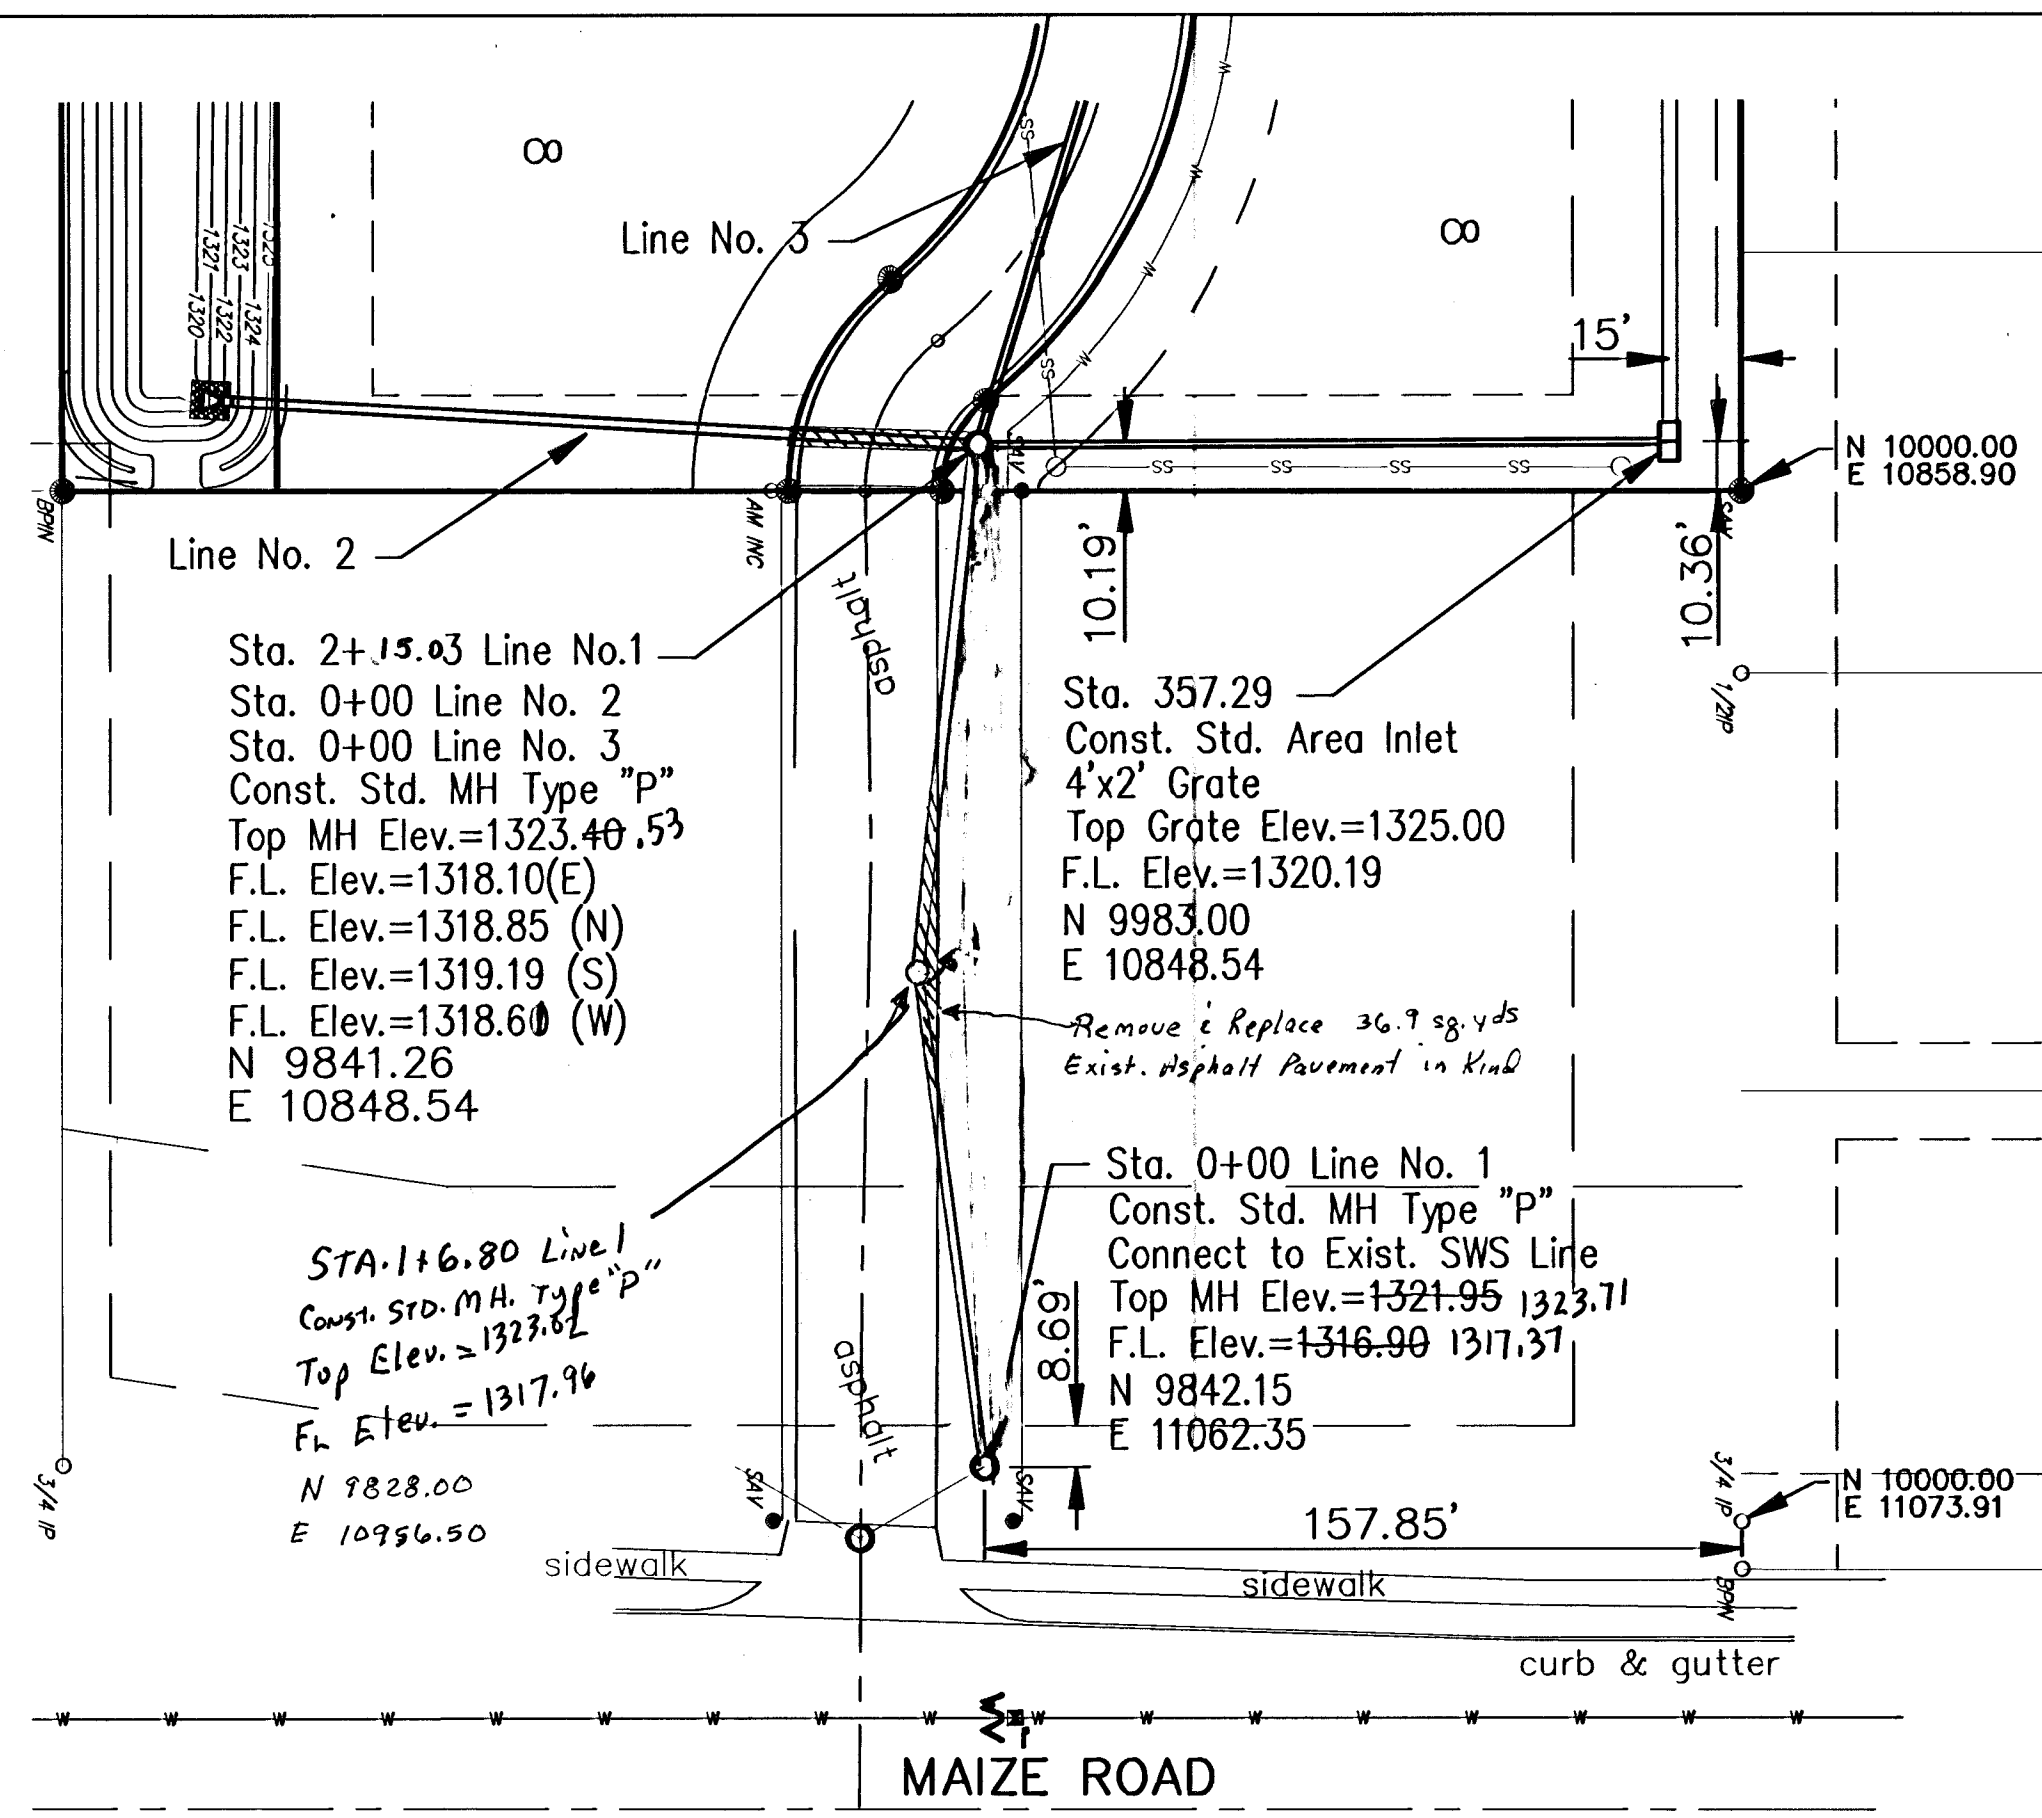

LINE NO. 1

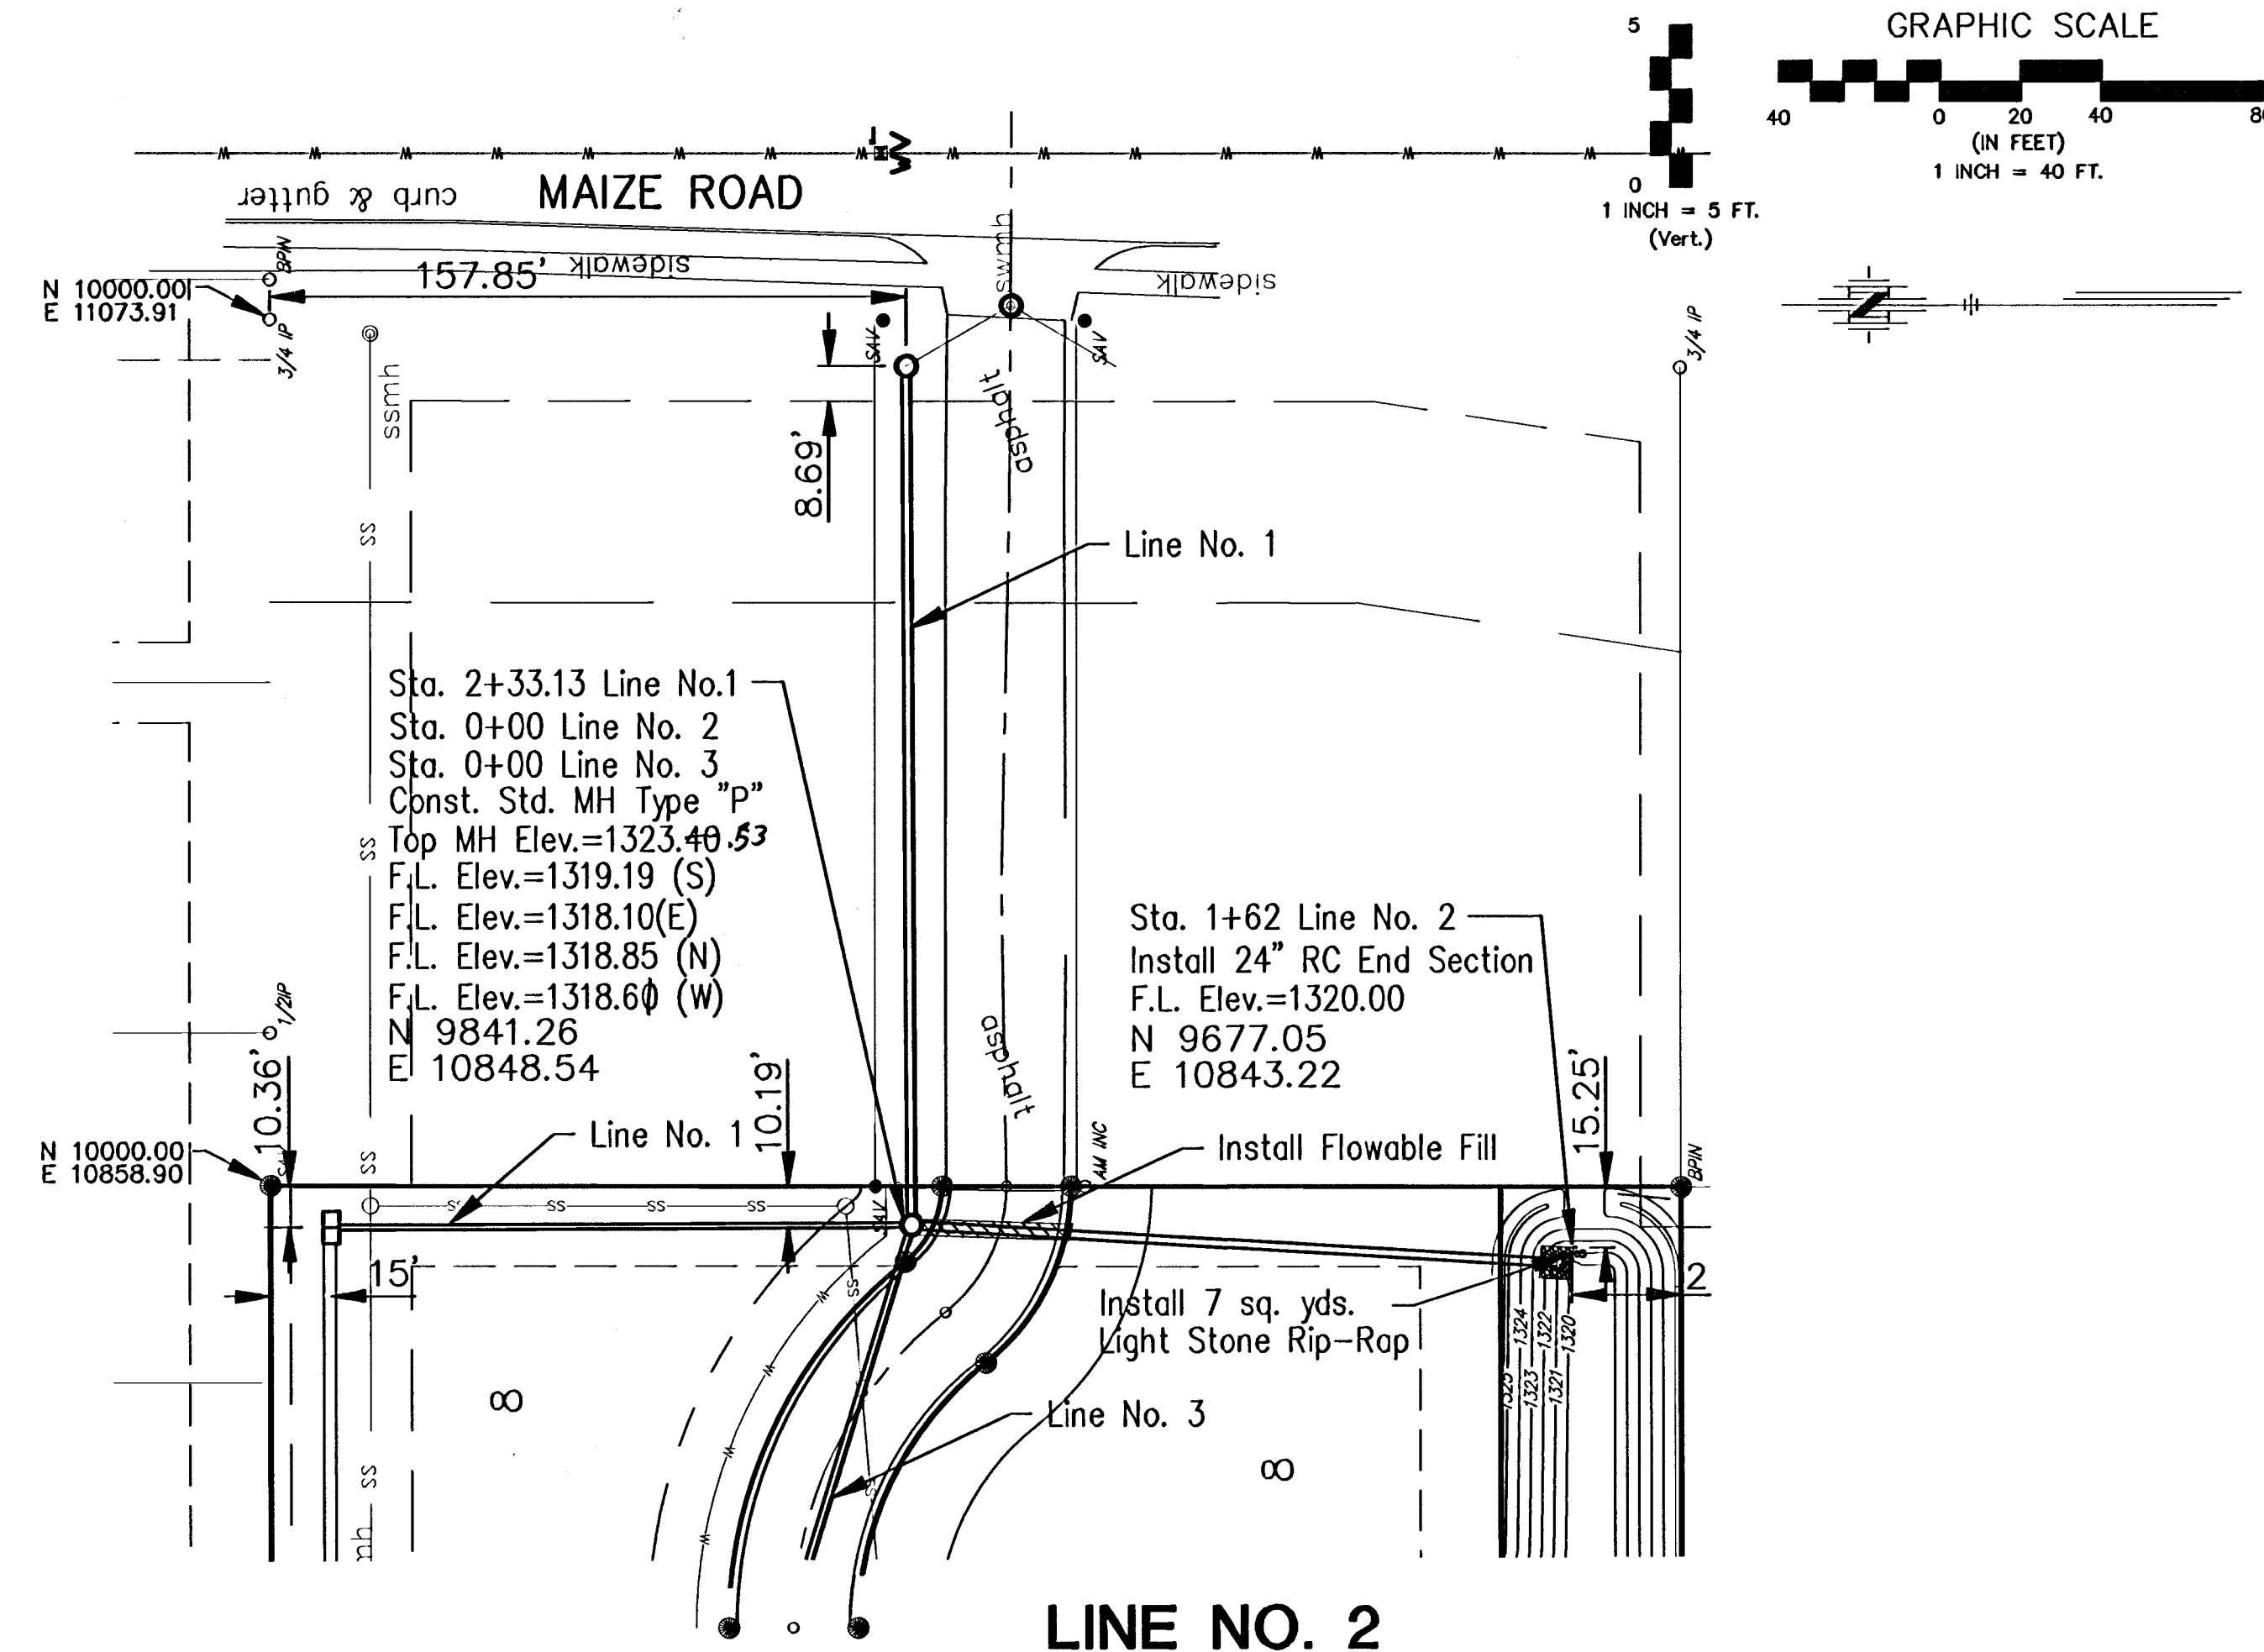

LINE NO. 2

