

City of Wichita Bench Mark
135th St. W. and 21st St. N
SW Corner Intersection
49.00' S. of Center Line of 21st St.
43.00' W. of Center Line of 135th St.
65.50' SW of Section Corner Iron
11.60' N. of Chain Link Fence
35.60' NW of Power Pole
27.60' W. of Back of Curb
City Elev. = 169.19

203 4+30.59

Sta. 4+80.59
BL Sta. 10+83.90, 85.00 Lt.
Install Type P Outside Drop Manhole (6' Dia.)
Flowline Elev. = 135.28 (In)
Extend 8" Vertical Drop line to Ground Level and Cap (W)
Flowline Elev. = 153.43 (In)
Install 165.04 L.F. 21" SS Line (N)
Flowline Elev. = 134.20 (In)

Sylvester Soller
Revocable Trust
13601 West 21st North
Wichita, Kansas

Caution!
1" Force Main
Crossing

202 Sta. 1+72.78
BL Sta. 9+11.90, 93.40 Rt.
Install Std. Type P Manhole (6' Dia.)
Install 248.15 L.F. 21" SS Line (NW)

Lot 1, Block 1
NW Main Pump Station
Wichita, Kansas

201 Sta. 0+00.00
BL Sta. 9+14.38, 266.16 Rt.
Tie in to Existing
Sanitary Sewer Line
Install Std. Type P Manhole (6' Dia.)
Install 172.47 L.F. 21" SS Line (W)

Sta. 2+99.36
BL Sta. 10+00.84, 3.32' Rt.
Install 36" x 88" Steel Casing Pipe
By Boring (36" min. I.D.)

Note: FL information not verified.

Wesley A. & Susan J. Kottas
Living Trust
2226 North 135th West
Wichita, Kansas

Jerald & Dana Bruggeman
2240 North 135th West
Wichita, Kansas


Raymond J. Jr. & Margaret E. Van Skiver
2256 North 135th West
Wichita, Kansas

William M. & Carol L. Reyes
2300 North 135th West
Wichita, Kansas

Michael D. & Linda J. Bell
2326 North 135th West
Wichita, Kansas

Scale
Horizontal 1" = 40'

MATCHLINE
STA. 19+00.00

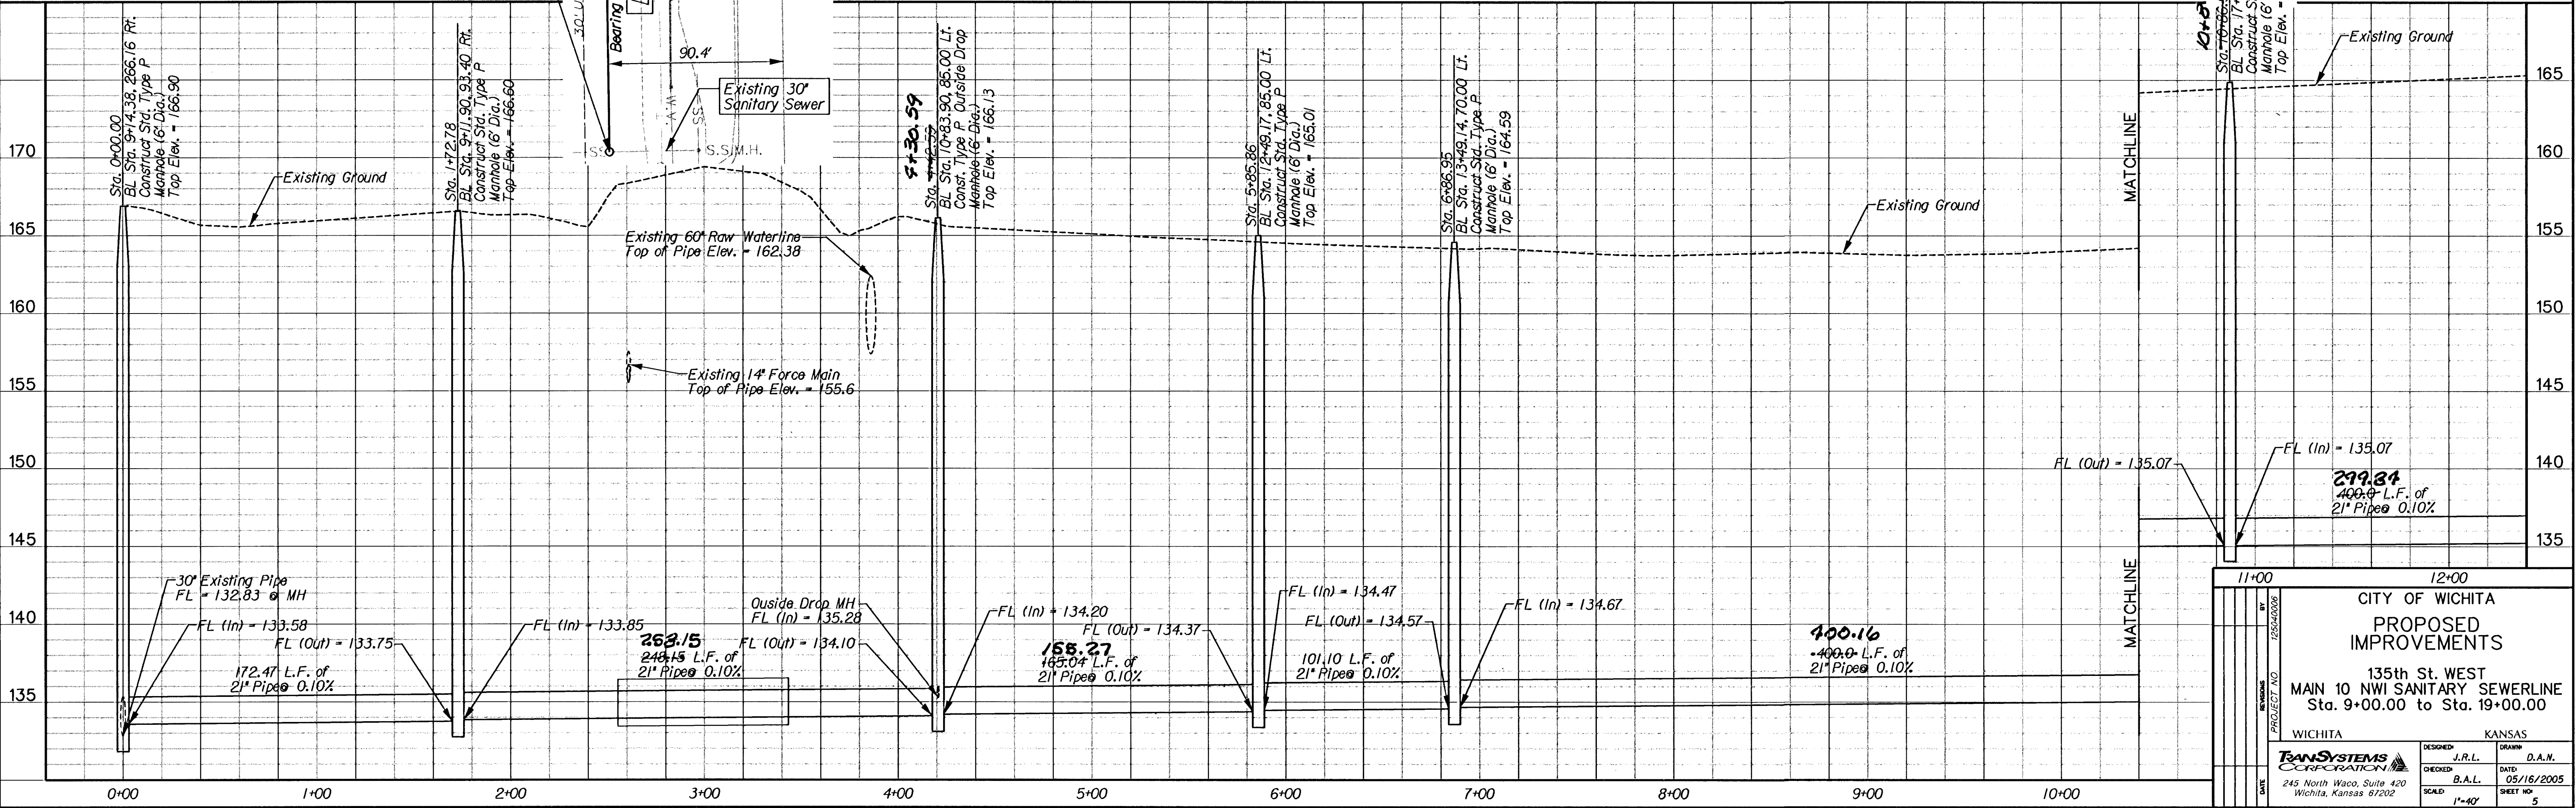

10+87.11
Sta. 10+86.95
BL Sta. 17+49.14, 70.00 Lt.
Install Std. Type P Manhole (6' Dia.)
Install 400.00 L.F. 21" SS Line (N)

10+87.11
Sta. 10+86.95
BL Sta. 17+49.14, 70.00 Lt.
Install Std. Type P Manhole (6' Dia.)
Install 400.00 L.F. 21" SS Line (N)

CITY OF WICHITA	
PROPOSED IMPROVEMENTS	
135th St. WEST	
MAIN 10 NW SANITARY SEWERLINE	
Sta. 9+00.00 to Sta. 19+00.00	
WICHITA	KANSAS
DESIGNED: J.R.L.	DRAWN: D.A.N.
CHECKED: B.A.L.	DATE: 05/16/2005
SCALE: 1"=40'	SHEET NO: 5