



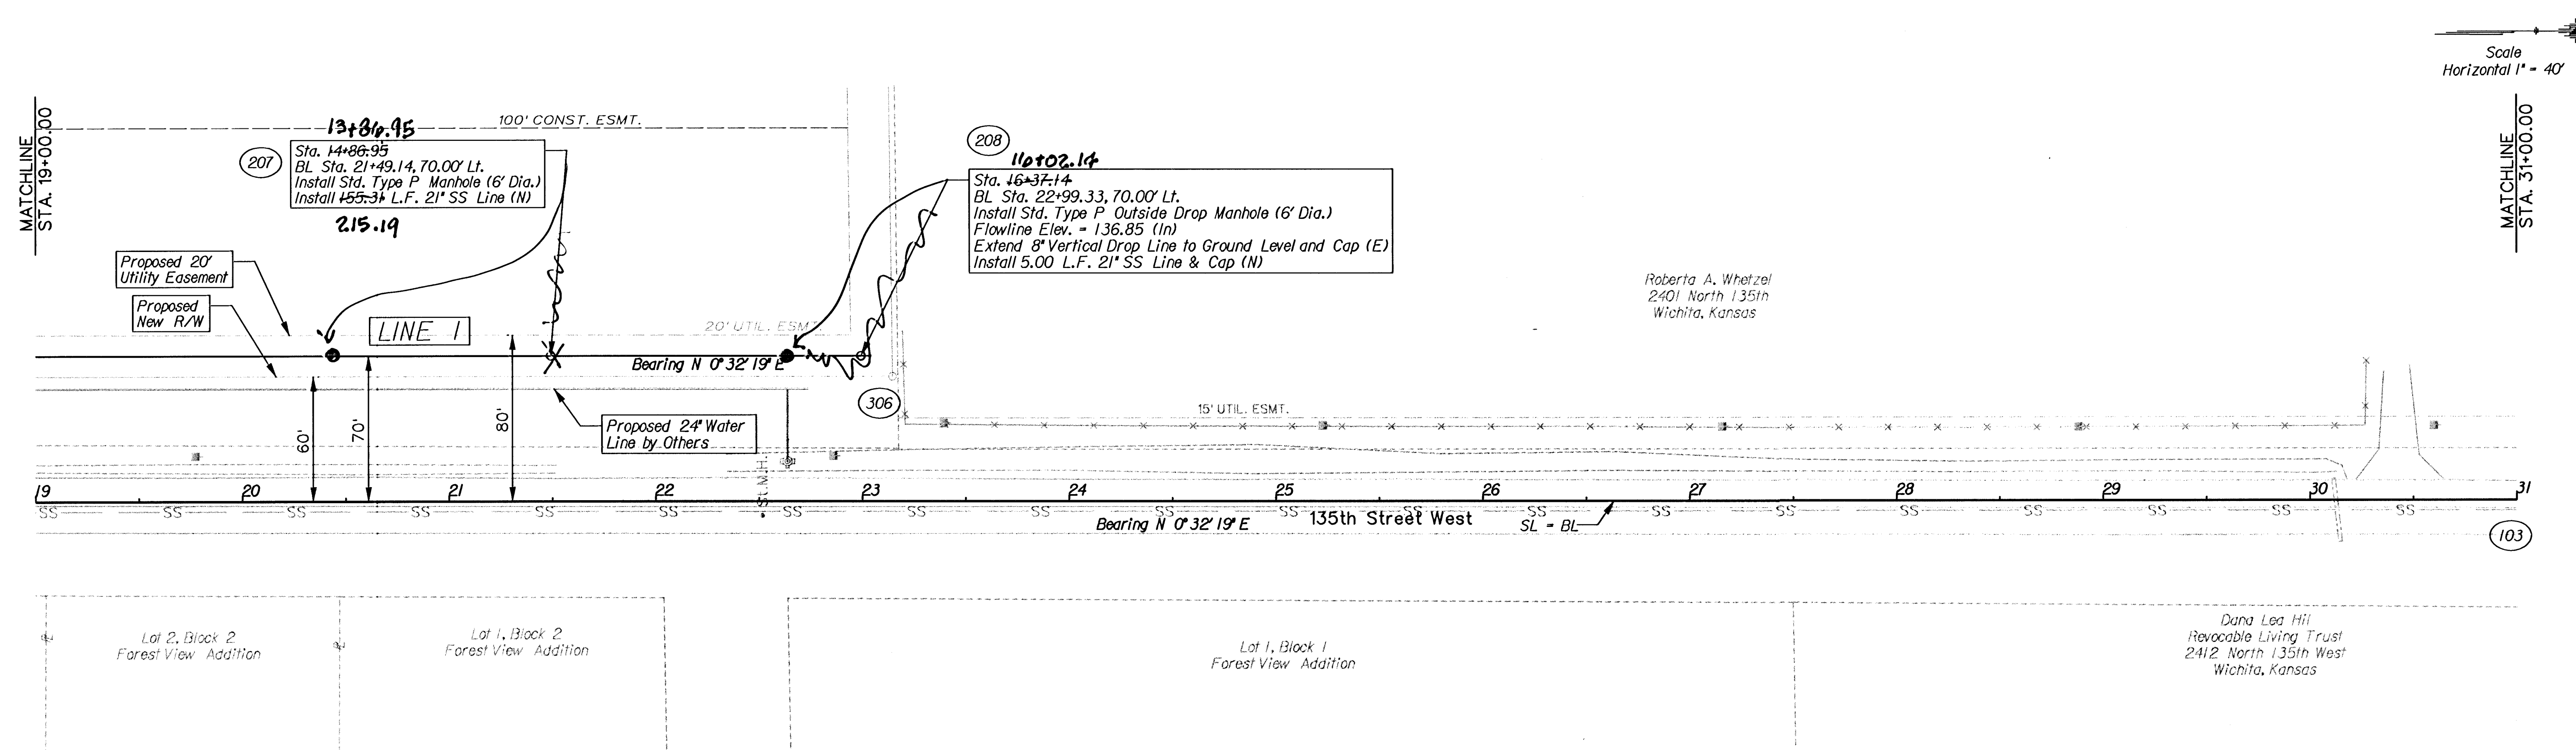

Note: FL information not verified.

Note:
No Construction Activities are allowed
on Private Property without a Construction
Easement.

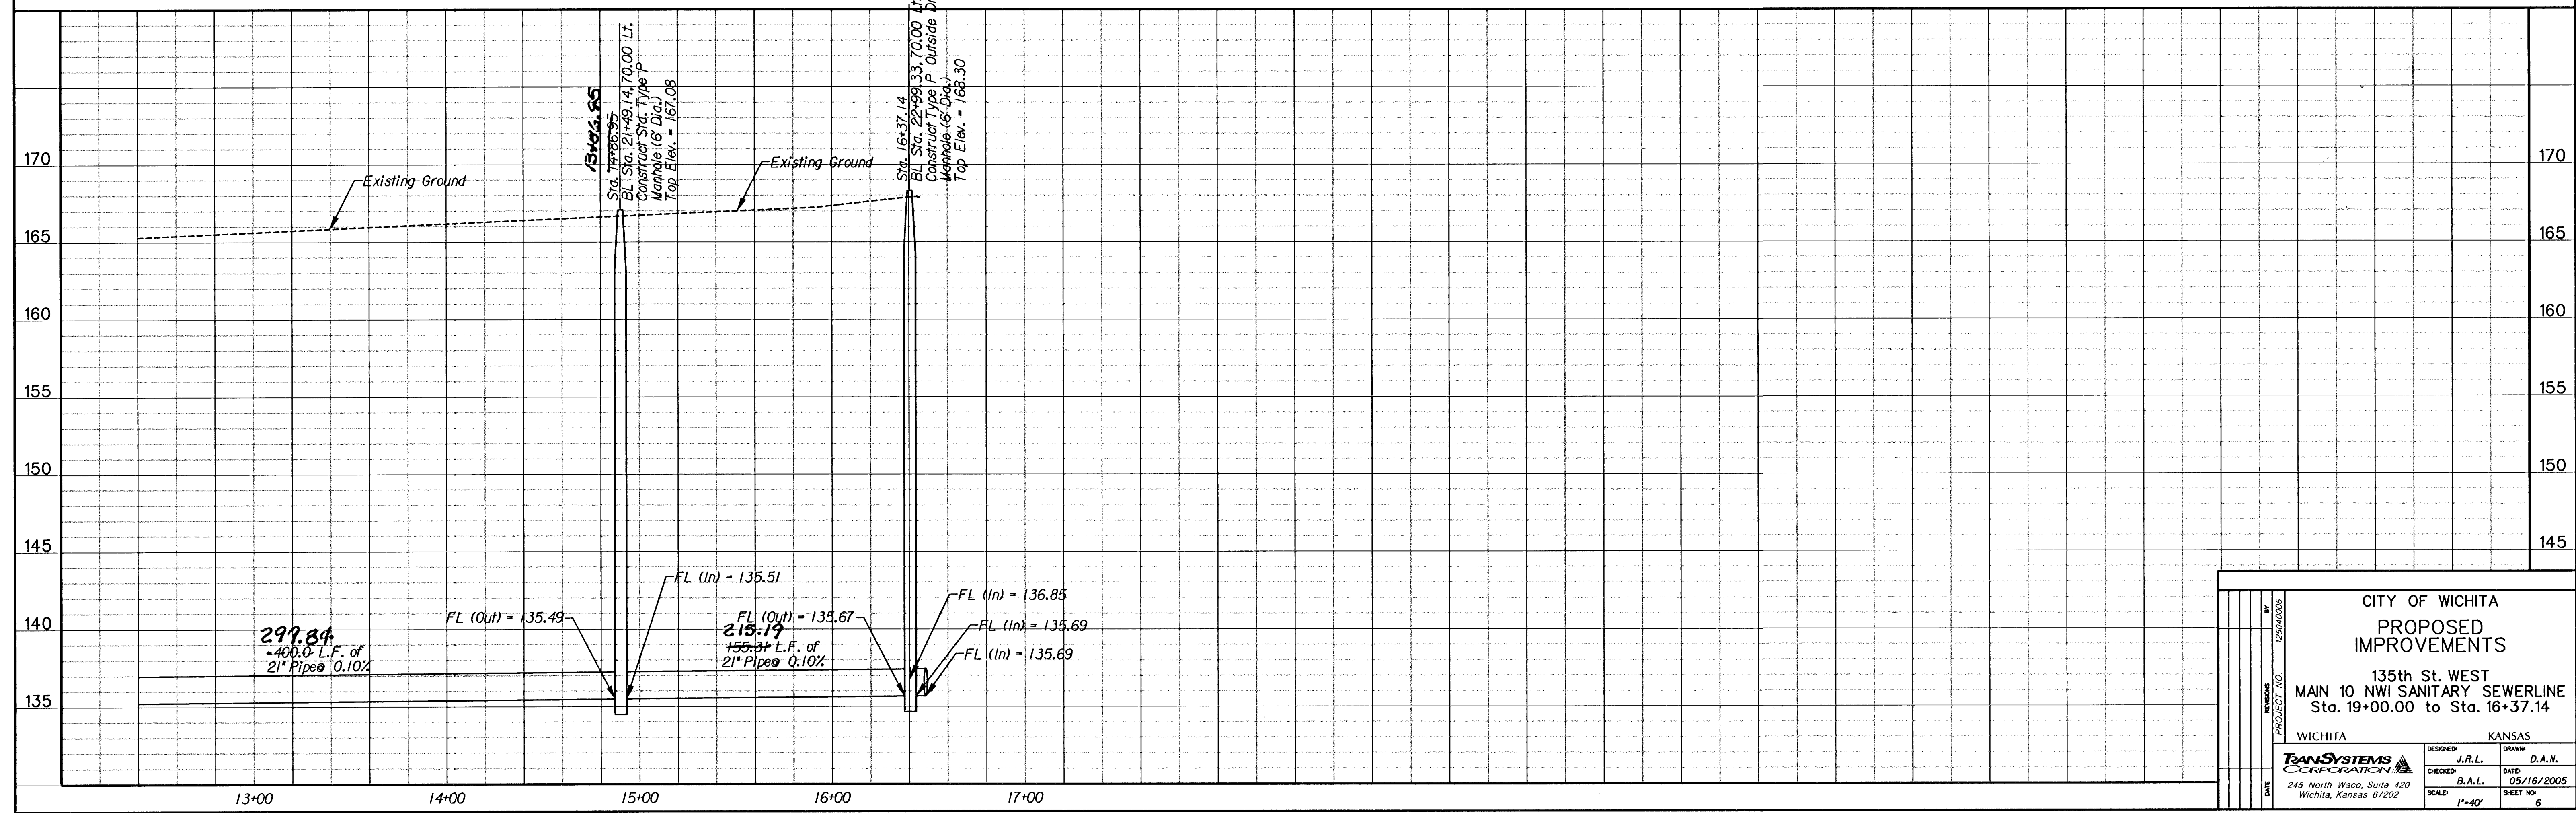

g:\w04\0006\road\p02.sht
05/16/2005 10:35:25 AM