





BENCHMARK:
BM #1 City of Wichita Disc located NE Corner of
Traffic Signal Light Pole Base at NW Corner
of Womer and 37th Street North.
Elev. = 1324.06 MSL

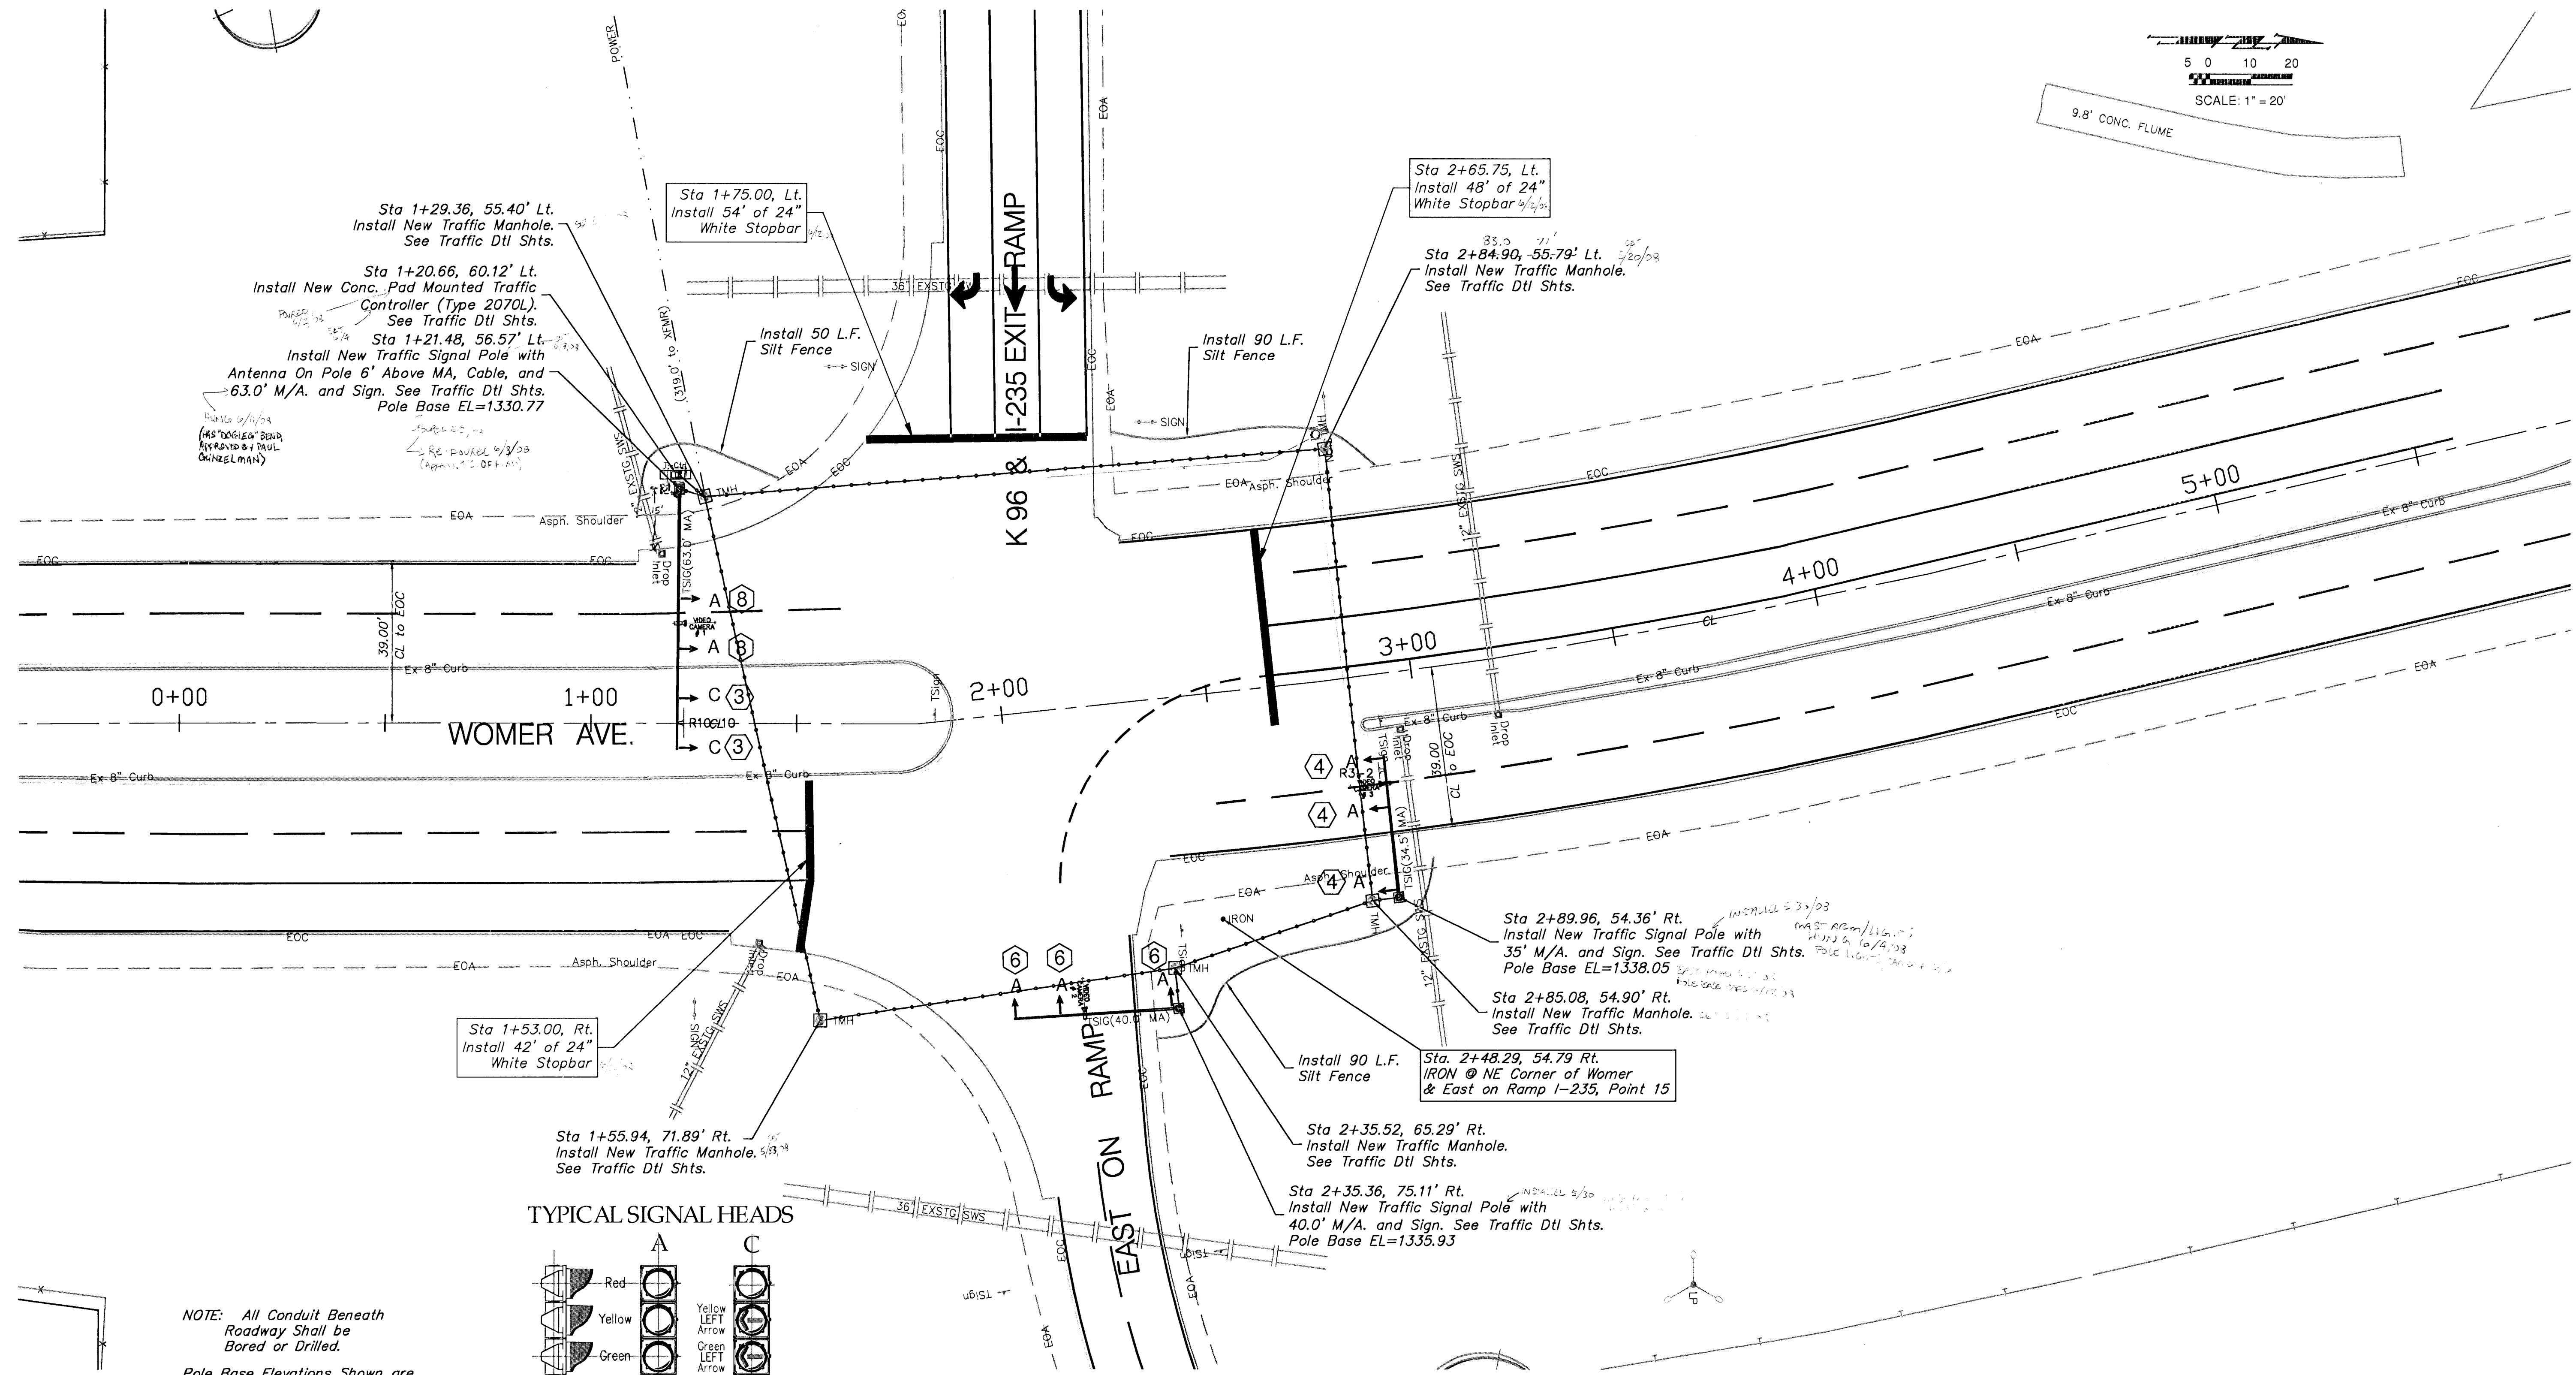

NOTE: All Conduit Beneath
Roadway Shall be
Bored or Drilled.

Pole Base Elevations Shown are
Based on Required Clearances.
See Signal Pole Detail Sheet
for Additional Information.

Contractor to Remove
Stop Sign when Signal
is Put into Operation.

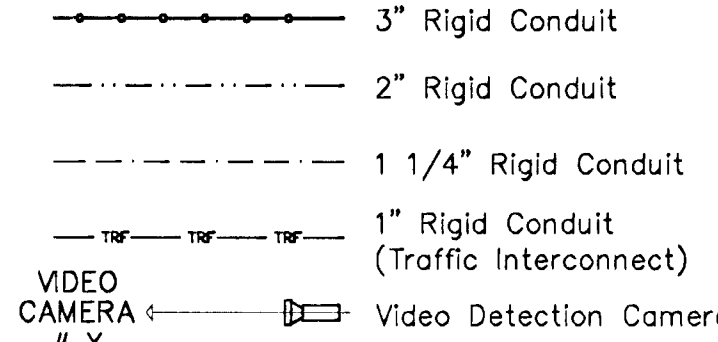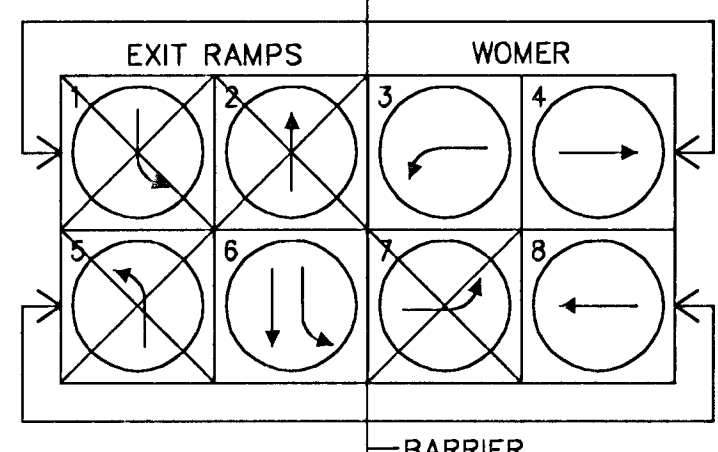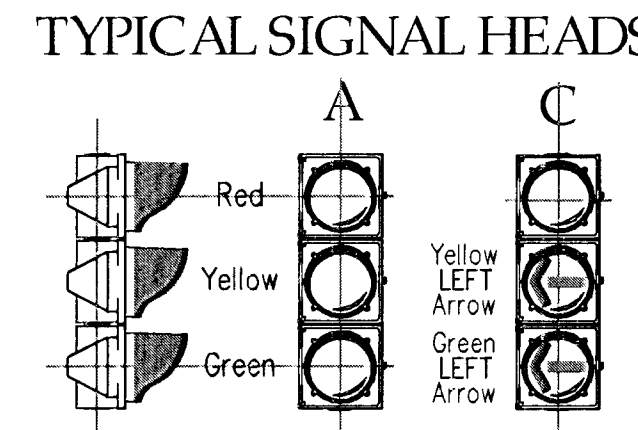

Drawing File: E:\Eng\1235 and meridian signalization\land\baselayout1.dwg
Project No. 07024758 CAPITAL IMPROVEMENT PROJECT
Design: TCA
Drawn: TCA
Approved: ENGINEER
Scale: NOTED
I-235 & MERIDIAN SIGNALIZATION
WOMER & EAST ON RAMP
PROJECT DESCRIPTION

Baughman Company, P.A.
315 Ellis St. Wichita, KS 67211 P 316-262-7271 F 316-262-0149
ENGINEERING | SURVEYING | PLANNING | LANDSCAPE ARCHITECTURE

December, 2007
SHEET
2
OF
8