

STORM WATER SEWER PLANS

CEDAR VIEW VILLAGE

PROJECT TITLE



468-84464

PROJECT NUMBER

ISSUED
AUGUST 2008

REVISED
 September 08

5 of 14

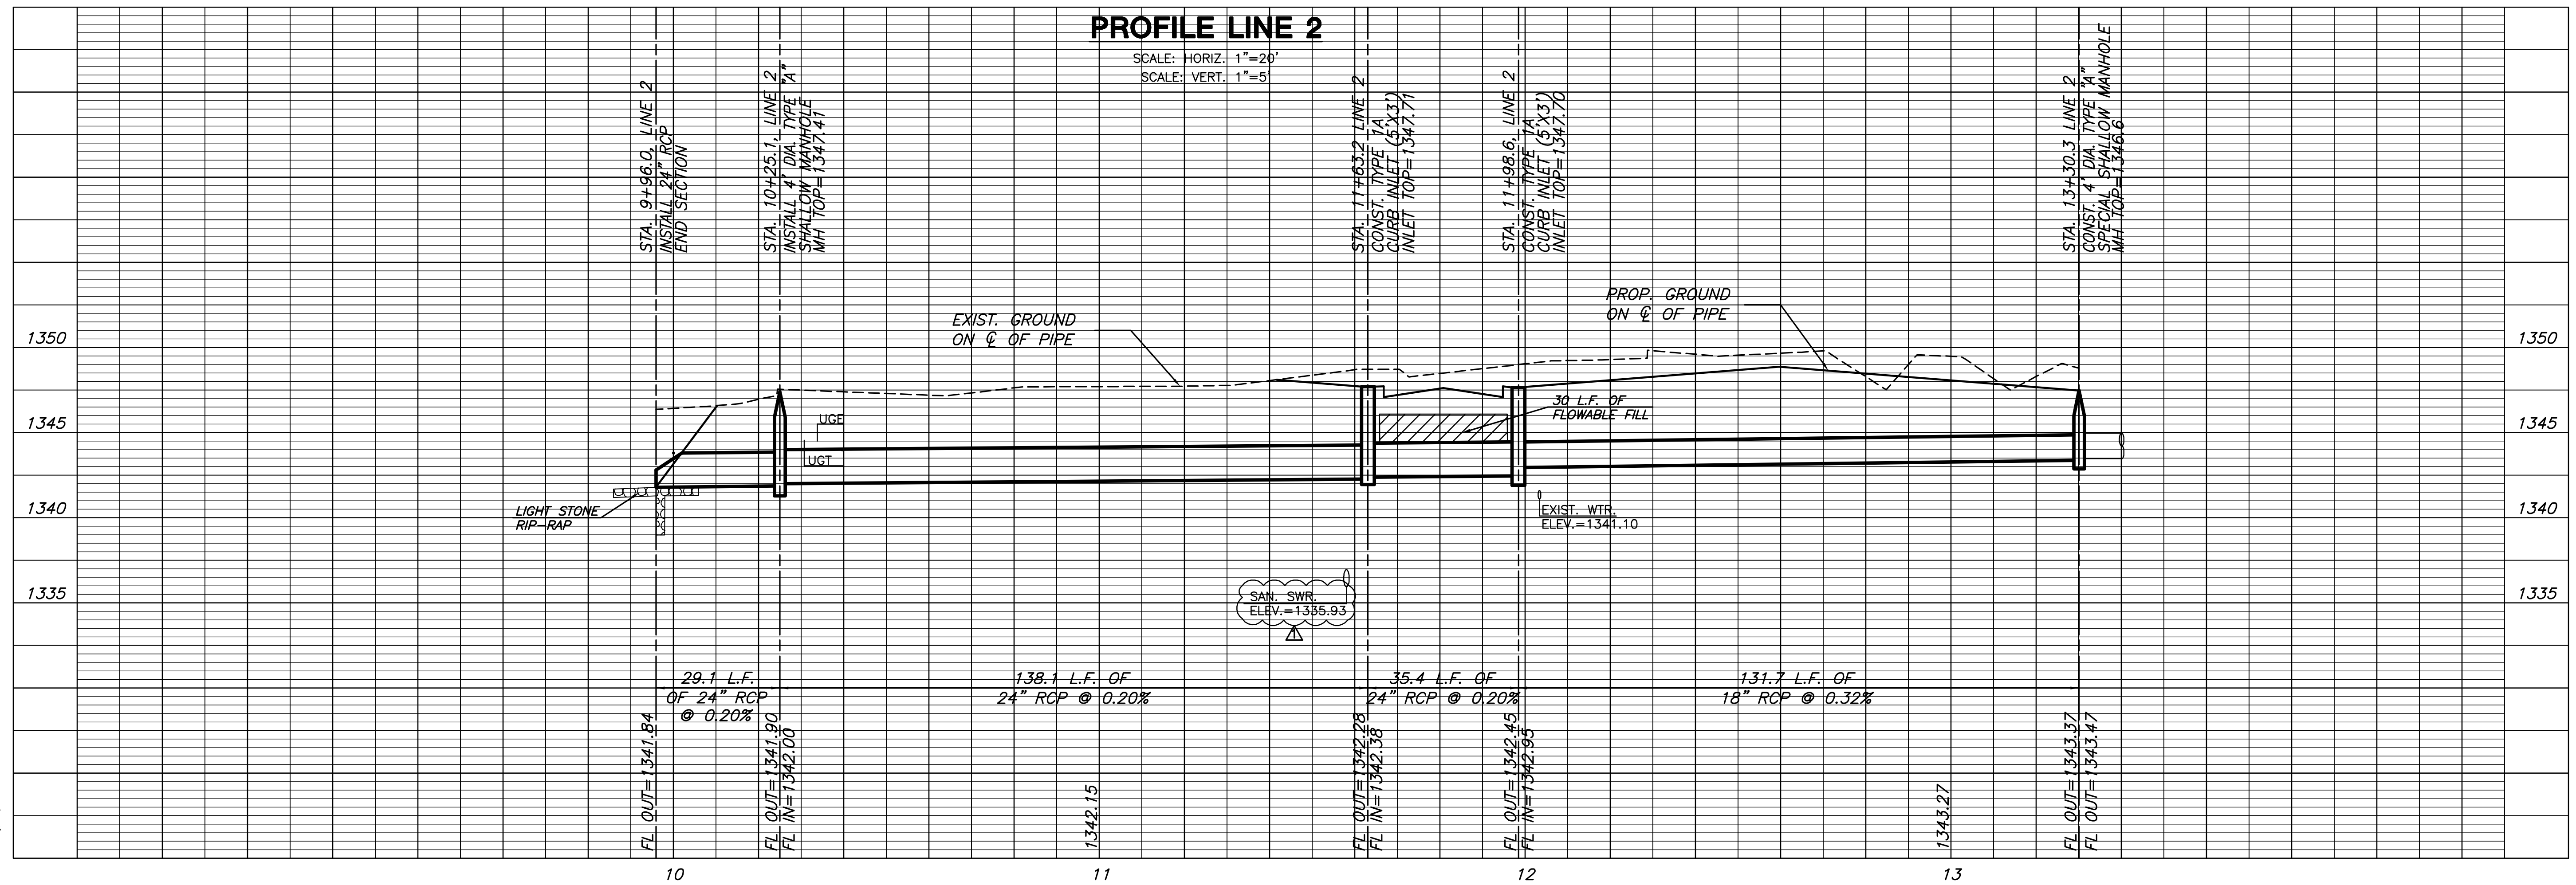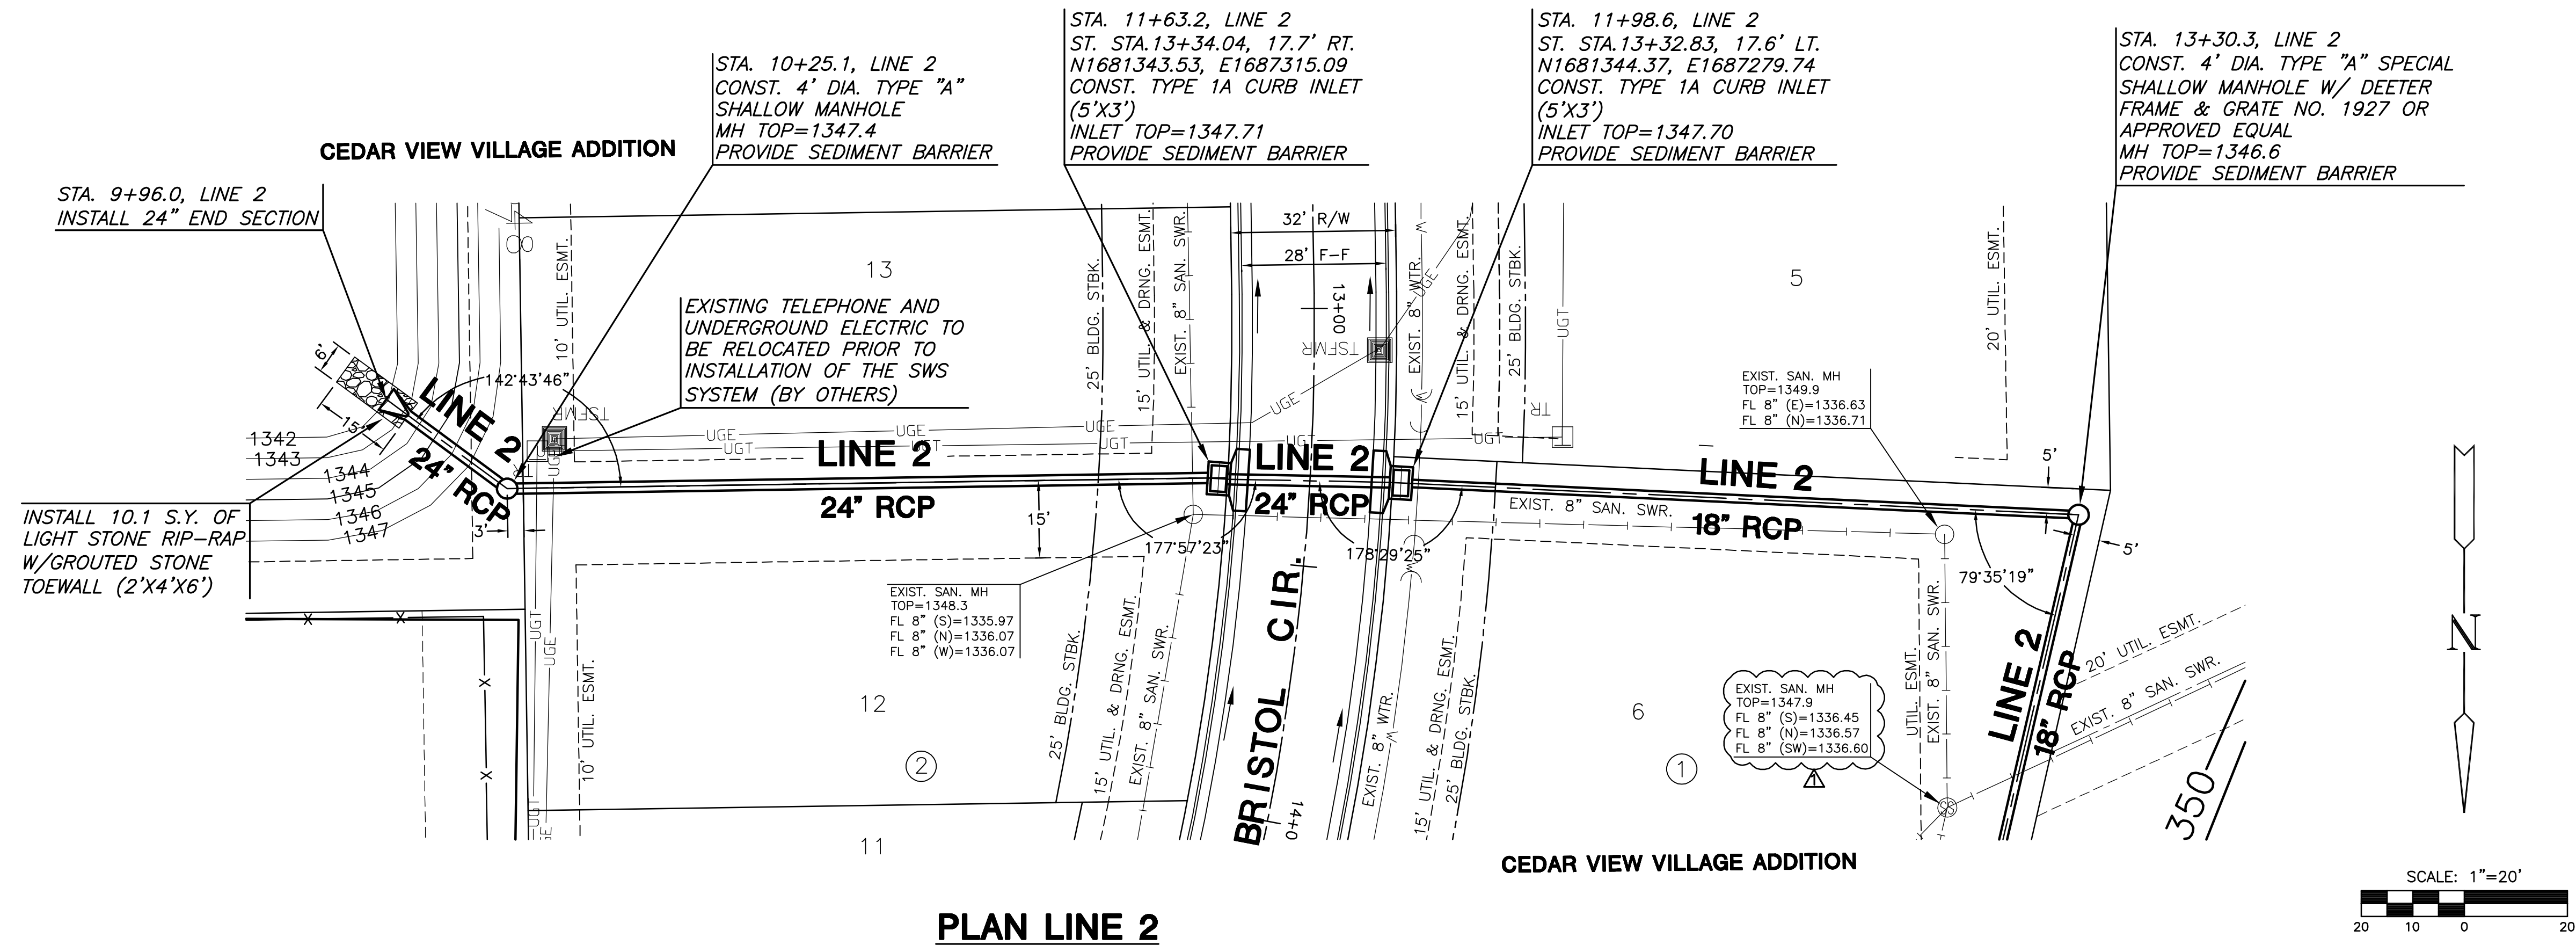

PLOTTED: Monday, September 15, 2008 @ 01:58PM

0:\MAIL\06189\5WS\GNG\68190\7MAIL\06189-02.DWG